



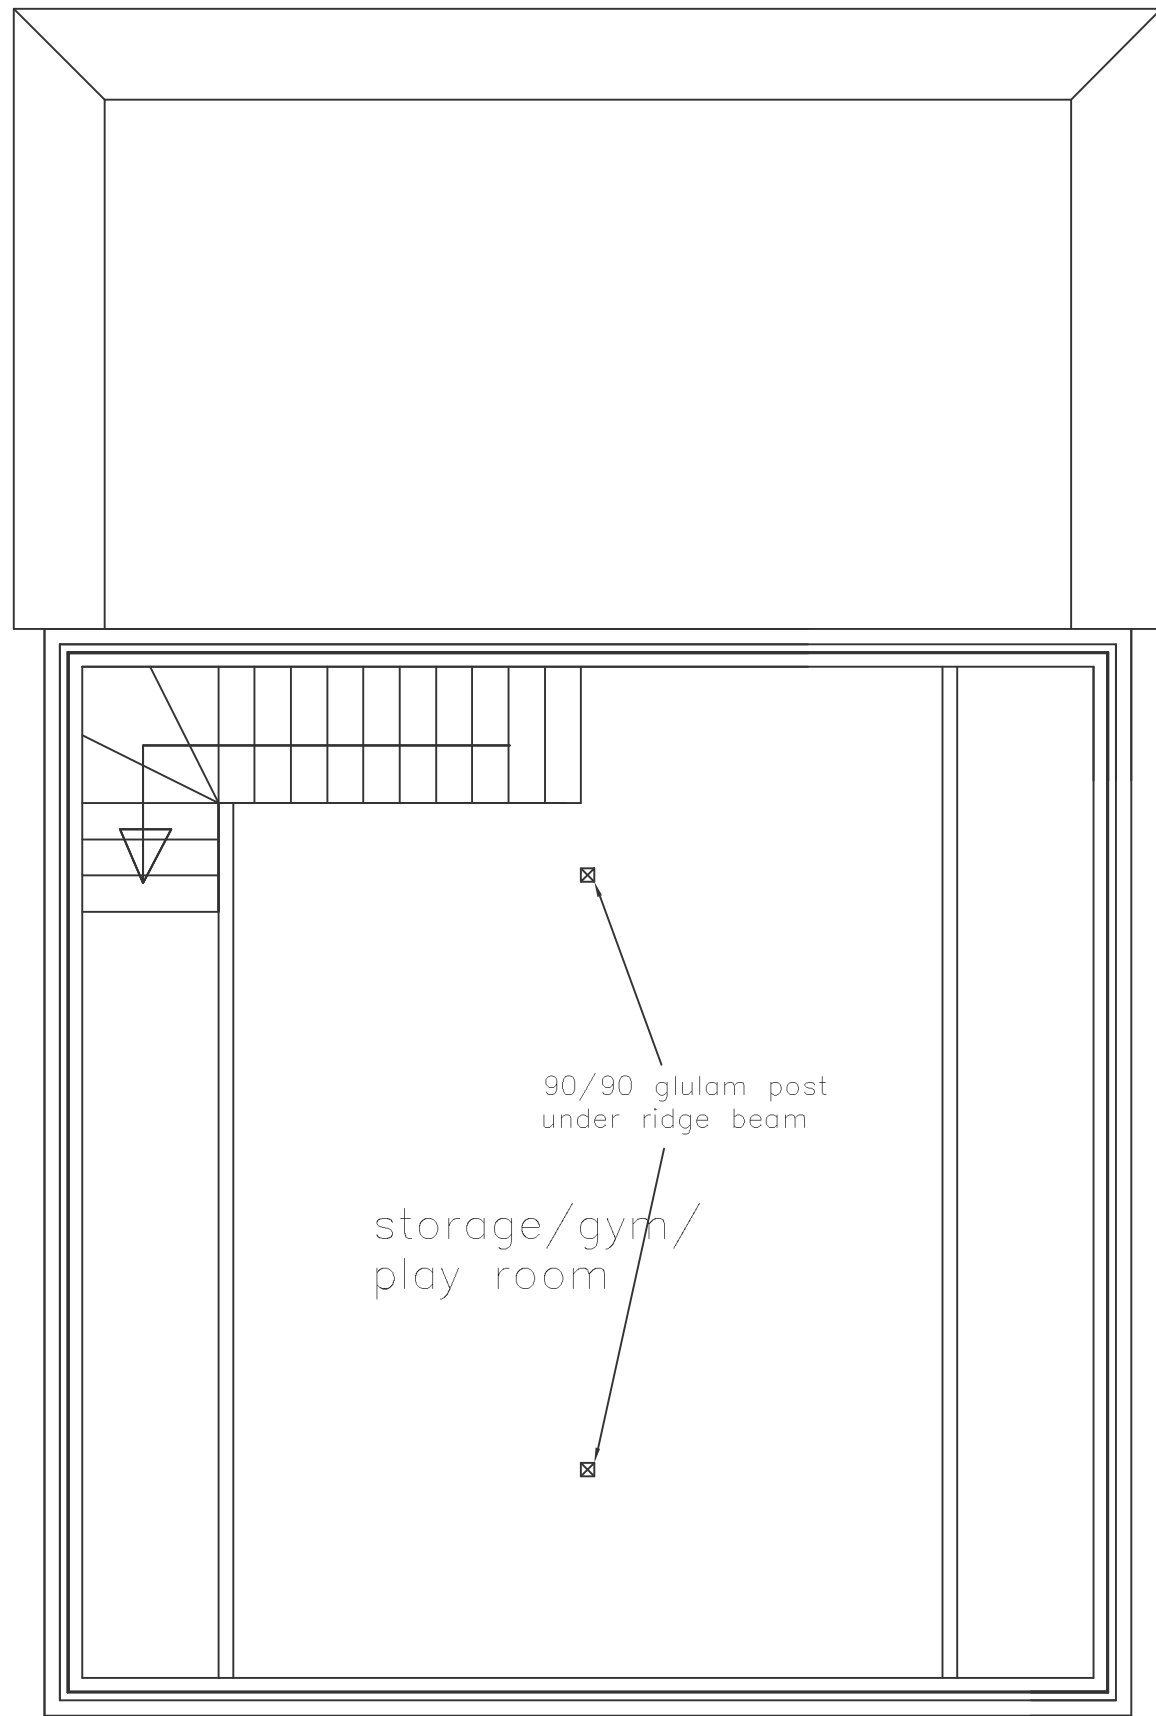

EXISTING FF GARAGE LAYOUT PLAN

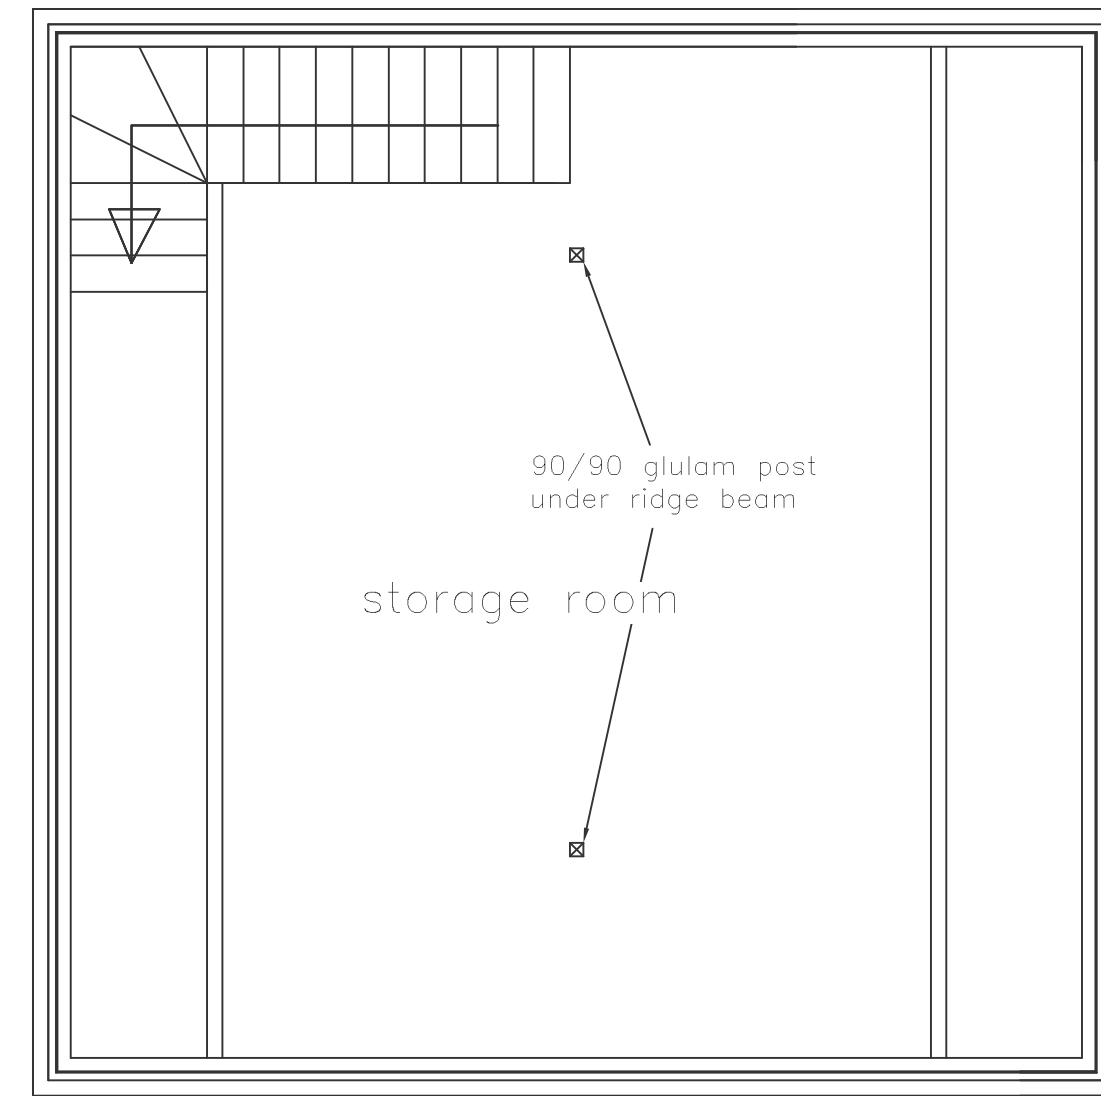

ORIGINAL (as built) FF GARAGE LAYOUT PLAN

Date 24/10/2011	Drawn EM	checked by	date checked	Client MERCO PLACE LTD	 8 New Brighton Road Emsworth, Hampshire, PO10 7PS TEL: 08450 450 862 www.erconstructions.co.uk
Scale 1/50	Drawing title Garage FF layout plan			Project EASTERN BARN	
Drawing No 105/73				Address 8 New Brighton Road Emsworth, Hampshire PO10 7PS	