




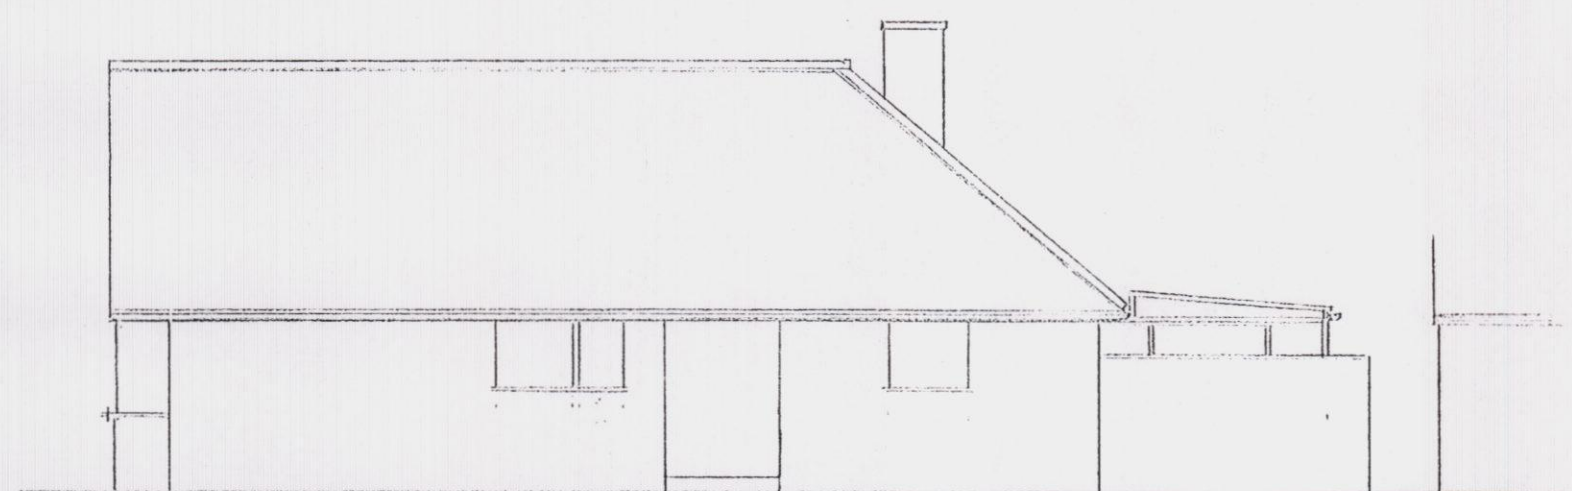


SOUTH WEST ELEVATION

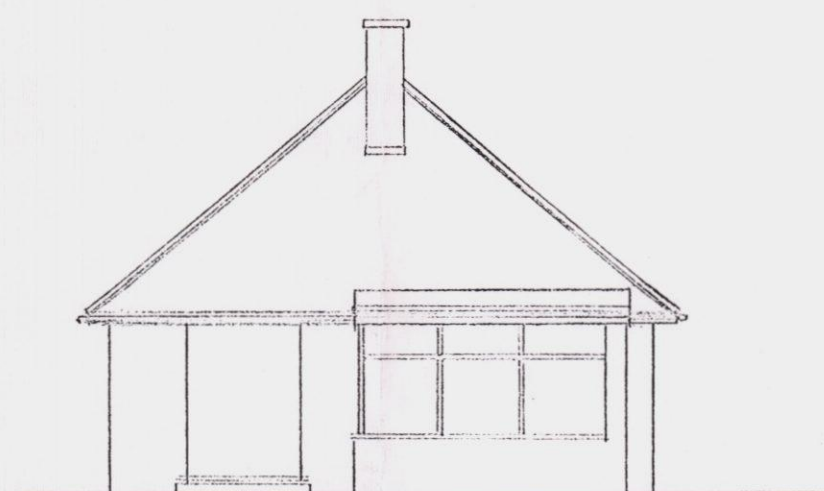

SOUTH EAST ELEVATION

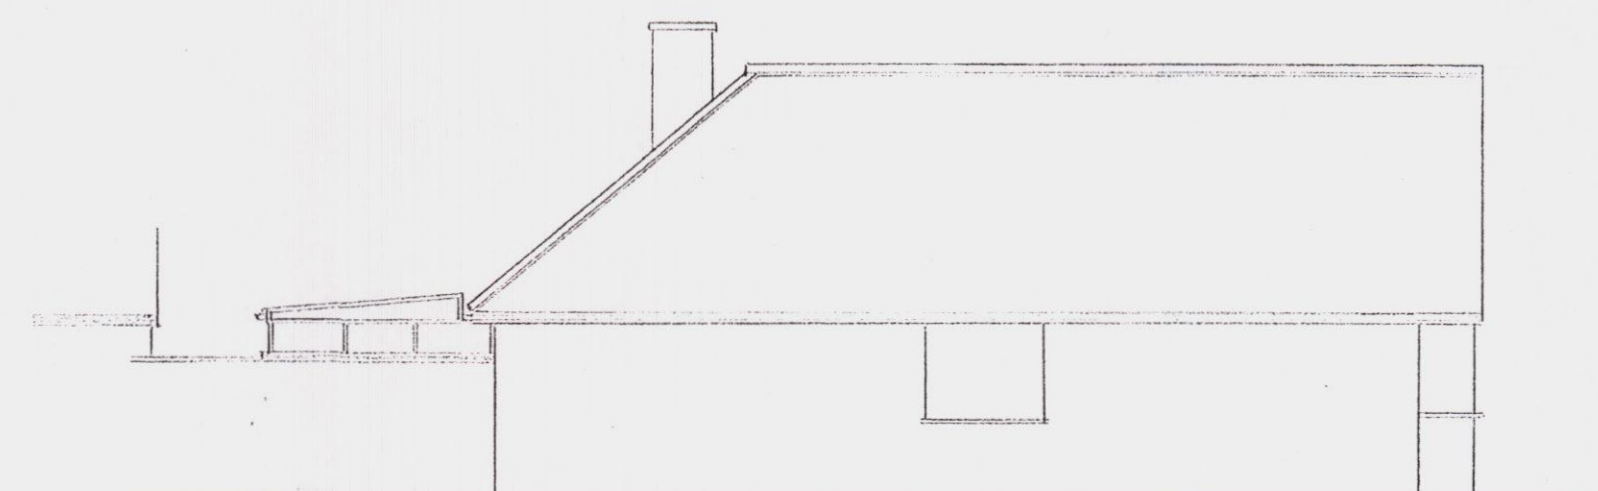

NORTH EAST ELEVATION

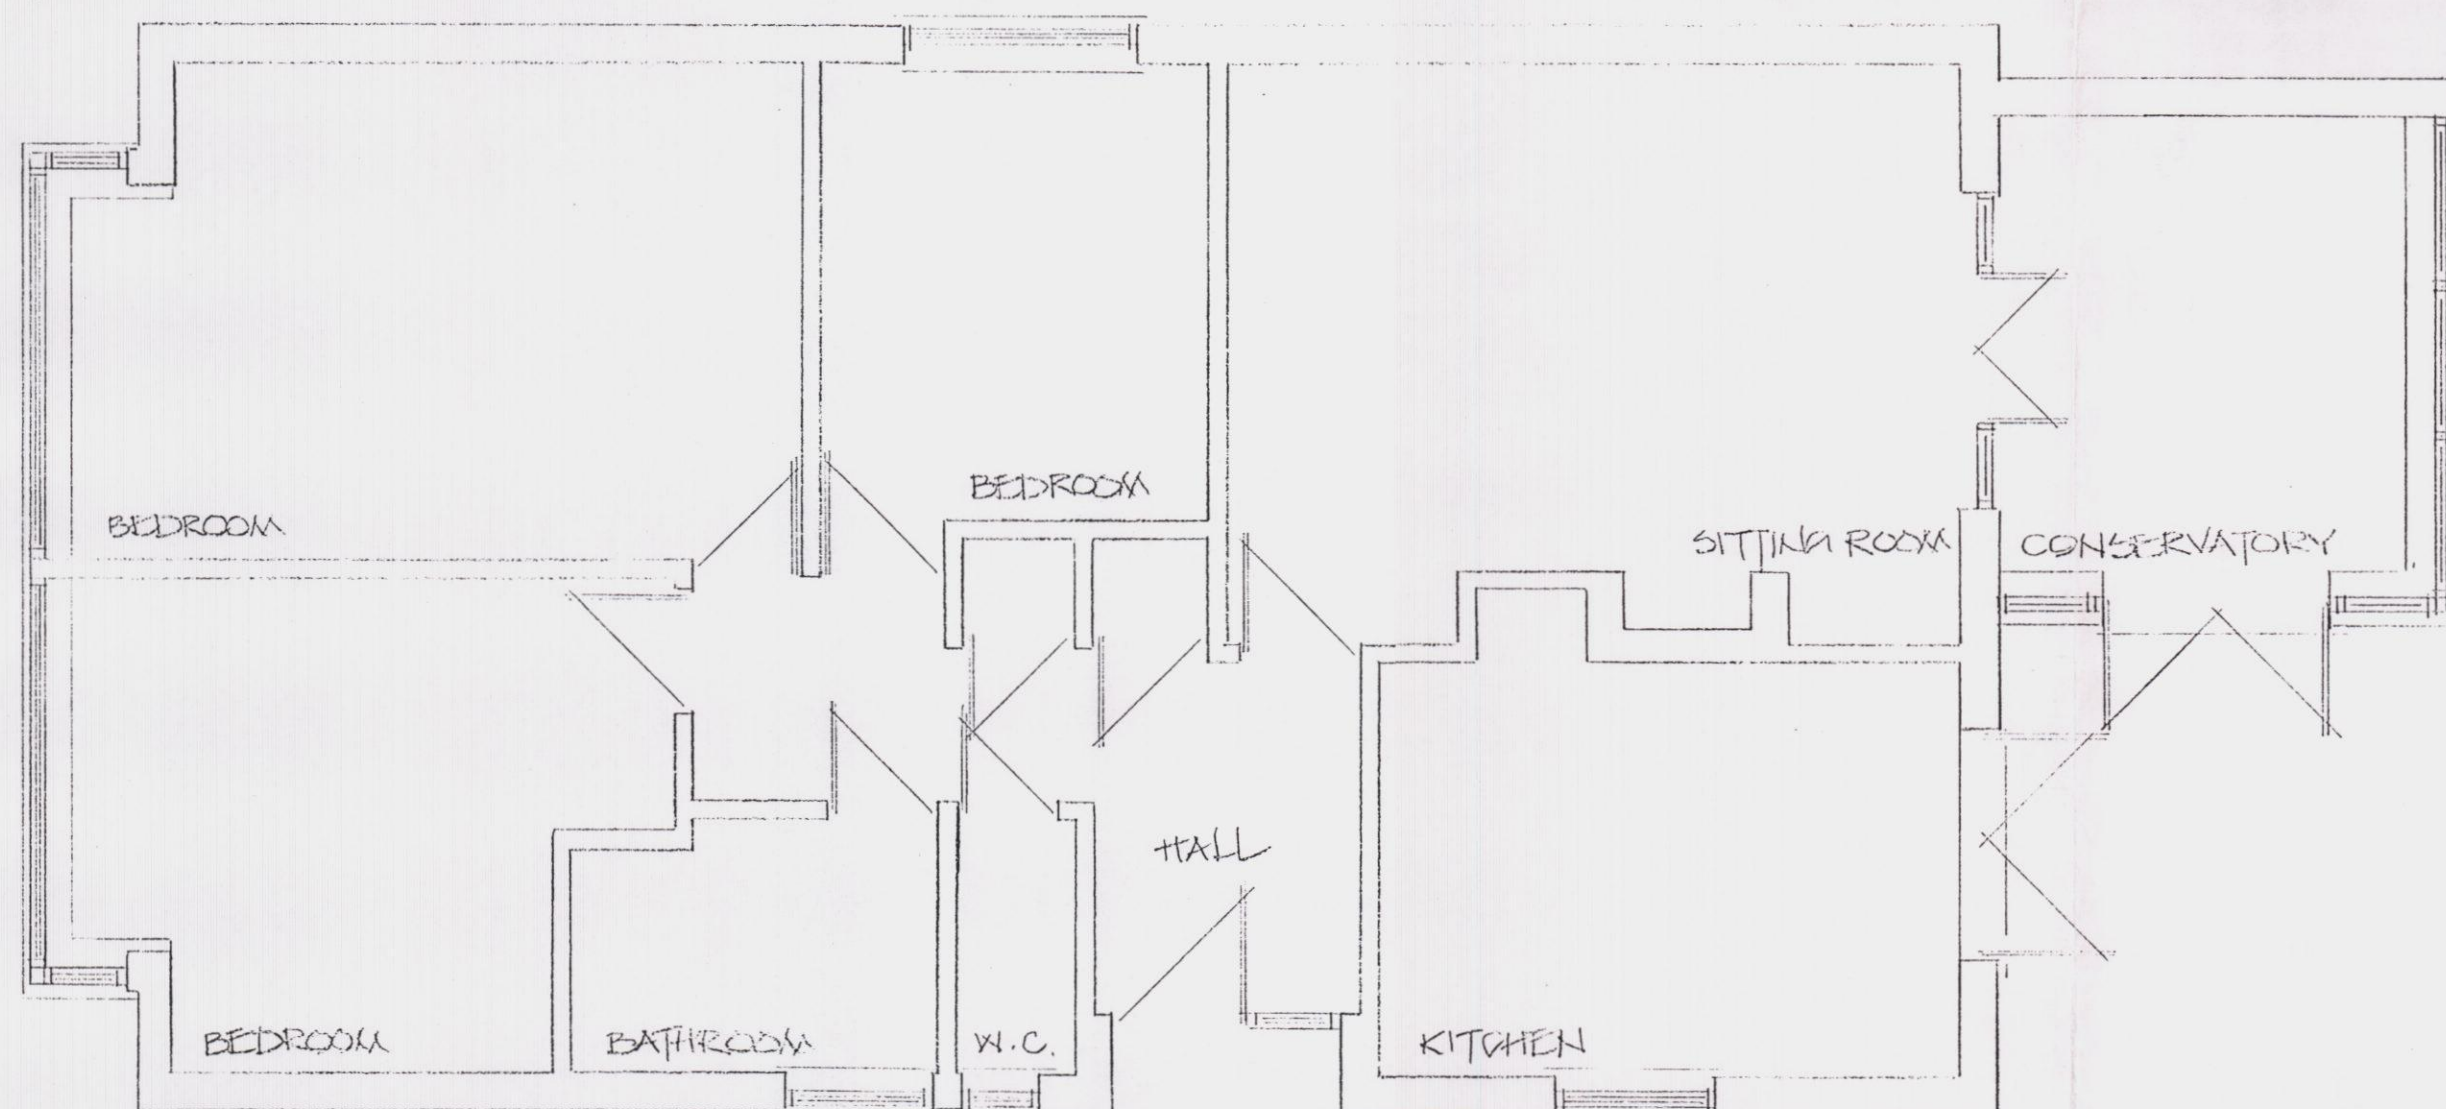

FLOOR PLAN



MRS E NIVEN

74 WESTBOURNE AVE
EMSWORTH
HANTS
PO10 7QU

AS BUILT

David Niven Design Ltd

davidnivedesign@gmail.com
07973 342 607
74 Westbourne Avenue,
Emsworth, Hampshire PO10 7QU



Architectural Design & Planning

1:100,50 MARCH 13 13/934/1