




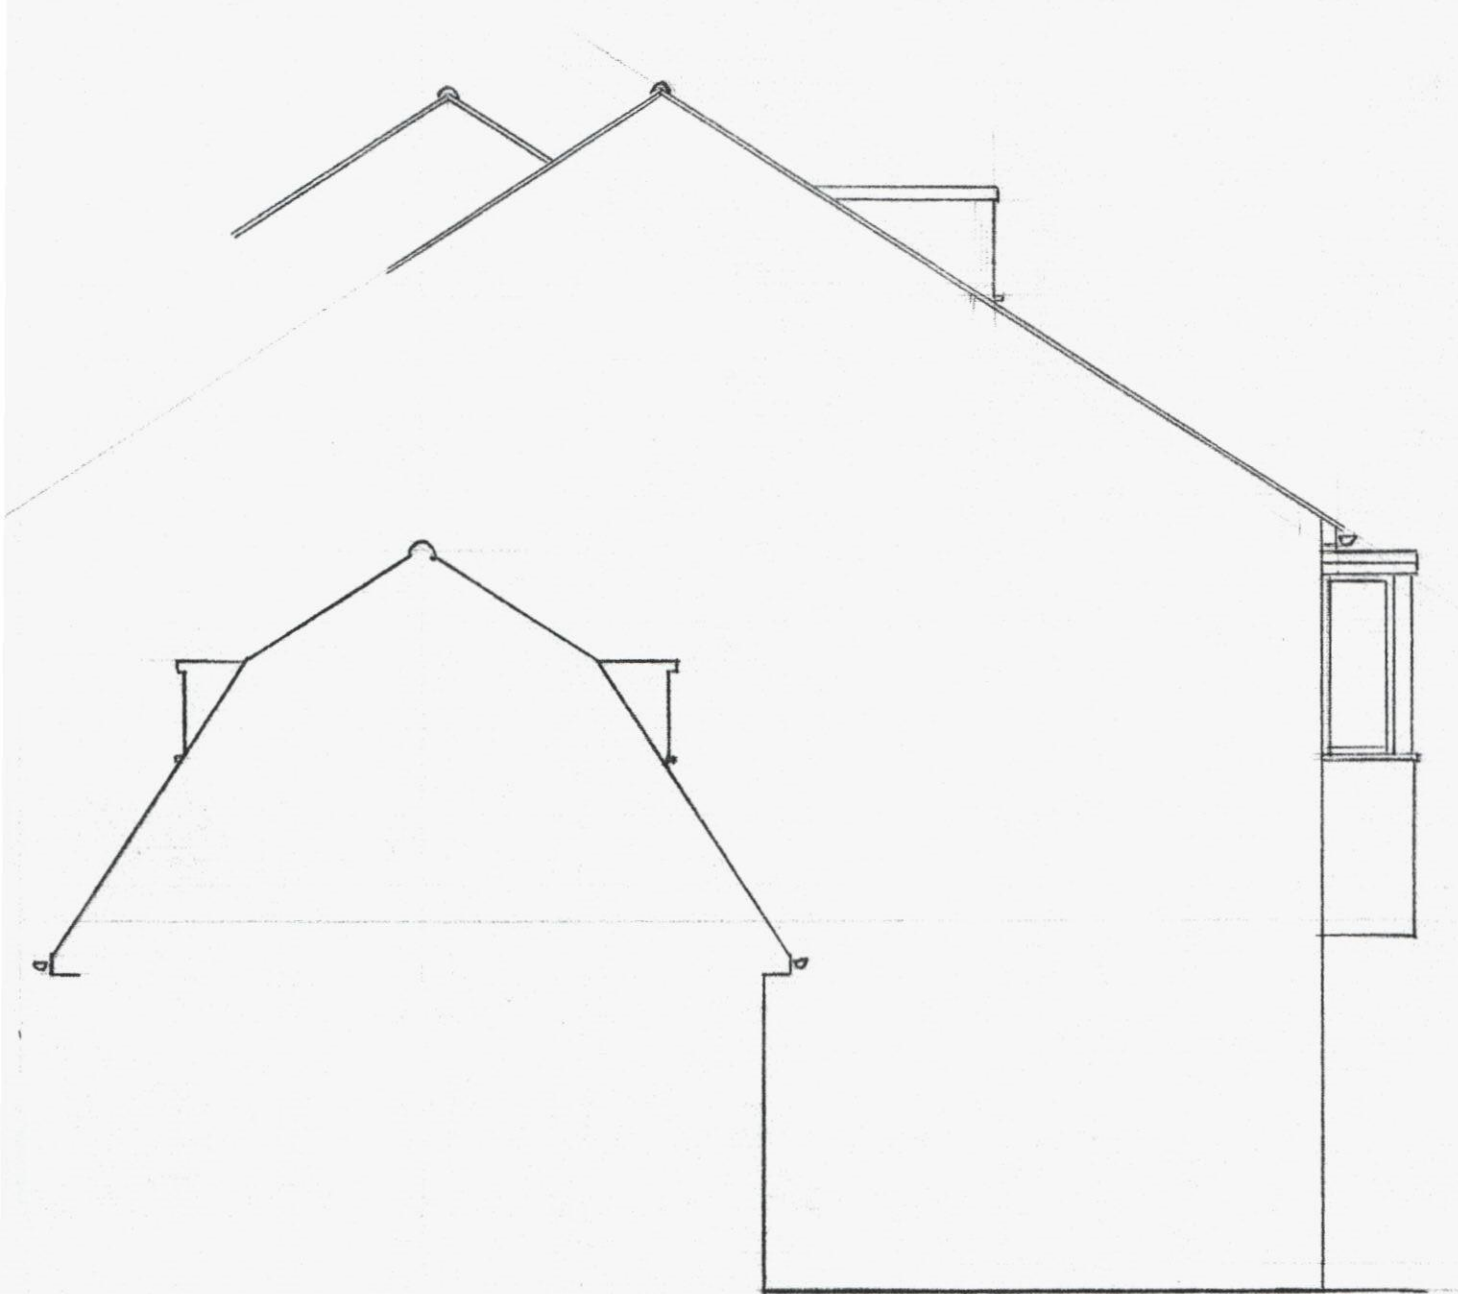


WEST ELEVATION

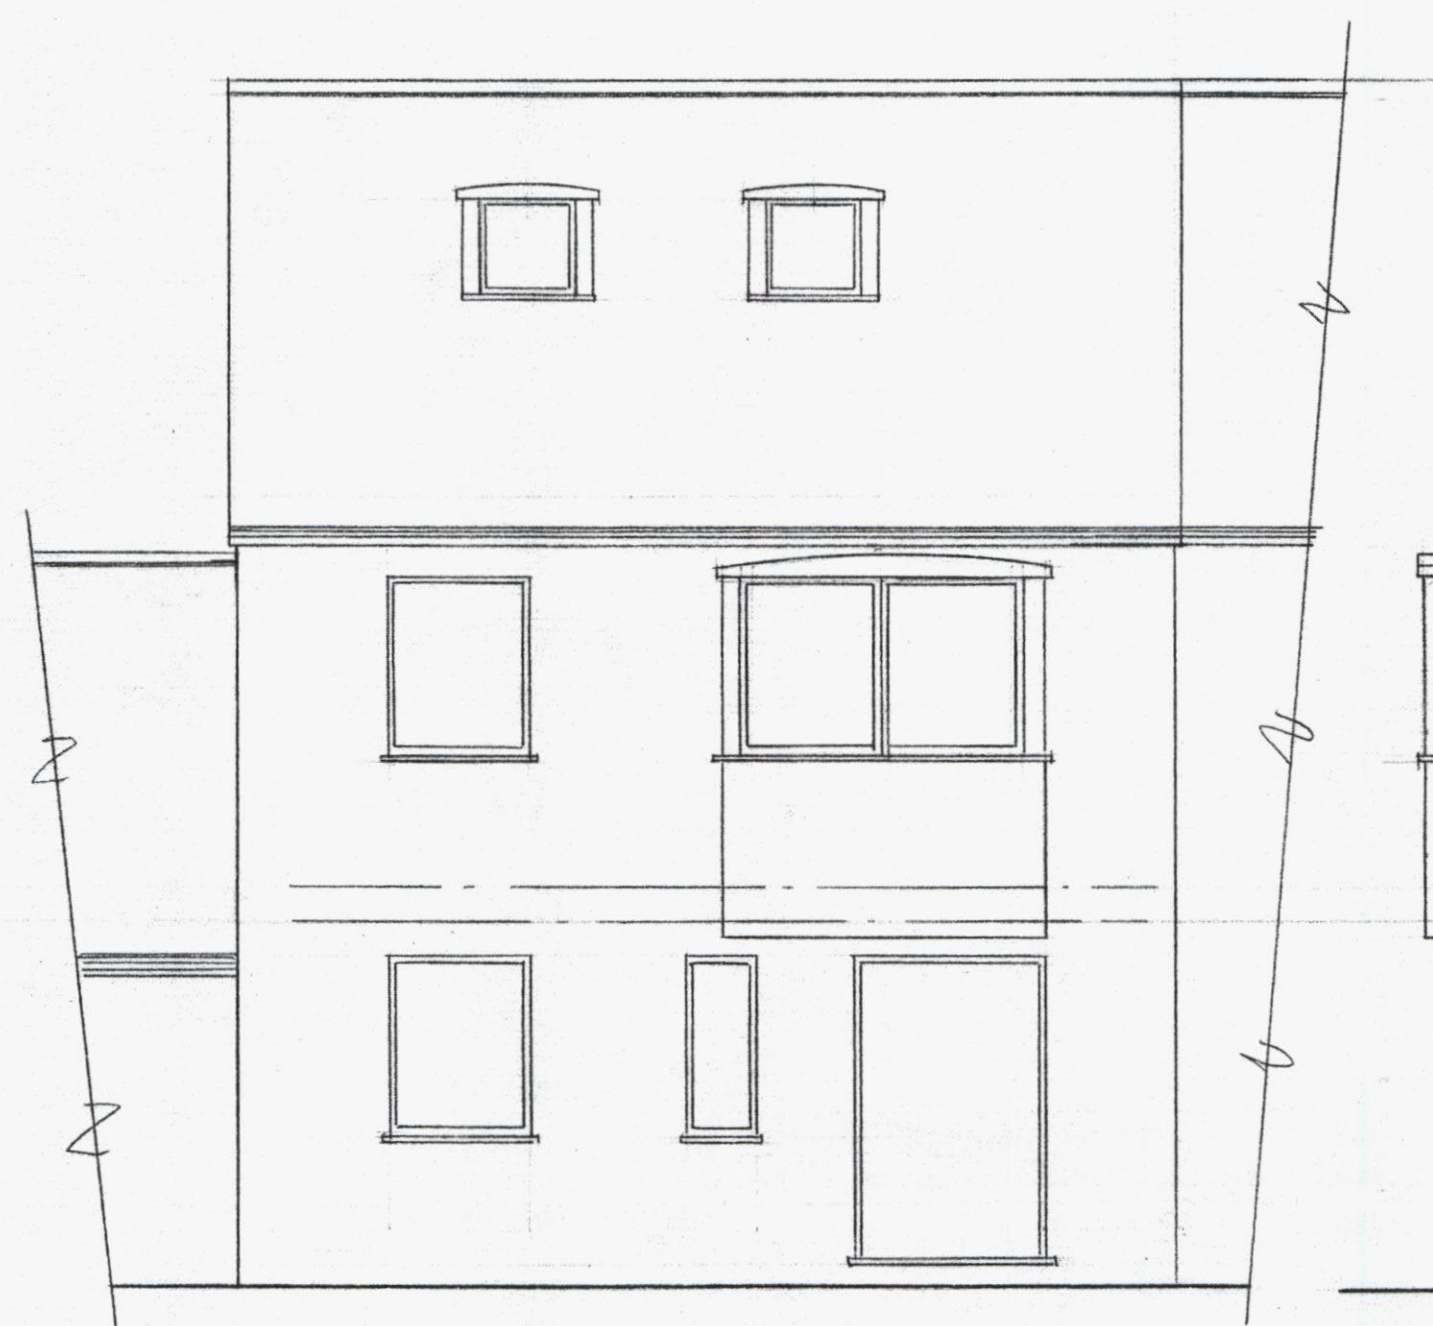


SOUTH ELEVATION

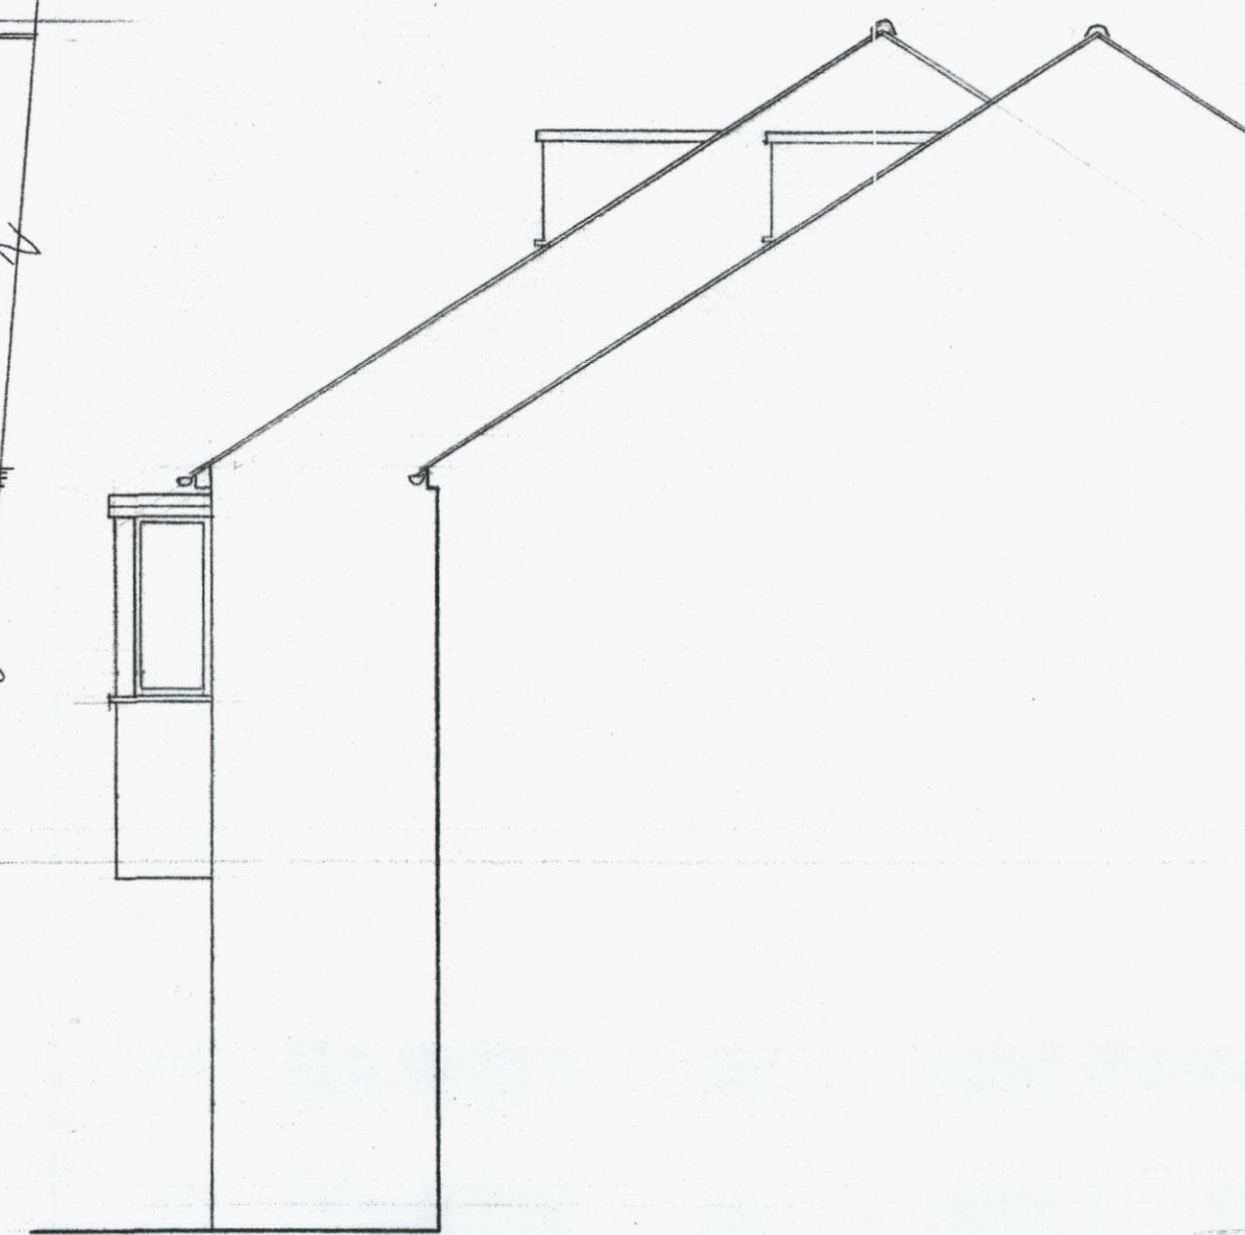


EAST ELEVATION

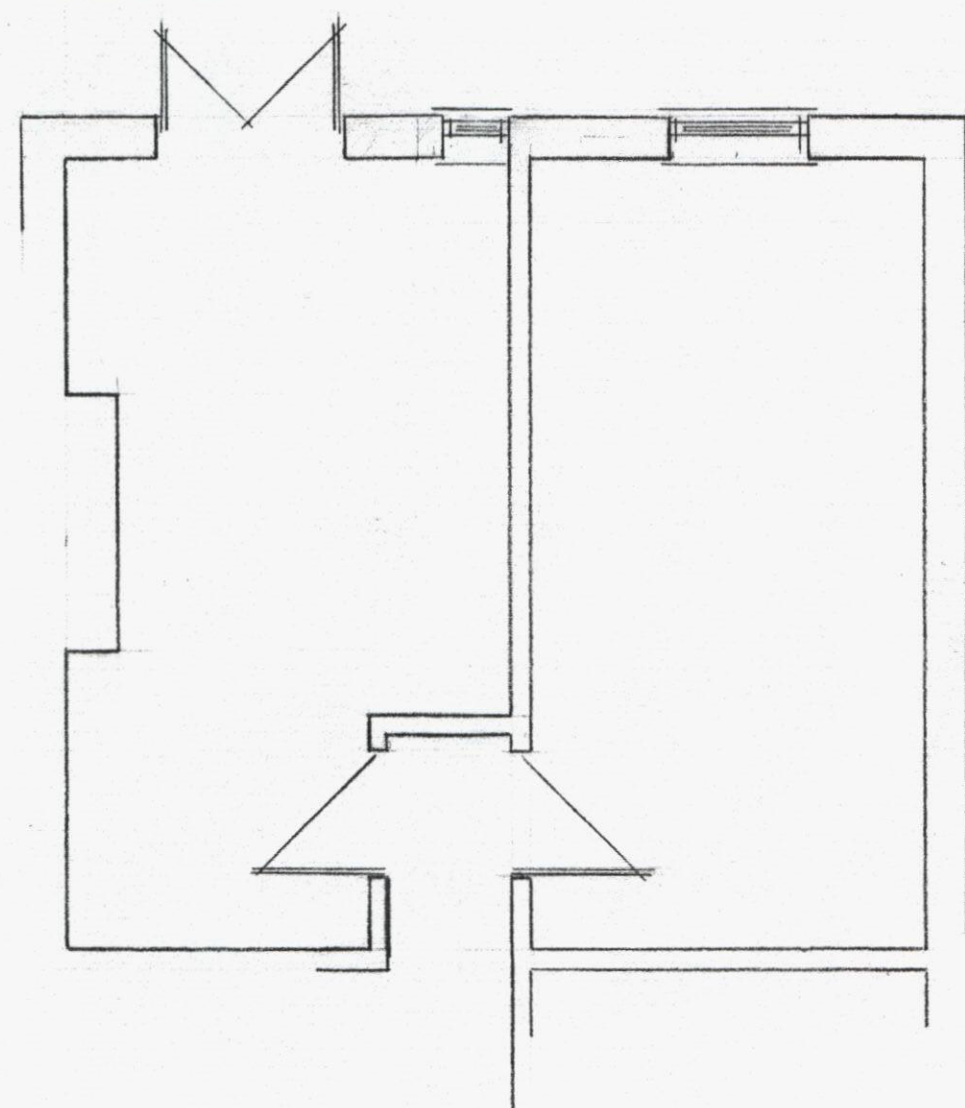

PART GROUND FLOOR PLAN

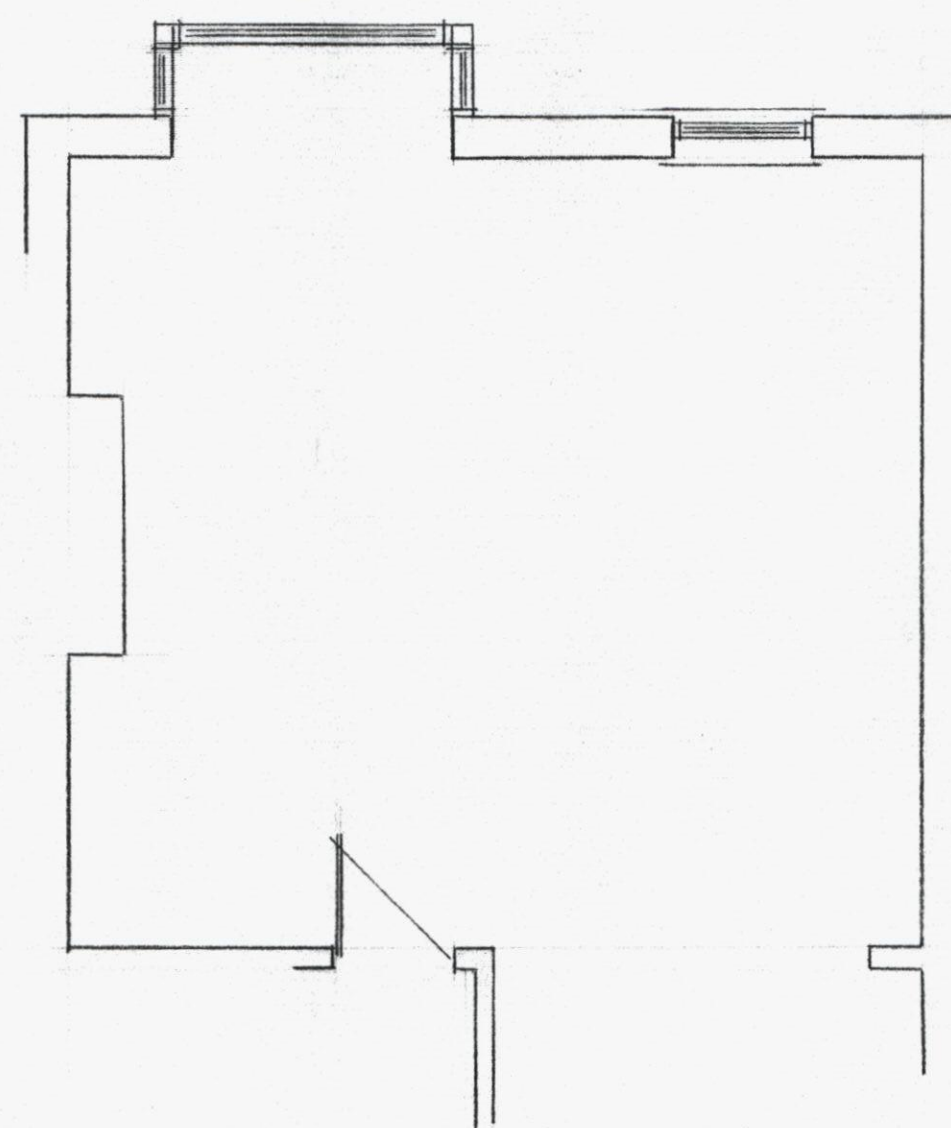

PART FIRST FLOOR PLAN

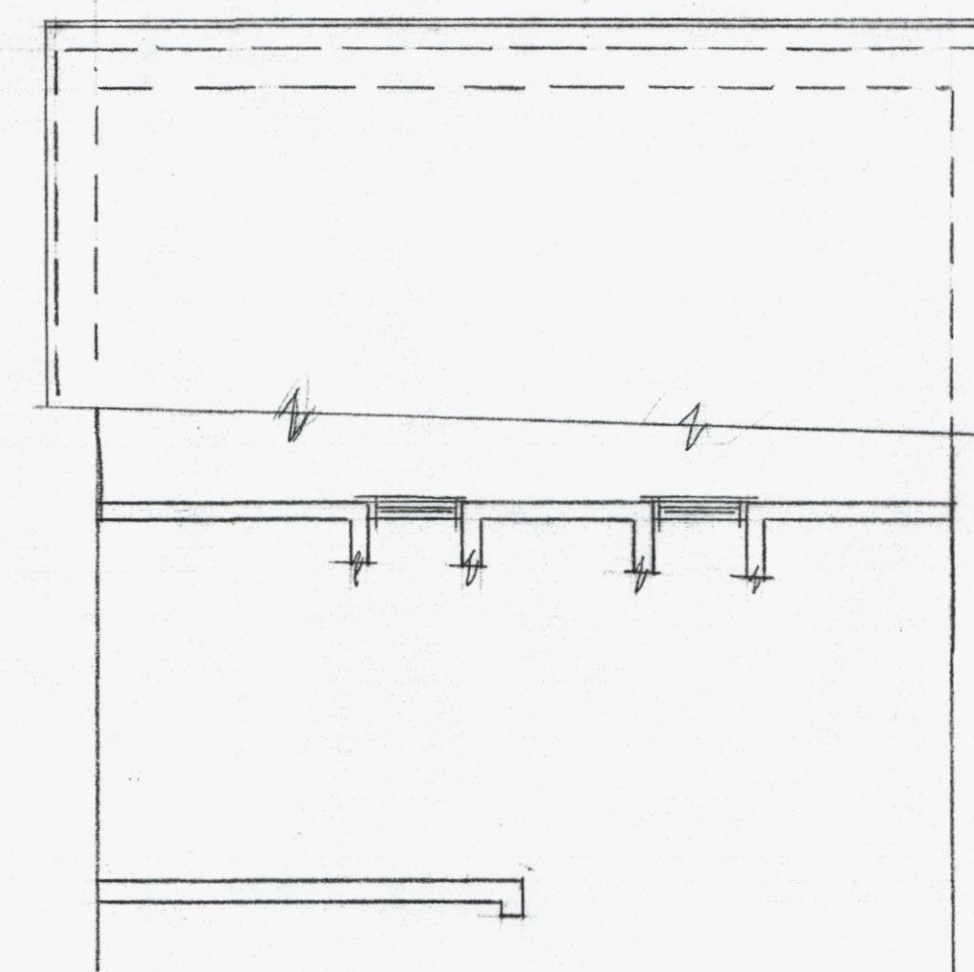

PART LOFT FLOOR PLAN



MR & MRS MILES

5 ORANGE ROW
SOUTH ST
EMSWORTH
HANTS

AS BUILT

David Niven Design Ltd

davidnivedesign@gmail.com
07973 342 807
74 Westbourne Avenue,
Emsworth, Hampshire PO10 7QU



Architectural Design & Planning

1:50

SEPT 12 12/922/1