

PERMIT

ALL DIMENSIONS AND LEVELS MUST BE CHECKED BY THE CONTRACTOR ON SITE BEFORE ANY WORK IS PUT IN HAND. ONLY DIMENSIONS AND LEVELS ARE TO BE WORKED TO AND ALL DISCREPANCIES ARE TO BE REFERRED TO THE DESIGNER FOR INSTRUCTIONS.

EMERGENCY ITEMS

- E 00** FIRE EXIT / PICTOGRAM FIRE SAFETY SIGN.
- E 100** DIRECTIONAL FIRE EXIT / PICTOGRAM FIRE SAFETY SIGN.
- NI** GENERAL FIRE NOTICE.
- NS** STAFF FIRE NOTICE.
- NS** NOTICE ON BOTH SIDES OF DOOR 'DOOR TO BE KEPT LOCKED AT ALL TIMES'.
- NS** NOTICE ON BOTH SIDES OF DOOR 'AUTOMATIC DOOR KEEP CLEAR'.
- NS** FIRE EXIT KEEP CLEAR NOTICE.
- NS** NOTICE ON BOTH SIDES OF DOOR 'FIRE DOOR KEEP SHUT'.
- 9** 9 LITRE WATER EXTINGUISHER, WALL MOUNTED WITH TOP 1000 MM FROM FLOOR LEVEL.
- CD** CARBON DIOXIDE (CO2) EXTINGUISHER, WALL MOUNTED AT APPROX EYE LEVEL.
- VP** FIRE BLANKET, WALL MOUNTED.
- PS** PANIC BOLTS WITH PUSH BAR TO OPEN NOTICE.
- SC** SELF CLOSING DEVICE.
- SS** COLD SMOKE SEALS.
- VP** VISION PANEL.
- FS** FIREMAN'S SWITCH RECESSED IN LOBBY SOFFIT.
- EM** ELECTRO MAGNETIC HOLD OPEN DEVICE.
- SD** SMOKE DETECTOR.
- EL** EMERGENCY LIGHT.

B.O.H. PERMIT

SALES AREA STATISTICS

GROUND FLOOR	
GROSS AREA	198.75 sqm
SALES AREA	97.64 sqm
STOCK CAPACITY	
FIRST FLOOR	
GROSS AREA	44.58 sqm
STOCK CAPACITY	
SECOND FLOOR	
GROSS AREA	32.3 sqm

APPROVED

ROSEMARY CARR	
RICHARD NEWMAN	
REGIONAL MANAGER	

REVISIONS

REV A 250500 PJS
REVISED AS BUILT

MARKETING SERVICES
CLARKS INTERNATIONAL
40 High Street
Somerset.
BA16 0YA
Telephone
Street 01458 443131
Fax 01458 842595

Clarks

THE CLARKS SHOP

15-17 WEST STREET
HAVANT
HANTS

HAVANT BOROUGH COUNCIL
DEVELOPMENT CONTROL
20 JAN 2010
RECEIVED

AS BUILT LAYOUT
& SHOPFRONT
GRADE C REFIT

SCALE 1:50
DATE MARCH 2000
DESIGNER D.B.FILBURN
DRAWN BY P.J.SCOTT
DRAWING NUMBER 32040001A

THIS DESIGN AND COPYRIGHT REMAINS THE PROPERTY OF CLARKS

C. & J. CLARK INTERNATIONAL LIMITED TRADING AS CLARKS INTERNATIONAL
REGISTERED OFFICE 40 HIGH STREET, SOMERSET.
REGISTERED NUMBER 141015 LONDON




SHOPFRONT ELEVATION

EXTEND FRONT WINDOW.
REPOSITION EXISTING DOORS
AND MATCH EXISTING
STALL RISERS




HANGING SIGN


REDECORATE EXISTING
HANGING SIGN CAMEO WHITE
AND SIGN WRITE LIGHT BRONZE
CLARKS LOGO ON EACH SIDE.
REDECORATE EXISTING BRACKET
LIGHT BRONZE.

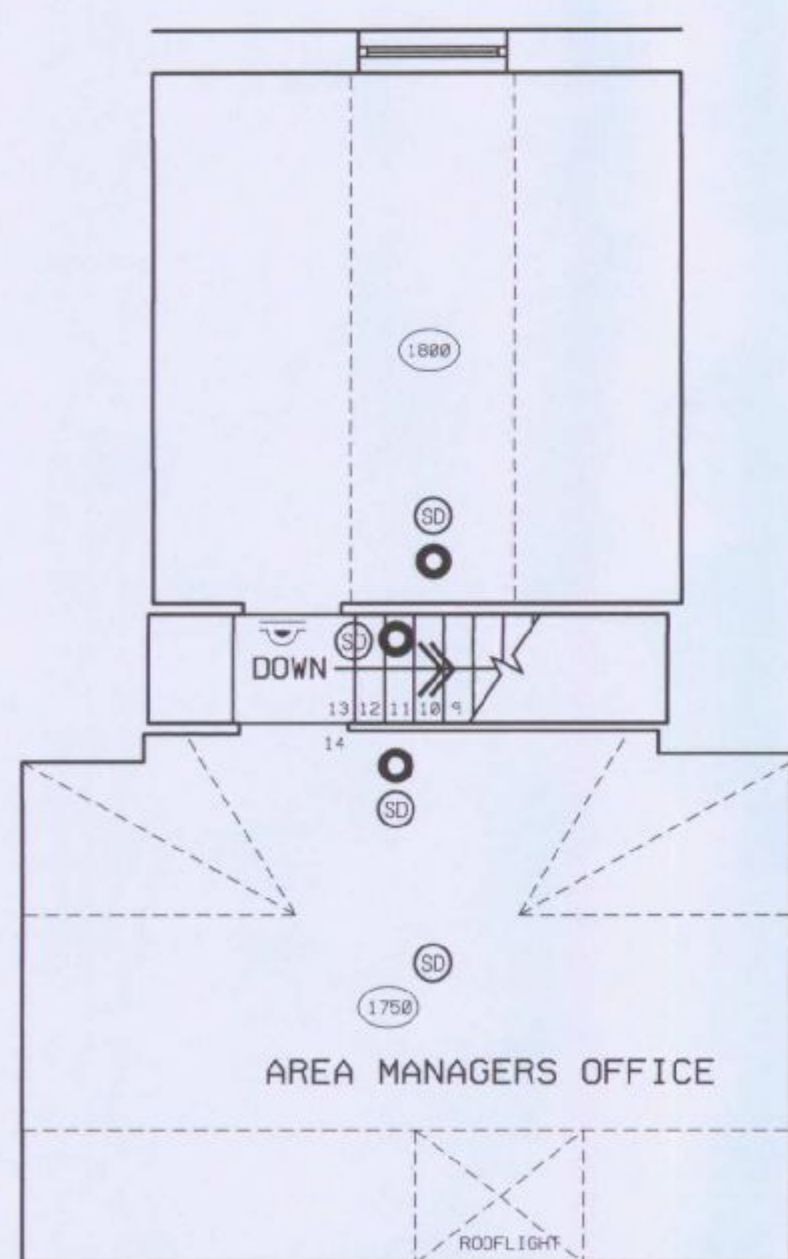

SECOND FLOOR PLAN
NO WORK TO THE THIS FLOOR

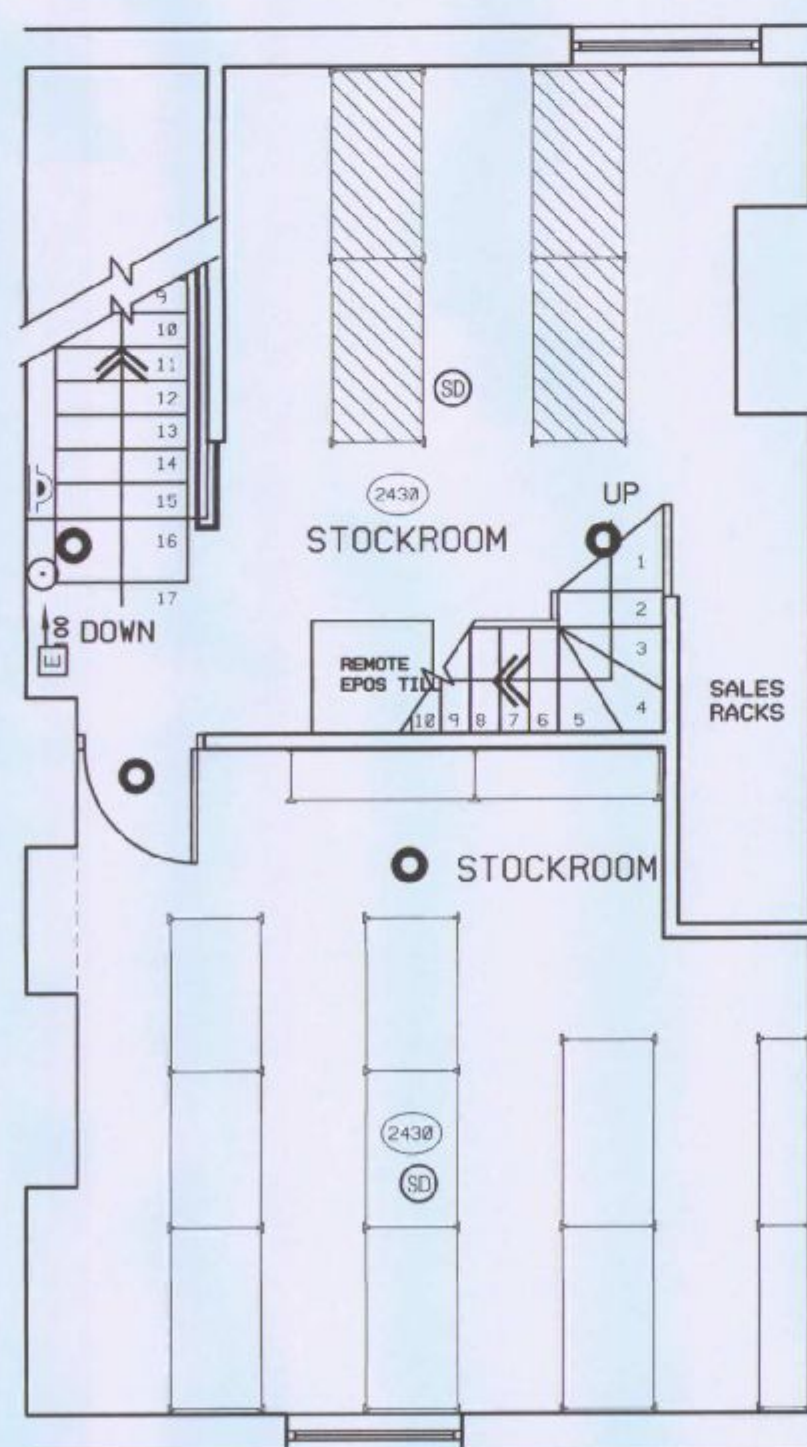

FIRST FLOOR PLAN

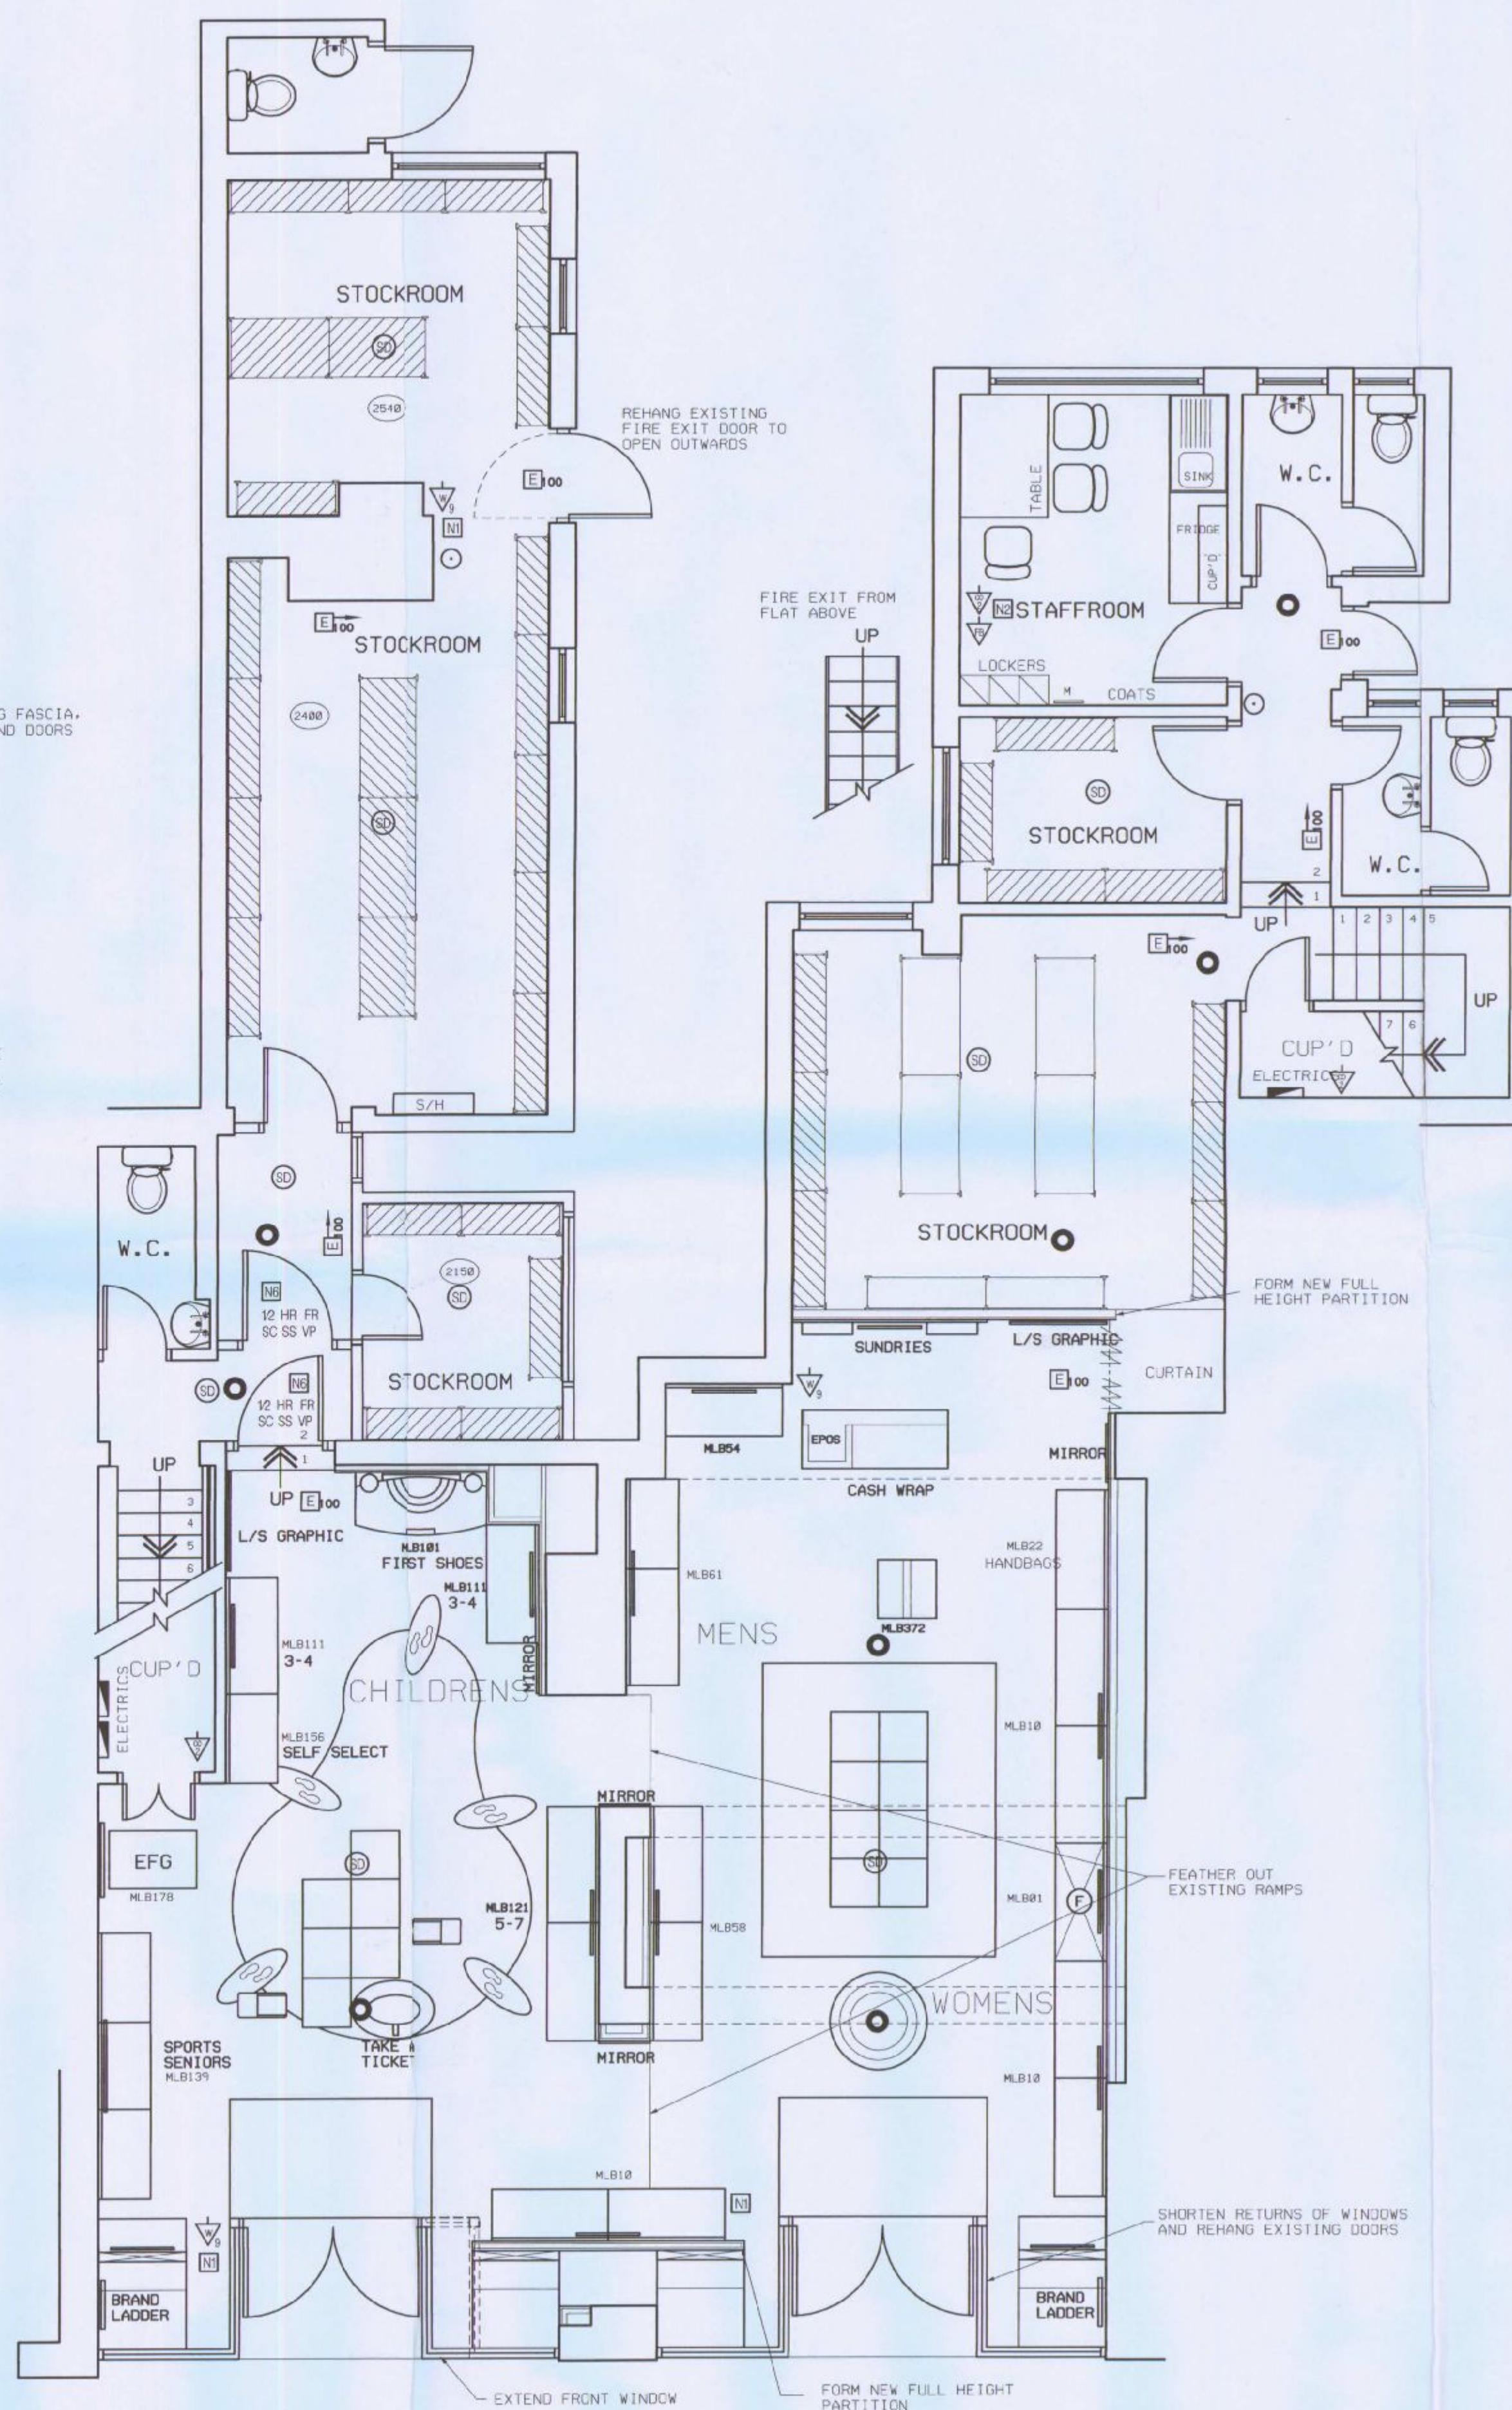

GROUND FLOOR PLAN