




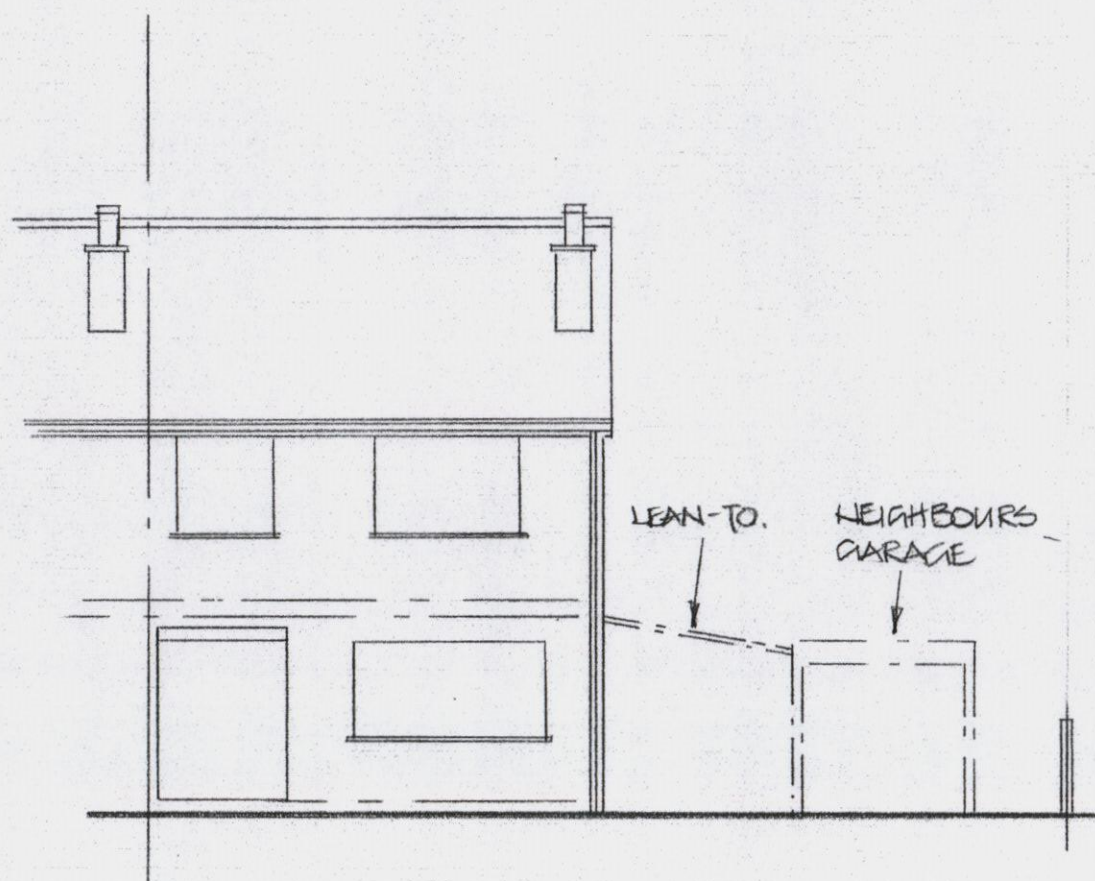


WEST ELEVATION

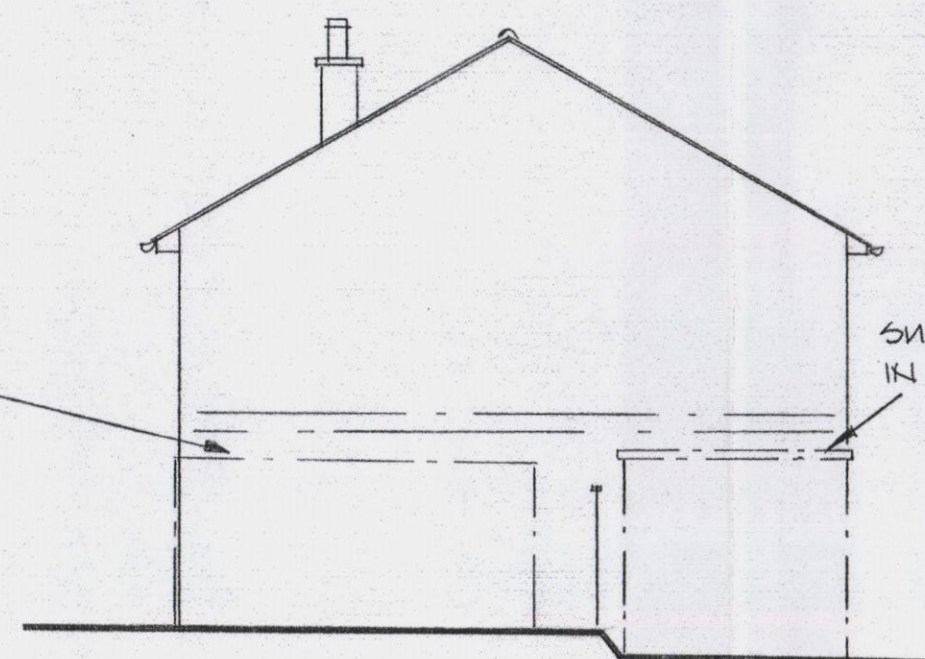

SOUTH ELEVATION

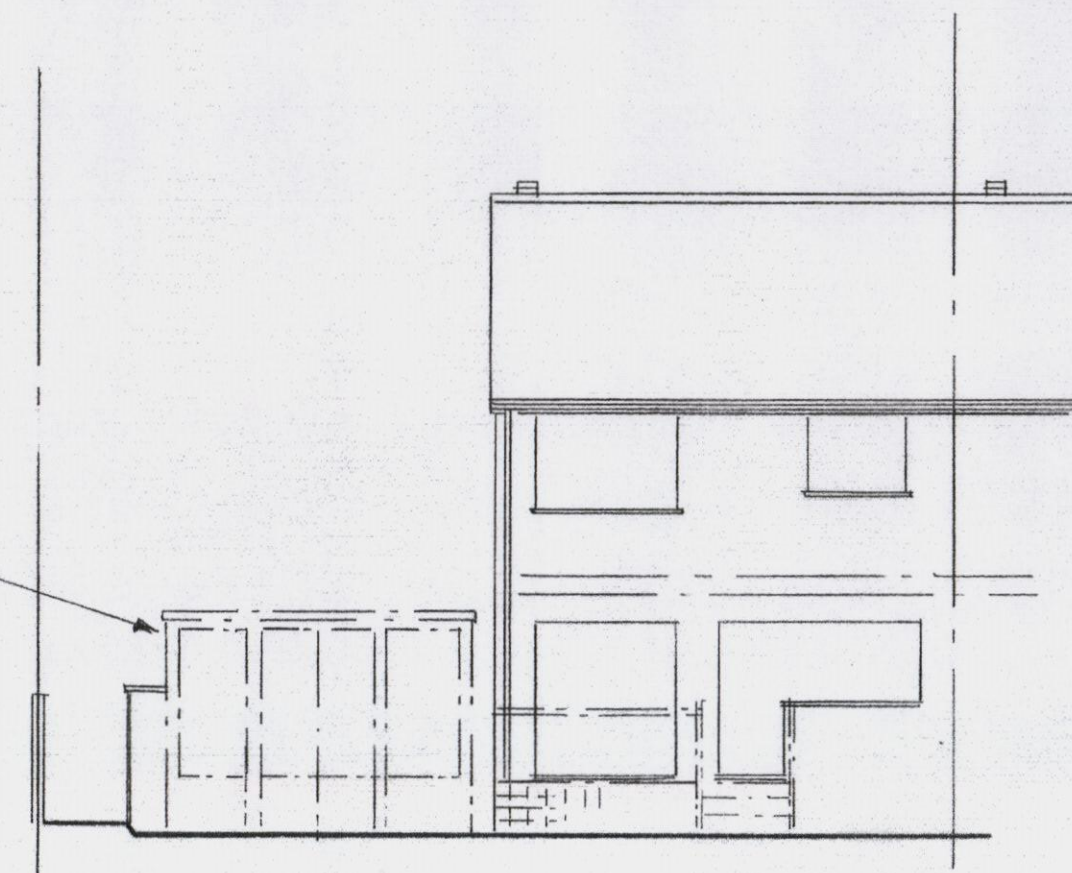

EAST ELEVATION

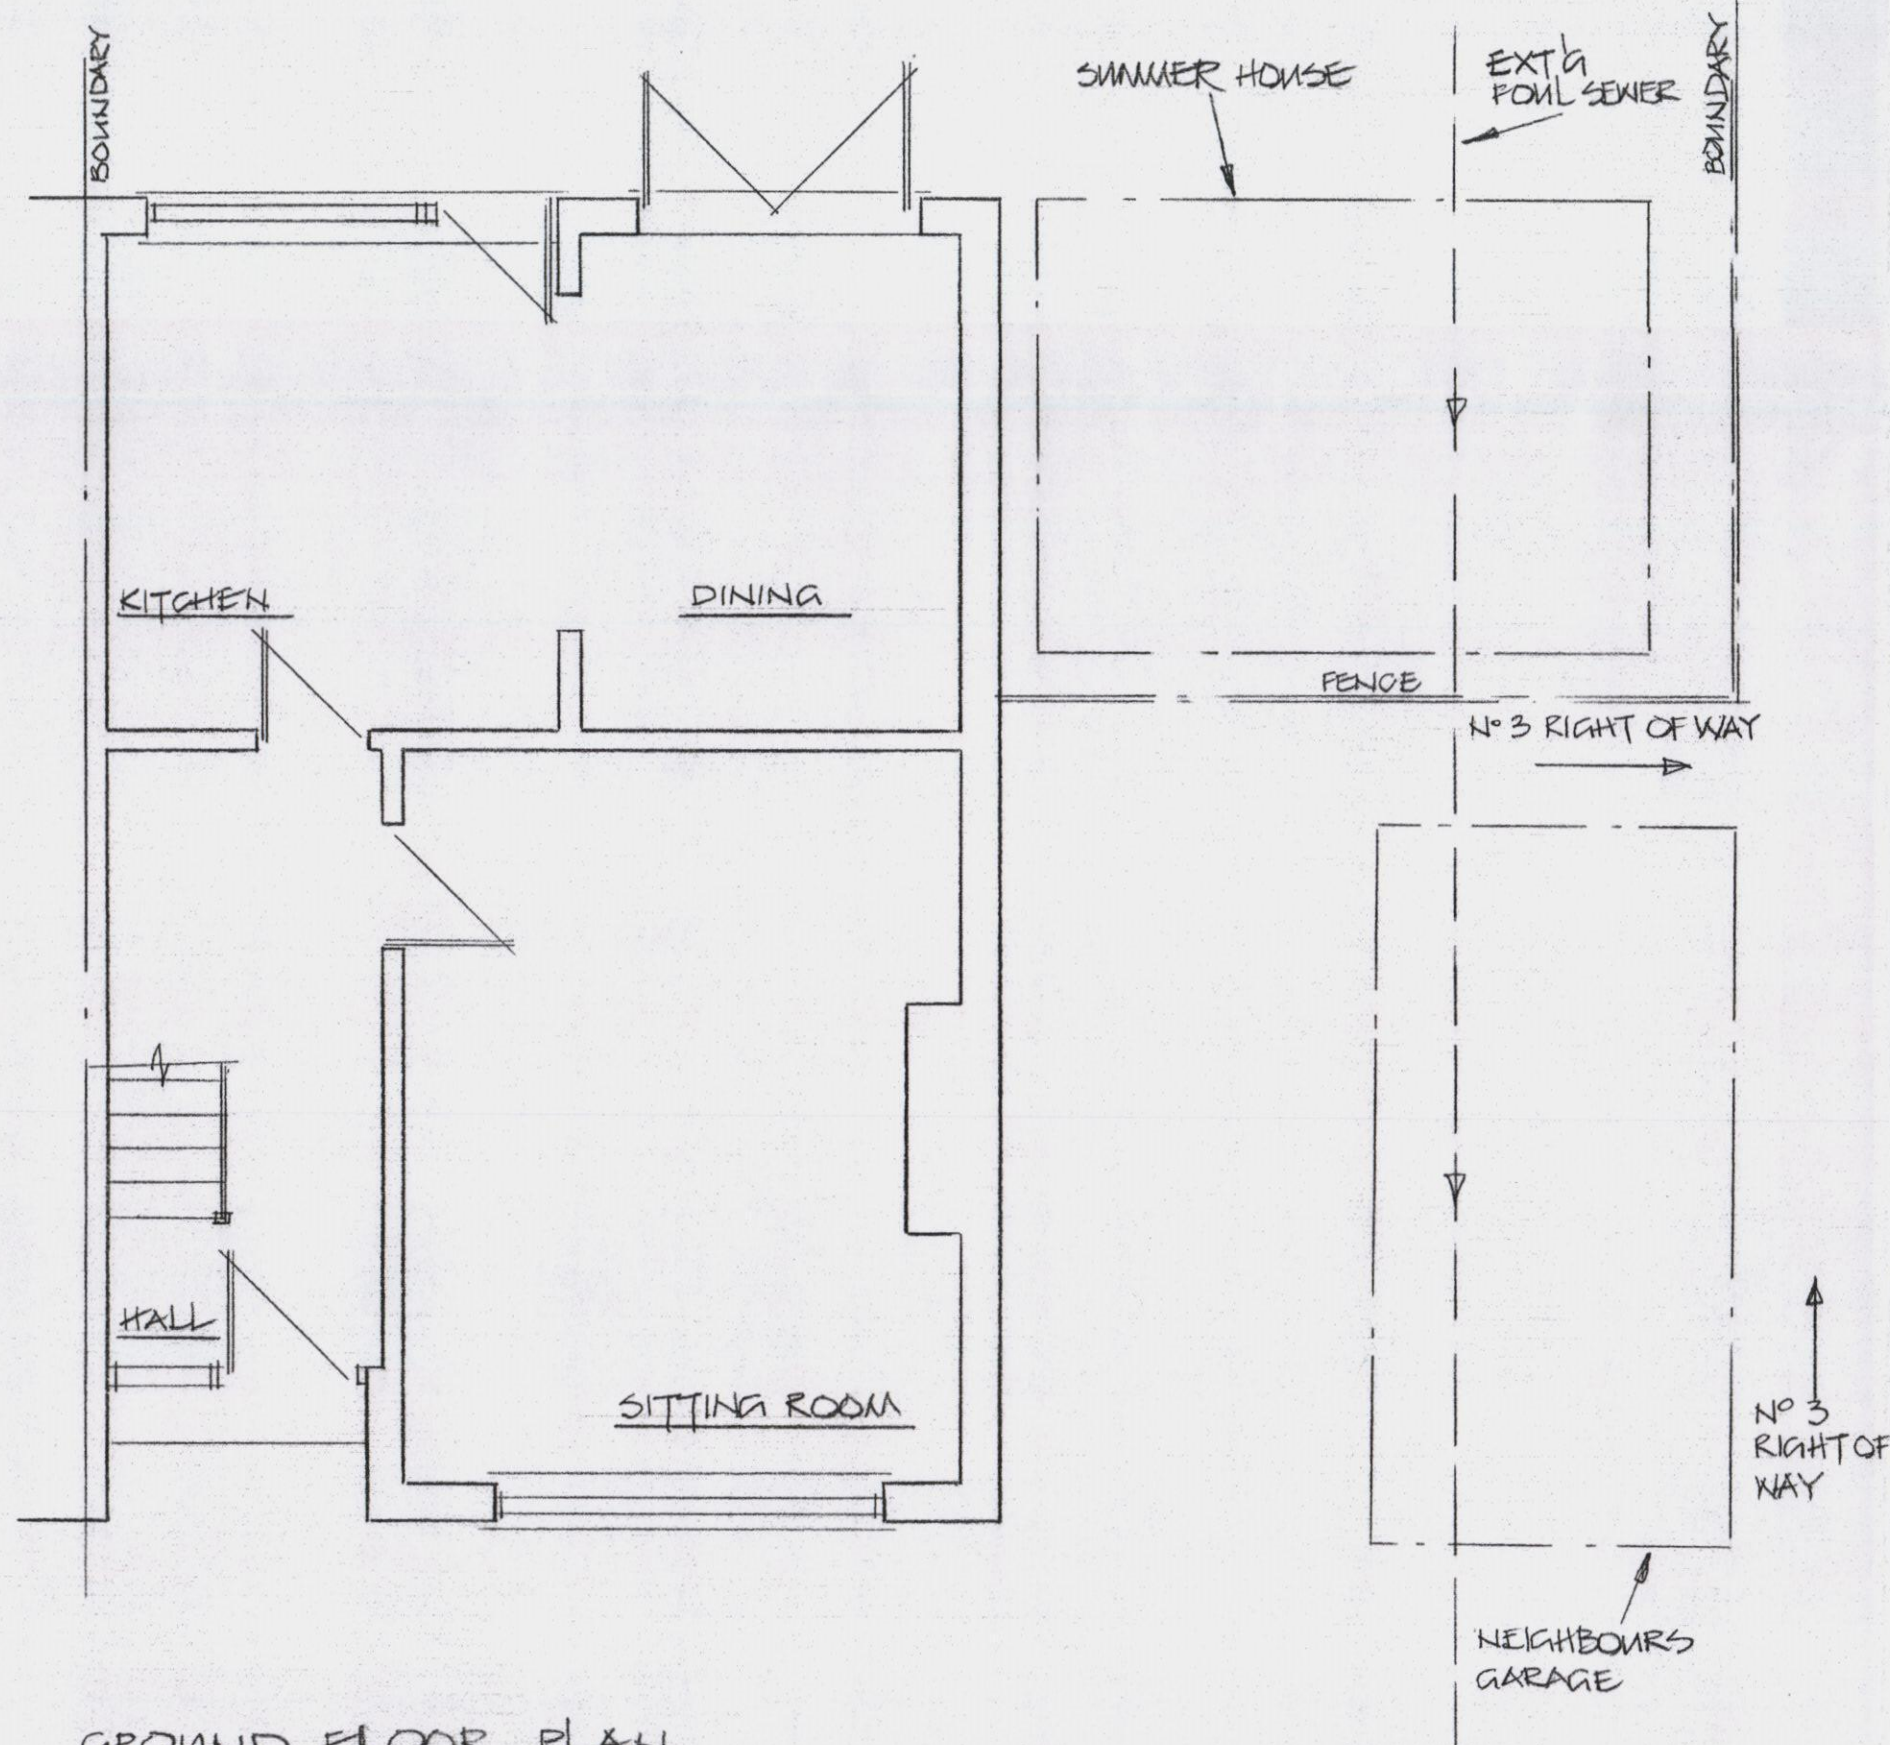

GROUND FLOOR PLAN



MRS M. ROBERTS

3 THE TRIREME
HAROLD TERRACE
BOSMERE ADNS
EMSWORTH
HANTS PO10 7N1

AS BUILT DRAWING

David Niven Design Ltd

davidnivedesign@gmail.com
07973 342 807 01243 330070
74 Westbourne Avenue,
Emsworth, Hampshire PO10 7QU



Architectural Design & Planning

1:100,50 OCT'12 12/921/1