



Finished floor and site levels. Scale 1 : 100





Proposed ^{East} ~~West~~ elevation
Scale 1 : 100

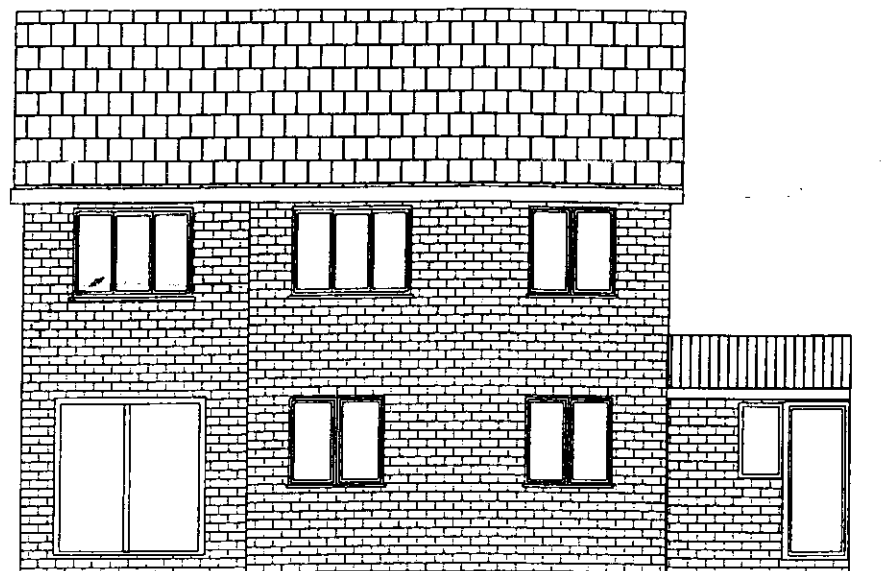

Proposed ^{West} ~~East~~ elevation
Scale 1 : 100

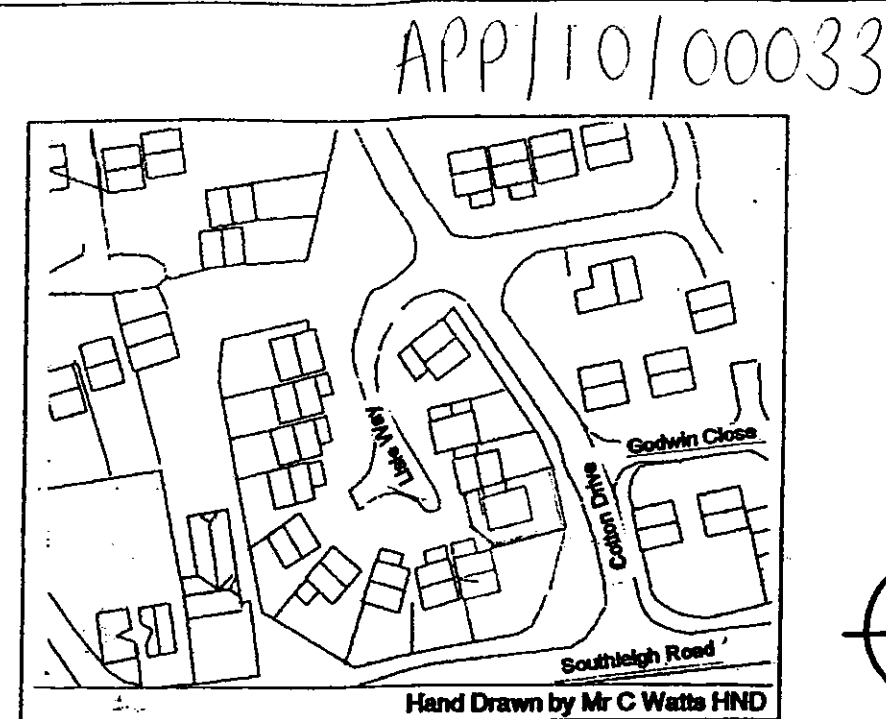

Location Plan Scale 1 : 1250

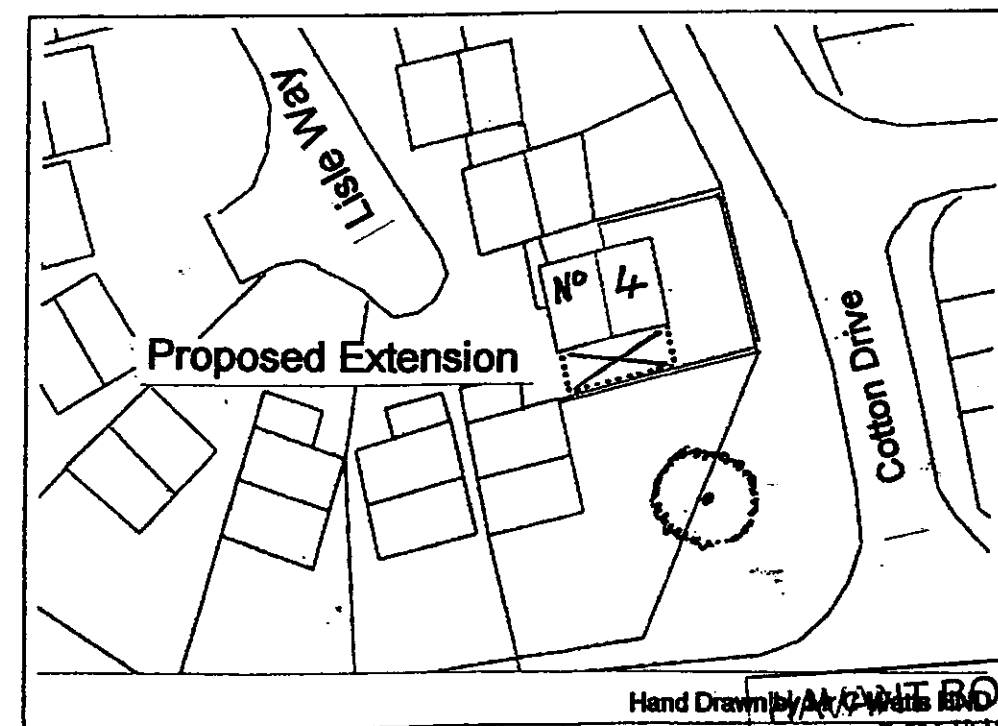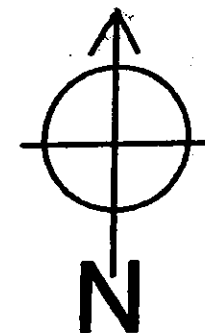

Block Plan Scale 1 : 500

Blue line indicates 6ft X 6ft wooden fence panels.

HANTS BOROUGH COUNCIL


20 APR 2010

RECEIVED


Proposed two Storey side Extension for
Mr & Mrs M Boxall
4 Lisle Way, Emsworth.
Hants, PO 10 7XN

Scale 1 : 100 (or as shown) Drawn of A3 paper
Amendments 19th April 2010 Plan 1 of 1


APP/10/00033

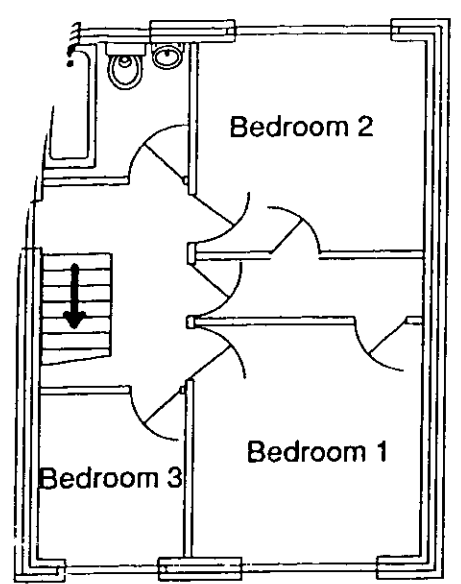

AM
C
F
Existing first floor
Scale 1 : 100

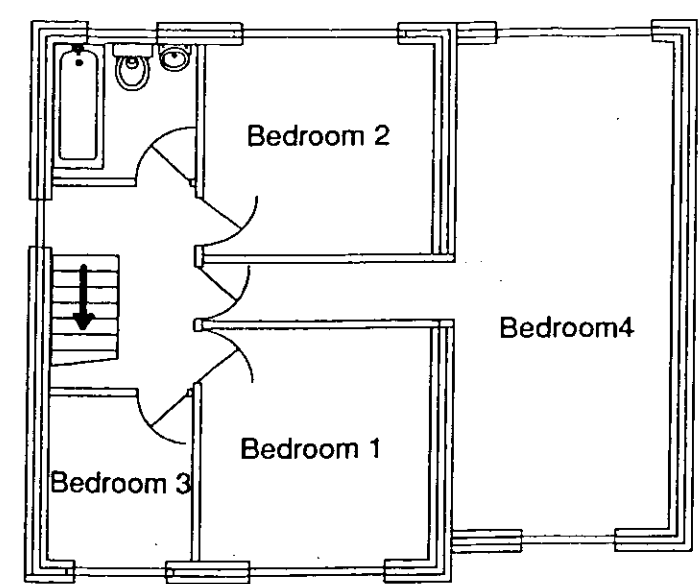


Proposed first floor
Scale 1 : 100

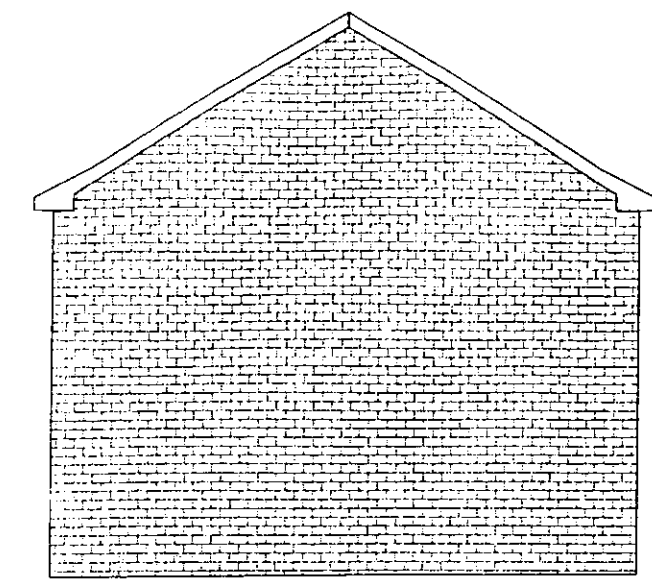


Existing South elevation
Scale 1 : 100




Existing ~~West~~ ^{East} elevation
Scale 1 : 100

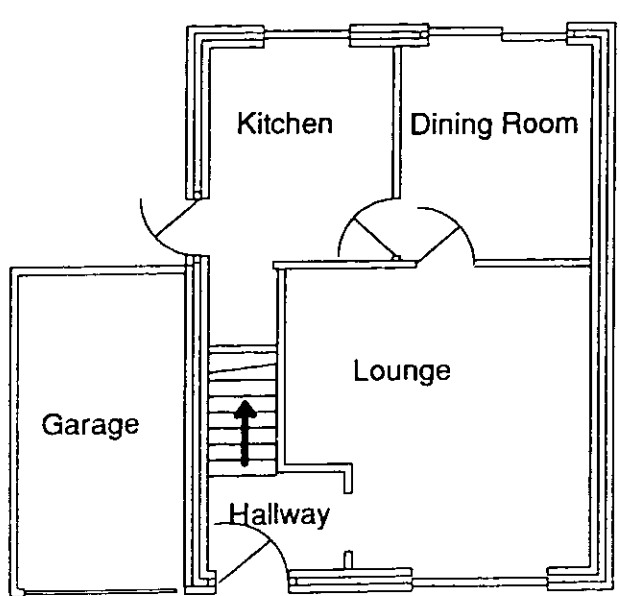

Existing ground floor
Scale 1 : 100

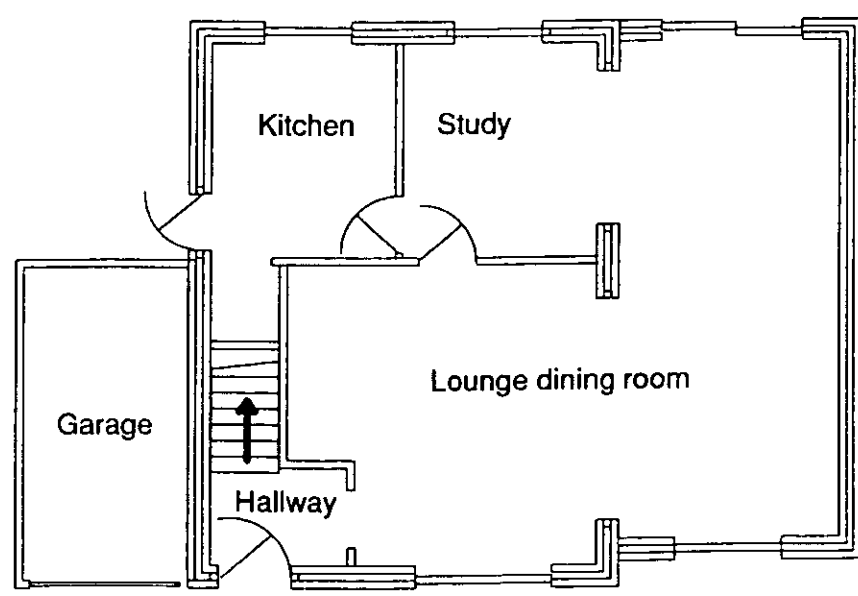


Proposed ground floor
Scale 1 : 100

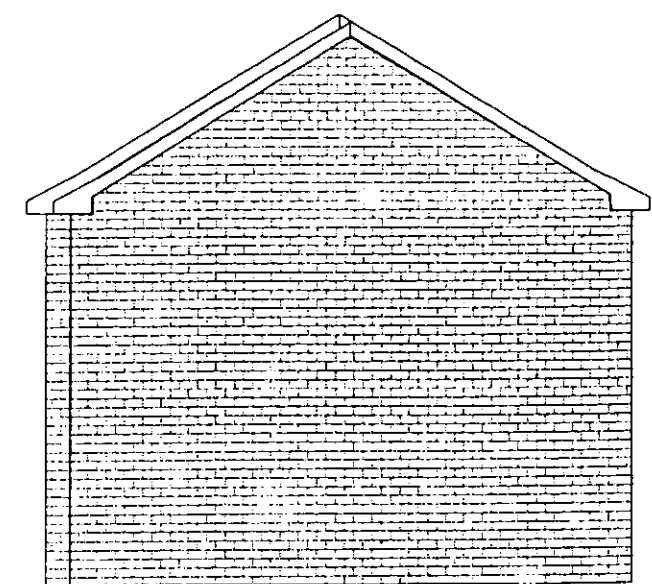

Proposed South elevation
Scale 1 : 100



Existing ~~East~~ ^{West} elevation
Scale 1 : 100

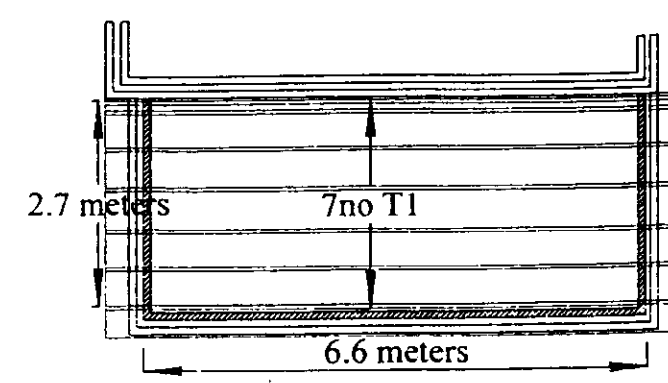

Trusses designed by bespoke truss makers.
Scale 1 : 100

HAVANT BOROUGH
COUNCIL
20 APR 2010
RECEIVED

Proposed two Storey side Extension for
Mr & Mrs M Boxall
4 Lisle Way, Emsworth,
Hants, PO 10 7XN
Scale 1 : 100 (or as shown) Drawn of A3 paper
Amended 19th April 2010 Plan 2 of 2