


AMENDED


PERMIT

10/71876/000

North

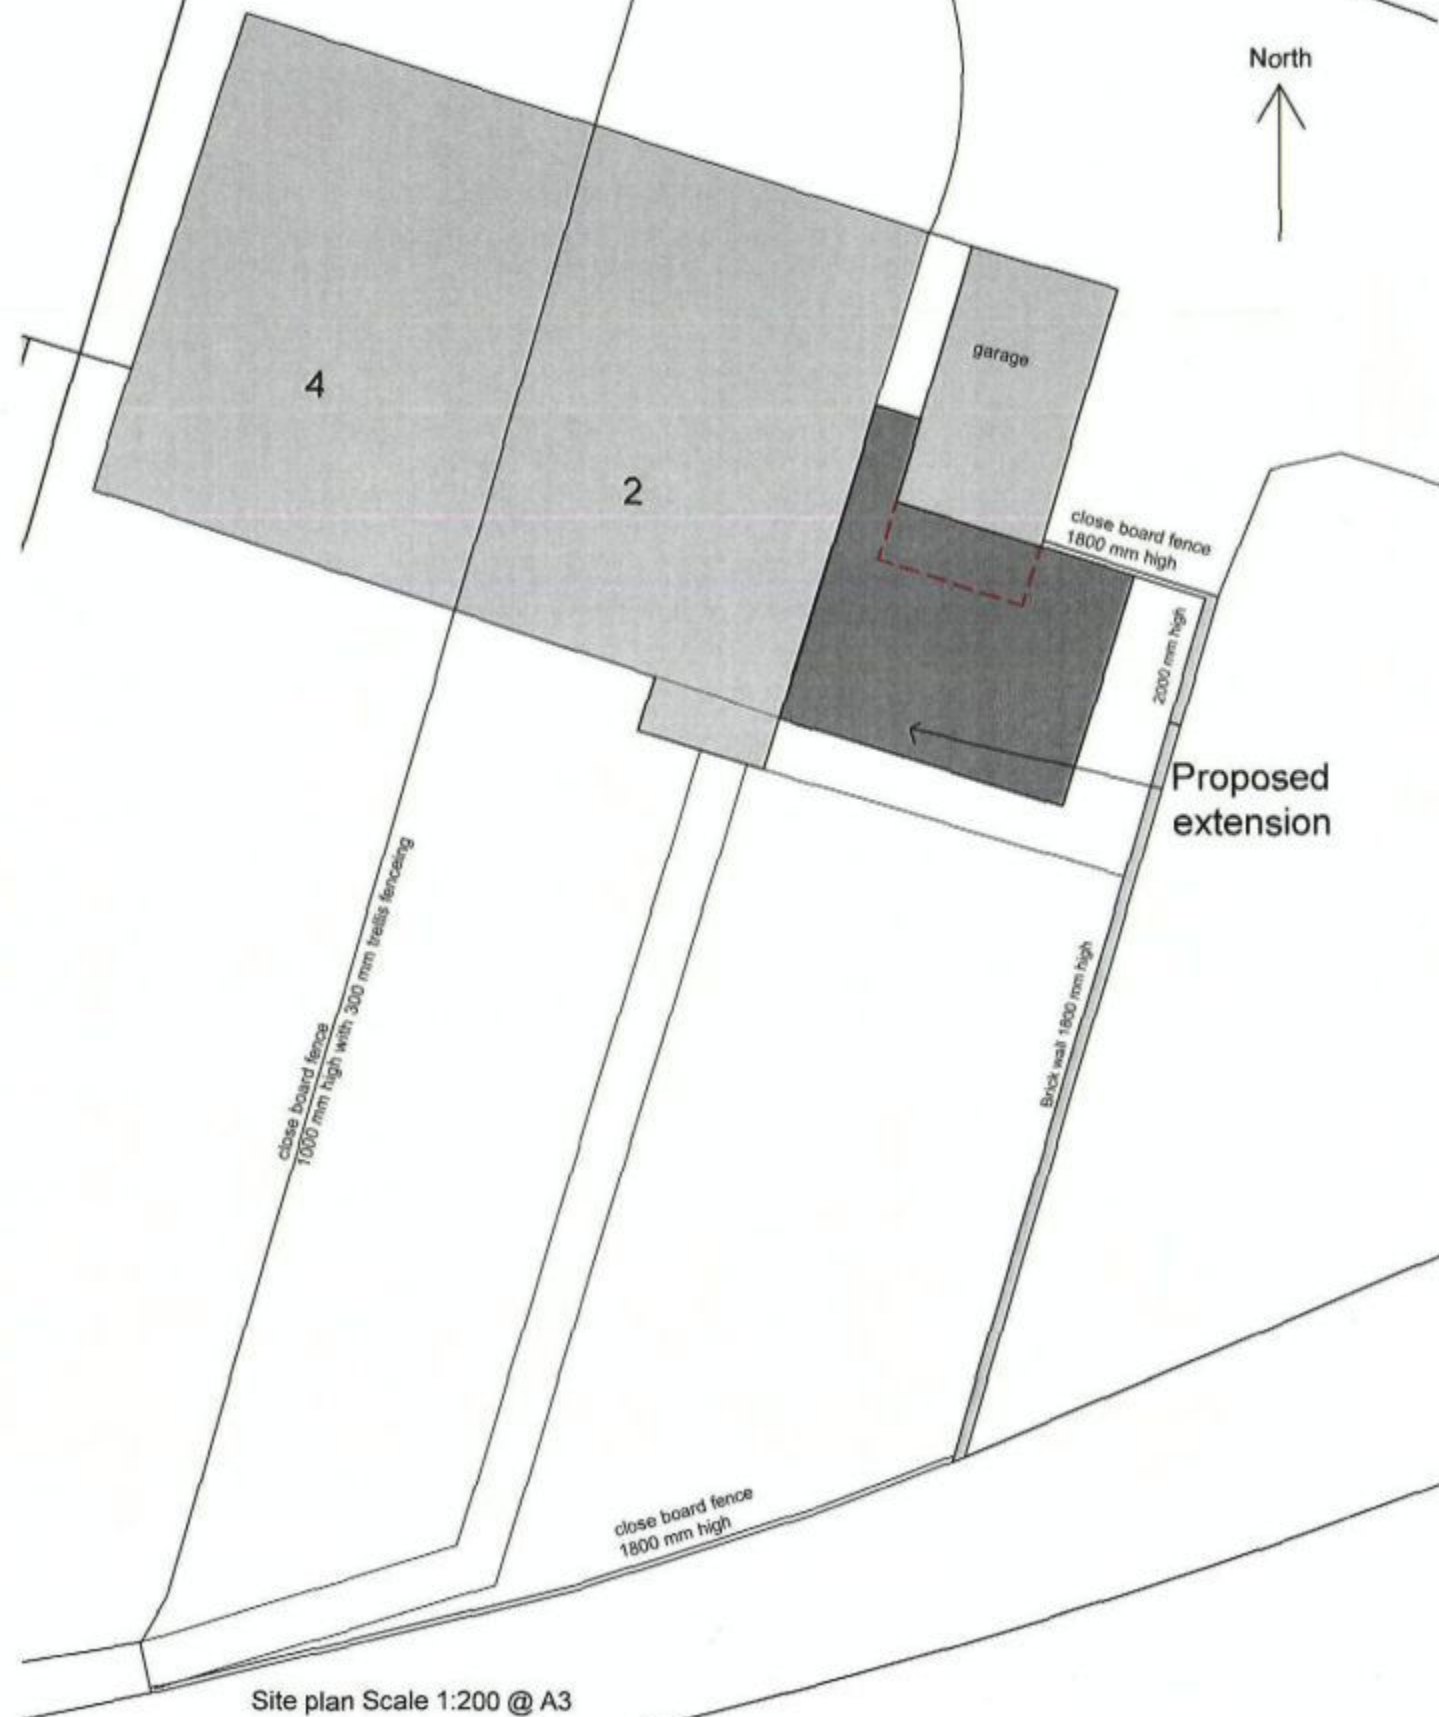

Site plan Scale 1:200 @ A3

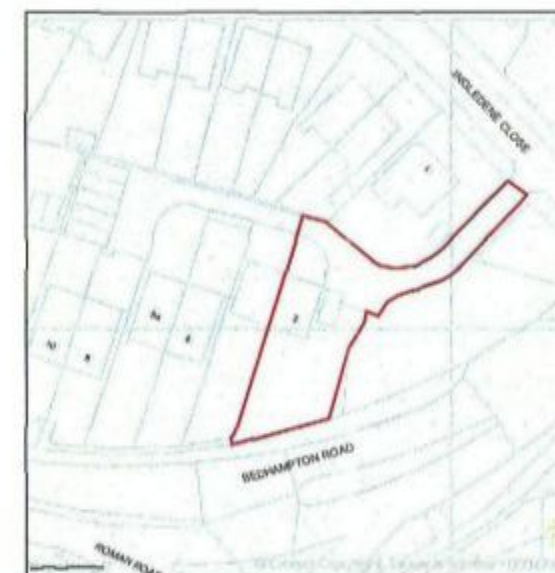

Location plan Scale 1:1125 @ A3
Streetwise Maps Ltd
License No. 100047474

B.O.H.
PERMIT

HAVANT BOROUGH
COUNCIL
13 APR 2010
RECEIVED

rev e - redline amended in accordance with
current title deeds 12.04.10
rev d - amended to LA recommendations 19.03.10
rev c - amended to LA recommendations 03.03.10
rev b - amended to clients requirements 18.01.10
rev a - amended to clients requirements 11.11.09

Site : 2 Bedhampton Road, Bedhampton
Hants.
Drawing : site plan and location plan
Scale : as stated
Date : Oct 2009