


Existing Elevation-Left side WEST


Existing Elevation-Front SOUTH

Existing Elevation-Rear NORTH

Existing Elevation-Right side EAST

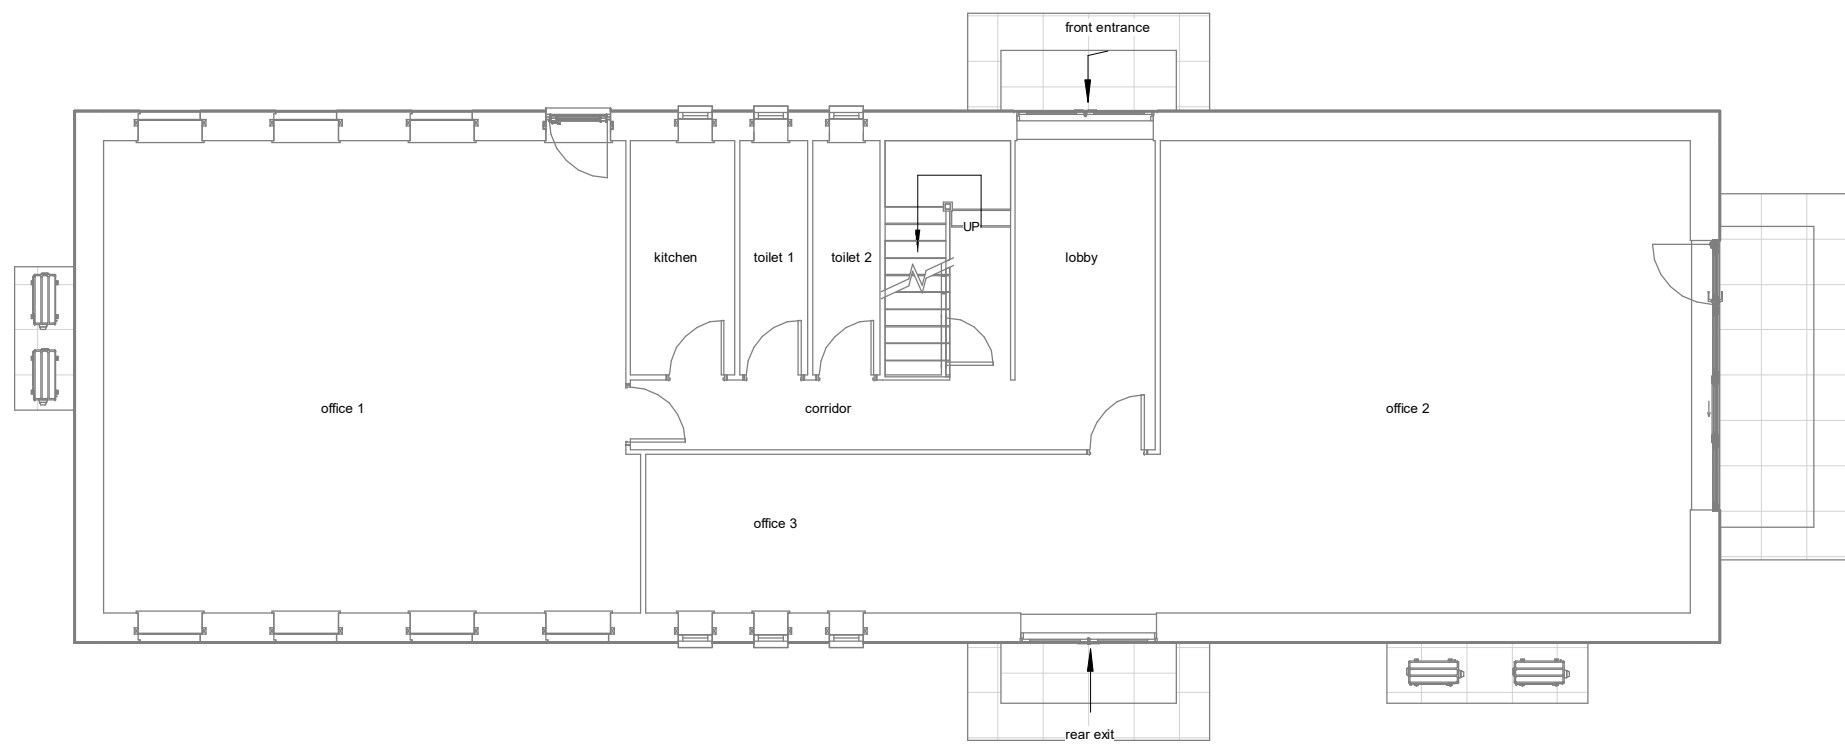

Existing Ground Floor

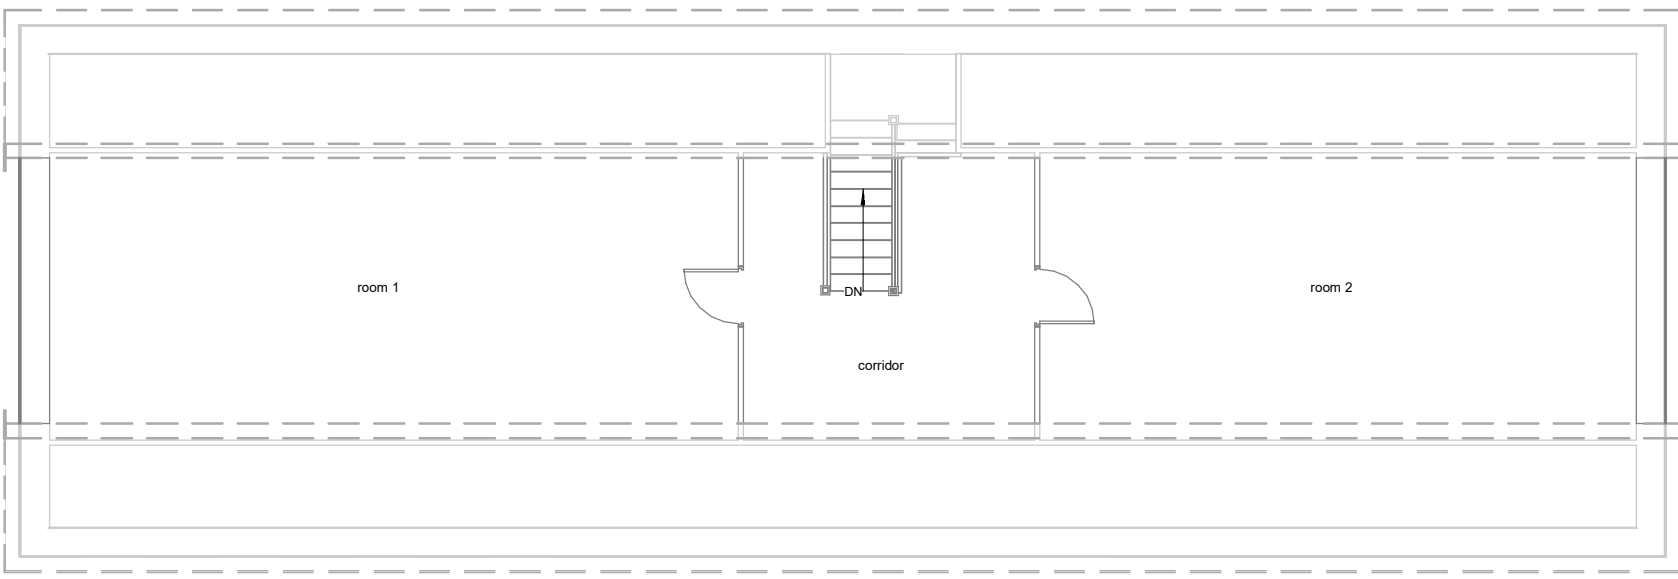

Existing First Floor




Proposed/As Built Elevation-Left side WEST


Proposed/As Built Elevation-Front SOUTH

Proposed/As Built Elevation-Rear NORTH

Proposed/As Built Elevation-Right side EAST

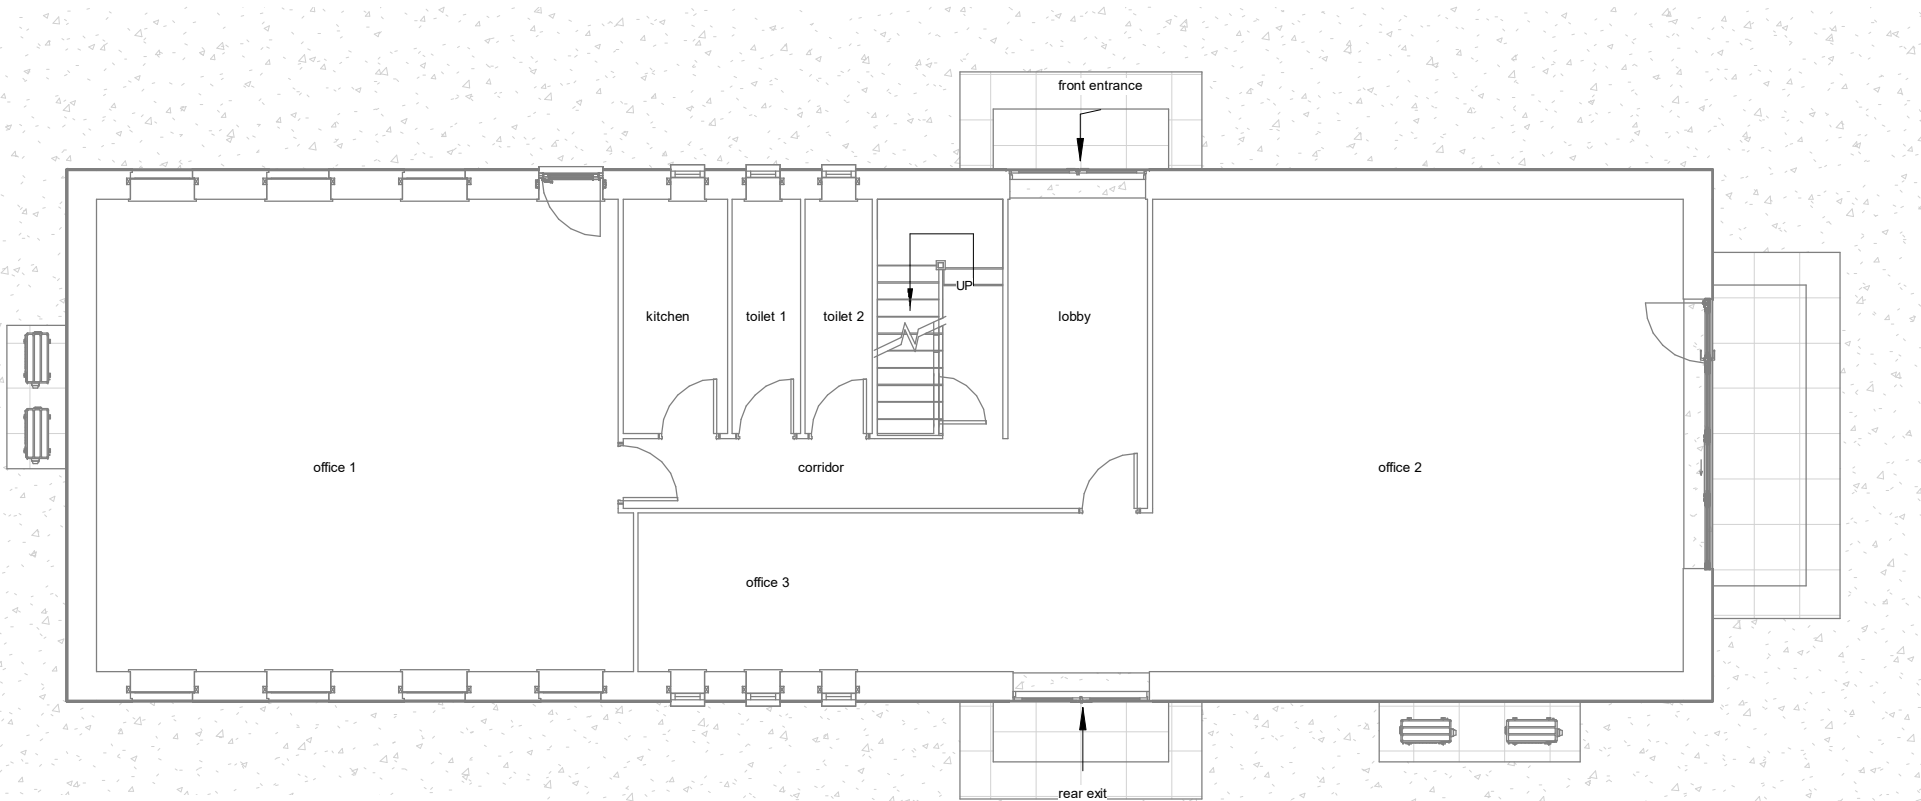

Proposed/As Built Ground Floor

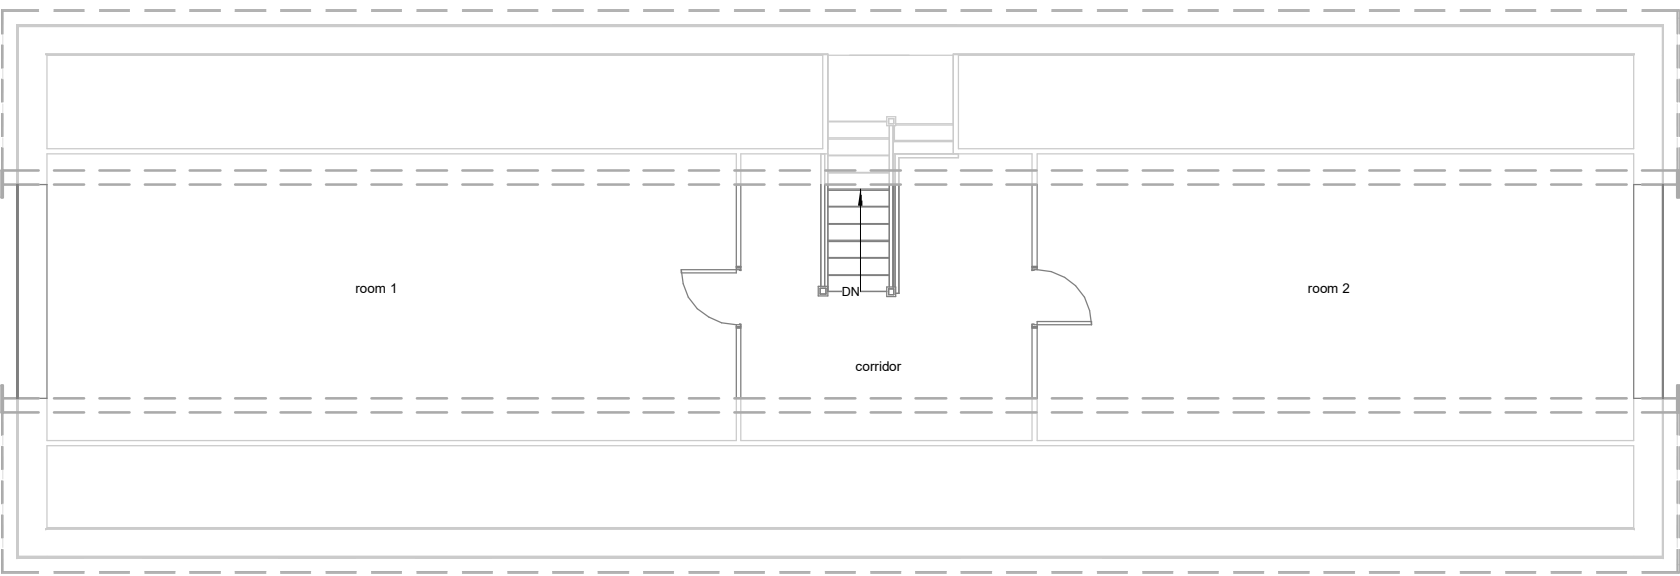

Proposed/As s Built First Floor

Boat Shed 144.5m2
Office Ground Floor 131.8m2
Office First floor @ 1500mm 59m2



www.parkersdesign.co.uk

info@parkersdesign.co.uk

Tel: 07776 008822

1:500		50
1:200		20
1:100		10
1:50		5


All measurement to be checked on site prior to any comment

Parkers Design Limited - No.3 - PO9 6AH

PROJECT	Yachthaven, Copse Lane PO11 0BF		
SHEET	Office		

CLIENT	Alpine Homes		
Date	Issue Date	SCALE (@ A1)	1:100
Drawn by	SW	DRAWING NUMBER	REV
Checked by	SR	P 1	


Project Number

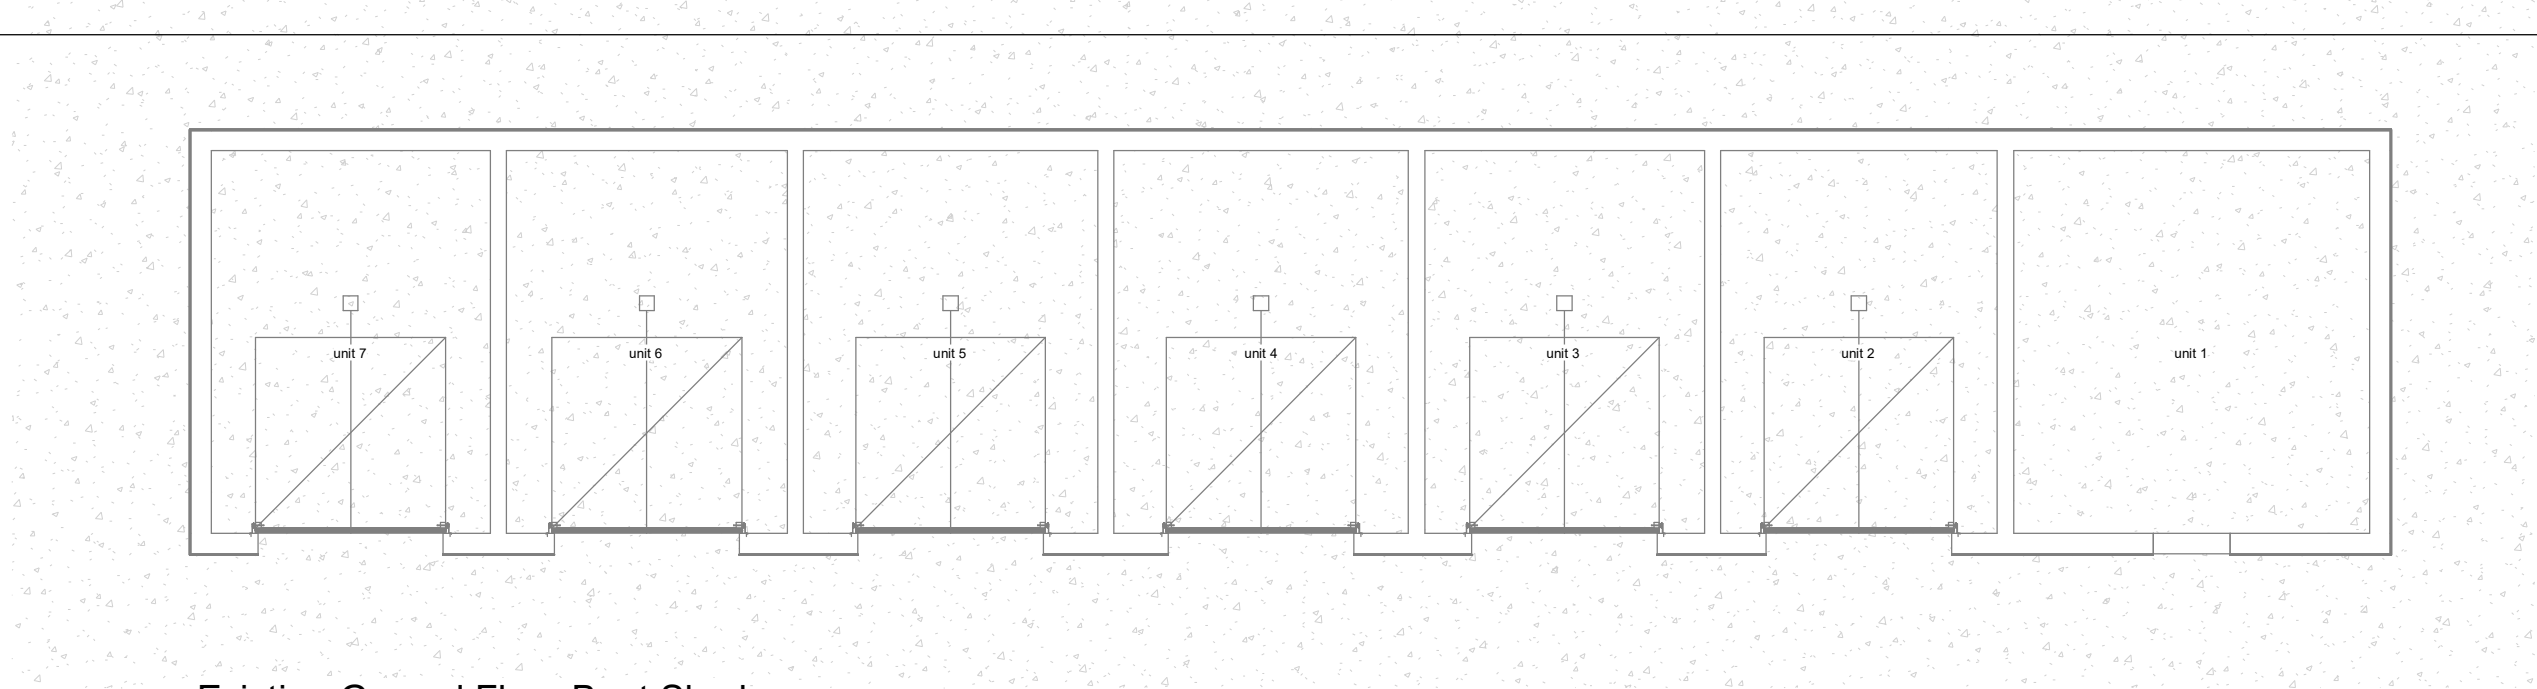


Existing Ground Floor Boat Shed




Existing Left Side Elevation Boat Shed SOUTH WEST

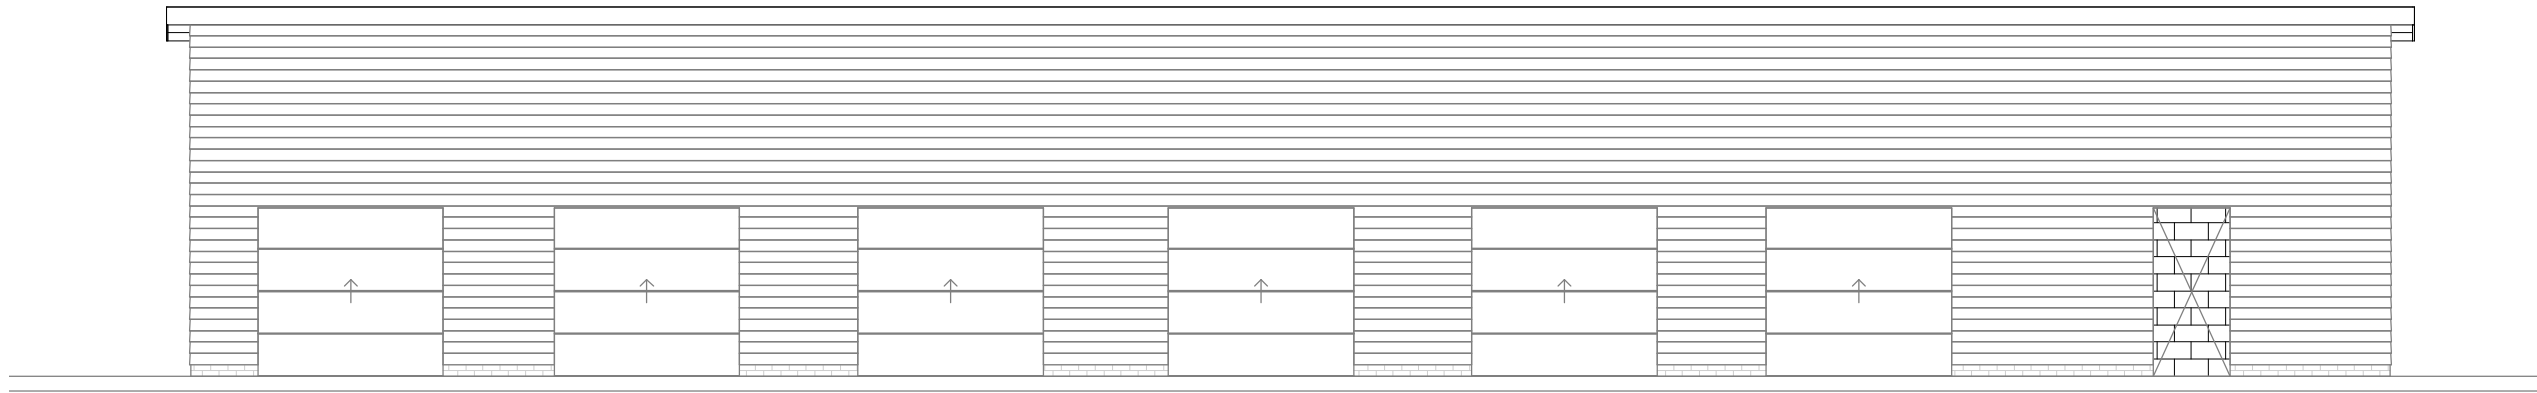


Existing Front Boat Shed SOUTH EAST

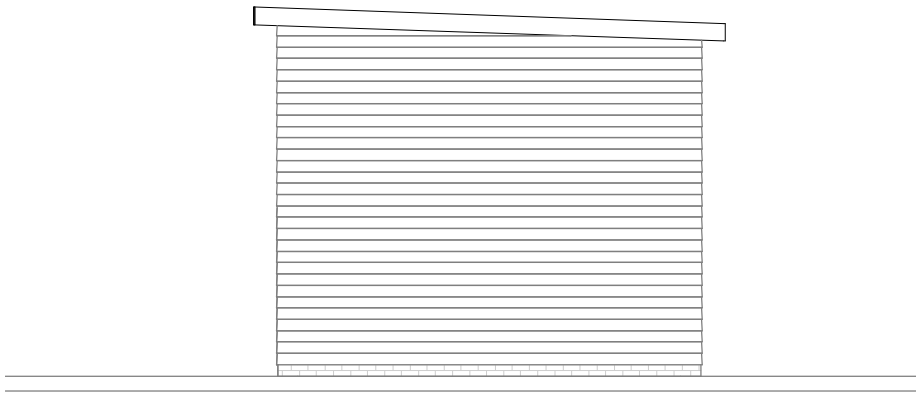

Existing Right side Boat Shed NORTH EAST

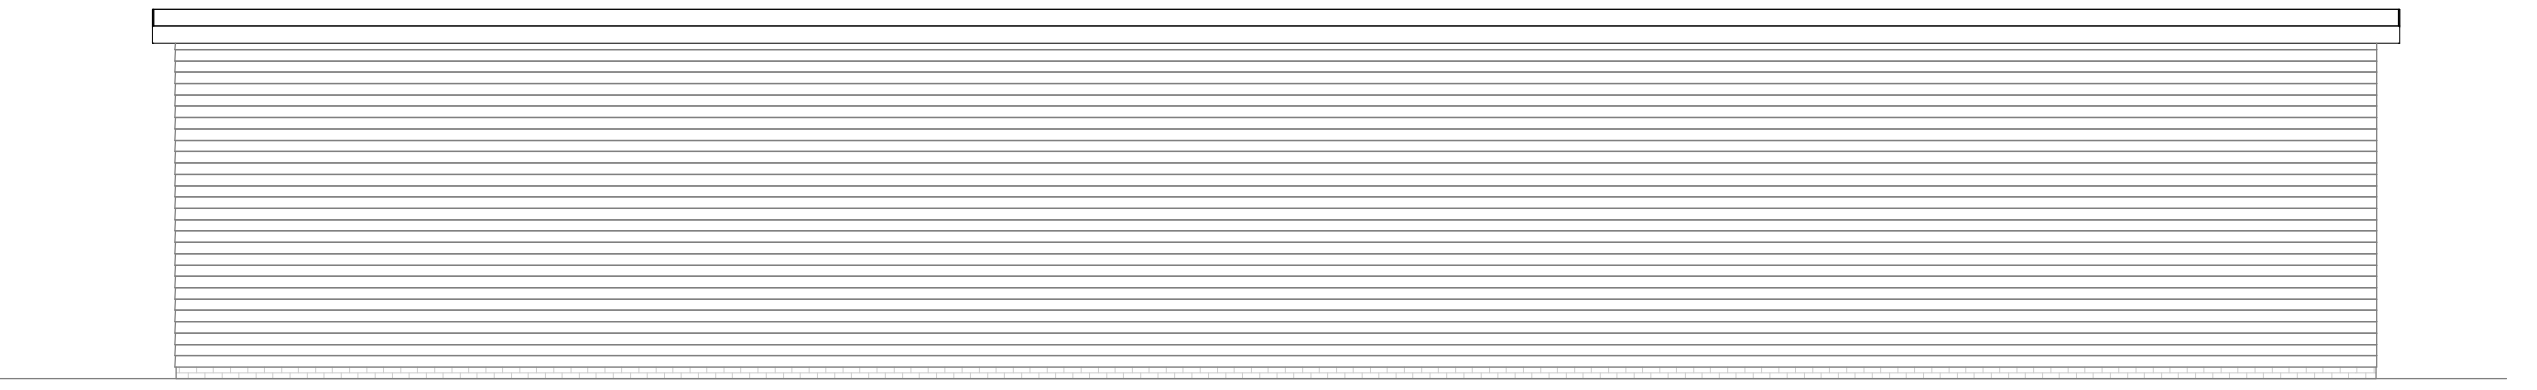


Existing Rear Boat Shed NORTH WEST

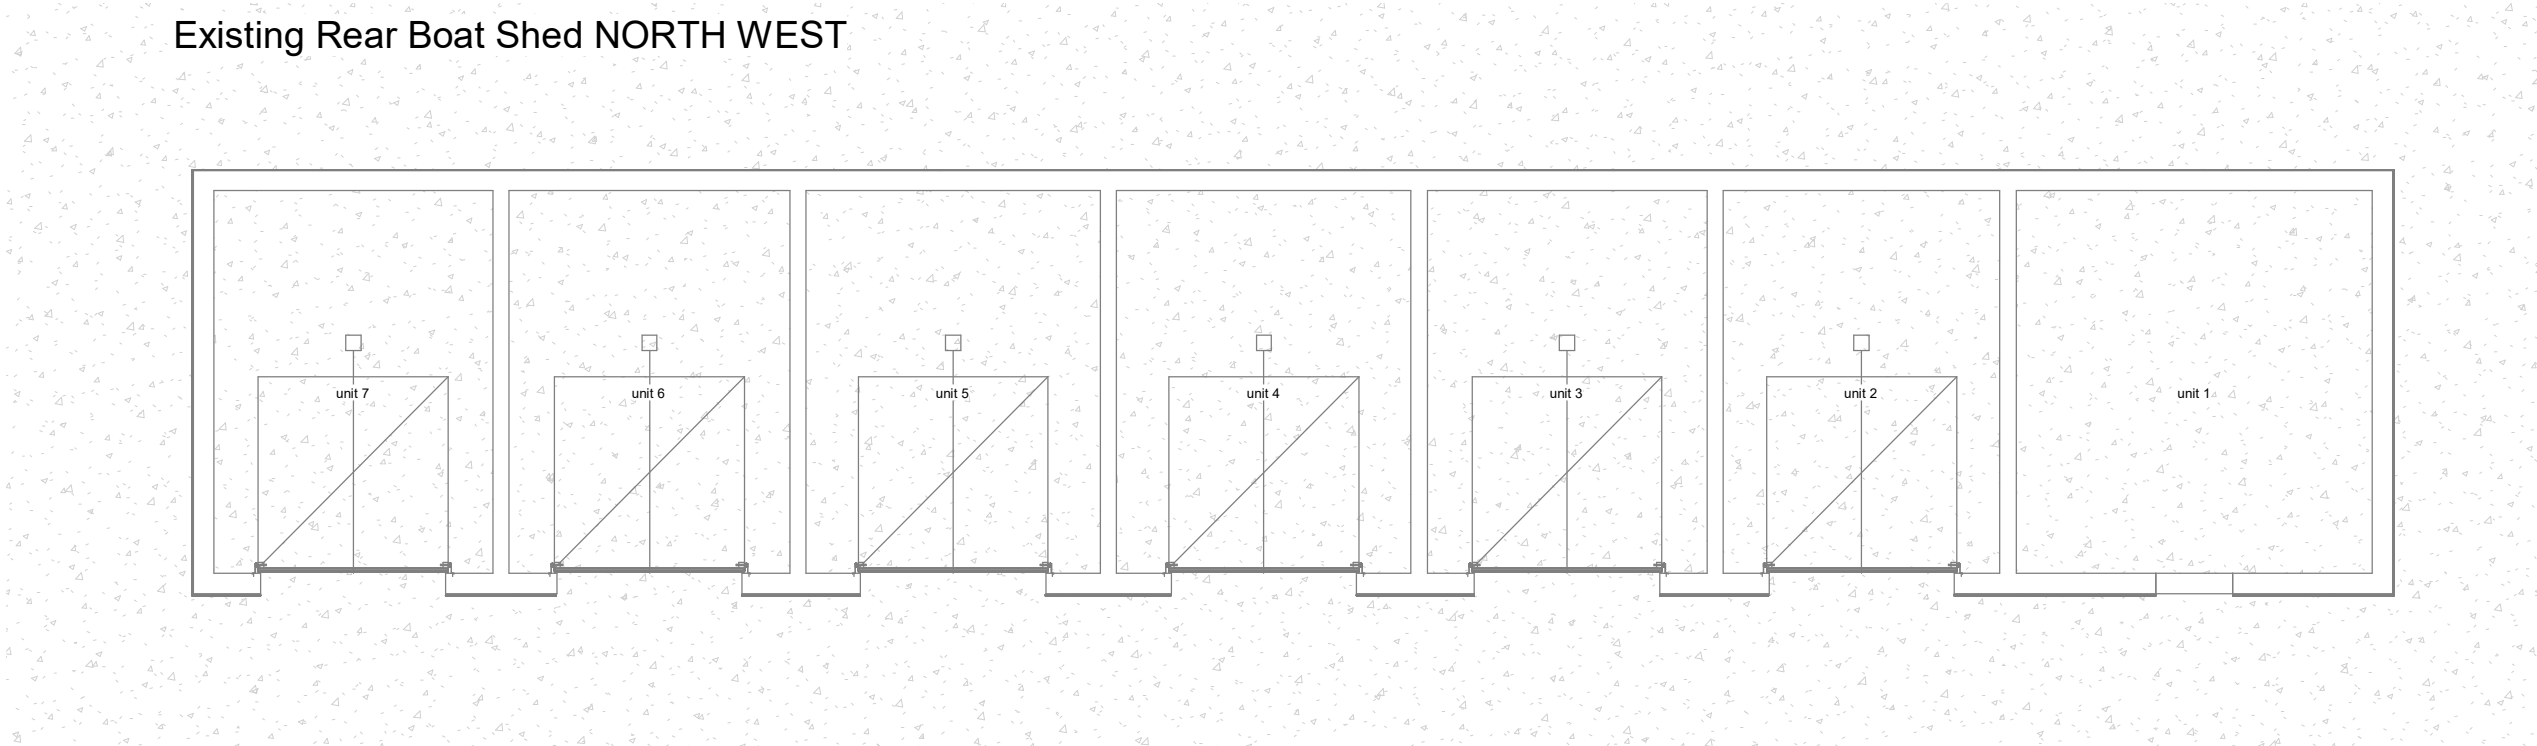


Proposed/As Built Ground Floor Boat Shed




Proposed/As Built Left Side Boat Shed SOUTH WEST

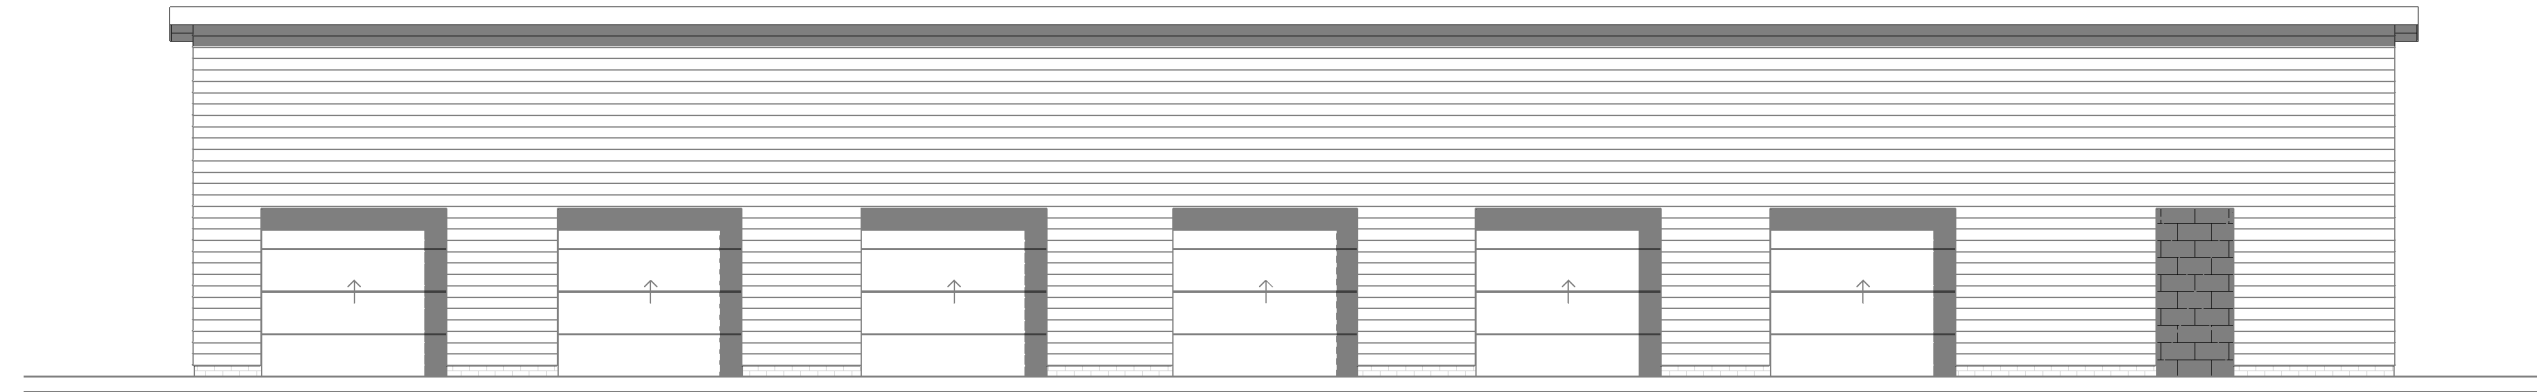

Proposed/As Built Front Boat Shed SOUTH EAST

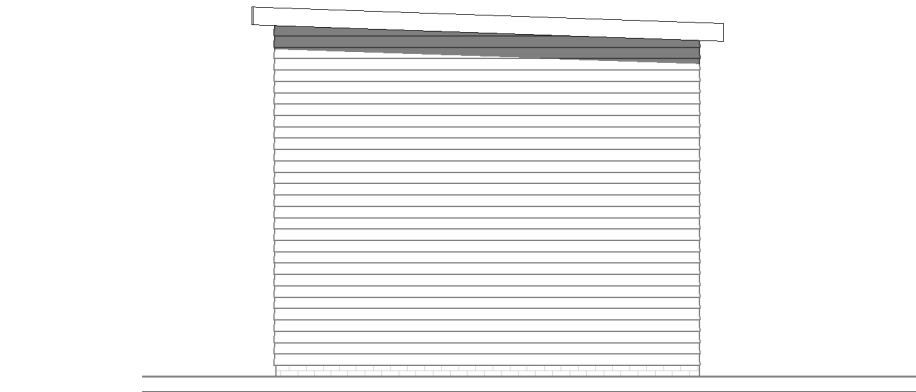

Proposed/As Built Righth Side Boat Shed NORTH EAST

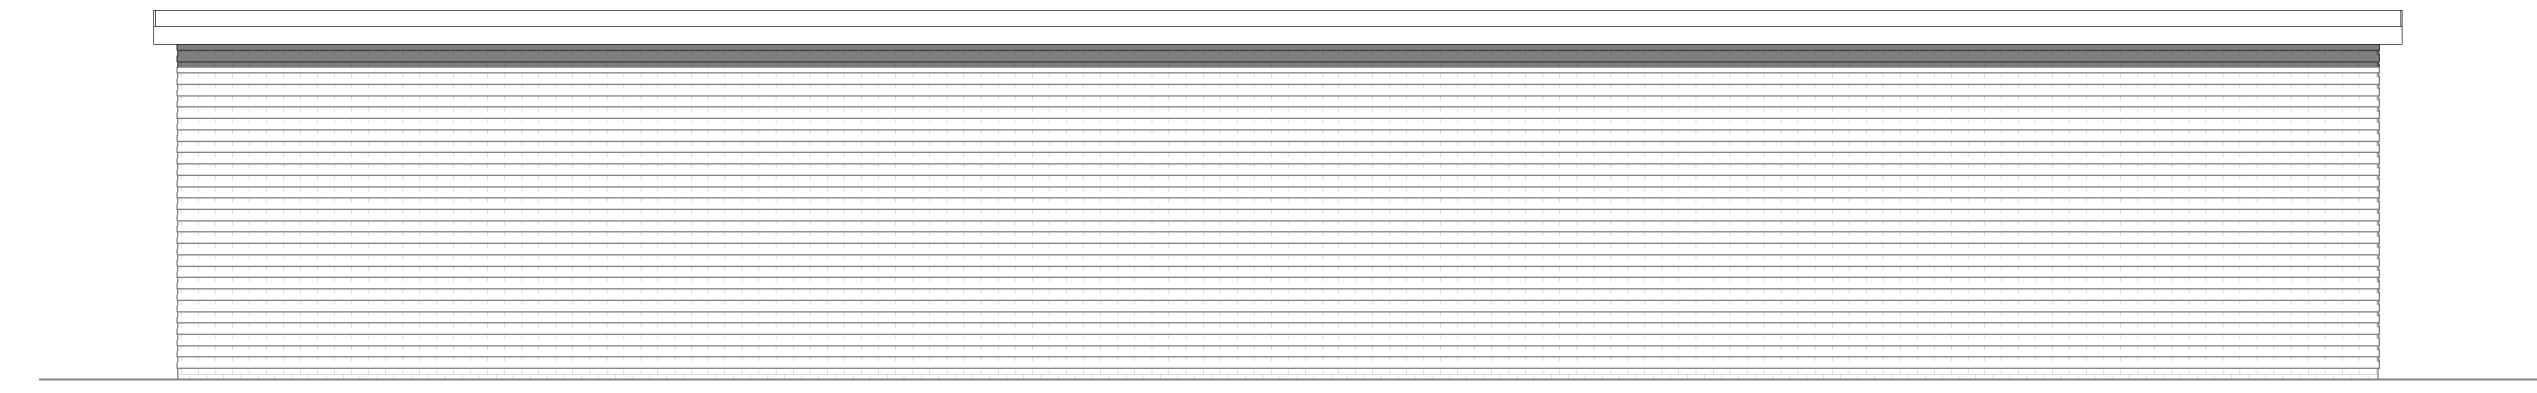

Proposed/As Built Rear Boat Shed NORTH WEST



www.parkersdesign.co.uk
info@parkersdesign.co.uk
Tel: 07776 00822

1:500		50
1:200		20
1:100		10
1:50		5

All measurement to be checked on site prior to any commenment

Parkers Design Limited - No.3 - PO9 6AH

PROJECT Yachthaven, Copse Lane
PO11 0BF

SHEET Boat Shed

CLIENT Alpine Homes

Date Issue Date SCALE (@ A1) 1:100

Drawn by SW

DRAWING NUMBER

REV

Checked by SR

P 2

Project Number