




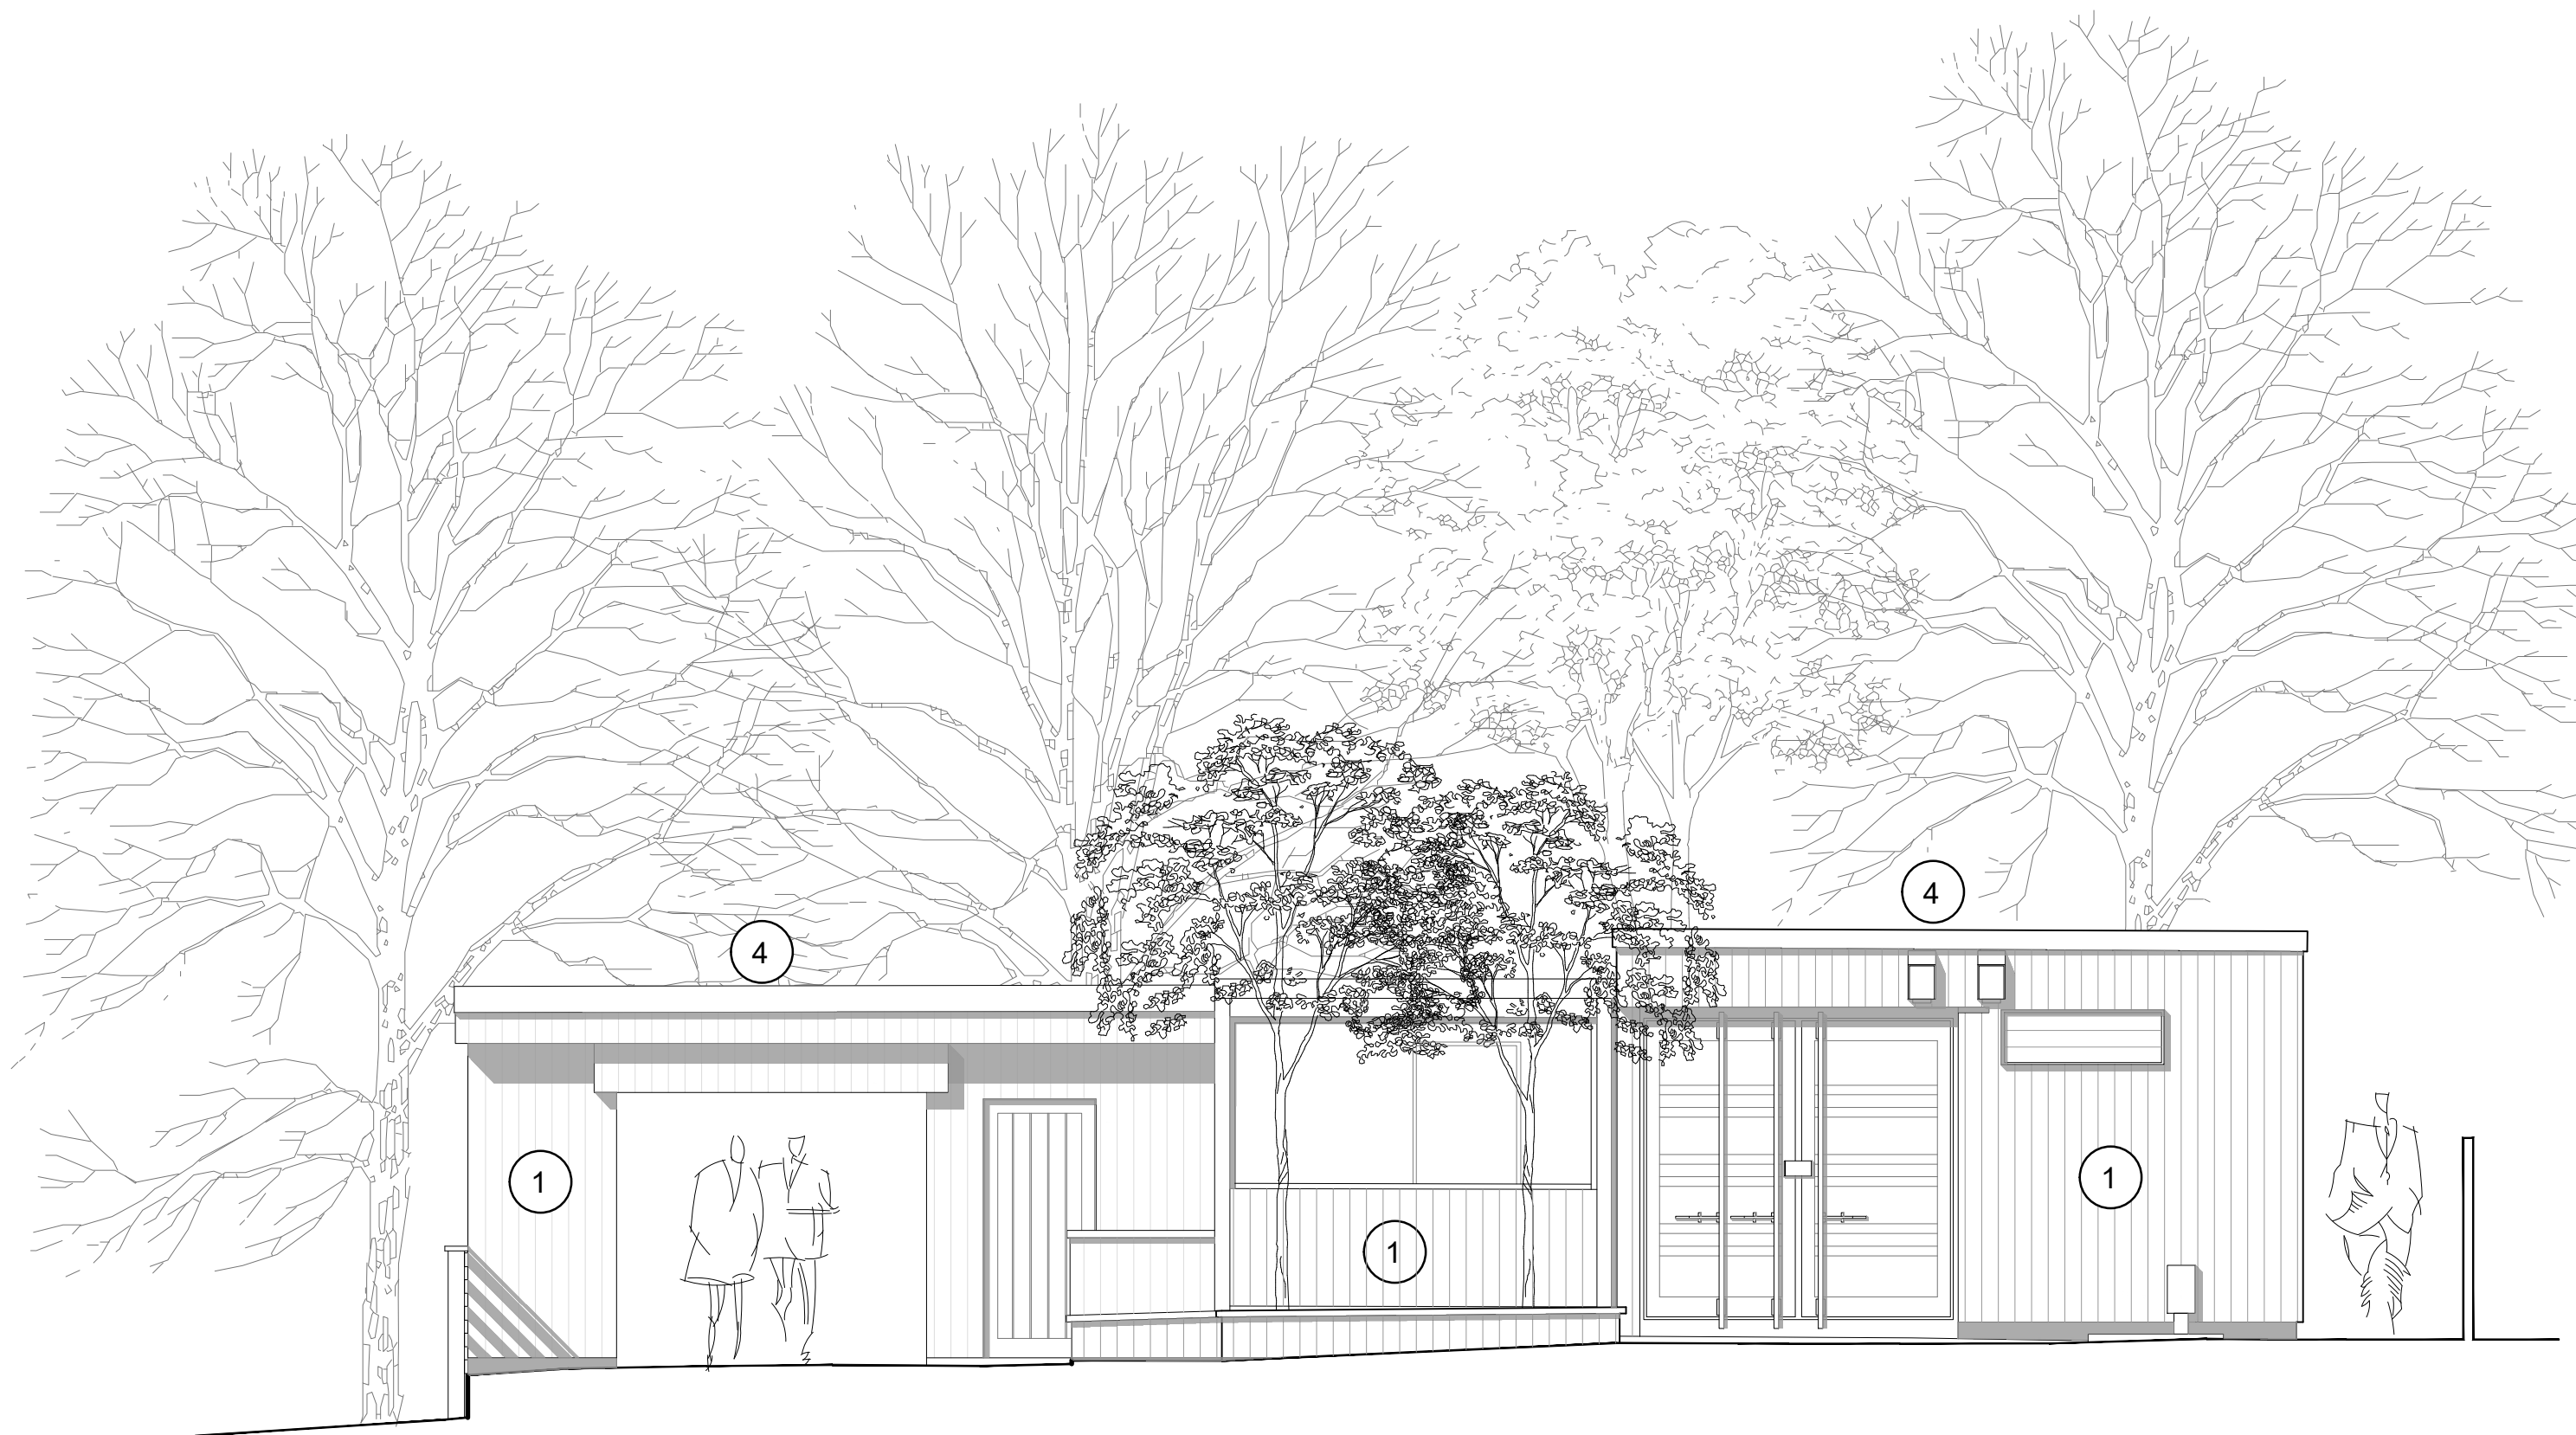



As-Built Front / North Elevation
1:50

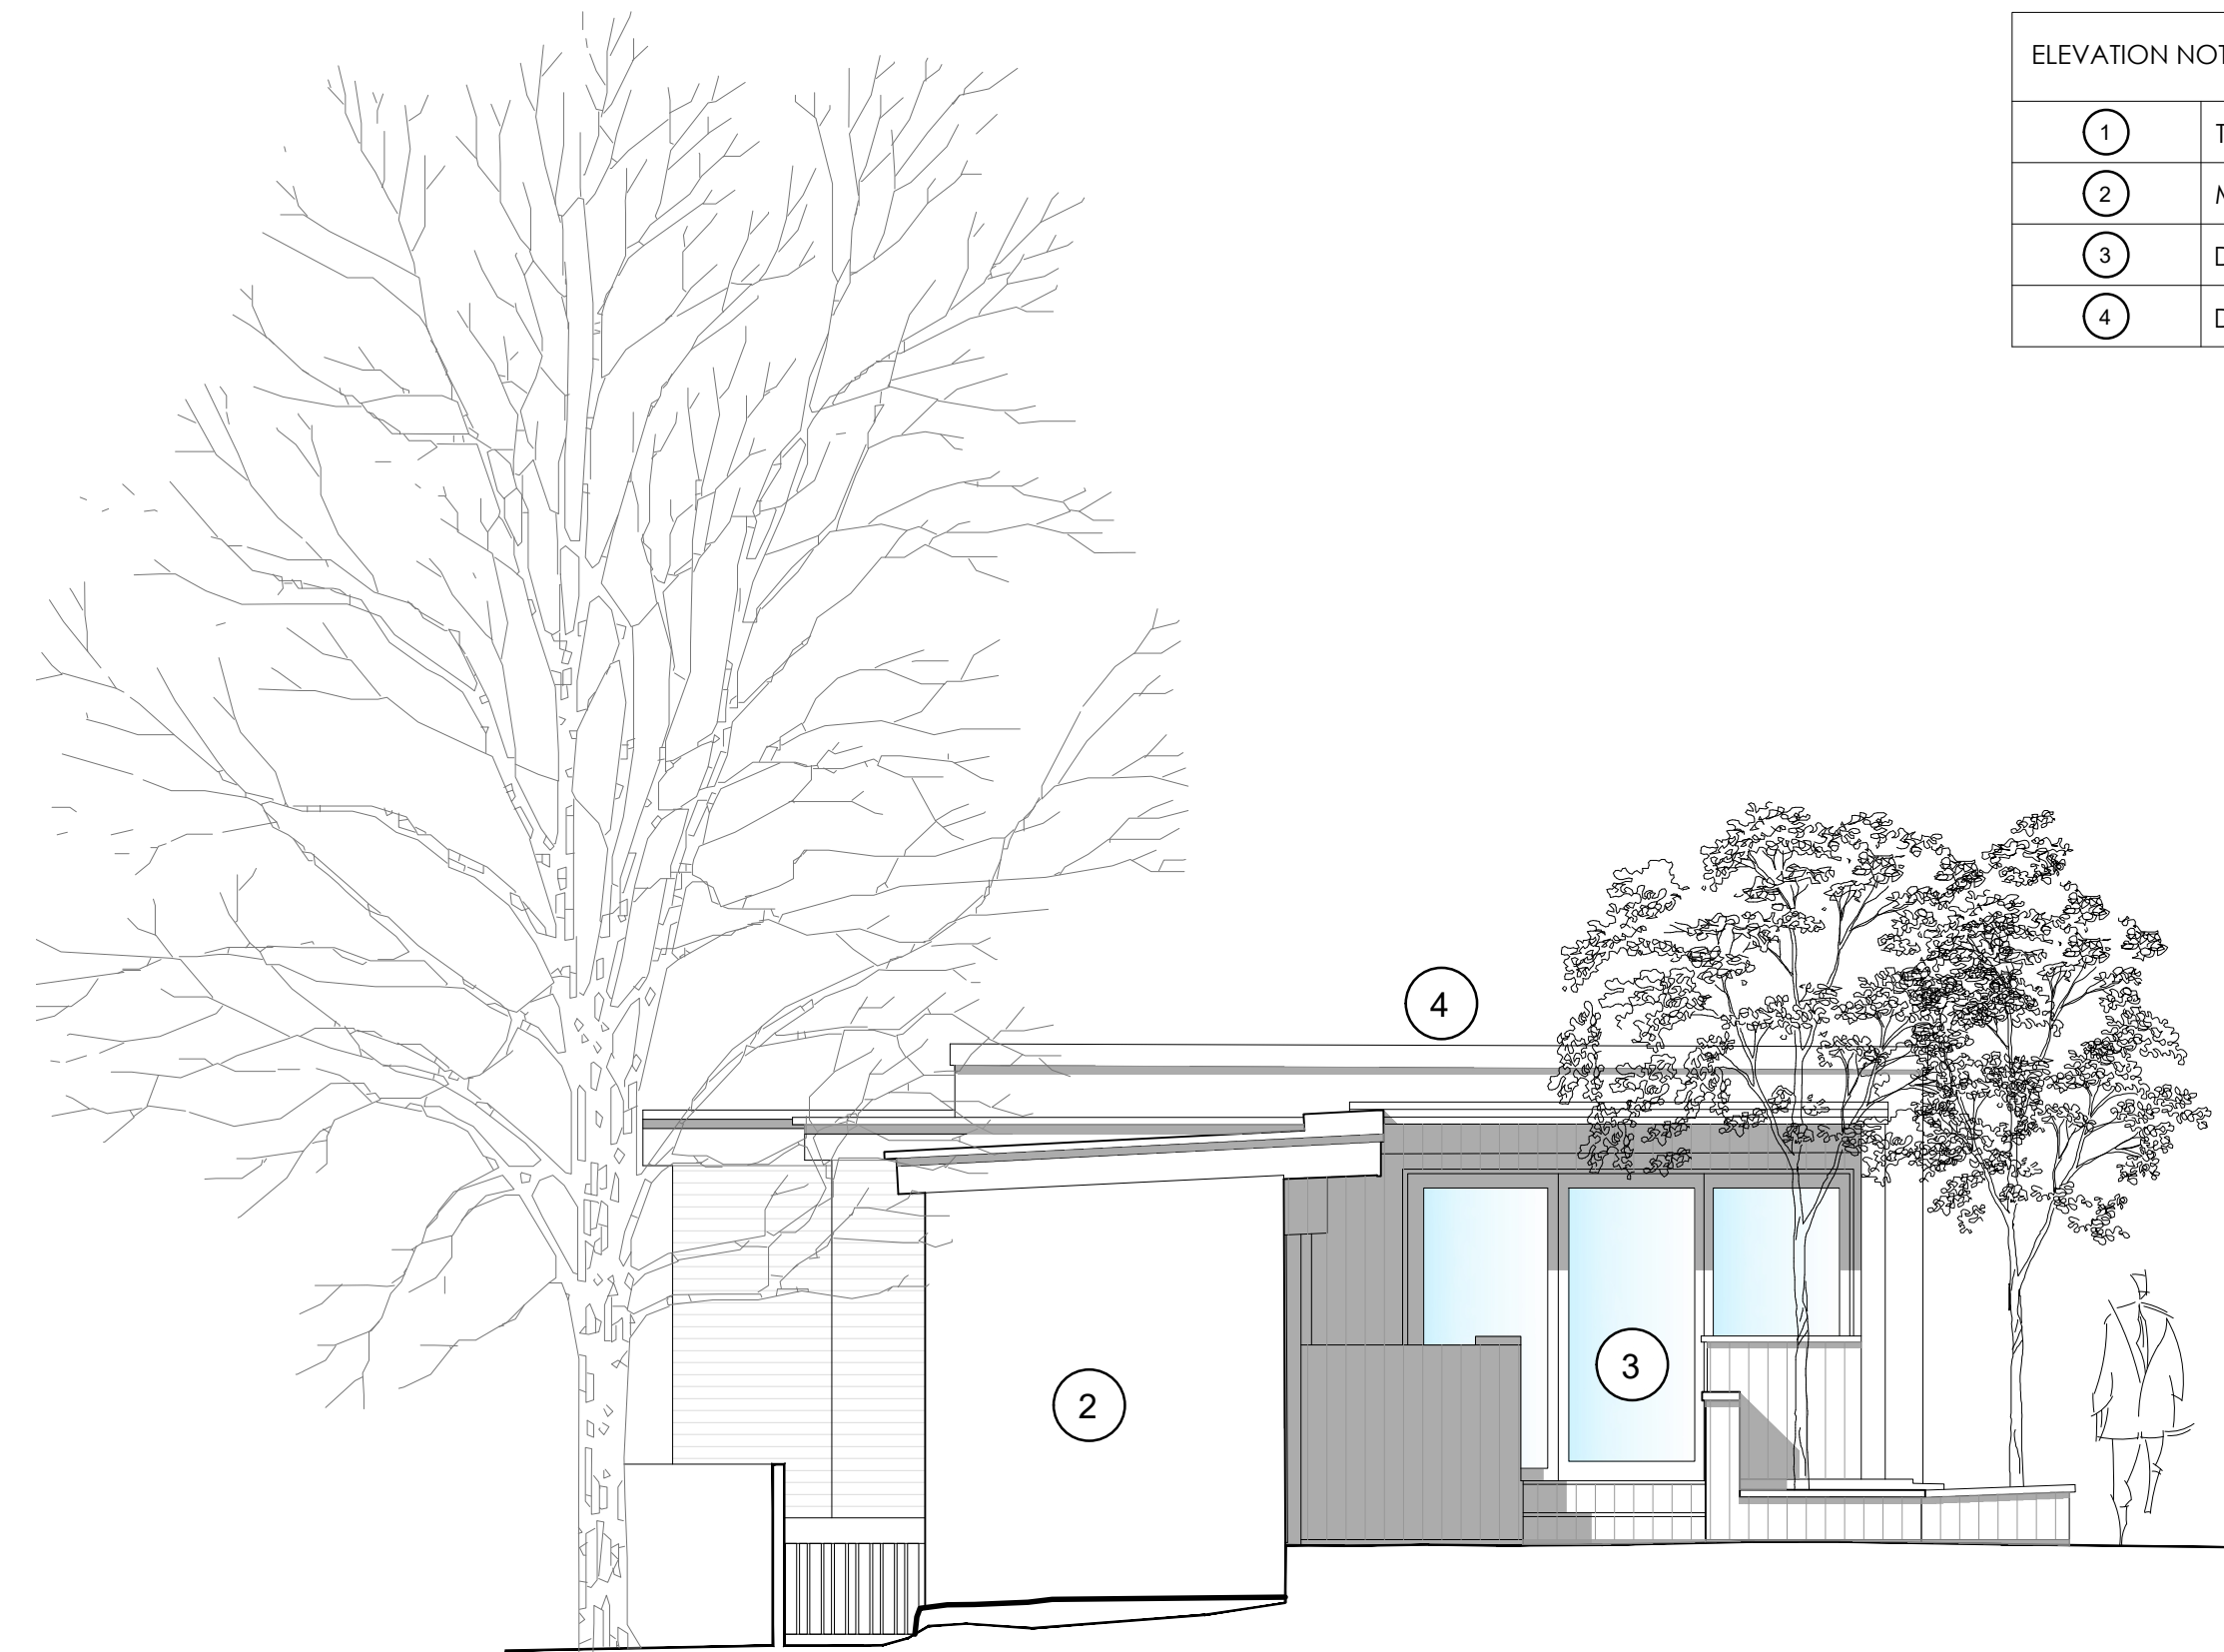


As-Built Side / East Elevation
1:50

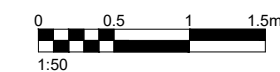

As-Built Rear / South Elevation
1:50

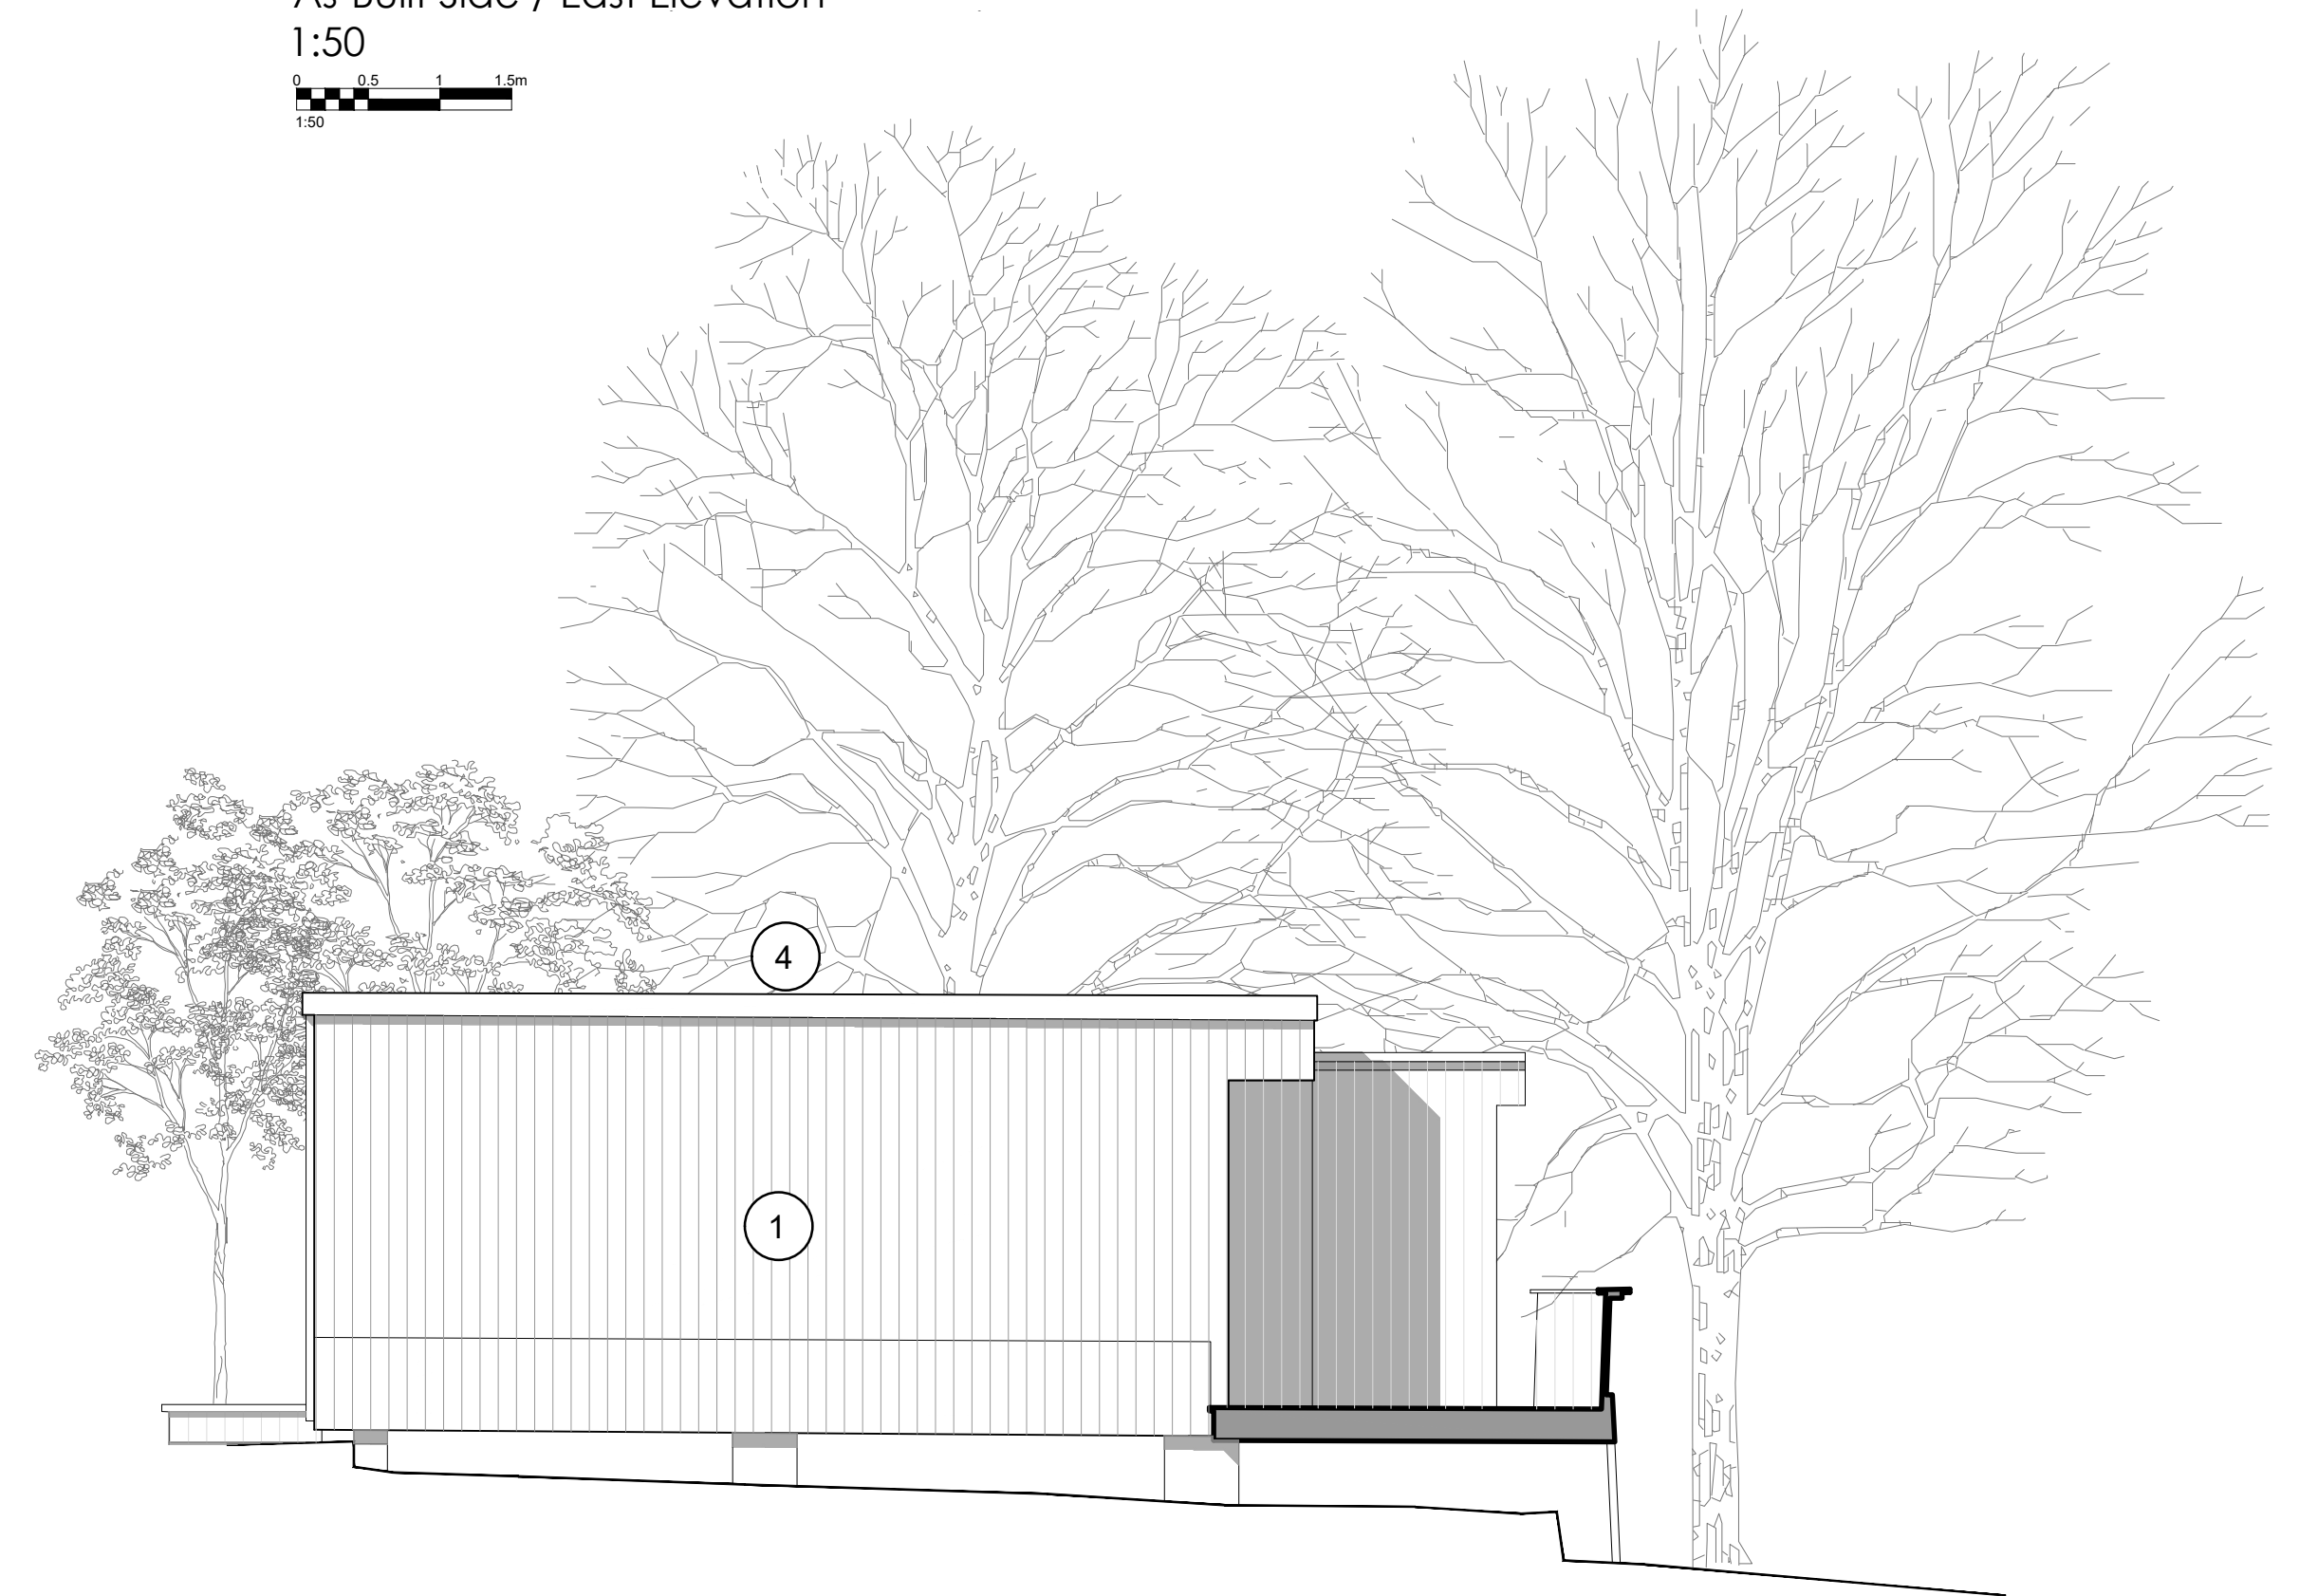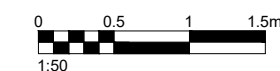



As-Built Side / West Elevation
1:50

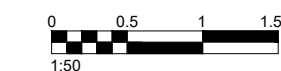

ELEVATION NOTES	
①	Timber cladding
②	Membrane
③	Dark grey glazed UPVC windows
④	Dark grey aluminium flashings

notes:

revisions: A | 19.08.2025 SCR | Amended To Reflect Clients Comments

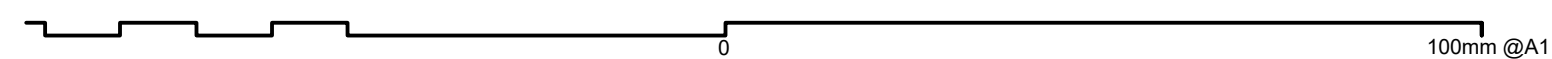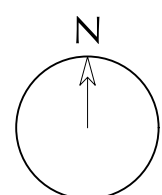

NOTE: The contractor is responsible for checking all site dimensions and levels. These should be checked prior to the ordering of any components and before the commencement of the works. All discrepancies should be brought to the attention of the Contract Administrator

Raimond Poikans
6 Northlands Park
Emsworth, PO10 7EY

drawing information

title:

As-Built elevations
as existing

status:

date:

scale:

drawn:

chk'd:


Planning

April 2025

1:500@A1

CR

SCR

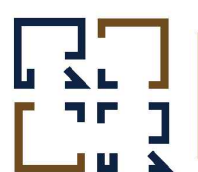

R&R DESIGN
STUDIO LTD

job:

1169

dwg:

1003

rev:

A