


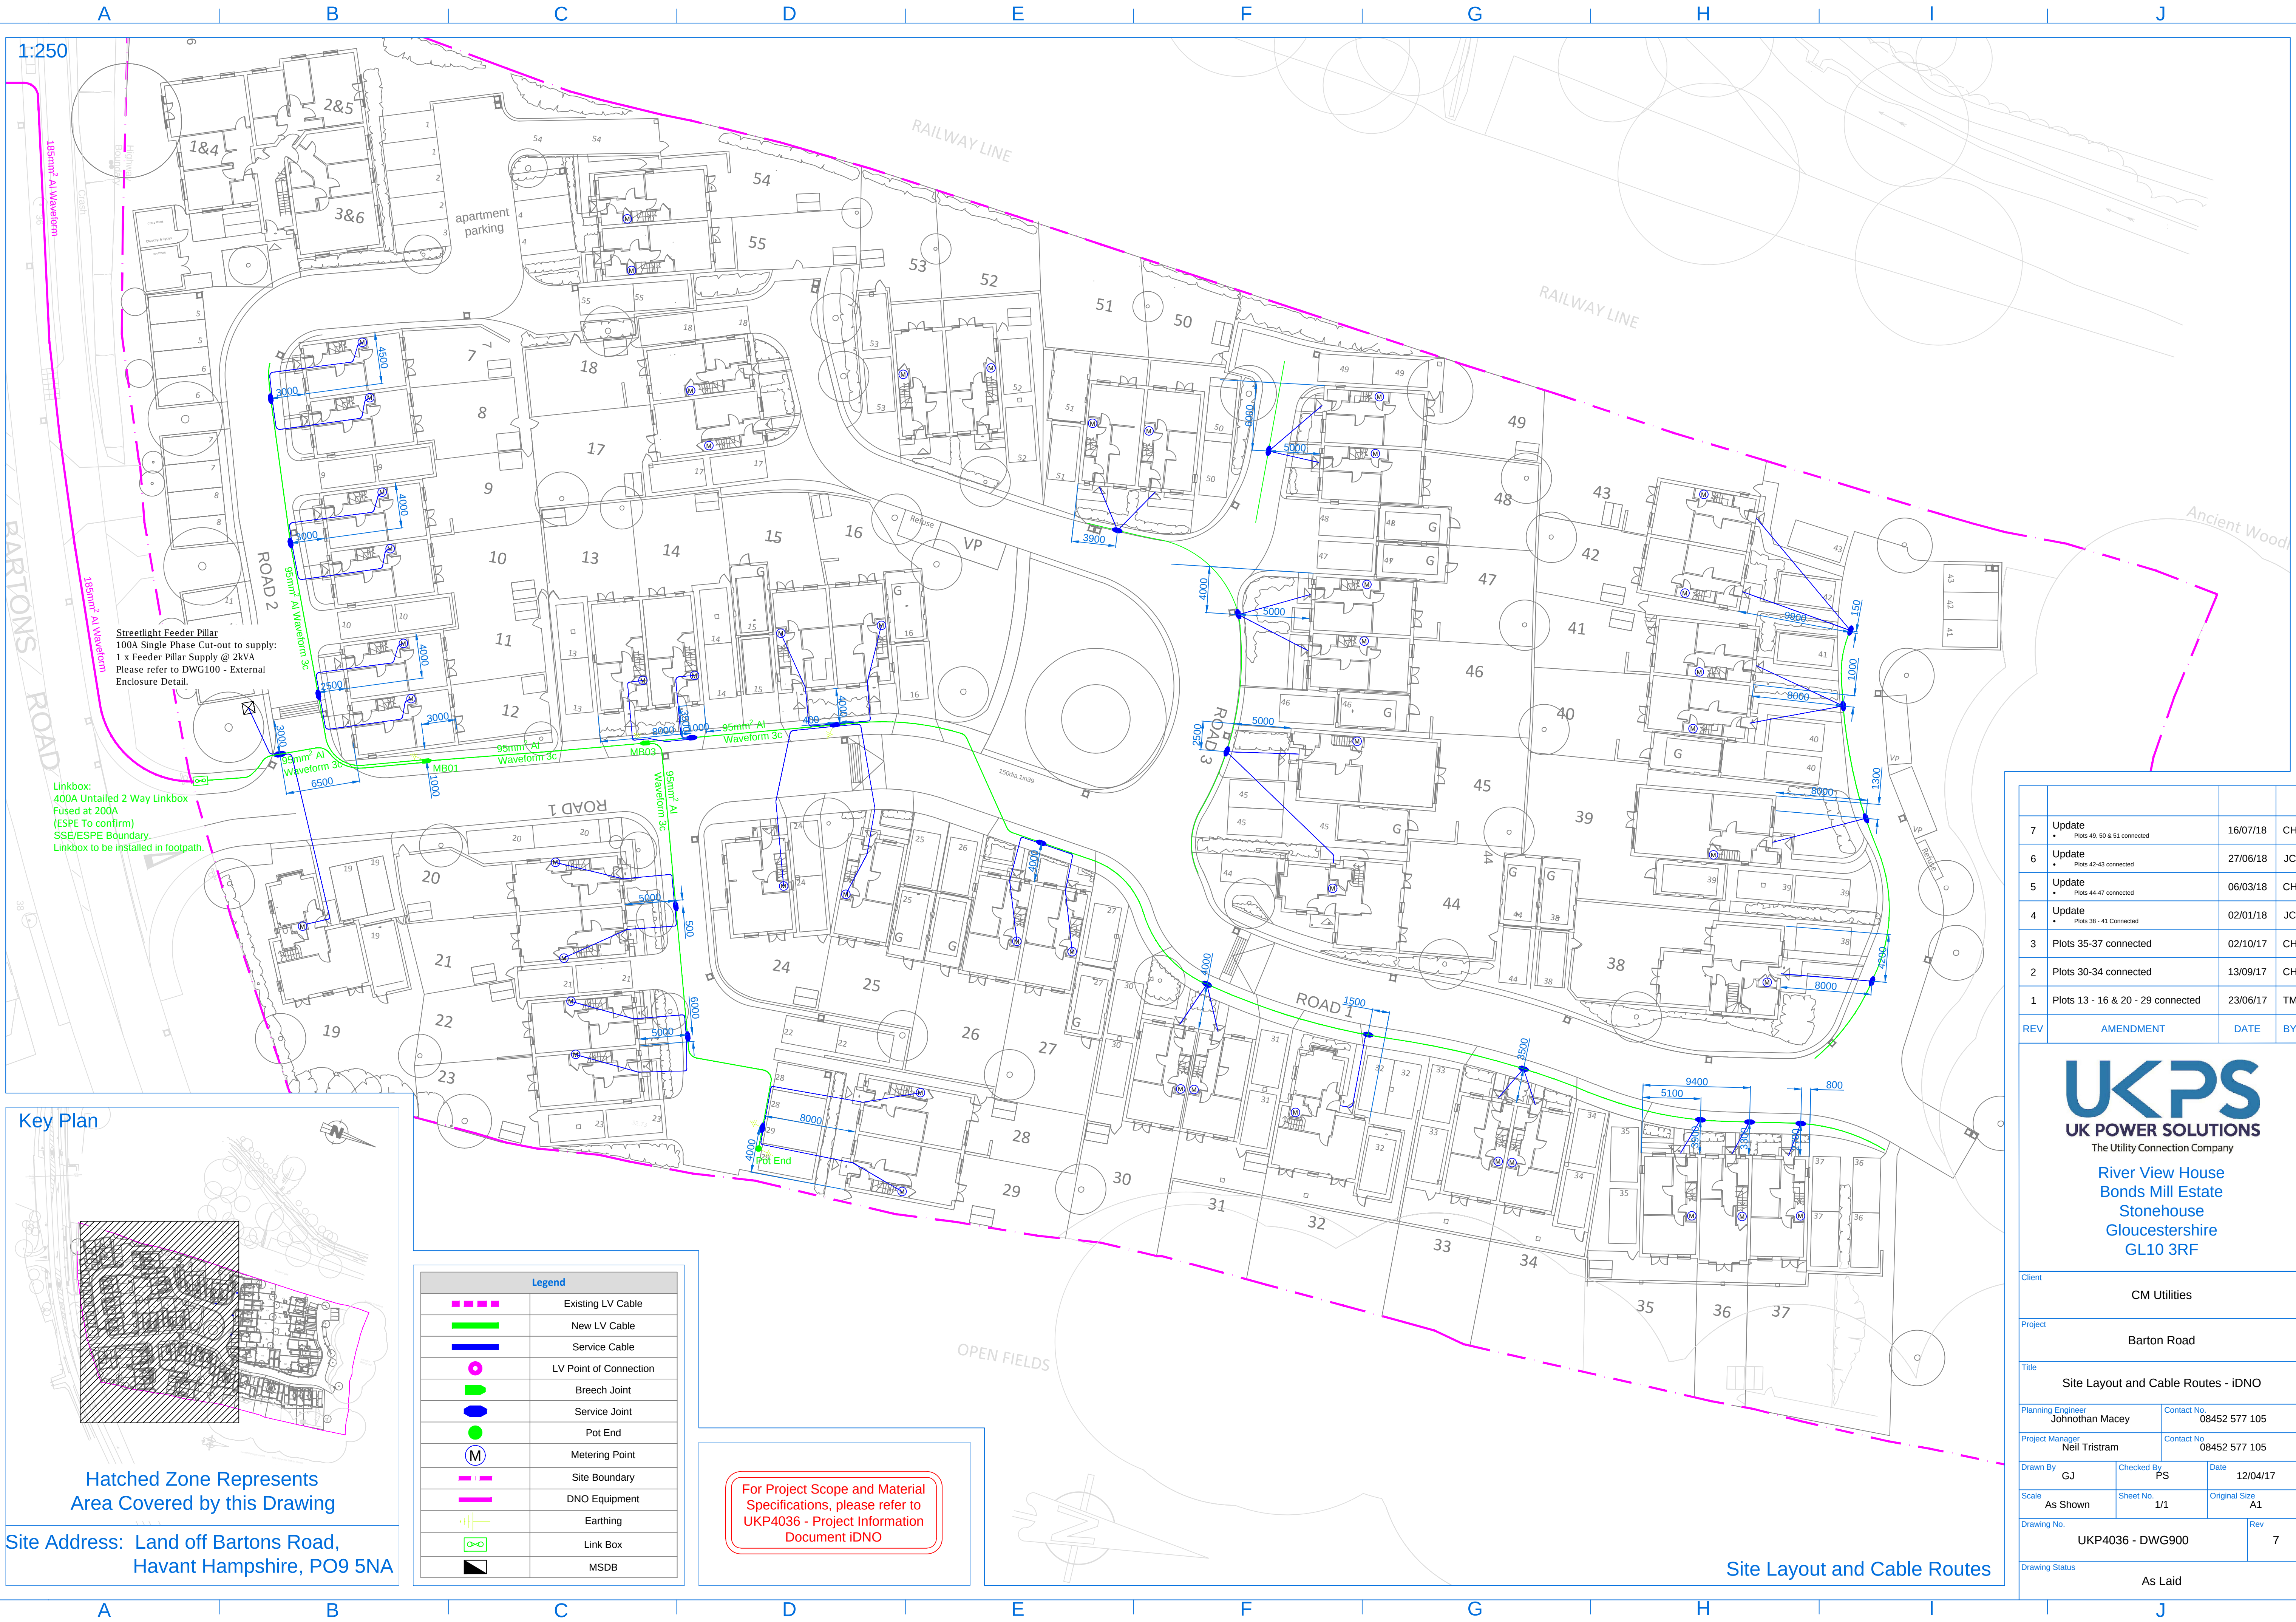

Key Plan

Hatched Zone Represents Area Covered by this Drawing

Site Address: Land off Barton Road, Havant Hampshire, PO9 5NA

Legend	
	Existing LV Cable
	New LV Cable
	Service Cable
	LV Point of Connection
	Breach Joint
	Service Joint
	Pot End
	Metering Point
	Site Boundary
	DNO Equipment
	Earthing
	Link Box
	MSDB

For Project Scope and Material Specifications, please refer to UKP4036 - Project Information Document iDNO

7	Update	Plots 49, 50 & 51 connected	16/07/18	CH
6	Update	Plots 42-43 connected	27/06/18	JC
5	Update	Plots 44-47 connected	06/03/18	CH
4	Update	Plots 38 - 41 Connected	02/01/18	JC
3	Plots 35-37 connected		02/10/17	CH
2	Plots 30-34 connected		13/09/17	CH
1	Plots 13 - 16 & 20 - 29 connected		23/06/17	TM
REV	AMENDMENT	DATE	BY	

UKPS
UK POWER SOLUTIONS
The Utility Connection Company

River View House
Bonds Mill Estate
Stonehouse
Gloucestershire
GL10 3RF

Client	CM Utilities		
Project	Barton Road		
Title	Site Layout and Cable Routes - iDNO		
Planning Engineer	Johnathan Macey	Contact No.	08452 577 105
Project Manager	Neil Tristram	Contact No.	08452 577 105
Drawn By	GJ	Checked By	PS
		Date	12/04/17
Scale	As Shown	Sheet No.	1/1
		Original Size	A1
Drawing No.	UKP4036 - DWG900		Rev
			7
Drawing Status	As Laid		

Site Layout and Cable Routes