


Boundary Key

- Estate
- Plot Boundary
- Shared Private Path
- Private Estate Road
- Estate Management Facilities
- B Bin Collection Point
- VP Visitor parking

REVISIONS

REV.	DESCRIPTION	DRAWN	CHKD	DATE
A	Updated with Clarke Willmott email	DW	DW	29/03/19
B	Drawing updated as per Clarke Willmott LLP mark up & email 06-03-19	DW	DW	29/03/19
C	Updated as per Clarke Willmott email 01.04.19	DW	DW	03/04/19
D	Updated as per Clarke Willmott email 04.04.19	DW	DW	05/04/19
E	Updated following Clarke Willmott email	JW	JW	19/11/19
F	Updated following Clarke Willmott email	JW	JW	02/12/19
G	Updated to as built at clients request to fulfill Land Registry requirements.	JW	JW	31/01/20
H	Updated in line with HM Land Registry illustrative plan data specifically relating to Plots 5,6,7 & 10.	JW	JW	14/02/20
J	Visitor parking space now conveyed to Plot 4.	JW	JW	14/02/20

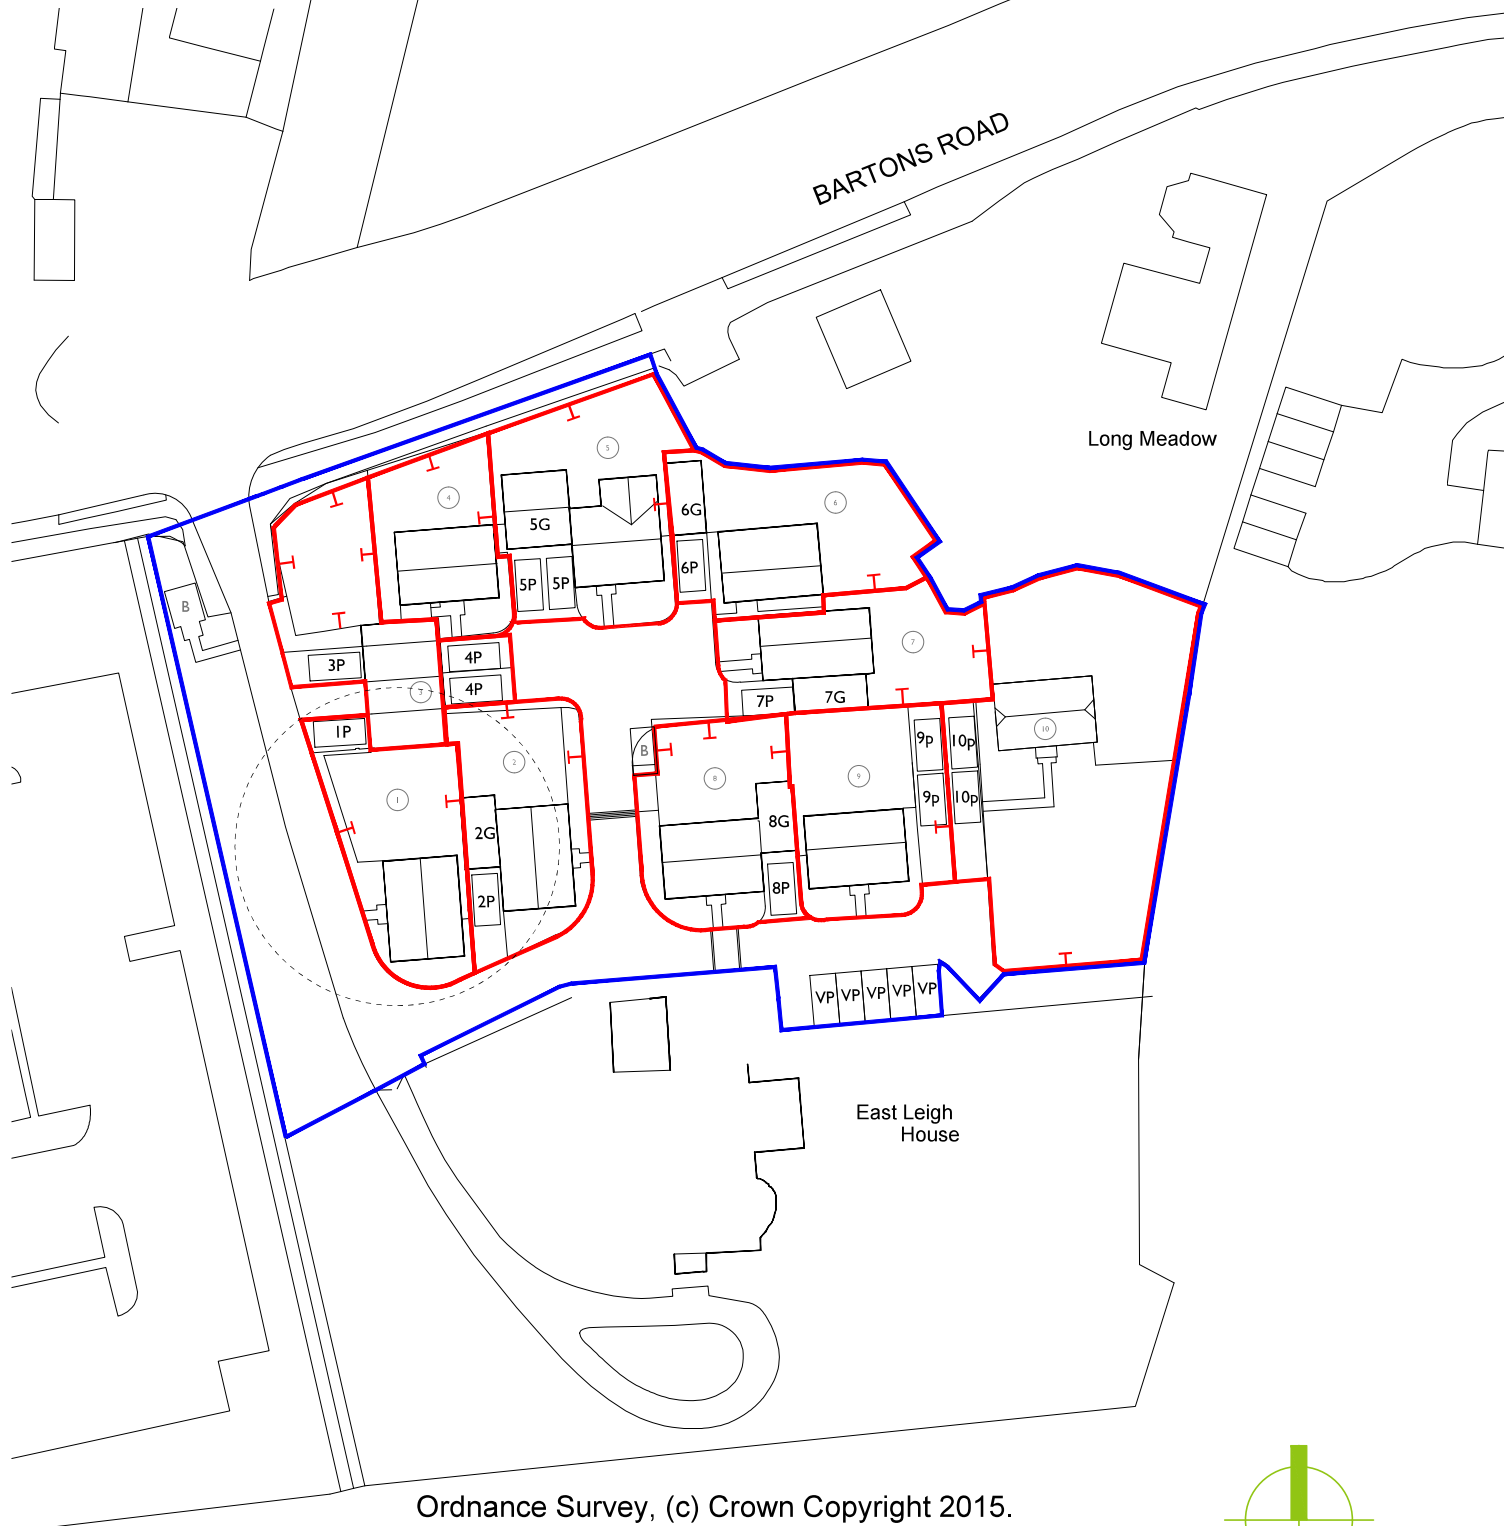

Ordnance Survey, (c) Crown Copyright 2015.
All rights reserved. Licence number 100022432



PROJECT
East Leigh House
Havant
Barton Road
Ibex Homes Ltd

DRAWING TITLE
Site Conveyance Plan

0	5	10	15	20	25	30	35
SCALE	SHEET SIZE	SHEET No.	DRAWN	CHKD	DATE	CAD FILE	
1:500	A3	1 of 1	JW		14/02/2020		
The Studio, Unit 17, Vicarage Farm, Winchester Road, Fair Oak, Hampshire. SO50 7HD 023 8069 7010 enquiries@urbanpulsedesign.co.uk www.urbanpulsedesign.co.uk							

urban pulse

design

17-1061-4010-1