


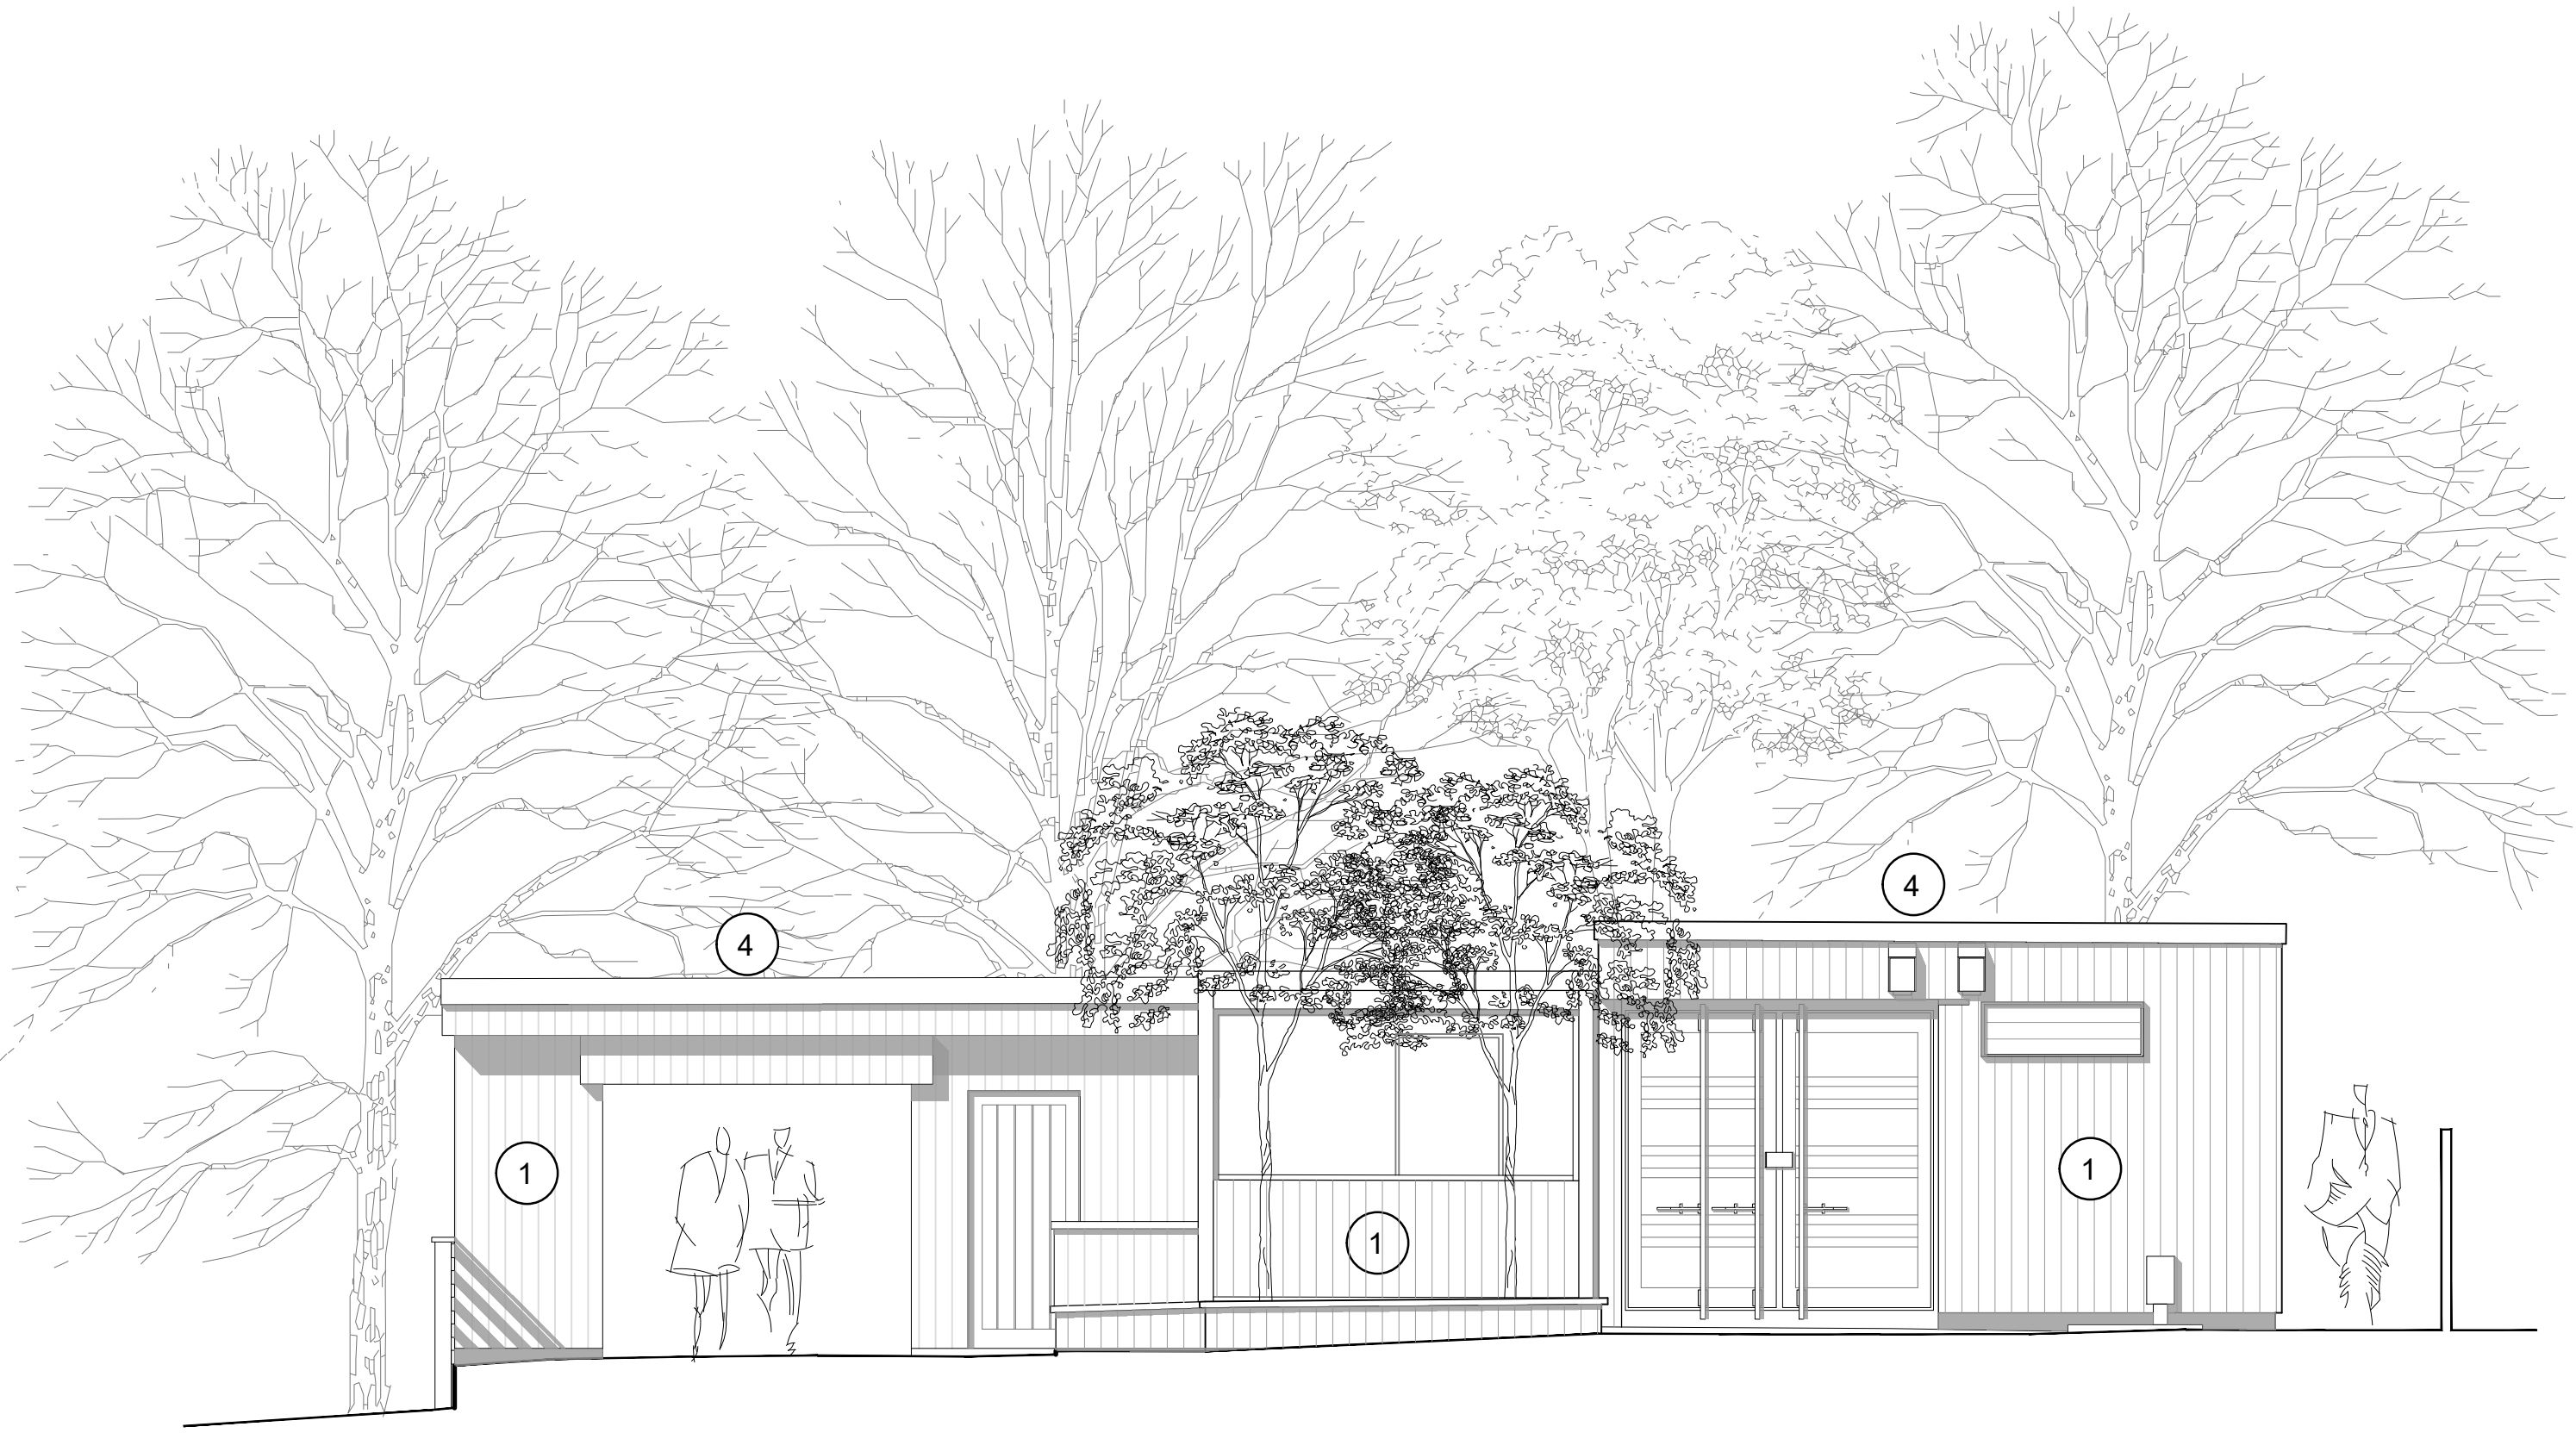


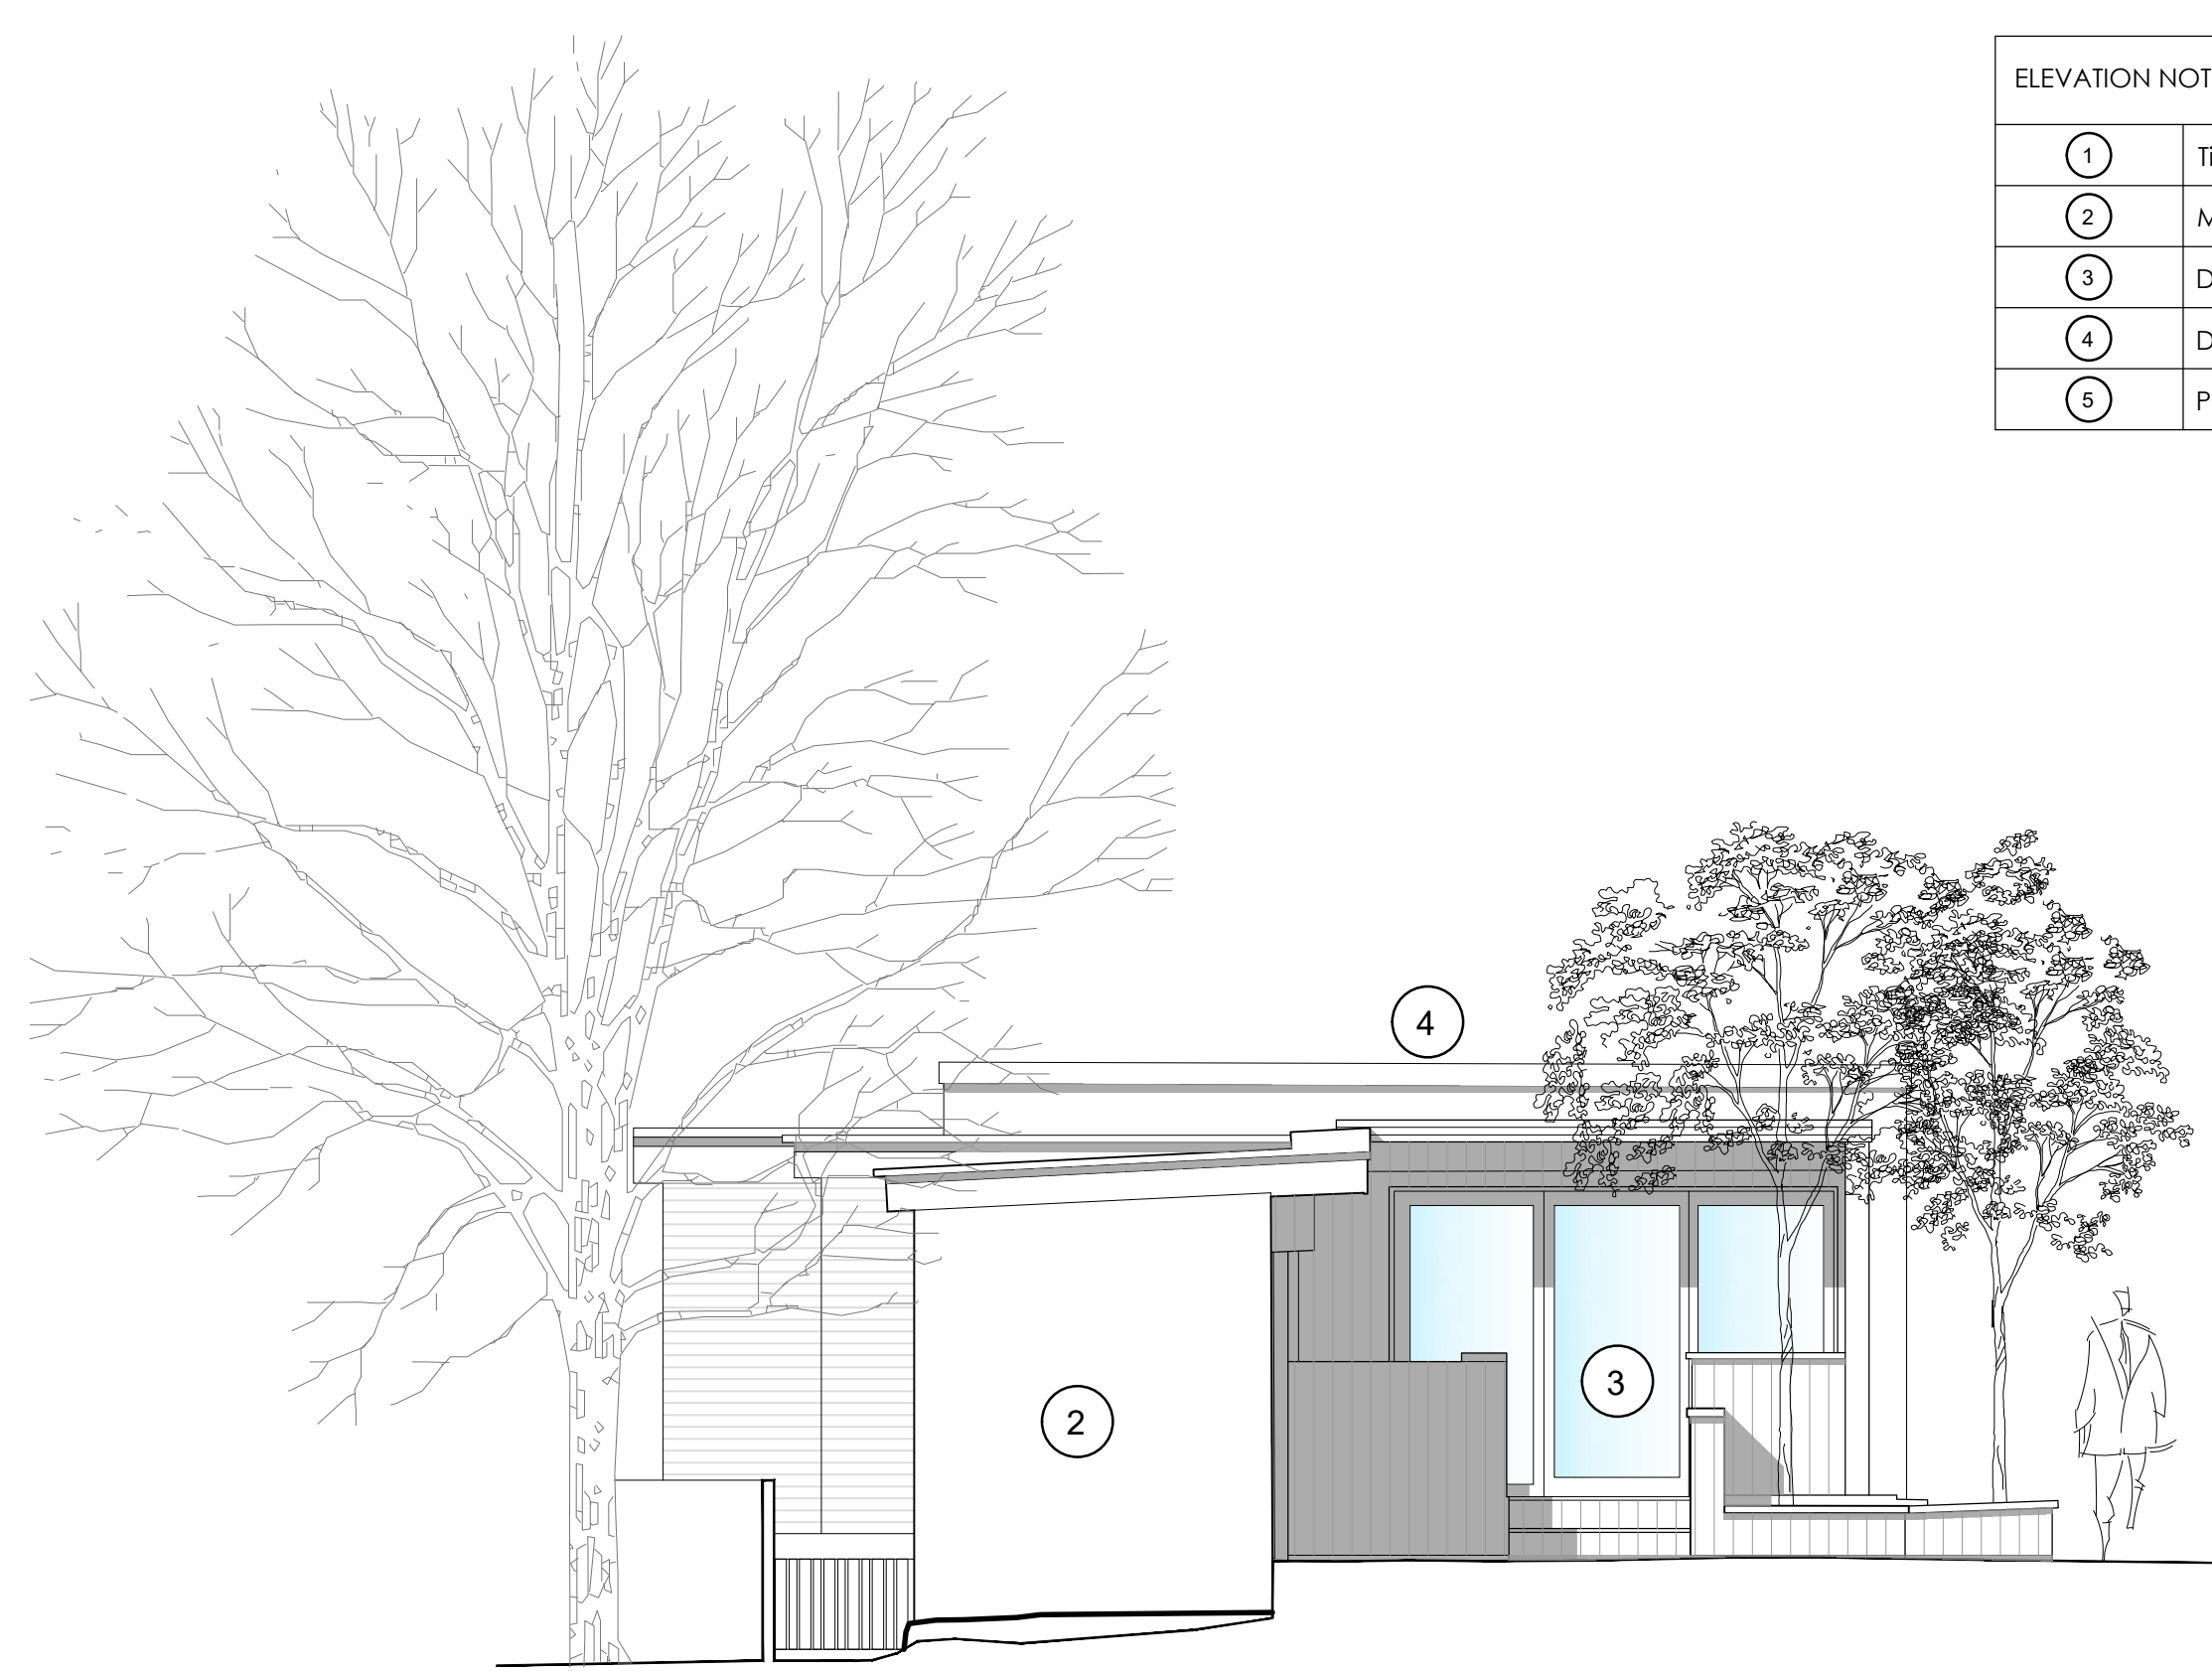



As-Built Front / North Elevation
1:50

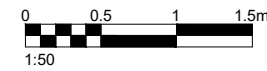


As-Built Side / East Elevation
1:50

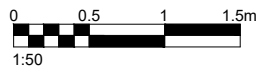

As-Built Rear / South Elevation
1:50

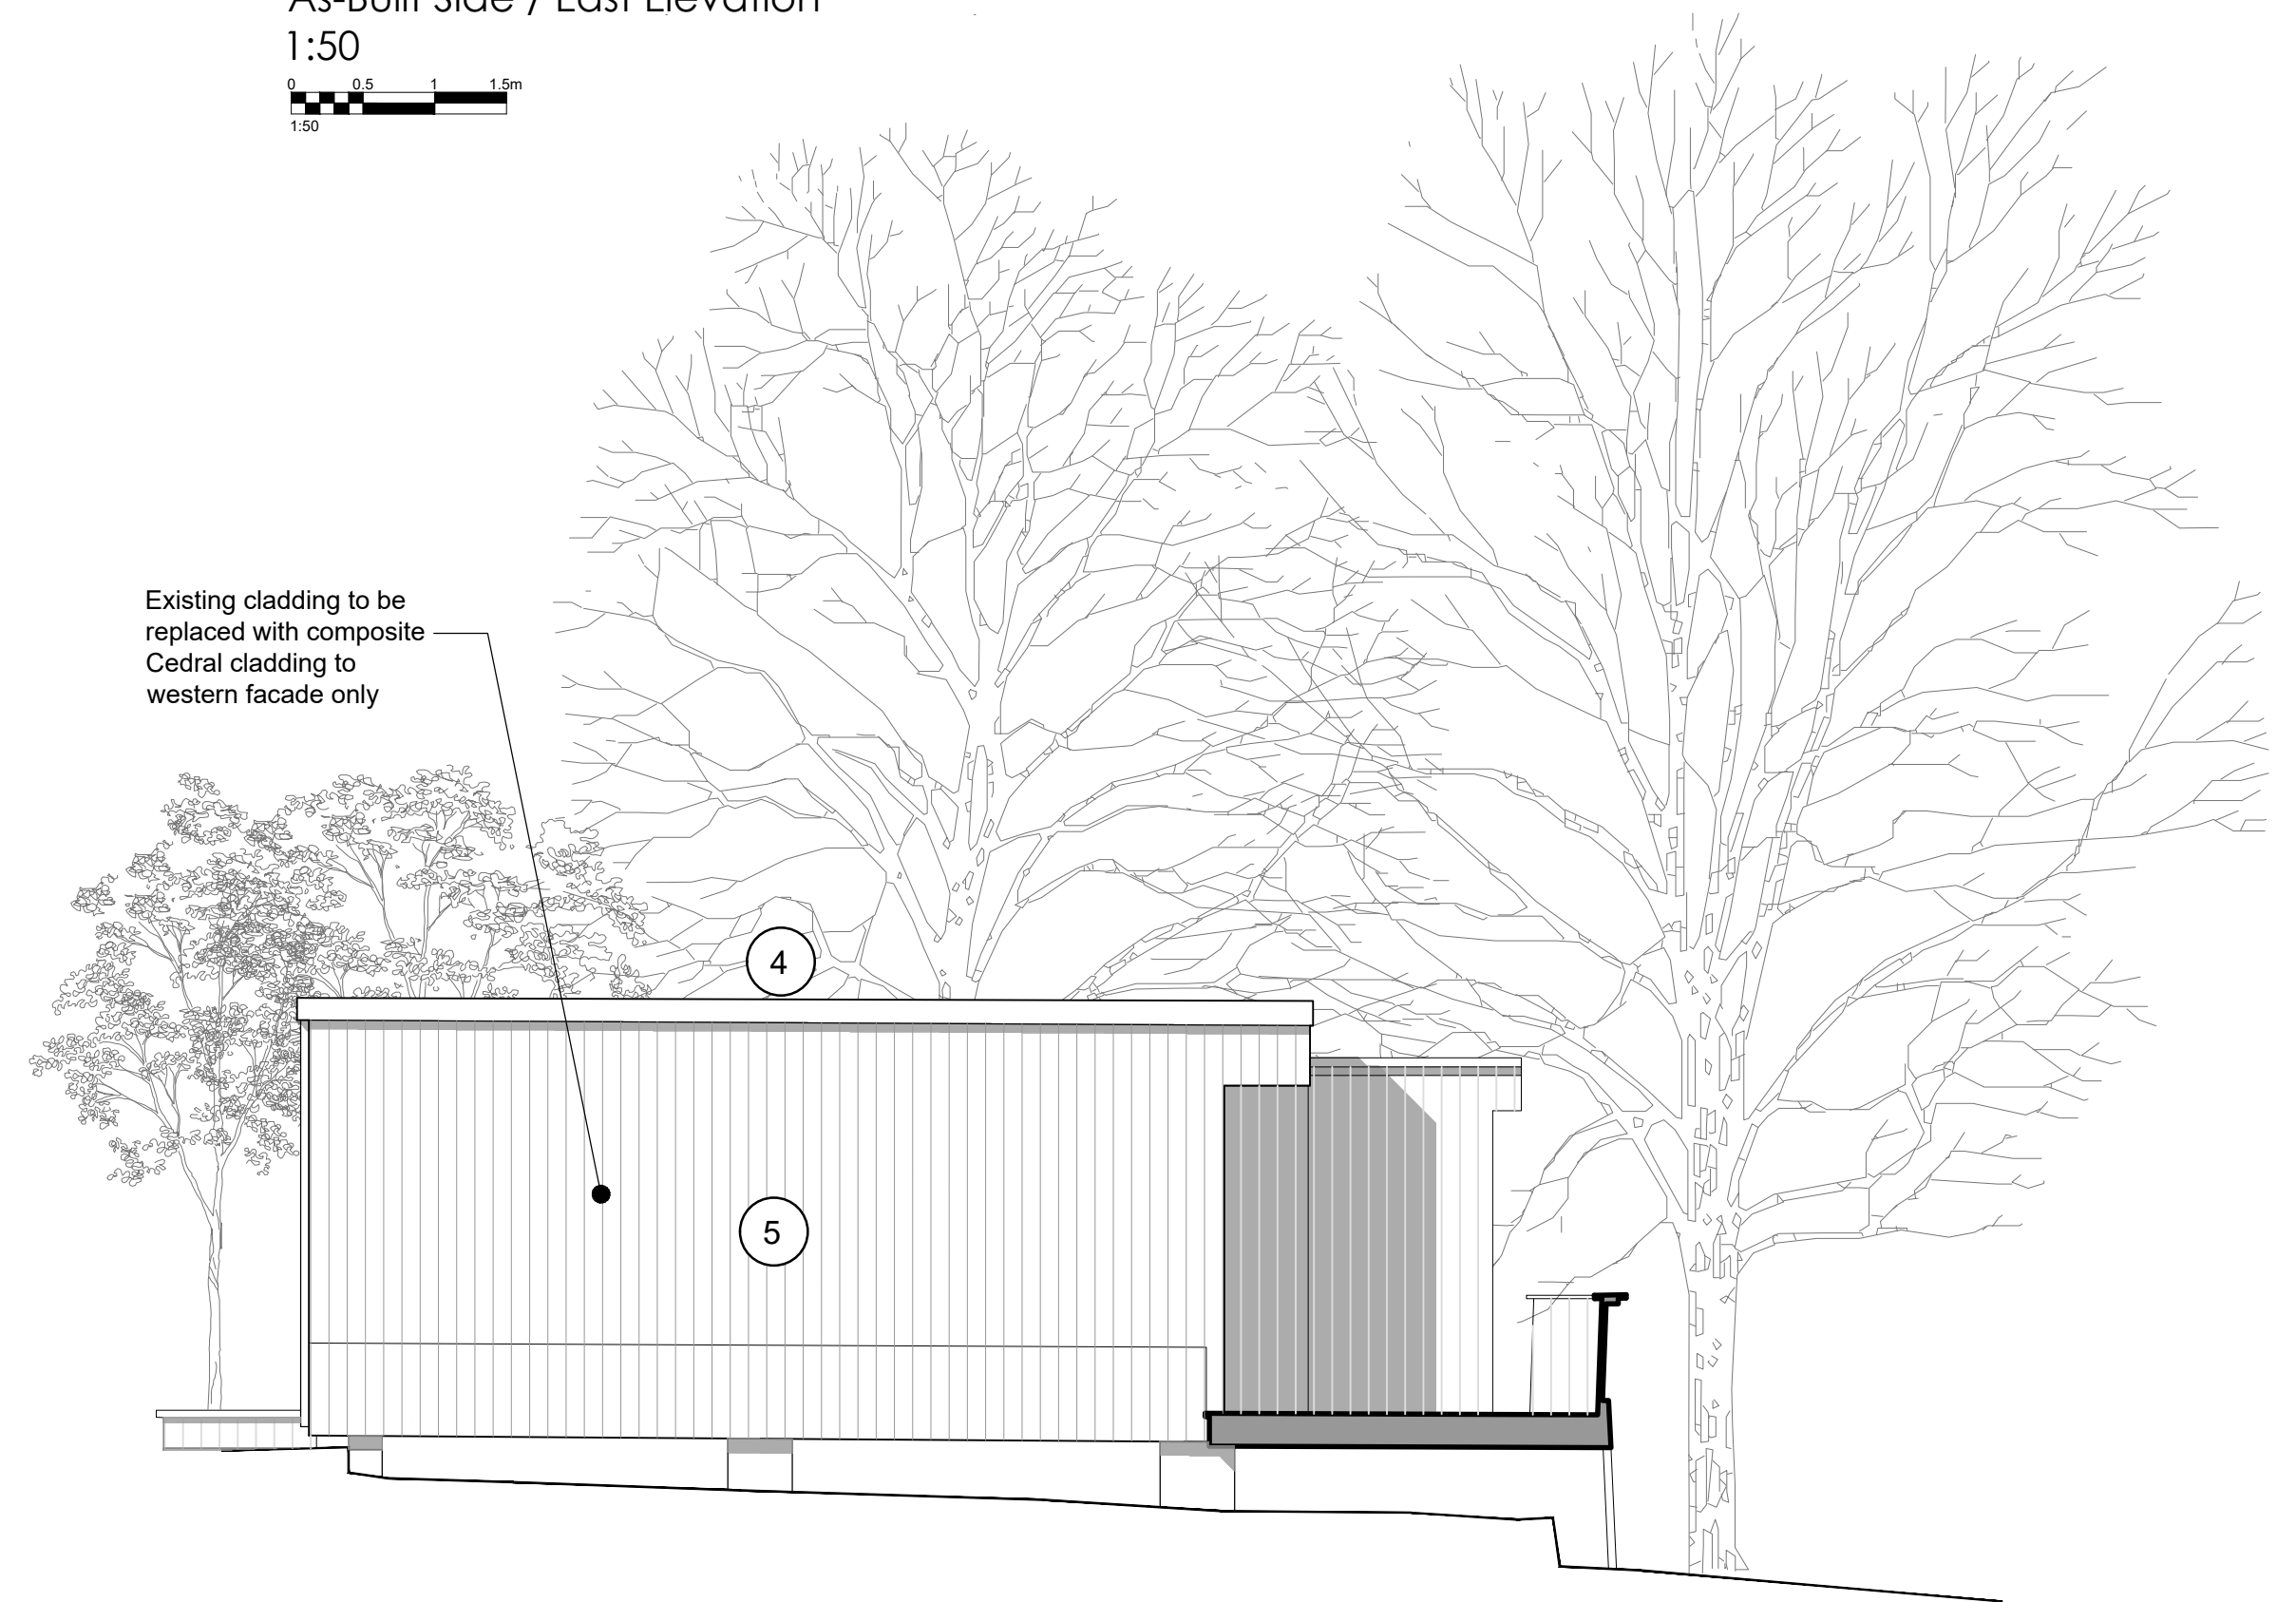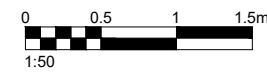


As-Built Side / West Elevation
1:50

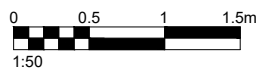

ELEVATION NOTES	
①	Timber cladding
②	Membrane
③	Dark grey glazed UPVC windows
④	Dark grey aluminium flashings
⑤	Proposed new cedar cladding

notes:

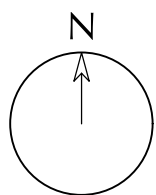

revisions: A | 19.08.2025 SCR | Amended To Reflect Clients Comments
B | 19.08.2025 GR | Note added to west elevation

Raimond Poikans
6 Northlands Park
Emsworth, PO10 7EY

drawing information title: As-Built elevations
as existing

status: Planning
date: April 2025
scale: 1:500@A1
drawn: CR
chk'd: SCR

job: 1169 dwg: 1003 rev: B

NOTE: The contractor is responsible for checking all site dimensions and levels. These should be checked prior to the ordering of any components and before the commencement of the works. All discrepancies should be brought to the attention of the Contract Administrator