


Doswell
May 2026

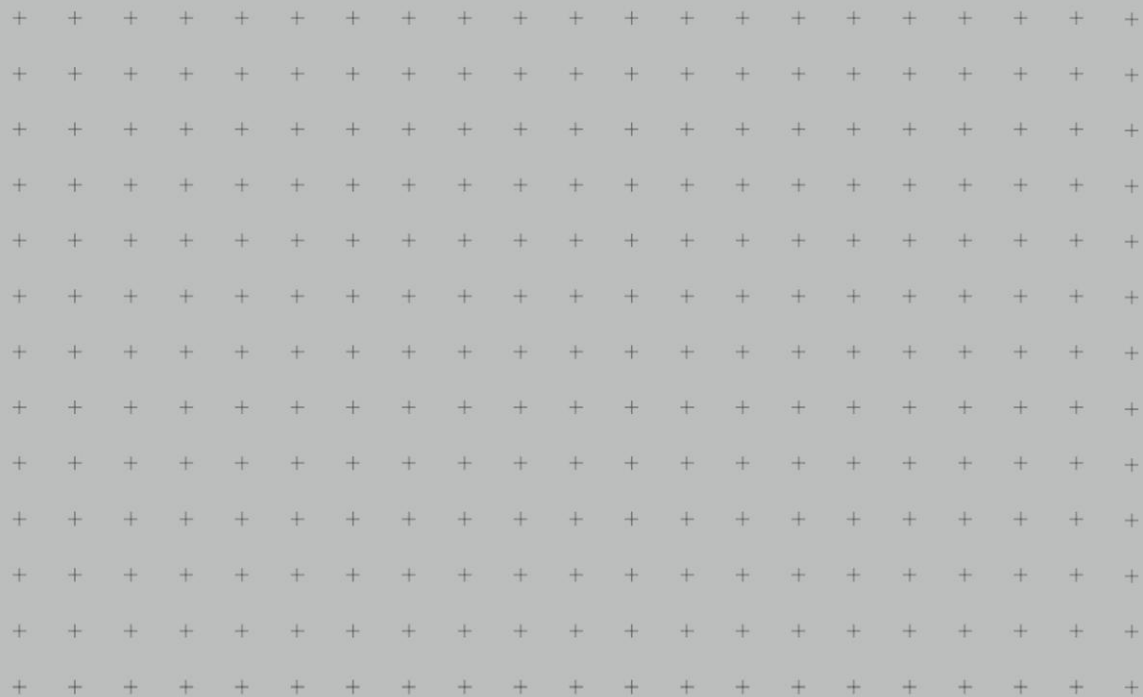

TECHNICAL RESPONSE TO HCC HIGHWAYS COMMENTS

1. INTRODUCTION

Ridge and Partners have been commissioned to respond to the Road Safety Audit undertaken by Fenley (March 2026) as part of the S278 Technical Approval Process.

The comments from RSA points have been itemised as below with responses to each section following on.

2. TECHNICAL RESPONSE

Stage One/Two Road Safety Audit (RSA1/2)

The RSA1/2 Audit raises 7 safety related concerns with the proposed access arrangement. The designer's response agrees and accepts all of the issues raised and confirms how the design has been updated to cater for each points.

Issue:

B.1.1 – Alignment may not be adequate for two-way car / LGV movements. It is recommended that the carriageway is adequate for cars and LGVs to pass one another.

Response:

We have provided updated tracking Drawing 23339-JUBB-XX-XX-DR-X-001200 REV C4 that shows in the bottom right that cars can pass each other.

Issue:

B2.1 No details of the proposed raised table have been provided. It is recommended that the proposed raised table includes adequate ramps that force traffic slow.

Response:

The raised table ramp length has been designed in accordance with HCC detail HCC11/C/105 Rev B.

Issue:

B2.2 Vehicles may not be able to access the existing parking bays. It is recommended that the bays are accessible.

Response:

The existing parking bays are proposed to be relined as shown on Drawing 23339-JUBB-XX-XX-DR-X-000100 REV C13 and the tracking is shown on Drawing 23339-JUBB-XX-XX-DR-X-001203 REV C1.

Issue:

B.4.1 - Cyclists are likely to continue without giving way to traffic. It is recommended that an appropriate level of visibility is achievable.

Response:

Suitable visibility splays for cyclists are as shown on Drawing 23339-JUBB-XX-XX-DR-X-000100 REV C13. In dashed orange. With regards to lighting, this has been confirmed as suitable by the lighting designer.

Issue:

B.4.2 - Non-motorised users at and on approach to the uncontrolled crossing may not be clearly visible during the hours of darkness. It is recommended that visibility is achievable to the tangent and that the proposed crossing point is illuminated adequately with a column provided immediately to the west of the crossing point as previously proposed.

Response:

Suitable visibility splays for pedestrians are as shown on Drawing 23339-JUBB-XX-XX-DR-X-000100 REV C13. In dashed yellow. With regards to lighting, this has been confirmed as suitable by the lighting designer.

APPENDIX A

Road Safety Audit

Road Safety Audit Report

Incorporating
Stage 1/2 Completion of Detail Design.



Proposed Continuation of Coldharbour Farm Road Emsworth

Client:
Doswell Projects

Client reference:
23339

Fenley
2 Blaenant
Emmer Green
READING
RG4 8PH

E: office@fenley.co.uk
www.fenley.co.uk

Report Status 1

Job no	RSA-25-242	Issue no	1	Date	March 2026
Prepared by	JJF	Verified by	ZB	Approved by	JJF
Filename and Path	Fenley/Road Safety Audits/RSA-25/RSA-25-242-1				

1.0 PROJECT DETAILS

Report Title:	Stage 1/2 Road Safety Audit
Date:	March 2026
Document reference and revision:	RSA-25-242-1
Prepared by:	Fenley Road Safety Limited
On behalf of the Overseeing Organisation:	Hampshire County Council
Design Organisation:	Ridge
Project Sponsor:	Doswell Projects

REV	ISSUE PURPOSE	AUTHOR	CHECKED	APPROVED	DATE
0	Stage 1/2 Road Safety Audit drafted for Audit Team discussions	JJF			20 th March 2026
1	Stage 1/2 Road Safety Audit finalised and issued to the Design Organisation	JJF	ZB	JJF	26 th March 2026

Contents:

1.0	Project Details	1
2.0	Introduction	2
3.0	Items Raised in any previous Road Safety Audits	3
4.0	Items Raised in this Stage 1/2 Road Safety Audit	4
	B.1 Alignment	
	B.2 General	
	B.3 Junctions	
	B.4 Walking, Cycling and Horse Riding	
	B.5 Traffic Signs, Carriageway Markings and Lighting	
5.0	Audit Team Statement	8

Appendices:

Stage 1/2	B1	Documents and Drawings provided for this Road Safety Audit
	B2	Item Location Plan

2.0 INTRODUCTION

- 2.1 This report has been prepared by Fenley Road Safety Limited and results from a Stage 1/2 Road Safety Audit of a revised design to allow for the continuation of Coldharbour Farm Road to provide access to a development. Coldharbour Farm Road currently accommodates a bend in the road that follows a circa 15 metre road centreline radius and provides access to a number of parking spaces. The proposals continue the carriageway through a number of the former parking bays before following another bend with a road centreline radius of circa 15 metres which is again followed by a bend with a circa 22 metre road centreline radius. The access carriageway is to be 4.8 metres wide with widening on the bends to a maximum of 5.2 metres. The proposed access road severs a pre-existing public footpath cyclepath that forms a link between Emsworth Park to the north and Washington Road to the south, which is to be diverted to cross the proposed continuation at a raised table. The scheme is proposed to facilitate access to a residential development of circa 44 dwellings on a parcel of land to the west, whilst retaining all but three of the existing parking spaces in the vicinity.
- 2.2 The Audit Brief identifies that the proposals do not include any Departures from Standard, whether related to strategic decisions or otherwise.
- 2.3 The Road Safety Audit was undertaken during March 2026 in accordance with the Road Safety Audit Brief provided on the 20th March 2026 by the Project Sponsor, Doswell Projects. The Road Safety Audit comprised of a previous site visit as well as an examination of the documents provided which are identified in **Appendix B1**. The Audit Team were satisfied that the Audit Brief was sufficient for the purpose of the Audit instructed.
- 2.4 The Road Safety Audit has been undertaken by an Audit Team whose qualifications and experience accord with the requirements of GG119 and have been approved to undertake Road Safety Audits of all stages within Hampshire. The Audit Team consists of the following members:

Audit Team Leader

Jamie Fenning *BSc(Hons), MIHE, MCIHT, MSoRSA, National Highways RSA Certificate of Competency*
Road Safety / Highway Engineer

Audit Team Member

Zane Beswick *MCIHT, MSoRSA*
Road Safety / Highway Engineer

- 2.5 The site has been visited on two occasions; once as part of previous Road Safety Audits in May 2022 during school pick up between the hours of 14:35 and 15:15 and again with the latest being on associated with this Stage 2 Road Safety Audit was undertaken during the morning of Wednesday 2nd July 2025 between the hours of 11:00 and 11:30. The site visit involved walking and driving around the local highway network for a total period of 70-minutes


whilst observing the local infrastructure and current off-peak traffic conditions. The weather during the site visits was overcast, the road surface was dry and visibility was good. A number of pedestrians and cyclists as well as skateboarders and scooter riders were observed during the site visits. Vehicular traffic was also observed to include cars and light goods vehicles. The traffic flow was light and free flowing. It was noted during the first site visit, that the existing perpendicular parking spaces at the end of Coldharbour Farm Road, are utilised by parents / guardians to drop-off and pick-up pupils from local schools and that the shared footpath cyclepath to the west of Coldharbour Farm Road forms a link between the residential area of Emsworth to the south and Emsworth Park to the north which incorporates numerous sports facilities.

- 2.6 The terms of reference of this Road Safety Audit are as described in GG119. The scheme has been examined and this report compiled, only with regard to the safety implications for road users of the scheme as presented. It has not been examined or verified for compliance with any other standards or criteria. However, in order to clearly explain a safety problem or the recommendation to resolve a problem, the Audit Team may on occasion have referred to a design standard for information only. All comments and recommendations are referenced to the design drawings supplied with the Audit Brief and the location of road safety concerns raised have been illustrated beneath the items along with relevant photographs for clarity, where appropriate, as well as on the Location Plan attached at **Appendix B2**.

3.0 ITEMS RAISED IN ANY PREVIOUS ROAD SAFETY AUDITS

- 3.1 Fenley Road Safety Limited have undertaken a number of road safety audits associated with the continuation of Coldharbour Farm Road. The latest assessed the realignment of the existing footpath cyclepath along an access road that was understood to have been approved. Since that Audit, the scheme has been amended and this Stage 1/2 Road Safety Audit reassesses all elements of the scheme and raises any road safety concerns that the Audit Team consider are present.

4.0 ITEMS RAISED AT THIS STAGE 2 ROAD SAFETY AUDIT

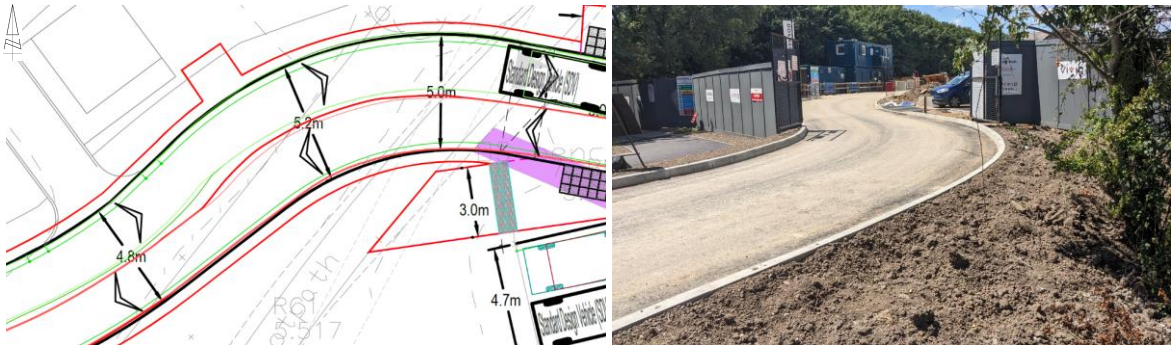B.1	LOCAL ALIGNMENT
B.1.1	PROBLEM
Location:	Proposed continuation
Summary:	Alignment may not be adequate for two-way car / LGV movements
Acc Type:	Sideswipe type collisions
<p>The scheme drawings provided with the Audit Brief, include a swept path analysis of various vehicles travelling along the proposed continuation to include large vehicles. It is noted that the large vehicles do encroach the entire carriageway and therefore opposing vehicles must stop and wait. This is common practice in residential estates where speeds are low and intervisibility is achievable. The scheme drawings illustrate that intervisibility is achievable between locations where the vehicles can pass. It is noted, however, that there is minimal margin for error where two cars passing one another around the bends in the road. It is noted that the vehicles utilised are the accord with the requirements of TG2, however, the swept paths encroaching the proposed kerblines in places with just 250mm separating the opposing vehicles. Motorists approaching a tight bend in the road will stop and proceed cautiously when a large vehicle is observed, however, the Audit Team have concerns that car drivers will be less cautious and will attempt to pass an opposing car which could lead to sideswipe type collisions.</p>	
RECOMMENDATION:	
It is recommended that the carriageway is adequate for cars and LGVs to pass one another.	
Location Plan: 	
B.2	GENERAL
B.2.1	PROBLEM
Location:	Proposed continuation
Summary:	No details of the proposed raised table have been provided
Acc Type:	Vehicle to non-motorised user, sideswipe type collisions
<p>The proposals include the provision of an uncontrolled crossing over the proposed access road that is to be situated on a raised table. Whilst the provision of a raised table should ensure that motorists reduce their speed on approach, no details of the associated ramps have been provided. The Audit Team have concerns that the proposed raised table will be too shallow which will not</p>	

achieve the desired speed reduction which could lead to a vehicle to non-motorised user as well as sideswipe type collisions.

RECOMMENDATION:

It is recommended that the proposed raised table includes adequate ramps that force traffic slow.

Location Plan:



B.2.2 PROBLEM

Location: Coldharbour Farm Road

Summary: Vehicles may not be able to access the existing parking bays.


Acc Type: Side impact type collision


The proposals include the continuation of Coldharbour Farm Road where a number of parking bays are provided both sides of the carriageway. The existing parking cul-de-sac off the northern side is to remain largely unchanged with a 6.0 metre aisle that allows for easy access to each bay and an edge of carriageway marking provided which will highlight priorities. It is noted, however, that the parking bays to the south of Coldharbour Farm Road do not benefit from an aisle that is of adequate width to allow a car to turn (6 metres). Motorists wishing to access the existing bays, will therefore be required to reverse off or onto the Coldharbour Farm Road carriageway. Speeds will be low and therefore motorists should become aware of one another and proceed accordingly. The Audit Team have concerns, however, that a vehicle will be required to encroach the proposed uncontrolled crossing or shared footway cycleway when manoeuvring into / out of the existing spaces which could lead to vehicle to non-motorised user type collisions.


RECOMMENDATION:

It is recommended that the bays are accessible.

Location Plan:

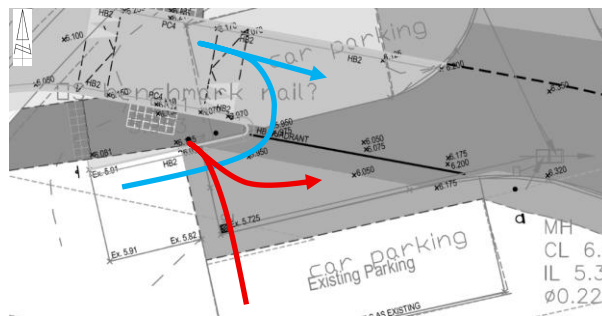

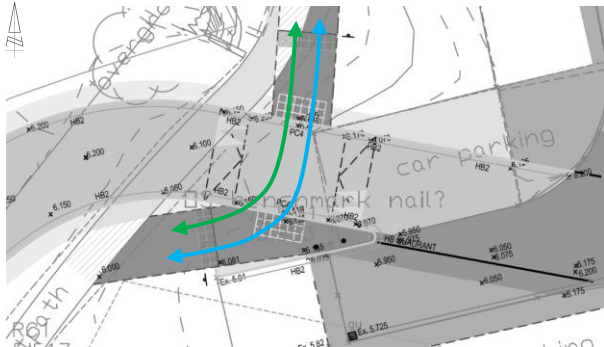
B.3	JUNCTIONS
	<i>No Road Safety Concerns regarding JUNCTIONS have been raised at this stage</i>
B.4	WALKING, CYCLING AND HORSE RIDING
B.4.1	PROBLEM
Location:	Proposed uncontrolled crossing
Summary:	Cyclists are likely to continue without giving way to traffic
Acc Type:	Vehicle to cyclist type collisions
<p>To the west of Coldharbour Farm Road, an existing shared footpath (ref: 108/71/1) is present. This route provides access between the residential area of Emsworth to the south of the A27 and leisure facilities to the north to include Emsworth Park. This route is utilised by pupils and parents / guardians of the local primary school as well as pedestrians and cyclists with numerous cyclists observed during then site visits associated with the scheme. The proposals include the continuation of Coldharbour Farm Road to form a development access which severs the existing footpath. The scheme drawing details that an uncontrolled crossing is to be provided on a raised table. Whilst non-motorised users should stop at an uncontrolled crossing and not proceed until it is safe to do so, the Audit Team have concerns that cyclists as well as some pedestrians will proceed without stopping which could lead to vehicle to non-motorised user type collisions. It is understood that cyclists should not utilise the existing footpath, however, it is a fact that they do.</p>	
RECOMMENDATION:	
It is recommended that an appropriate level of visibility is achievable.	
<p>Location Plan:</p>  	
B.4.2	PROBLEM
Location:	Coldharbour Farm Road
Summary:	Non-motorised users at and on approach to the uncontrolled crossing may not be clearly visible during the hours of darkness
Acc Type:	Vehicle to pedestrian type collisions
<p>The public footpath 108/71/1 that is present to the west of the Coldharbour Farm Road cul-de-sac provides a link between the facilities available at Emsworth Park and the residential areas to the south. During the site visits associated with this scheme, numerous pedestrians to include joggers and cyclists have been observed. The proposals include the continuation of Coldharbour Farm</p>	
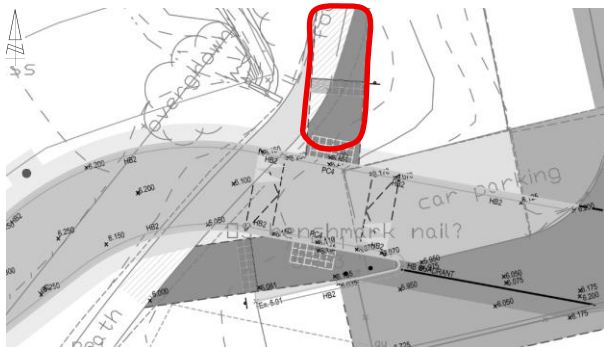
<p>Road to the west severing the existing footpath. As part of the proposals, an uncontrolled crossing is to be provided on a raised table. This crossing is to benefit from tactile paving to a depth of 1200mm which should be sufficient to warn all pedestrians of the live carriageway. The scheme drawing illustrates that visibility splays of 2.4x43 metres are achievable from the uncontrolled crossing, however, they do not extend to the tangent and it is noted that the footpath is not illuminated. The Audit Team have concerns that visibility of a non-motorised users immediately approaching the proposed uncontrolled crossing is limited, particularly during the hours of darkness which could lead to a vehicle to pedestrian type collision.</p>	
<p>RECOMMENDATION:</p>	
<p>It is recommended that visibility is achievable to the tangent and that the proposed crossing point is illuminated adequately with a column provided immediately to the west of the crossing point as previously proposed.</p>	
<p>Location Plan:</p> <div></div>	
<p>B.5</p>	<p>TRAFFIC SIGNS, CARRIAGEWAY MARKINGS AND LIGHTING</p>
	<p><i>No Road Safety Concerns regarding TRAFFIC SIGNS, CARRIAGEWAY MARKINGS AND LIGHTING have been raised at this stage</i></p>

5.0 STAGE 1/2 ROAD SAFETY AUDIT TEAM STATEMENT

5.1 We certify that this Road Safety Audit has been carried out in accordance with GG119.

 Audit Team Leader

Name:  MSoRSA, HE RSA Certificate of Competency

Signed:

Position: Road Safety / Highway Engineer

Organisation: Fenley Road Safety Limited

Date: 26th March 2026

Audit Team Member

Name: **Zane Beswick** MCIHT, MSoRSA

Signed:

Position: Road Safety / Highway Engineer

Organisation: Fenley Road Safety Limited

Date: 26th March 2026


Appendix B1

Documents and Drawings provided for this Stage 1/2 Road Safety Audit

<u>Audit Stage</u>	<u>Doc. No.</u>	<u>Rev</u>	<u>Title</u>
Stage 1/2	Email dated 22 nd June 2025		Stage 1/2 Road Safety Audit Brief
	<u>Dwg No.</u>	<u>Rev</u>	<u>Title</u>
	23339_JUBB_XX_XX_DR_C_100	C9	S278 Combined
	23339_JUBB_XX_XX_DR_C_1200	C2	S278 TRACKING
	23339_JUBB_XX_XX_DR_C_1201	C1	S278 TRACKING SHOWING FORWARD VISIBILITY SHEET 1
	23339_JUBB_XX_XX_DR_C_2102	C1	S278 TRACKING WITH FORWARD VISIBILITY SHEET 2

Appendix B2


Item Location Plan

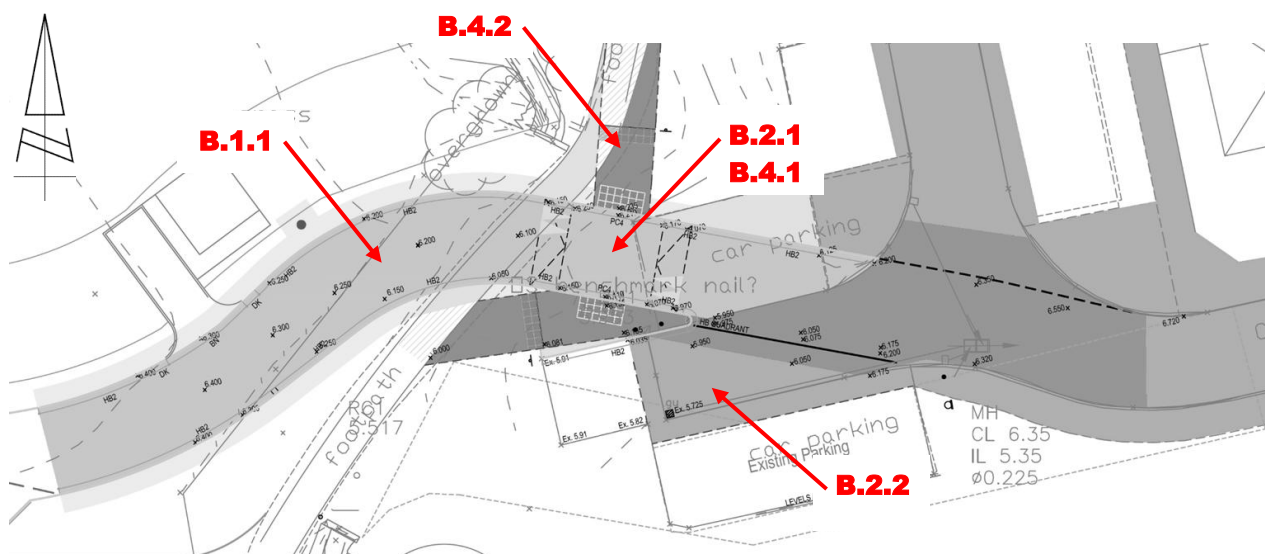

fenley


APPENDIX B

Drawing Pack

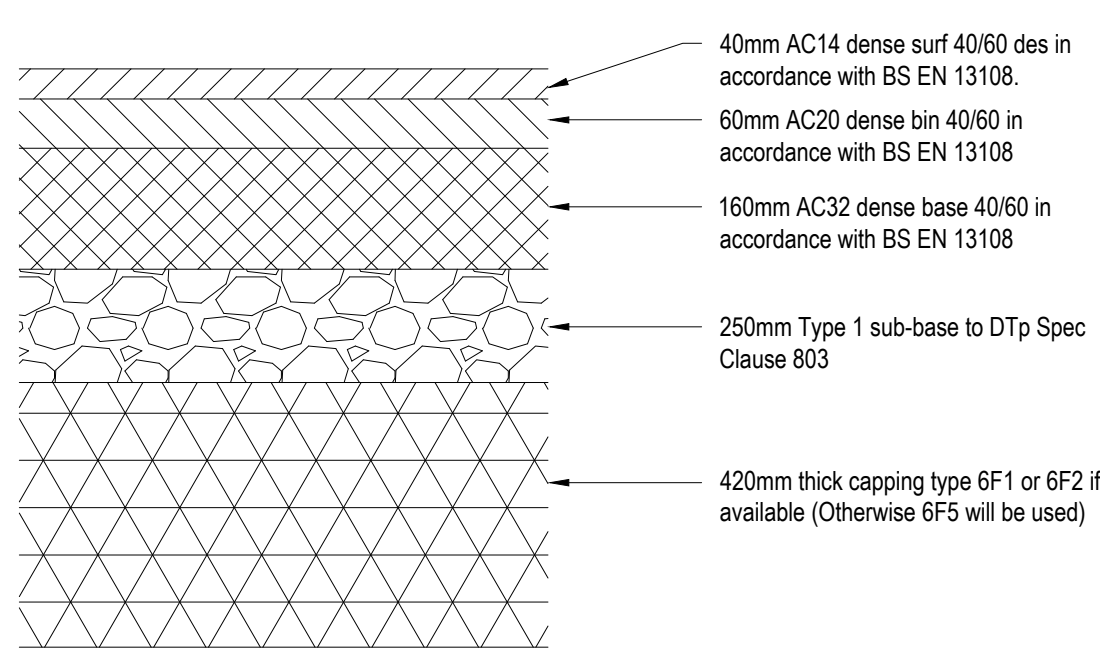

- Notes:
- Build-up based on CBR values of 2%, TBC prior to construction. Depths calculated using CD 225. Foundation class 2. 30MPa modulus value used.
 - 40/60 penetration grade bitumen shall be used at all times.
 - Construction depth to be minimum 450mm depth of non-frost susceptible material

CARRIAGEWAY CONSTRUCTION DETAIL

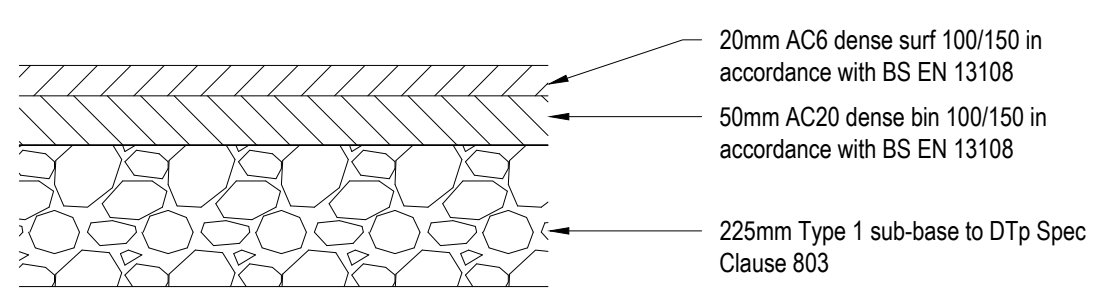

- Notes:
- Build-up based on CBR values of 2%, TBC prior to construction. Depths calculated using CD 225. Foundation class 2. 30MPa modulus value used.
 - Construction depth to be minimum 450mm depth of non-frost susceptible material


FOOTWAY CONSTRUCTION DETAIL



2 No. Oncoming vehicles in middle of road (Diag 513.4) Mounted on post



1 No. New Road Layout Ahead (Diag 7014) Mounted on post min 30m in advance from New Layout

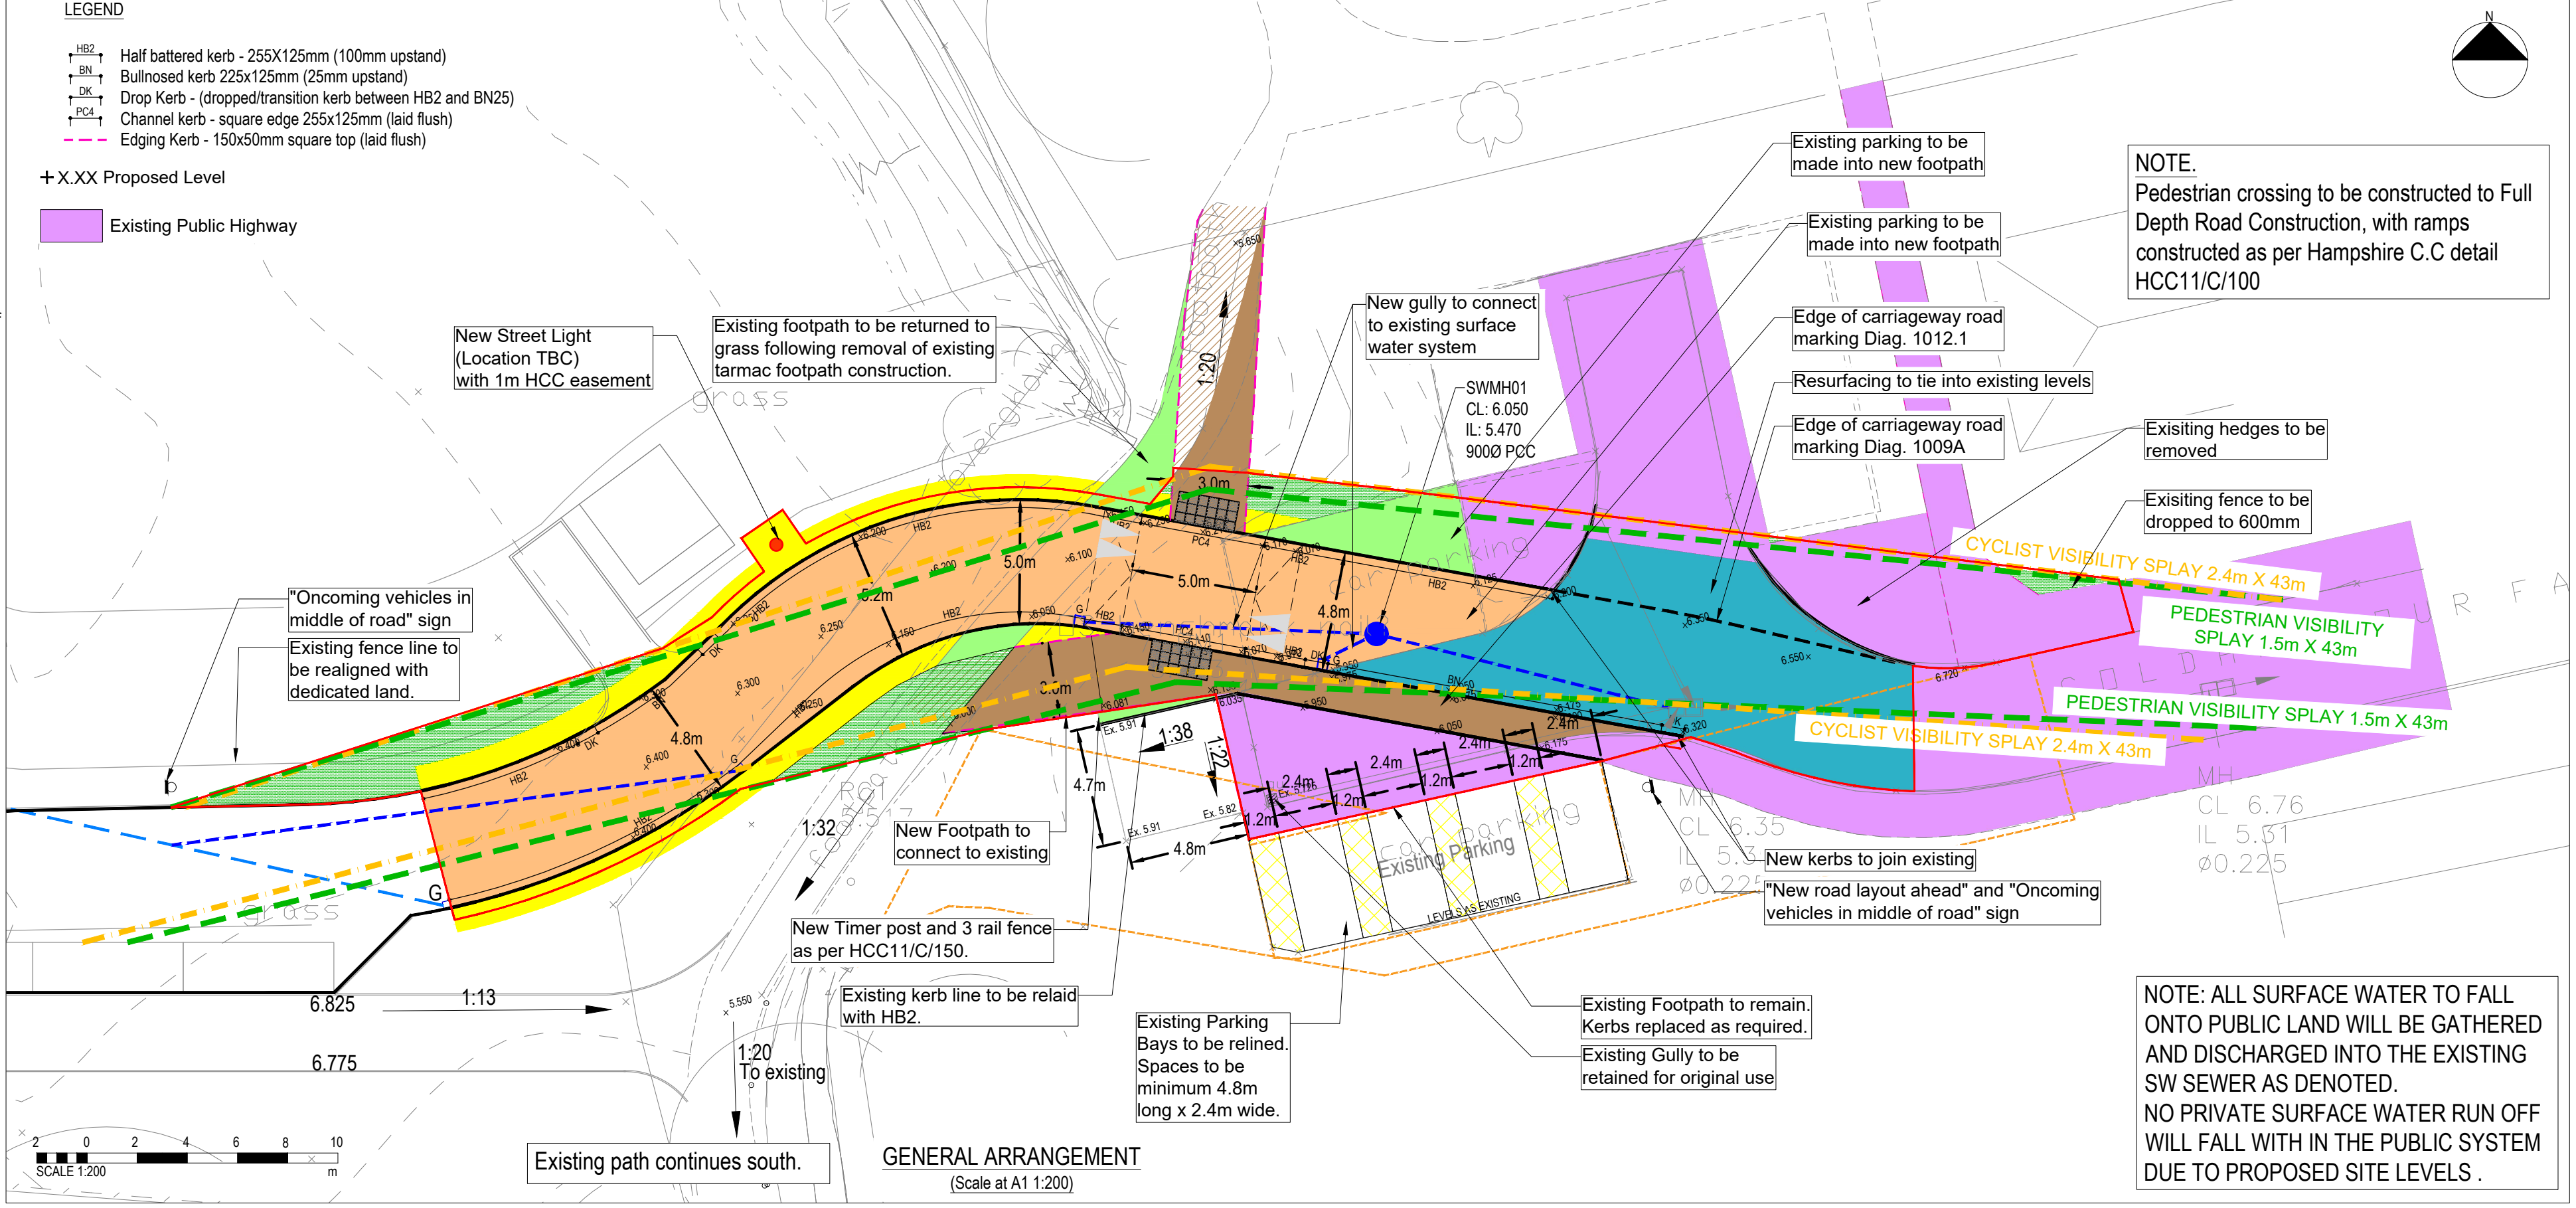

- LEGEND
- Half battered kerb - 255x125mm (100mm upstand)
 - Bullnosed kerb 225x125mm (25mm upstand)
 - Drop Kerb - (dropped/transition kerb between HB2 and BN25)
 - Channel kerb - square edge 255x125mm (laid flush)
 - Edging Kerb - 150x50mm square top (laid flush)
 - + X.XX Proposed Level
 - Existing Public Highway

Key	Description	Surface Course	Binder	Base	Sub-Base	Capping
	Road - Full depth construction	40mm AC14 dense surf 40/60 des in accordance with BS EN 13108	60mm AC20 dense bin 40/60 in accordance with BS EN 13108	160mm AC32 dense base 40/60 in accordance with BS EN 13108	250mm Type 1 sub-base to DTp Spec Clause 803	420mm thick capping type 6F1 or 6F2 if available otherwise 6F5 will be used
	Footway - Full depth construction	20mm AC6 dense surf 100/150 in accordance with BS EN 13108	50mm thick AC14 Dense bin 100/150 in accordance with BS EN 13108	-	225mm Type 1 sub-base to DTp Spec Clause 803	-
	Footway - Plane and overlay	20mm AC6 dense surf 100/150 in accordance with BS EN 13108	-	-	-	-
	Road - Plane and overlay	Plane 100mm thick and replace with 40mm AC10 Dense Surf 40/60 in accordance with BS EN 13108. Min PSV 65	60mm AC20 dense bin 40/60 in accordance with BS EN 13108	-	-	-
	Tactile paving	400mm x 400mm x 50mm thick tactile paving - colour buff	-	-	185mm Type 1 sub-base to DTp Spec Clause 803	-
	Corduroy paving	400mm x 400mm x 50mm thick Corduroy paving - colour buff	-	-	185mm Type 1 sub-base to DTp Spec Clause 803	-
	1m HCC Easement	-	-	-	-	-
	Landscaping area	-	-	-	-	-

Hampshire County Council Standard Detail Reference
All works are to be done in accordance with the following HCC standard details

Item	Standard Detail
Precast concrete kerbs	HCC11/C/010
Footways Type 1A	HCC11/C/045
Uncontrolled pedestrian crossing in new works	HCC11/C/060
Kerb replacement (on new base)	HCC11/M/010
Kerb replacement (on existing base)	HCC11/M/025
Flat Topped Road Hump and Junction table Type 1	HCC11/C/100
Haunch detail - min 1m	HCC11/M/020
Concrete Bollard Detail	HCC11/C/135

- Notes:
- HCC11/M/025 to include geotextile layer between the base and binder layers

DISCLAIMER NOTES:

- THIS DOCUMENT IS COPYRIGHT OF THE ORIGINATOR AND MUST BE TREATED AS CONFIDENTIAL.
- THIS DOCUMENT MUST NOT BE ALTERED, REPRODUCED OR DISTRIBUTED WITHOUT PRIOR WRITTEN CONSENT OF THE ORIGINATOR.
- THIS DOCUMENT MUST NOT BE ALTERED - THE ORIGINATOR ACCEPTS NO RESPONSIBILITY FOR ANY DISCREPANCIES ARISING AS A RESULT OF THE ORIGINATOR'S INFORMATION BEING ALTERED BY OTHERS.
- ANY DISCREPANCY MUST BE REPORTED TO THE ORIGINATOR.
- DO NOT SCALE THIS DOCUMENT - USE FIGURED DIMENSIONS ONLY.
- ALL DIMENSIONS MUST BE CHECKED ON SITE PRIOR TO COMMENCEMENT OF ANY RELATED WORKS.
- THIS DOCUMENT MUST BE READ IN CONJUNCTION WITH ALL SUPPORTING DOCUMENTS PRODUCED BY THE ORIGINATOR AND OTHER PROJECT DISCIPLINES.
- THE ORIGINATOR ACCEPTS NO RESPONSIBILITY FOR THE ACCURACY OF BACKGROUND INFORMATION PRODUCED BY THIRD PARTIES - THIS MUST BE TREATED AS INDICATIVE ONLY.
- USERS OF THIS DOCUMENT ARE RESPONSIBLE FOR CHECKING WHICH REVISION IS CURRENT.
- THE DOCUMENT STATUS 'INFORMATION' OR 'PRELIMINARY', INDICATES THAT THIS DRAWING IS FOR REFERENCE PURPOSES ONLY - THE ORIGINATOR WILL ACCEPT NO RESPONSIBILITY FOR THE COMPLETENESS OF INFORMATION UNDER THIS STATUS.
- THE DOCUMENT STATUS 'RECORD' OR 'AS BUILT' HAS BEEN PREPARED, IN PART, BASED UPON INFORMATION FURNISHED BY OTHERS. WHILE THIS INFORMATION IS BELIEVED TO BE RELIABLE, THE ORIGINATOR ASSUMES NO RESPONSIBILITY FOR THE ACCURACY OF THIS 'RECORD' OR 'AS BUILT' DOCUMENT OR FOR ANY ERRORS OR OMISSIONS THAT MAY HAVE BEEN INCORPORATED INTO IT AS A RESULT OF INCORRECT INFORMATION PROVIDED TO THE ORIGINATOR. THOSE RELYING ON THE 'RECORD' OR 'AS BUILT' DOCUMENT ARE ADVISED TO OBTAIN INDEPENDENT VERIFICATION OF ITS ACCURACY.

- DRAWING NOTES:
- NOTES
- Do not Scale from this drawing
 - Print in colour
 - All dimensions in metres, unless stated otherwise
 - All proposed construction is within both HCC and developers ownership boundaries
 - Proposed adoptable footway and highway to tie in to existing levels
 - Site boundary drawing based on HCC Ordnance Survey
 - Tie in detail to avoid wheel track zone. For a 3.65m wide lane, the wheel track zones shall be taken to be between 0.5m and 1.1m and between 2.55m and 3.15m from the centre of the nearside lane markings for each traffic lane (or, in the absence of lane markings, lane edges)

C13	Landscaping & red line boundary updated	08.05.26	JF	TC
C12	Bollards removed from footpath	06.05.26	JF	TC
C11	Footpath/parking bays added to drawing	23.04.26	JF	TC
C10	Footpath to north of access incorporated	02.04.26	PJ	CL
C9	Updated following additional comments	19.03.26	PJ	TC
C8	Updated following RSA comments	02.01.26	PJ	PB
C7	HCC Easement added	15.12.25	PJ	PB
C6	Updated following comments, received 03.12.2025	08.12.25	PJ	PB
C5	Updated to Ridge Frame	25.11.25	PJ	PB
C4	Updates	04.09.25	RL	RL
C3	Updates to Resurfacing	12.05.25	AH	RL
C2	Construction Issue	09.05.25	AH	RL
C1	Construction Issue	28.03.25	AH	RL
P13	Updated To HCC comments	11.03.25	AH	RL
P12	Highway Boundary Updated	17.01.25	AH	RL
P11	Updated to HCC comments	26.11.24	AH	RL
P10	Street lighting added	07.01.24	RL	RL
P9	Updated to HCC comments	02.08.24	AH	RL
P8	Crossing location updated	25.07.24	AH	RL
P7	Updated to HCC comments	25.06.24	AH	RL
P6	Updated to Comments	03.06.24	AH	RL
P5	S278 submission	18.04.24	AH	RL
P4	Updated Widths and Splays	05.04.24	AH	RL
P3	Updated to suit amended access.	22.03.24	SH	RL
P2	Preliminary Issue	07.03.23	AH	RL
P1	Preliminary issue	15.11.23	AK	RL
REV	DESCRIPTION	DATE	BY	CHKD

ORIGINATOR: www.ridge.co.uk

RIDGE

PROJECT NUMBER: 23339

CLIENT: DOSWELL PROJECT

IN ASSOCIATION WITH:

PROJECT: COLDHARBOUR FARM ROAD EMSWORTH

TITLE: S278 COMBINED



DRAWN BY: AK CHECKED BY: APPROVED BY:


SCALE: AS SHOWN @ A1 DATE: 15.11.2023

STATUS: DESCRIPTION:


DRAWING NO: JUBB_XX_XX_DR_C_100

PROJECT: 23339 ORG: JUBB FUNCTION: XX SPATIAL: XX DR DISCIPLINE: X NUMBER: 000100 REV: C13

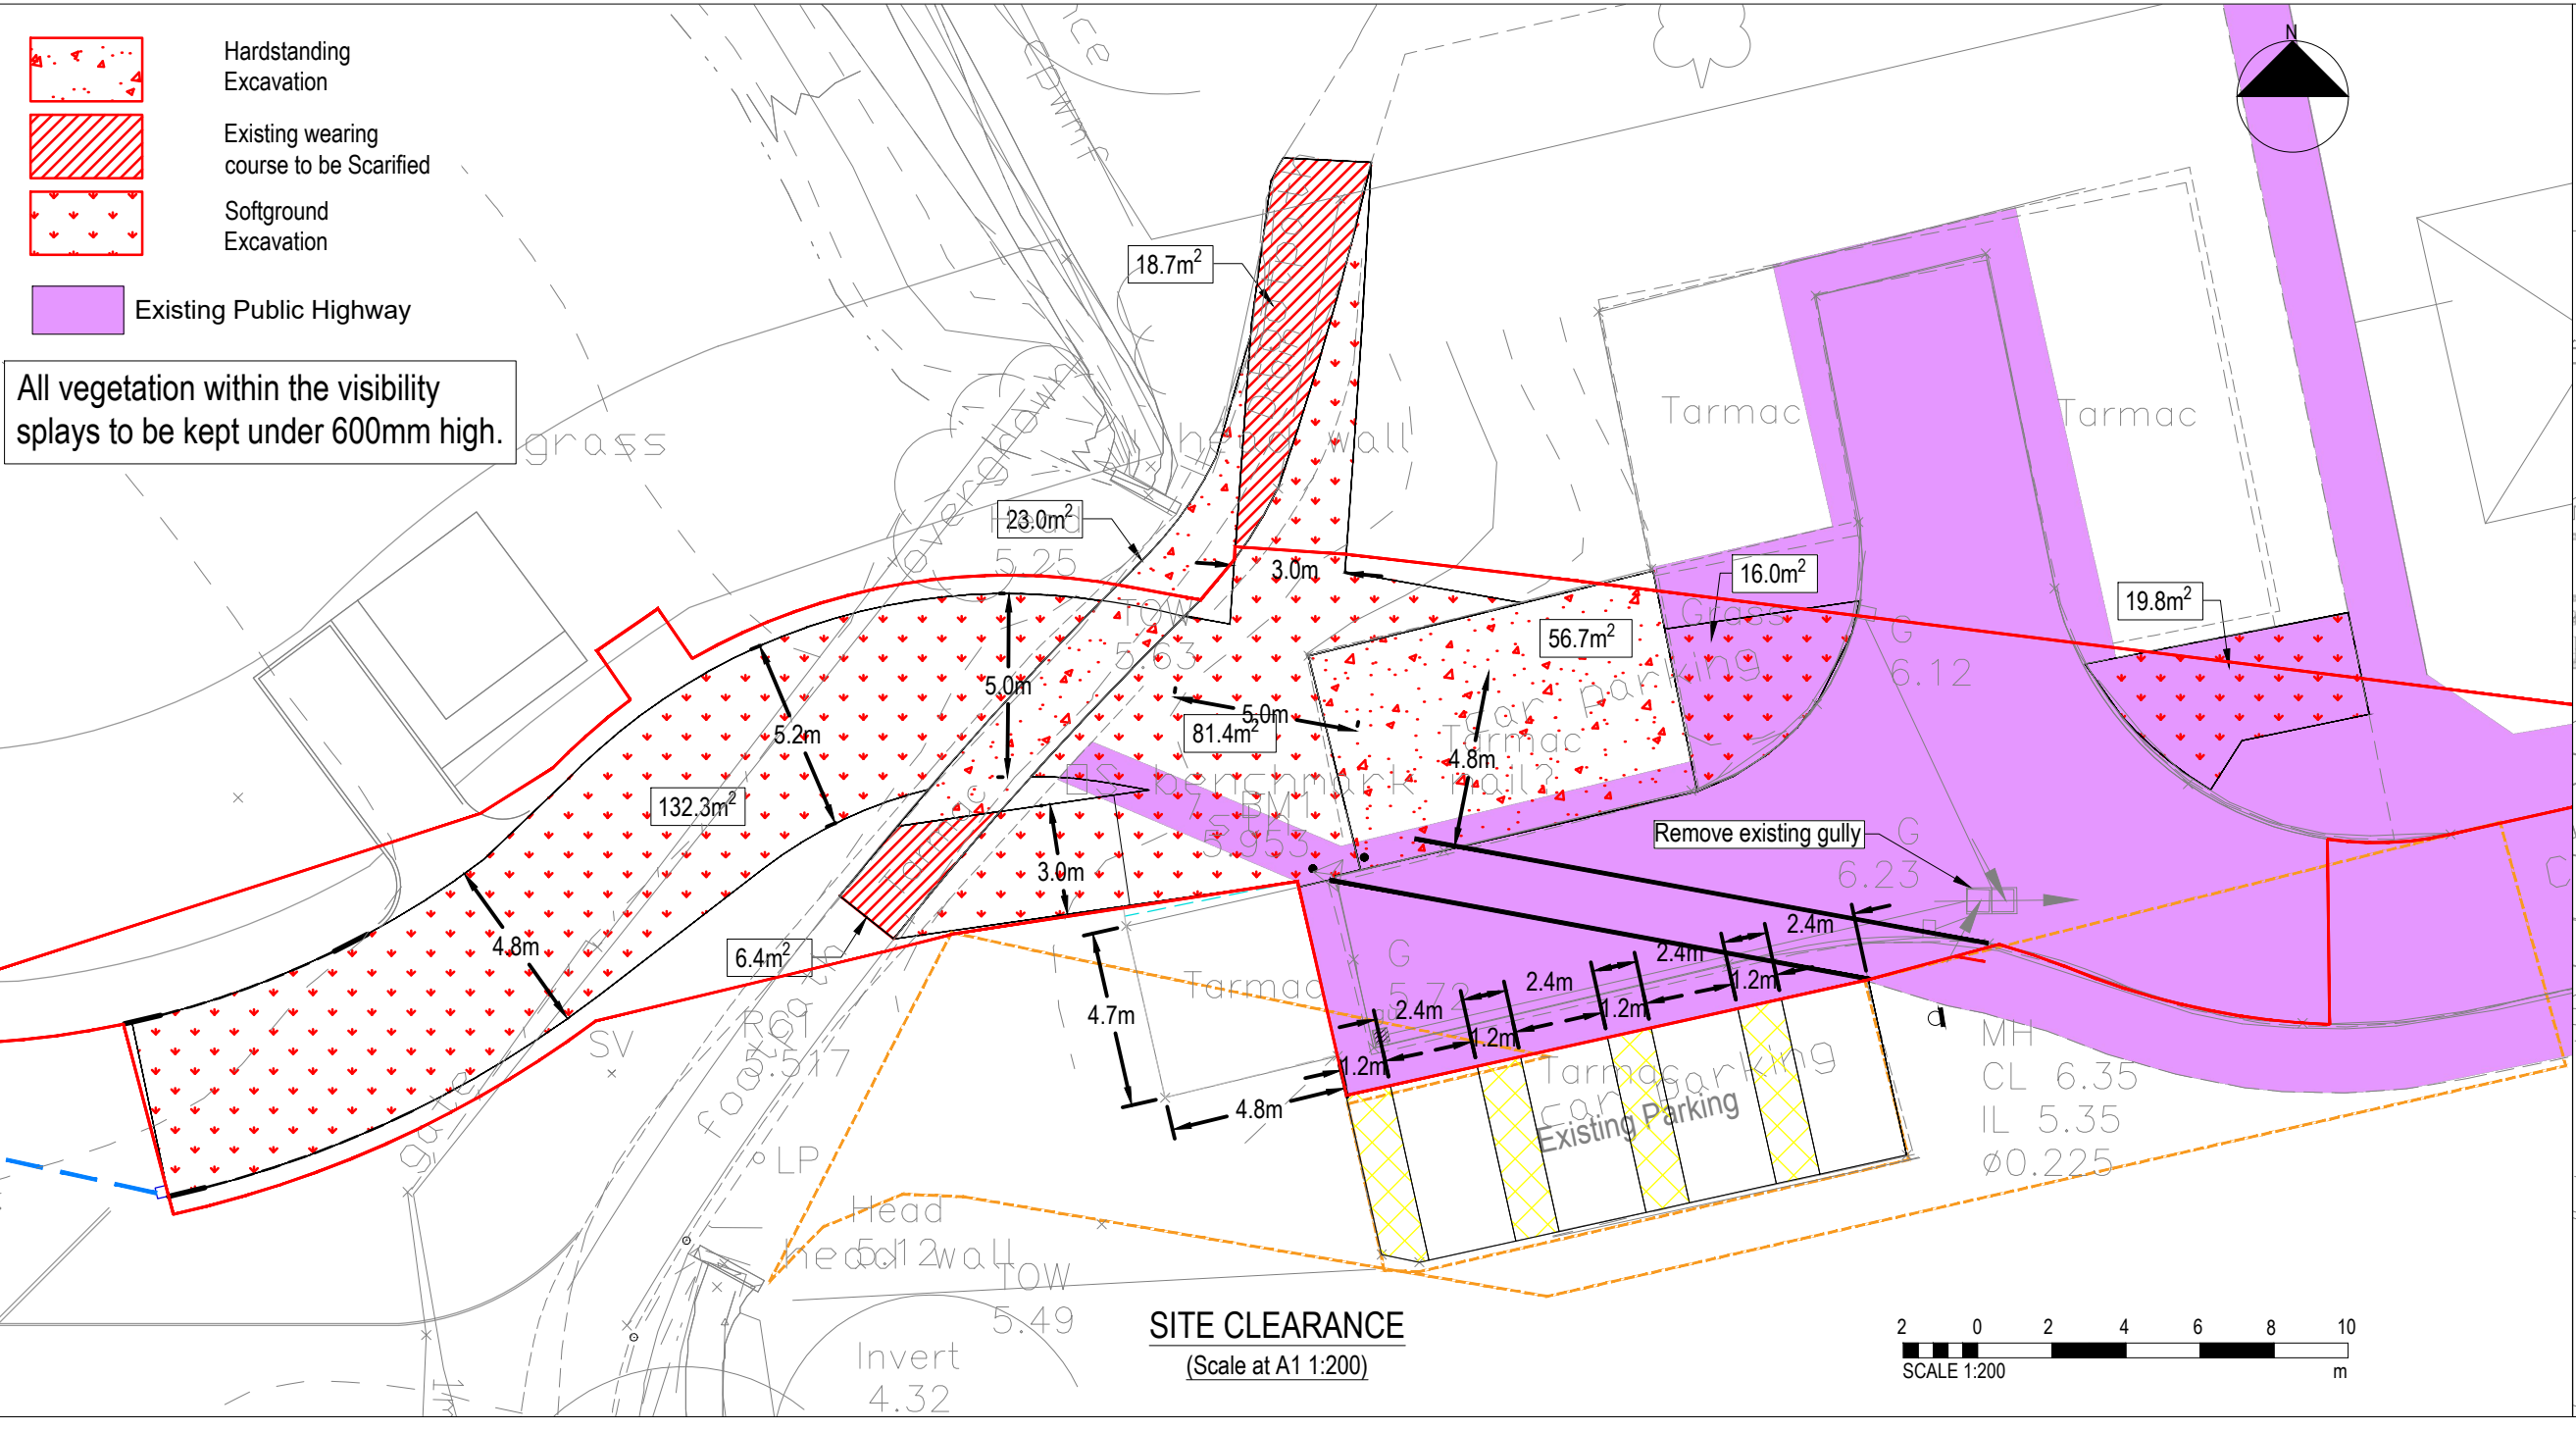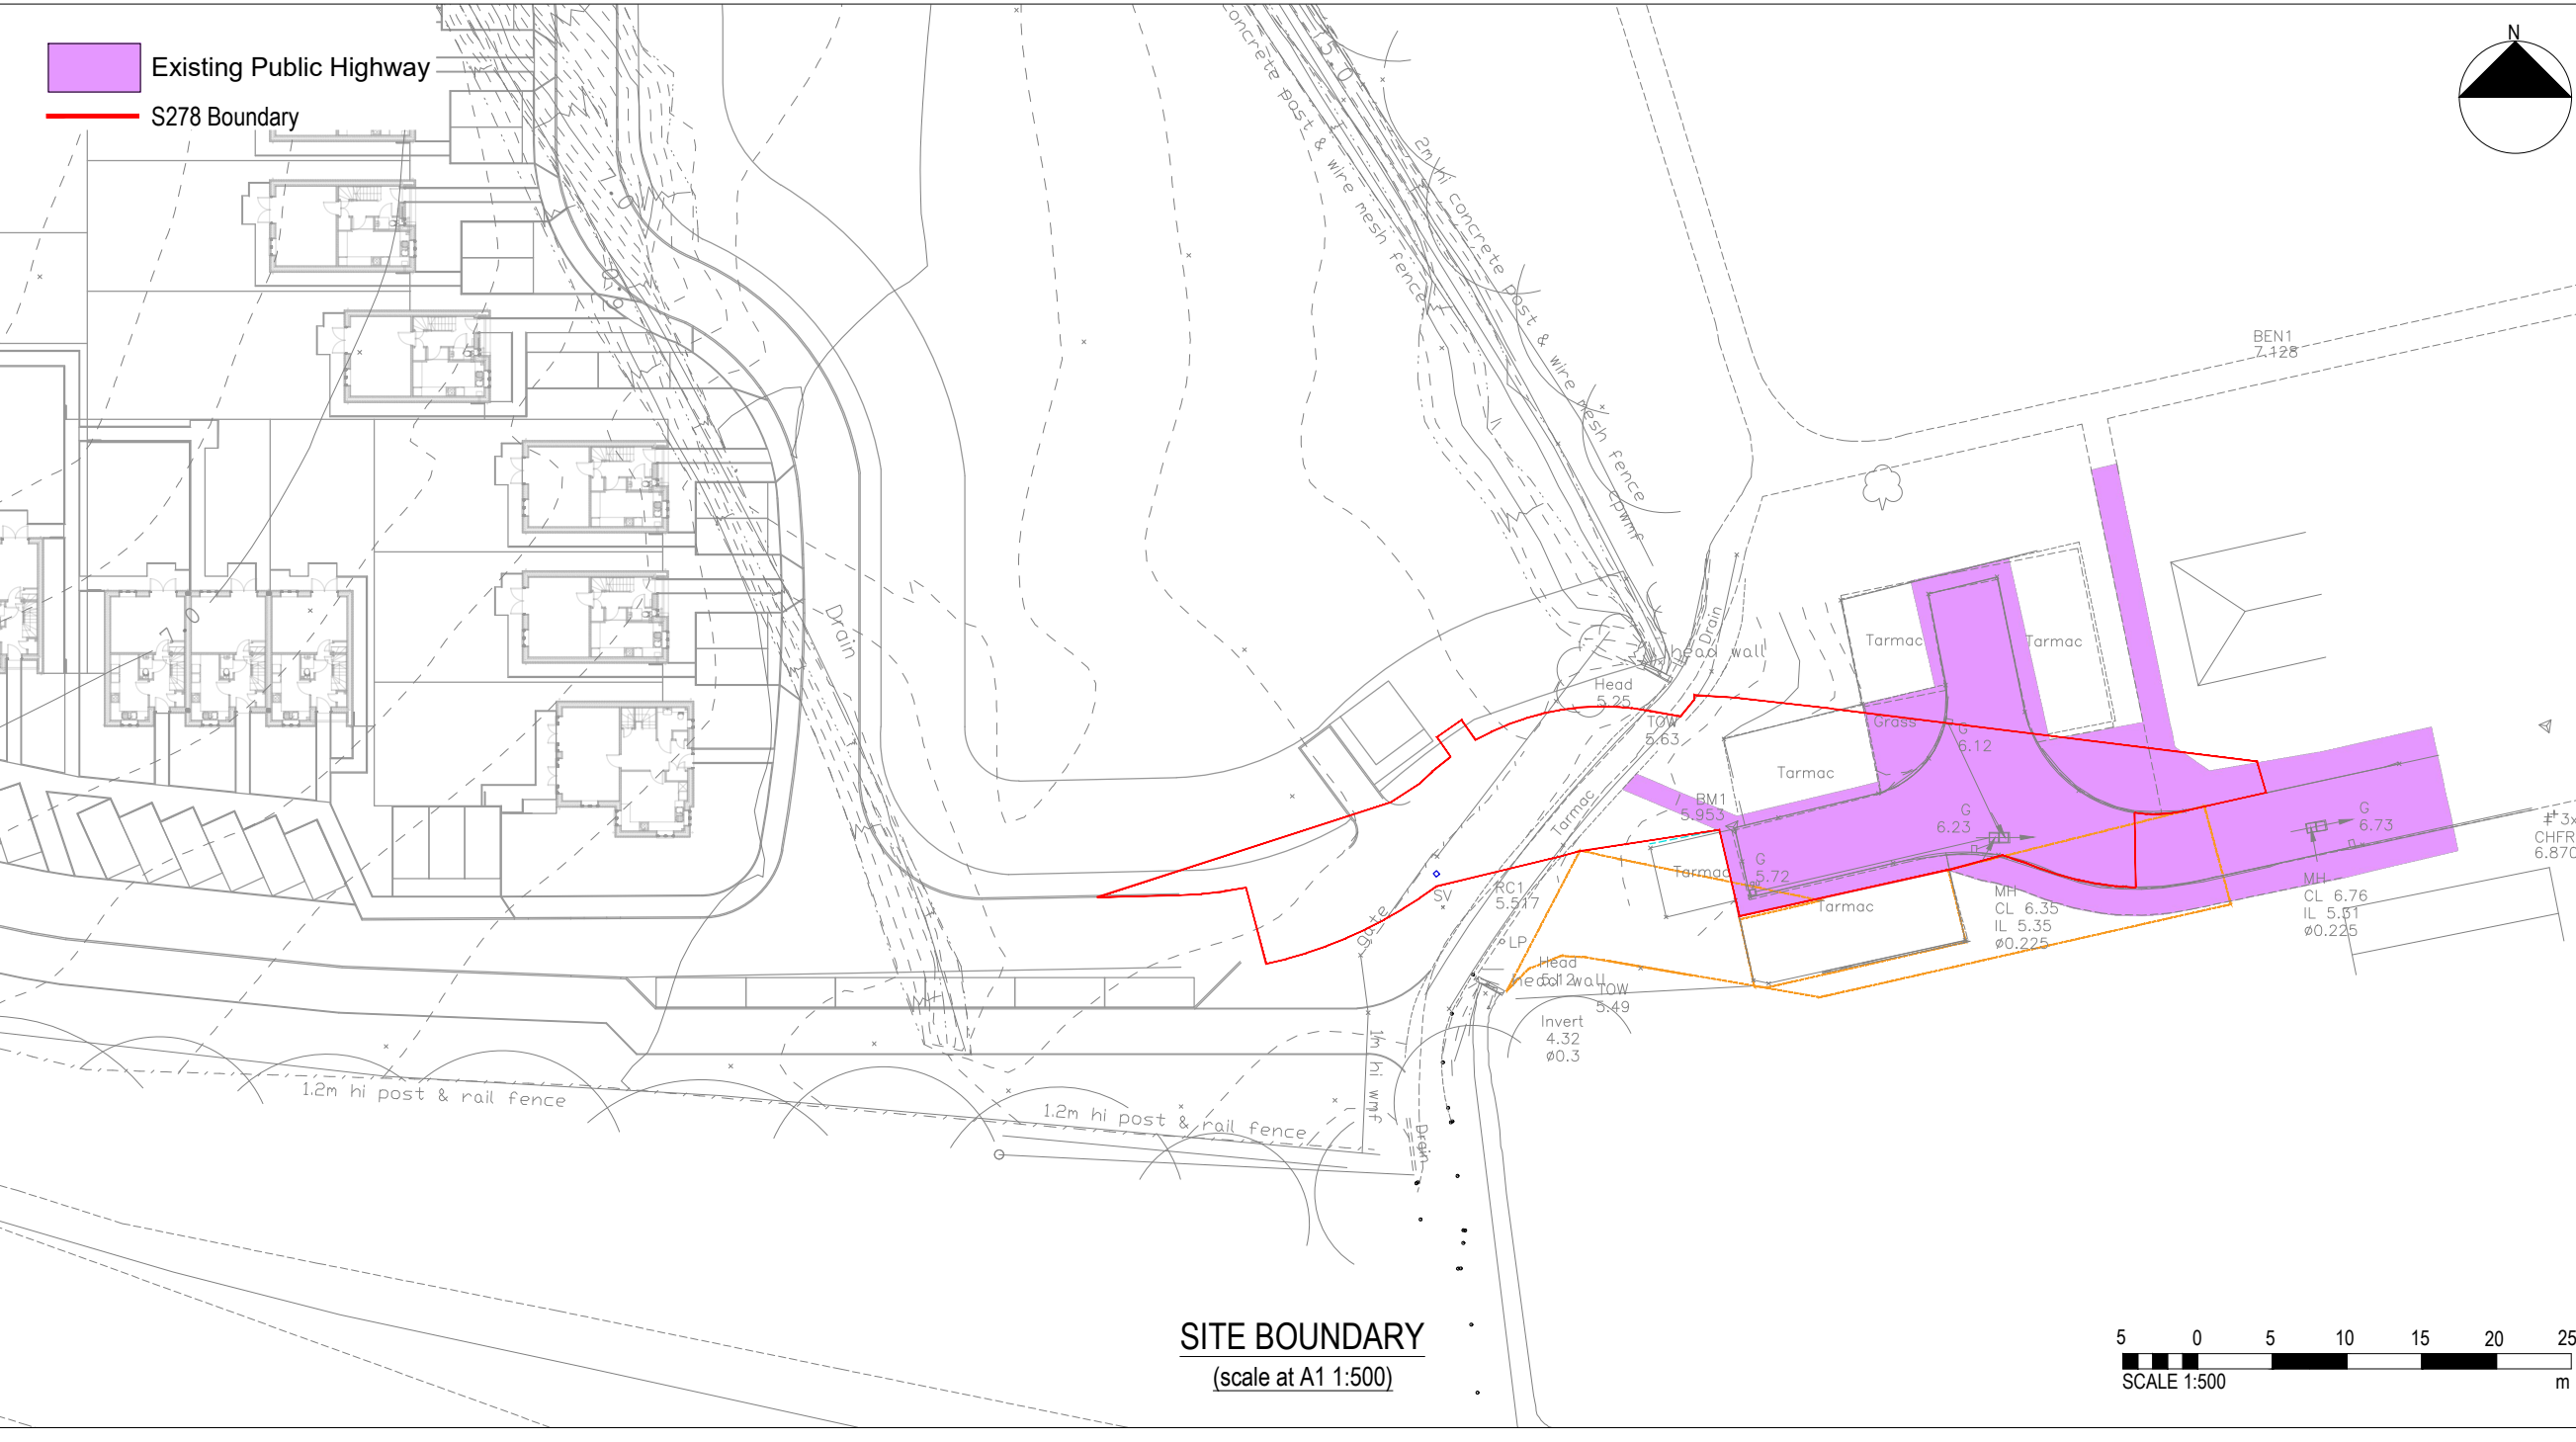


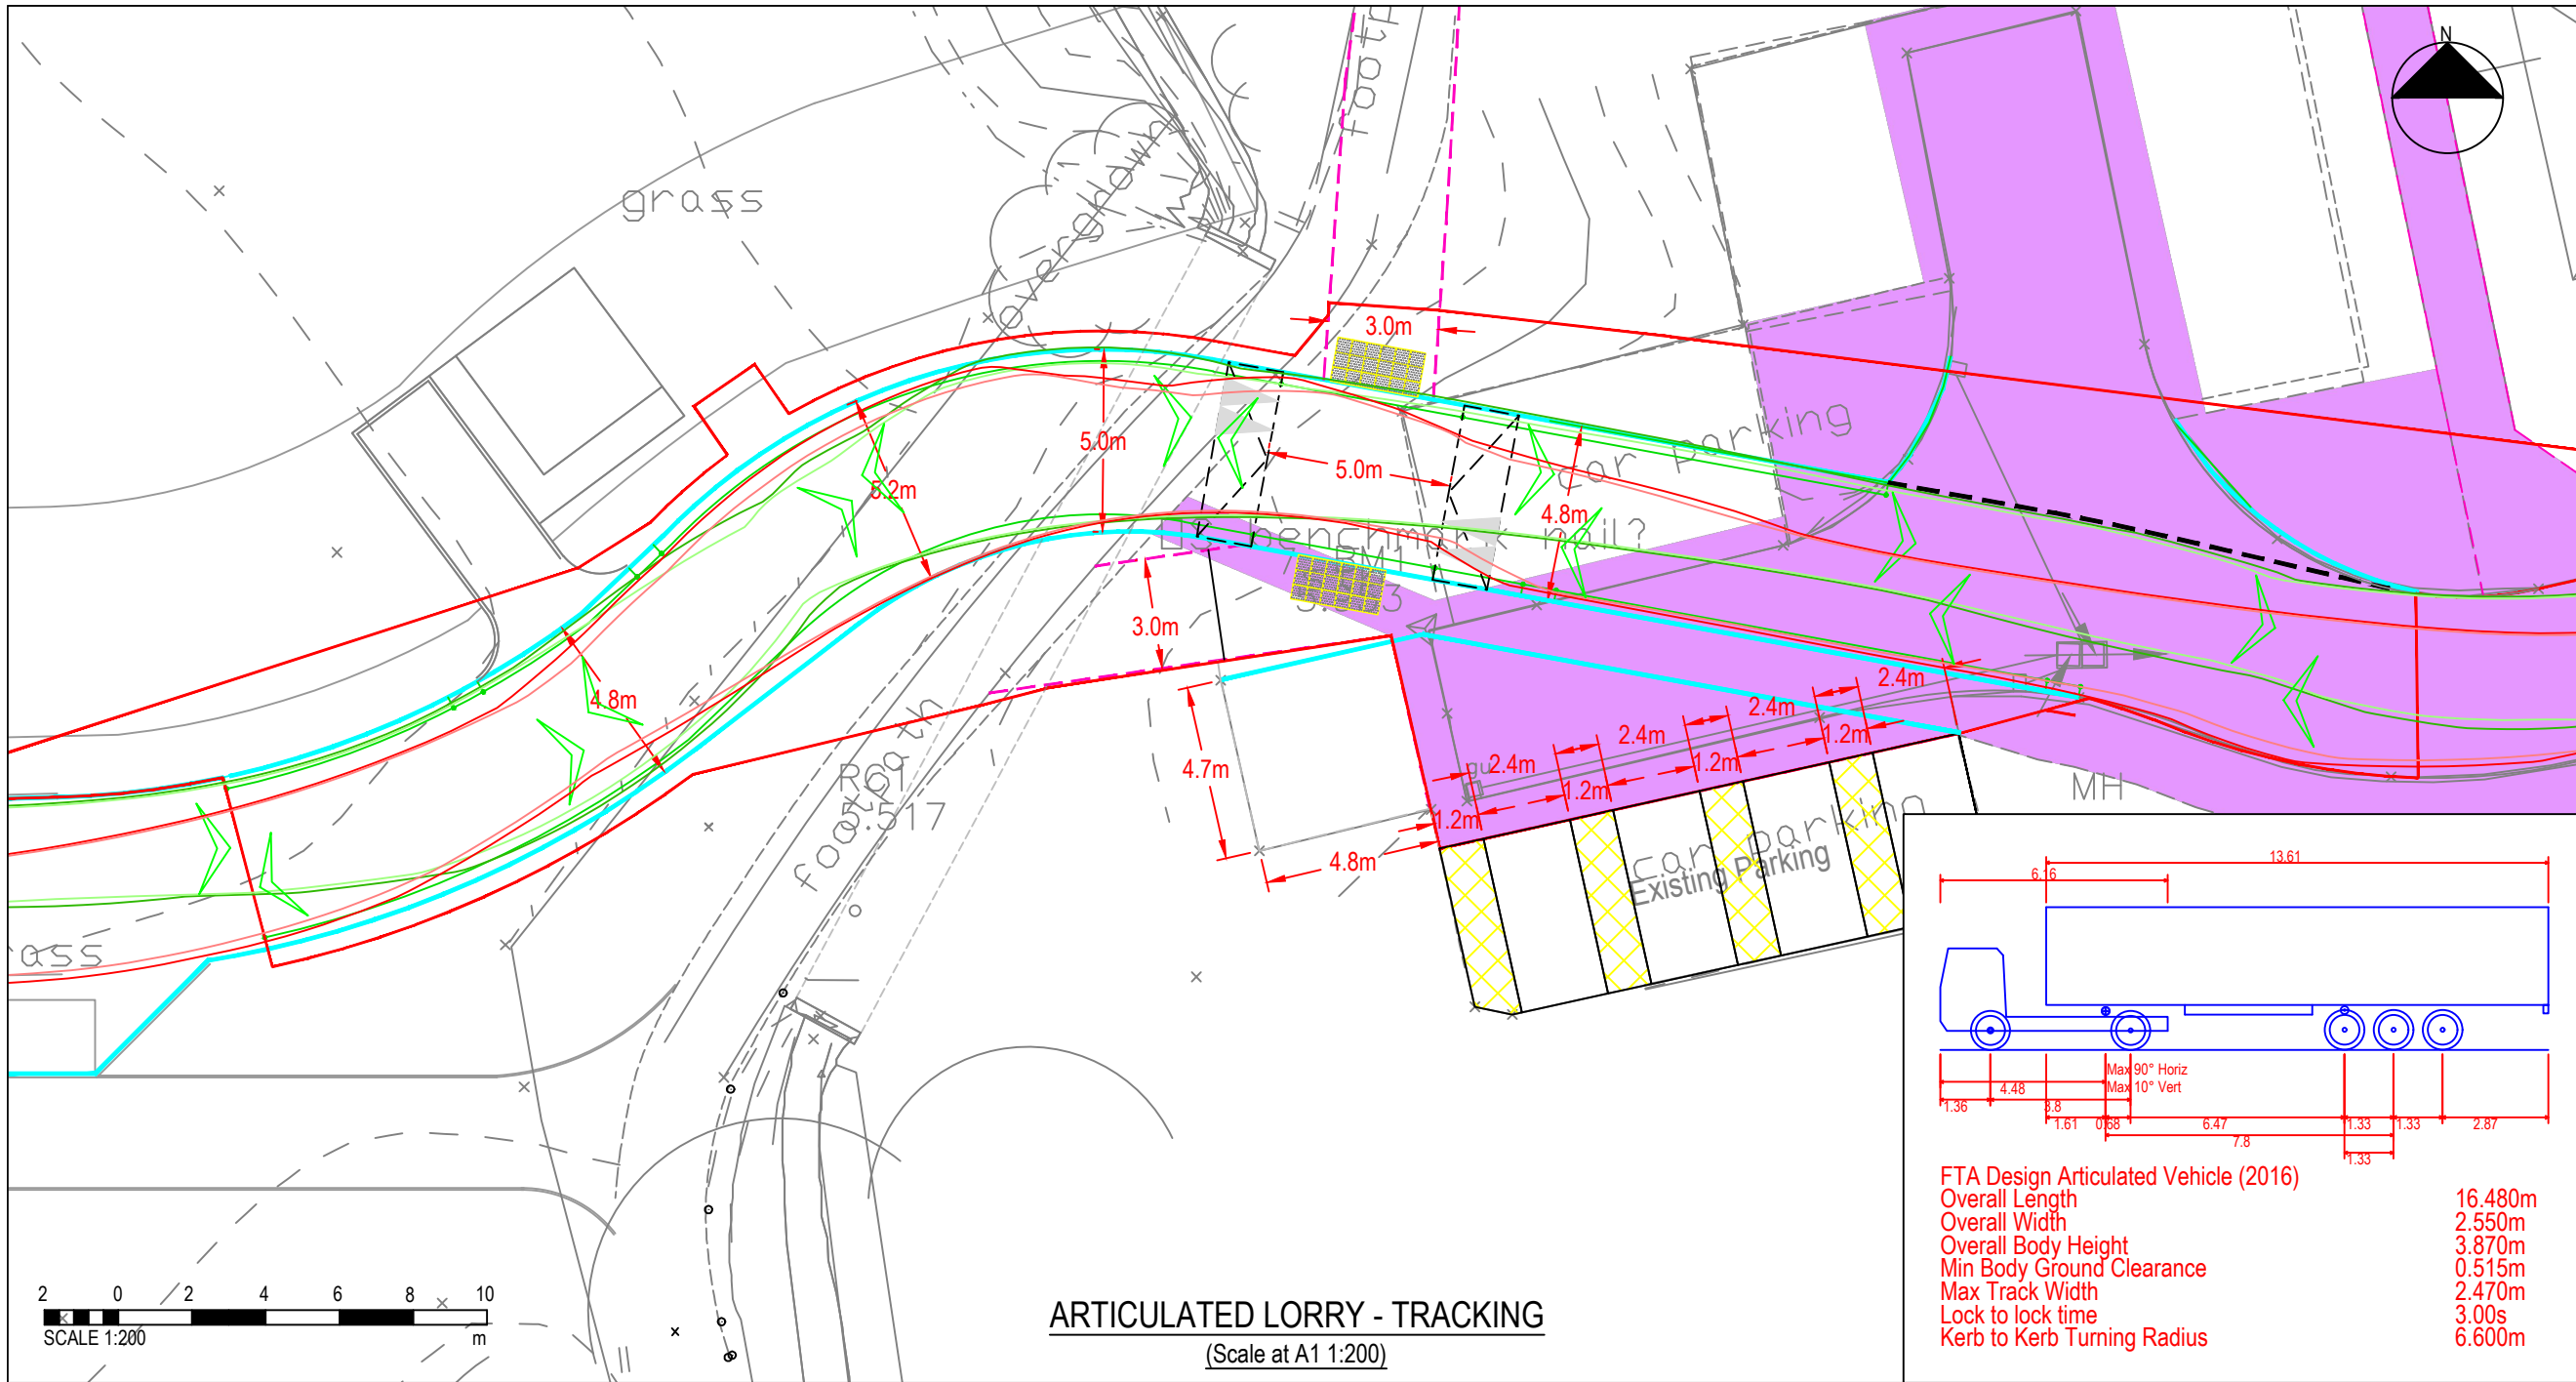


ARTICULATED LORRY - TRACKING
(Scale at A1 1:200)

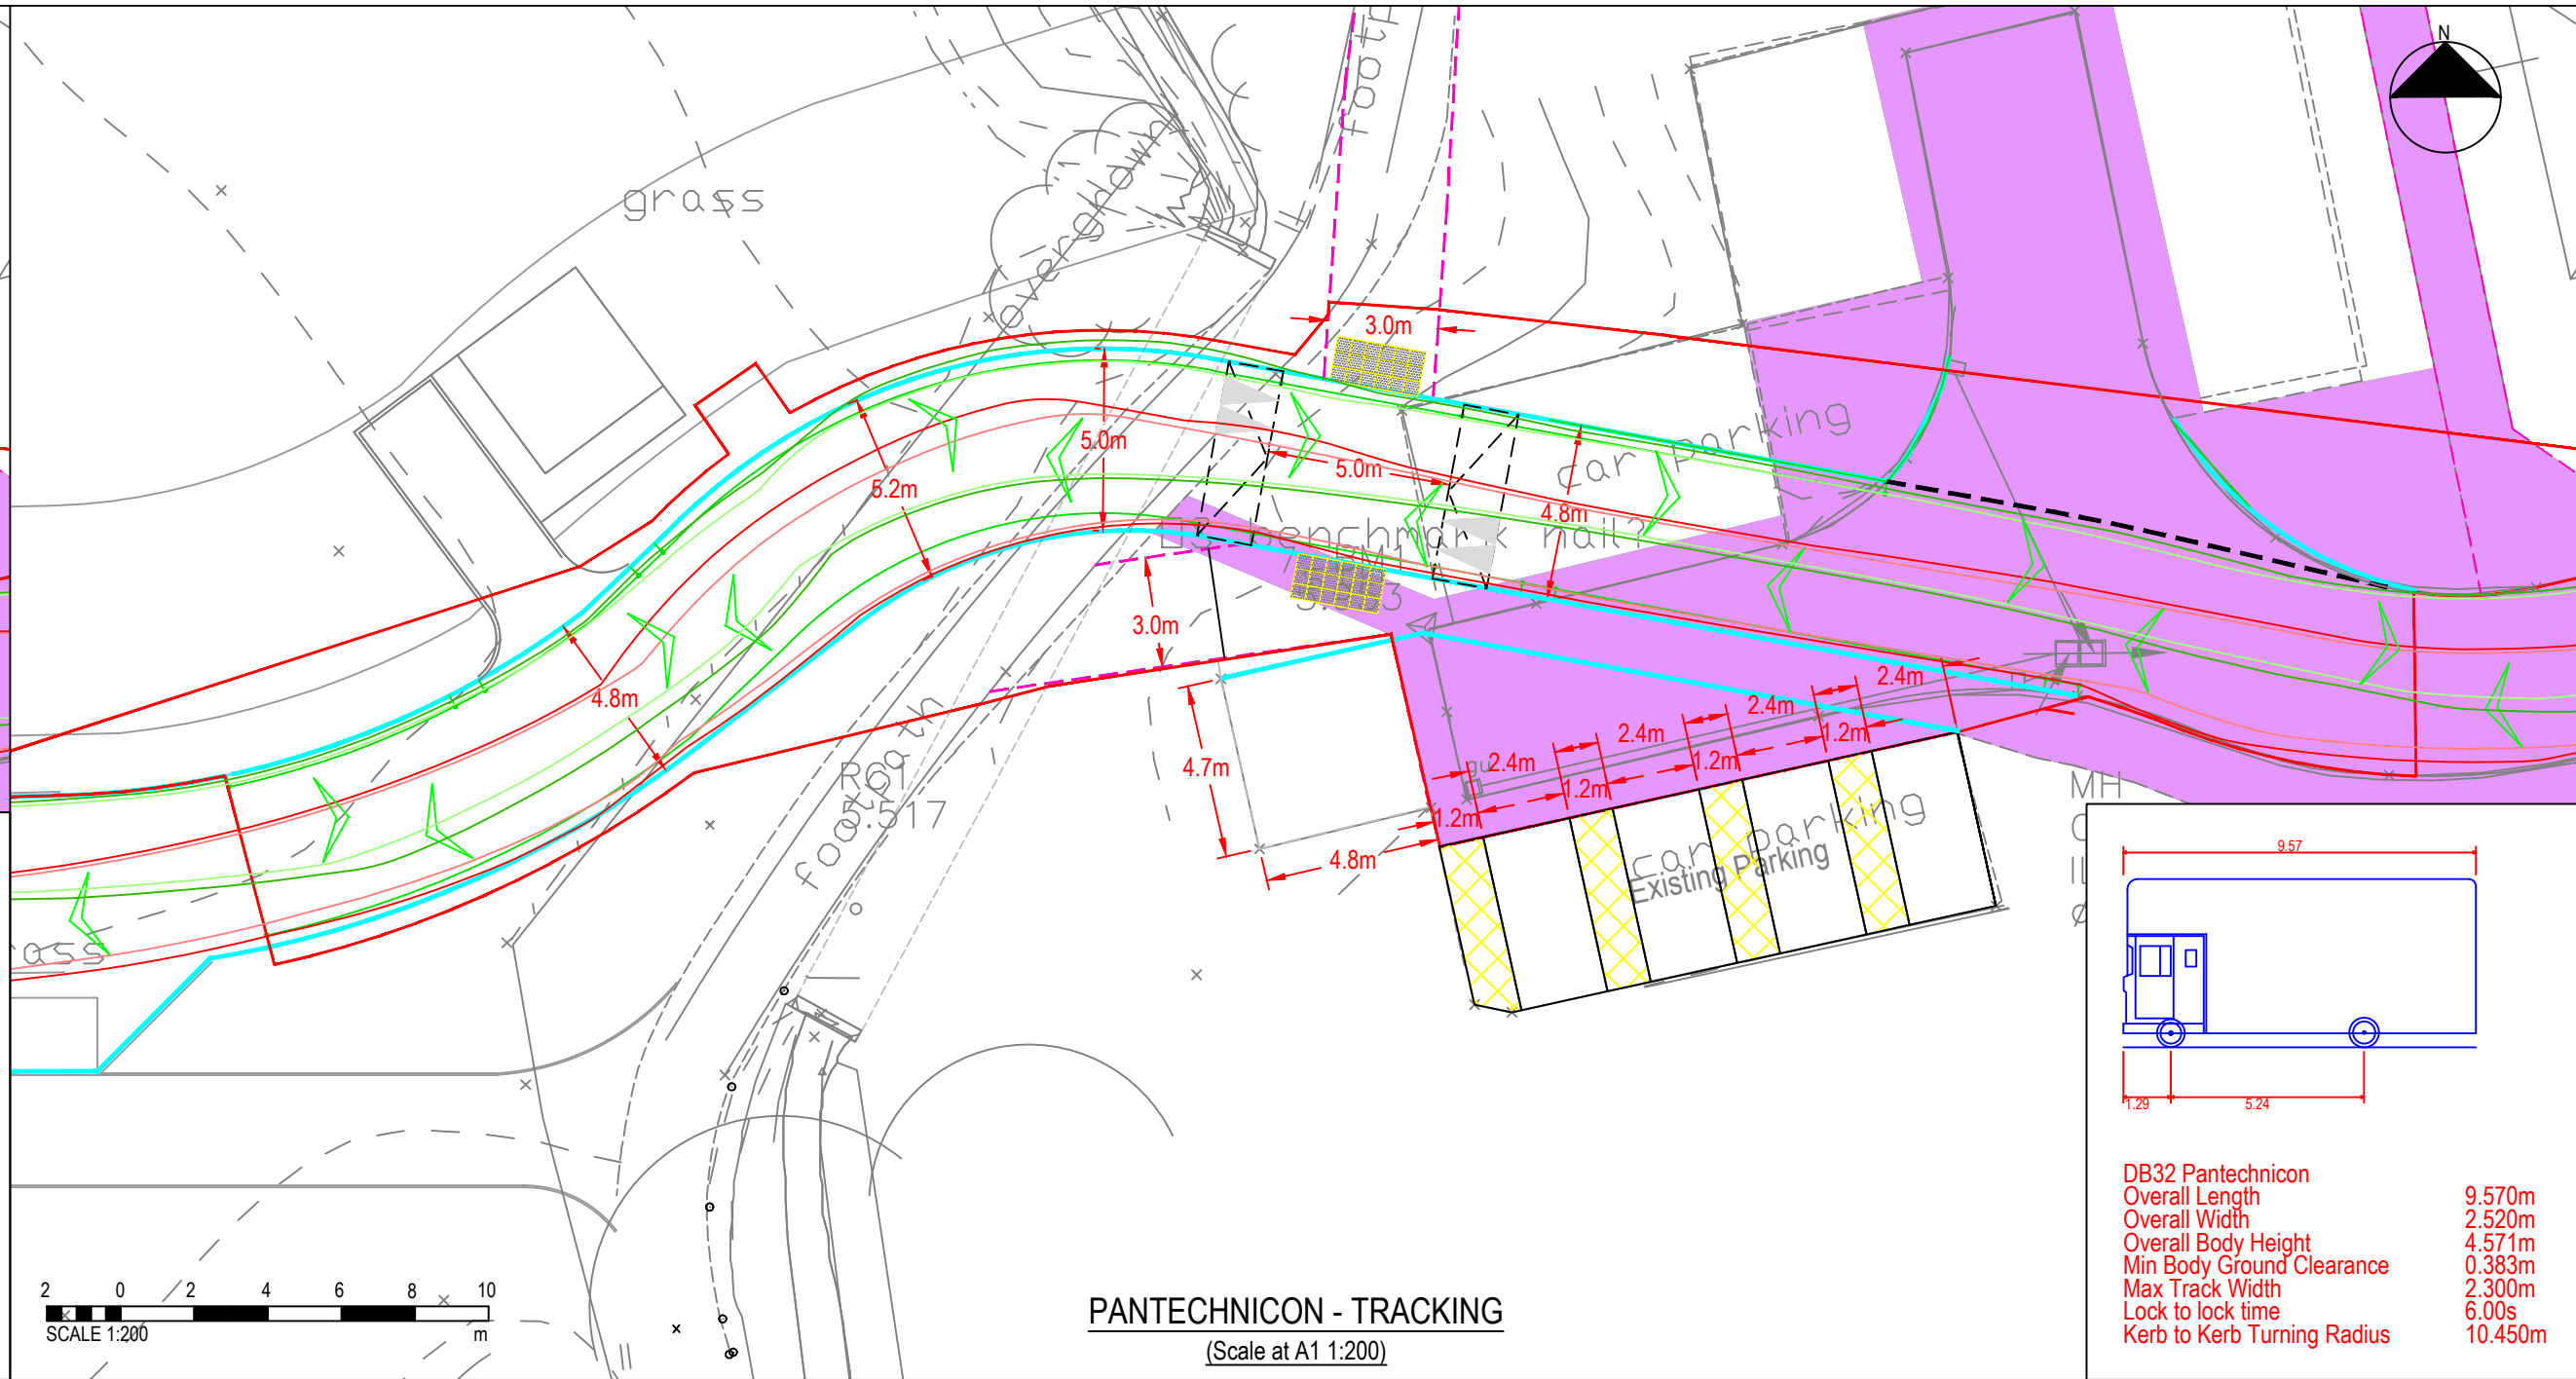


PANTECHNICON - TRACKING
(Scale at A1 1:200)

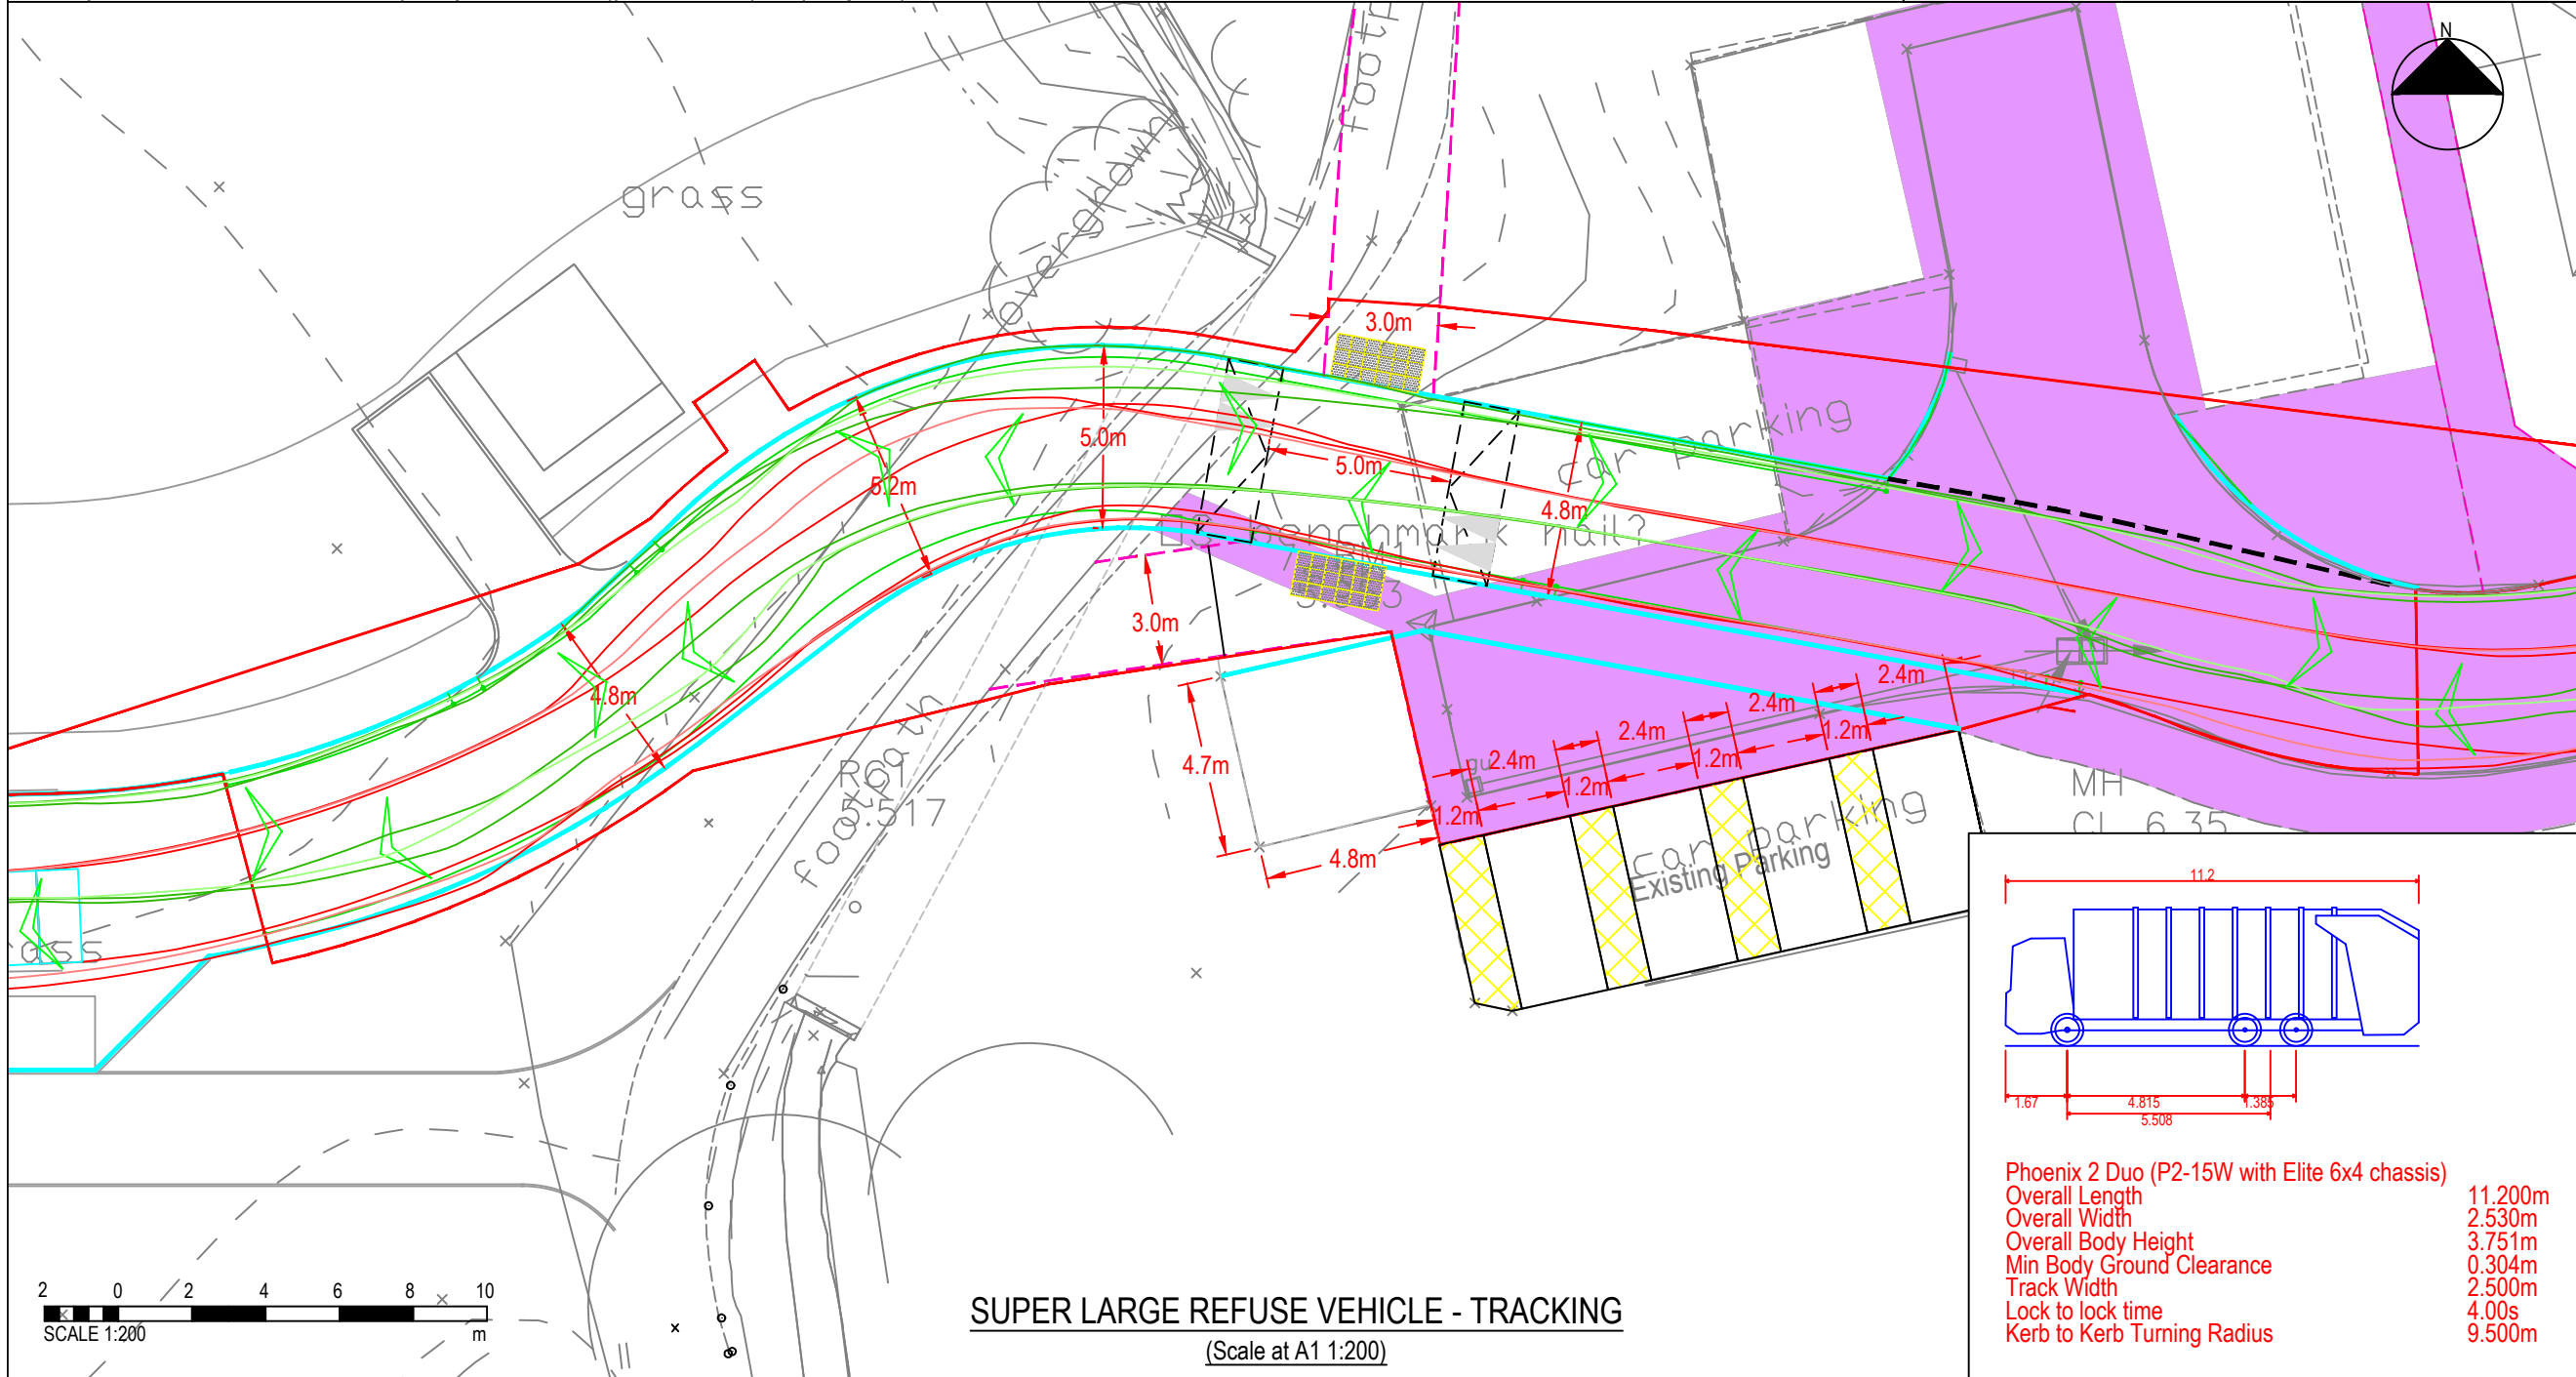


SUPER LARGE REFUSE VEHICLE - TRACKING
(Scale at A1 1:200)

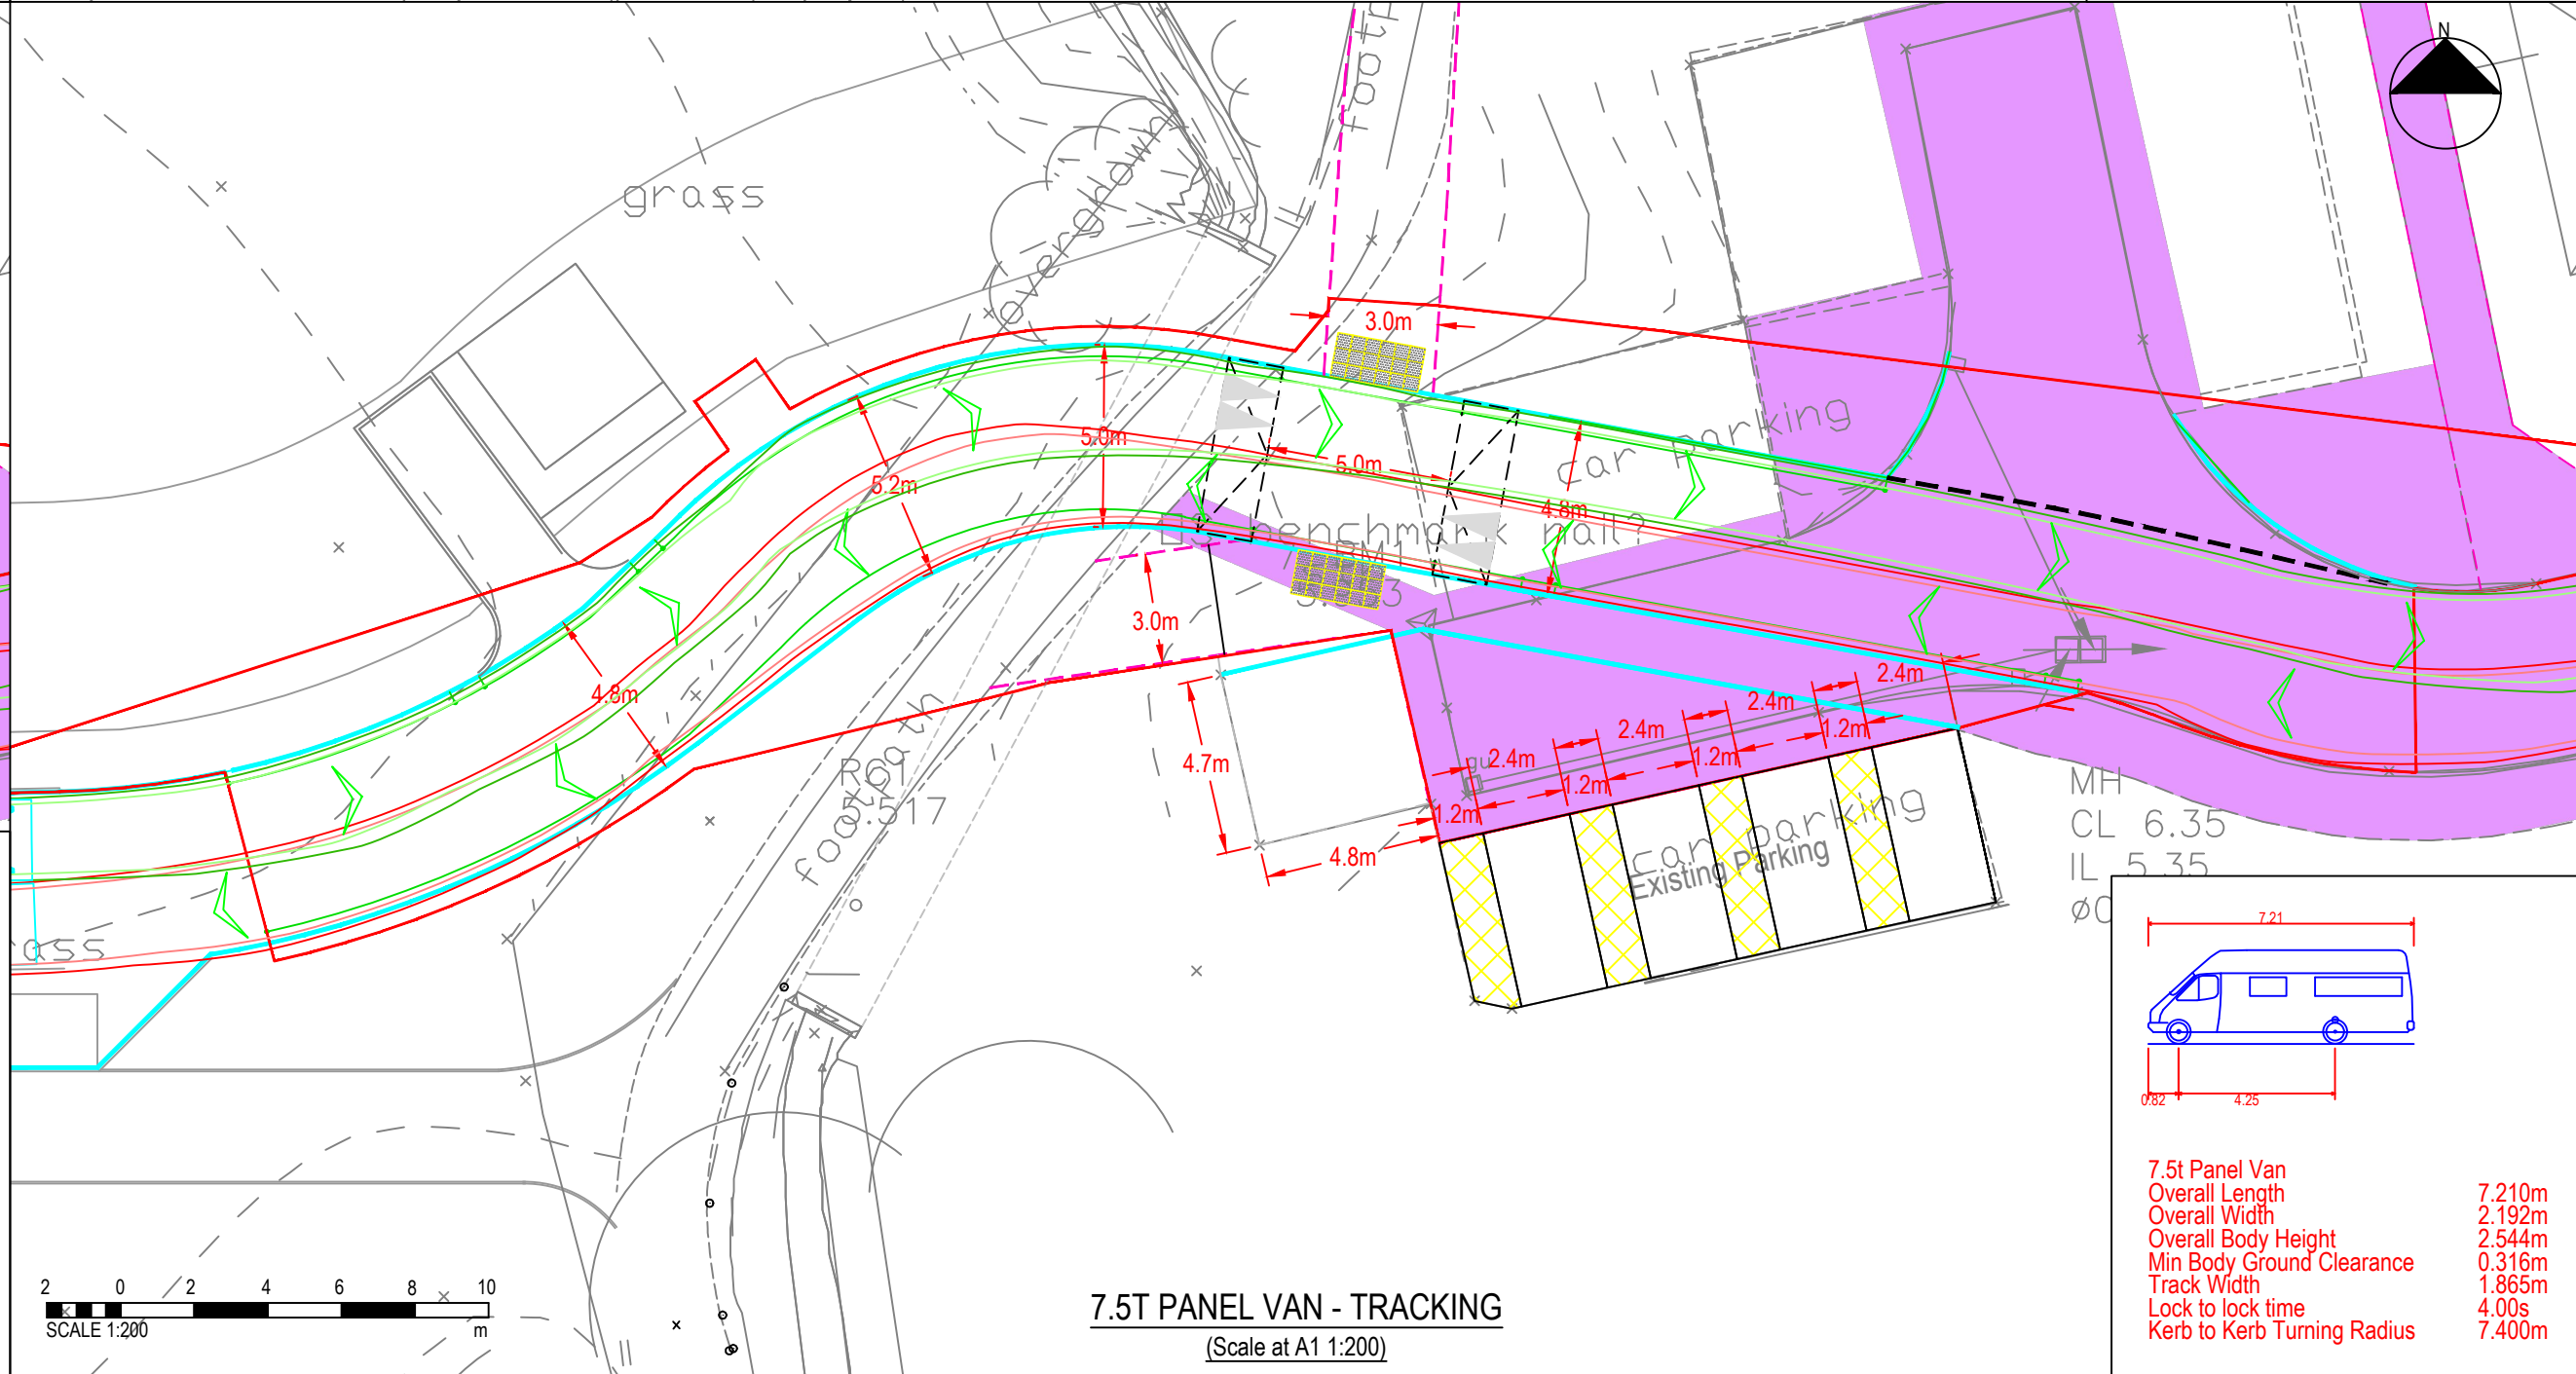

7.5T PANEL VAN - TRACKING
(Scale at A1 1:200)

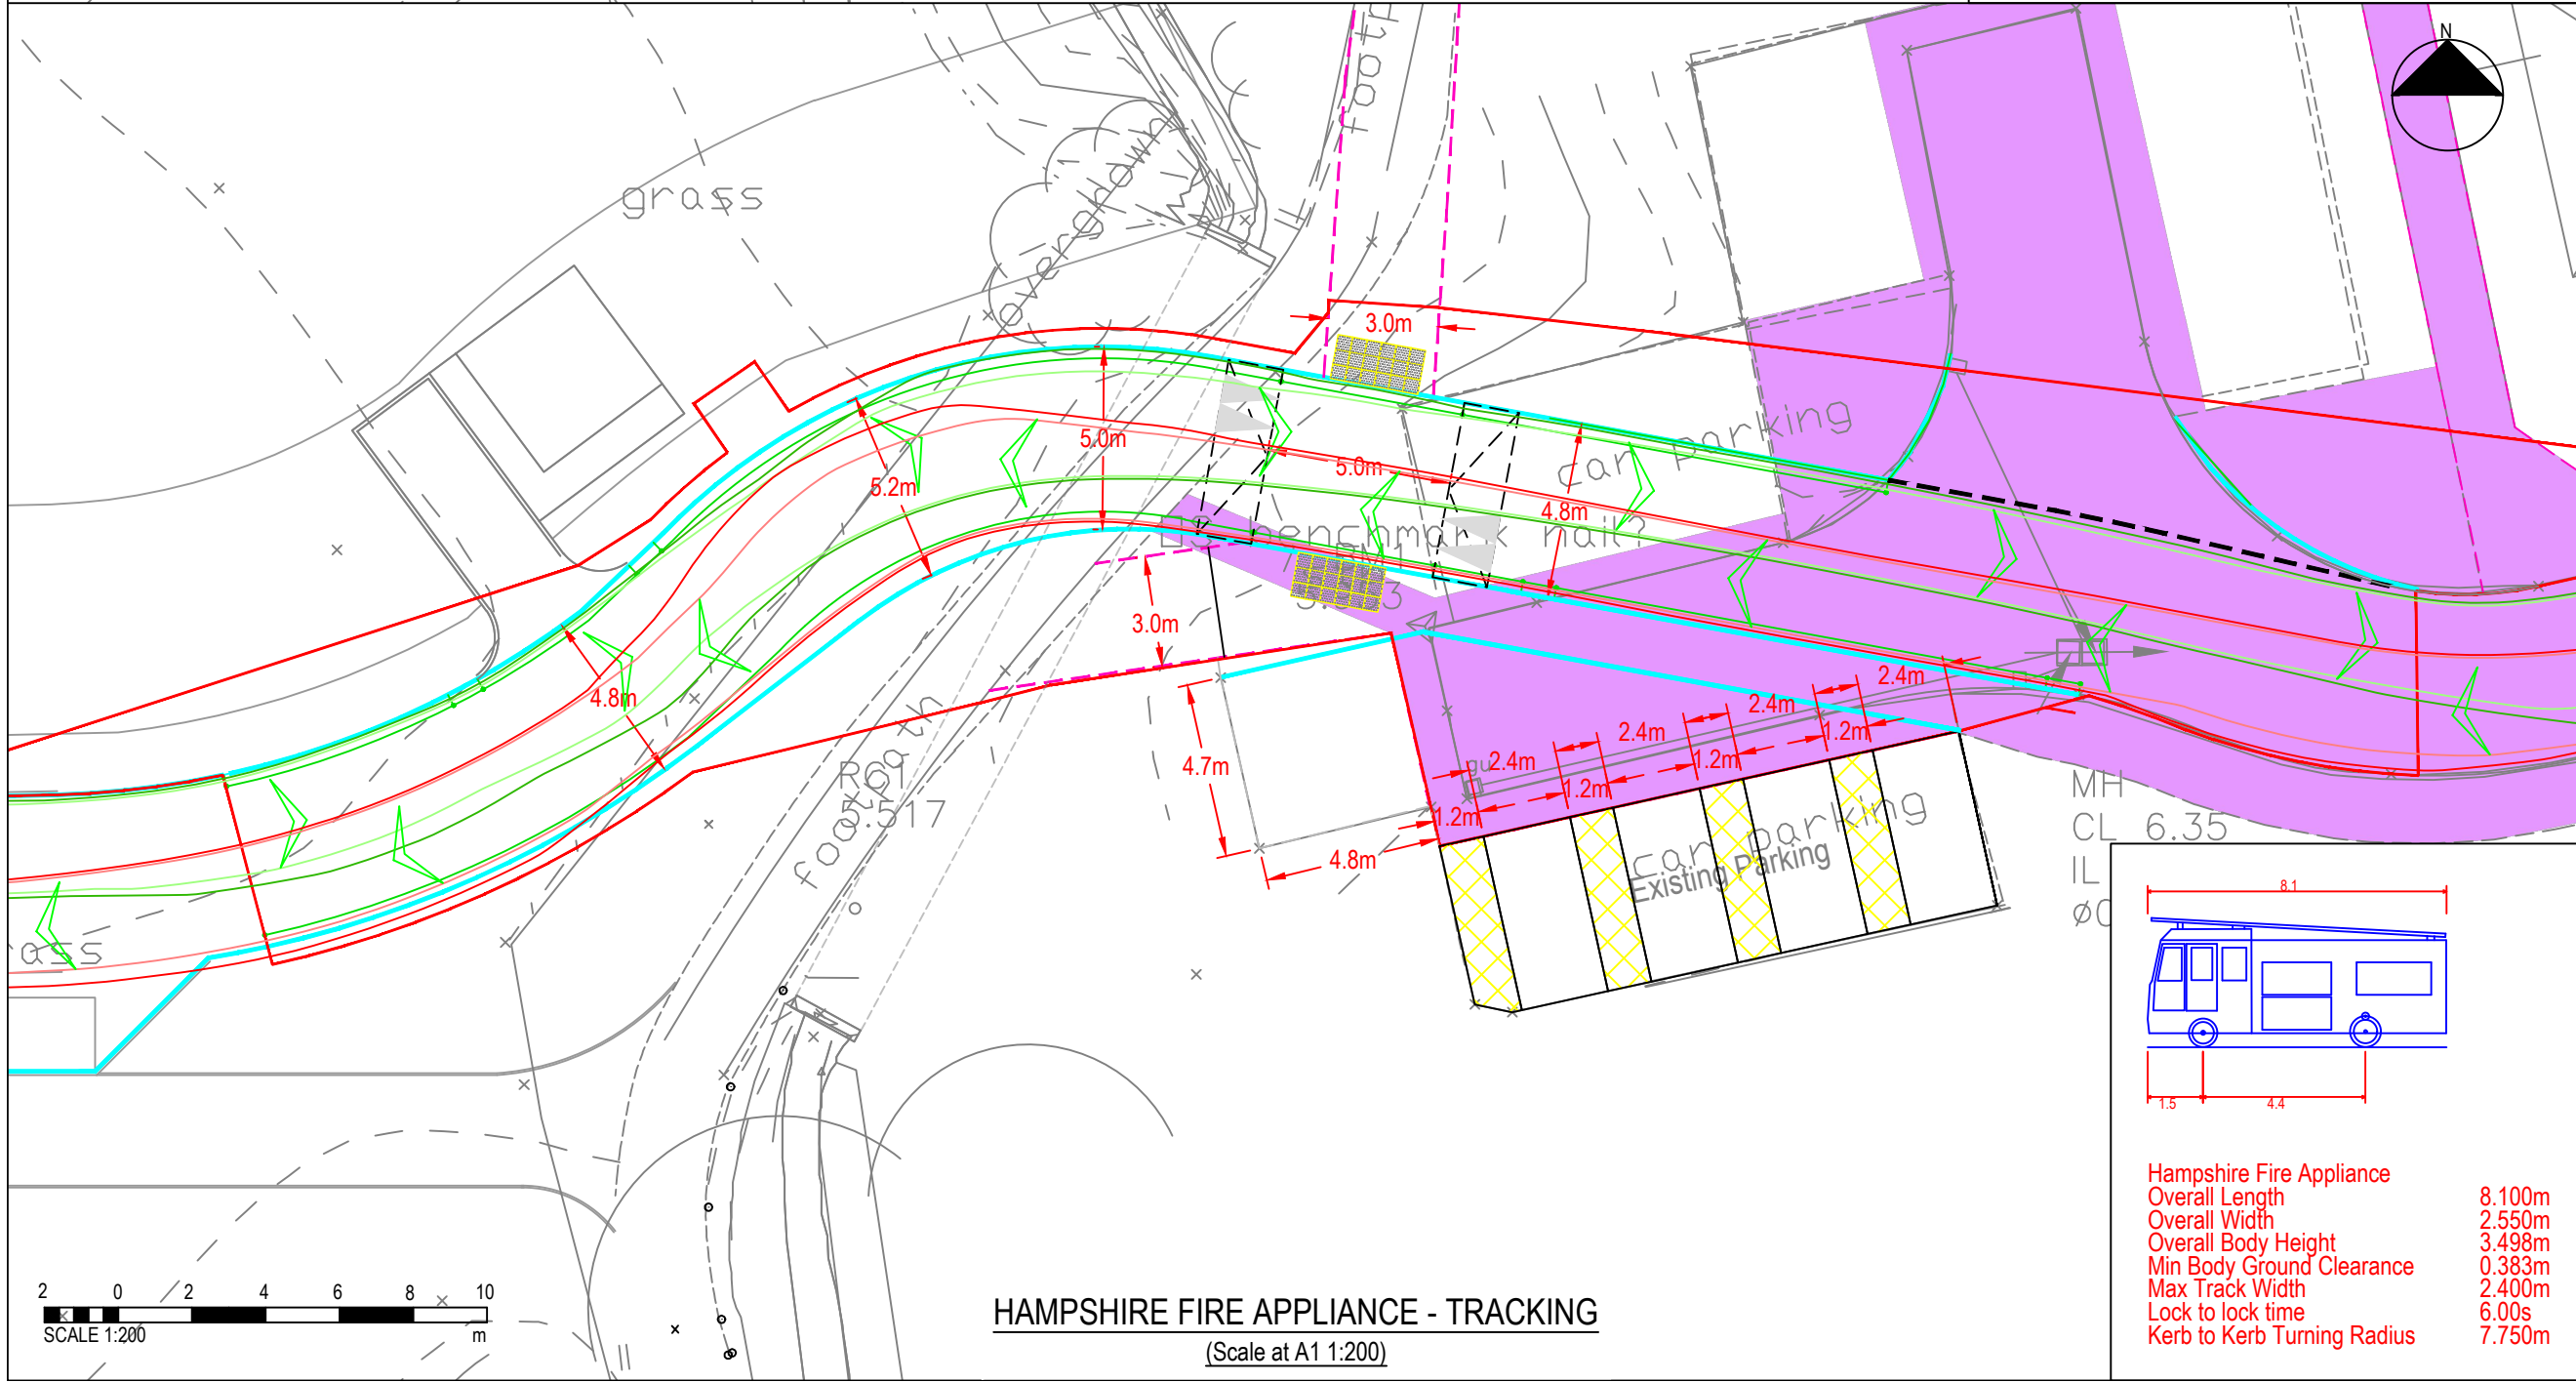


HAMPSHIRE FIRE APPLIANCE - TRACKING
(Scale at A1 1:200)

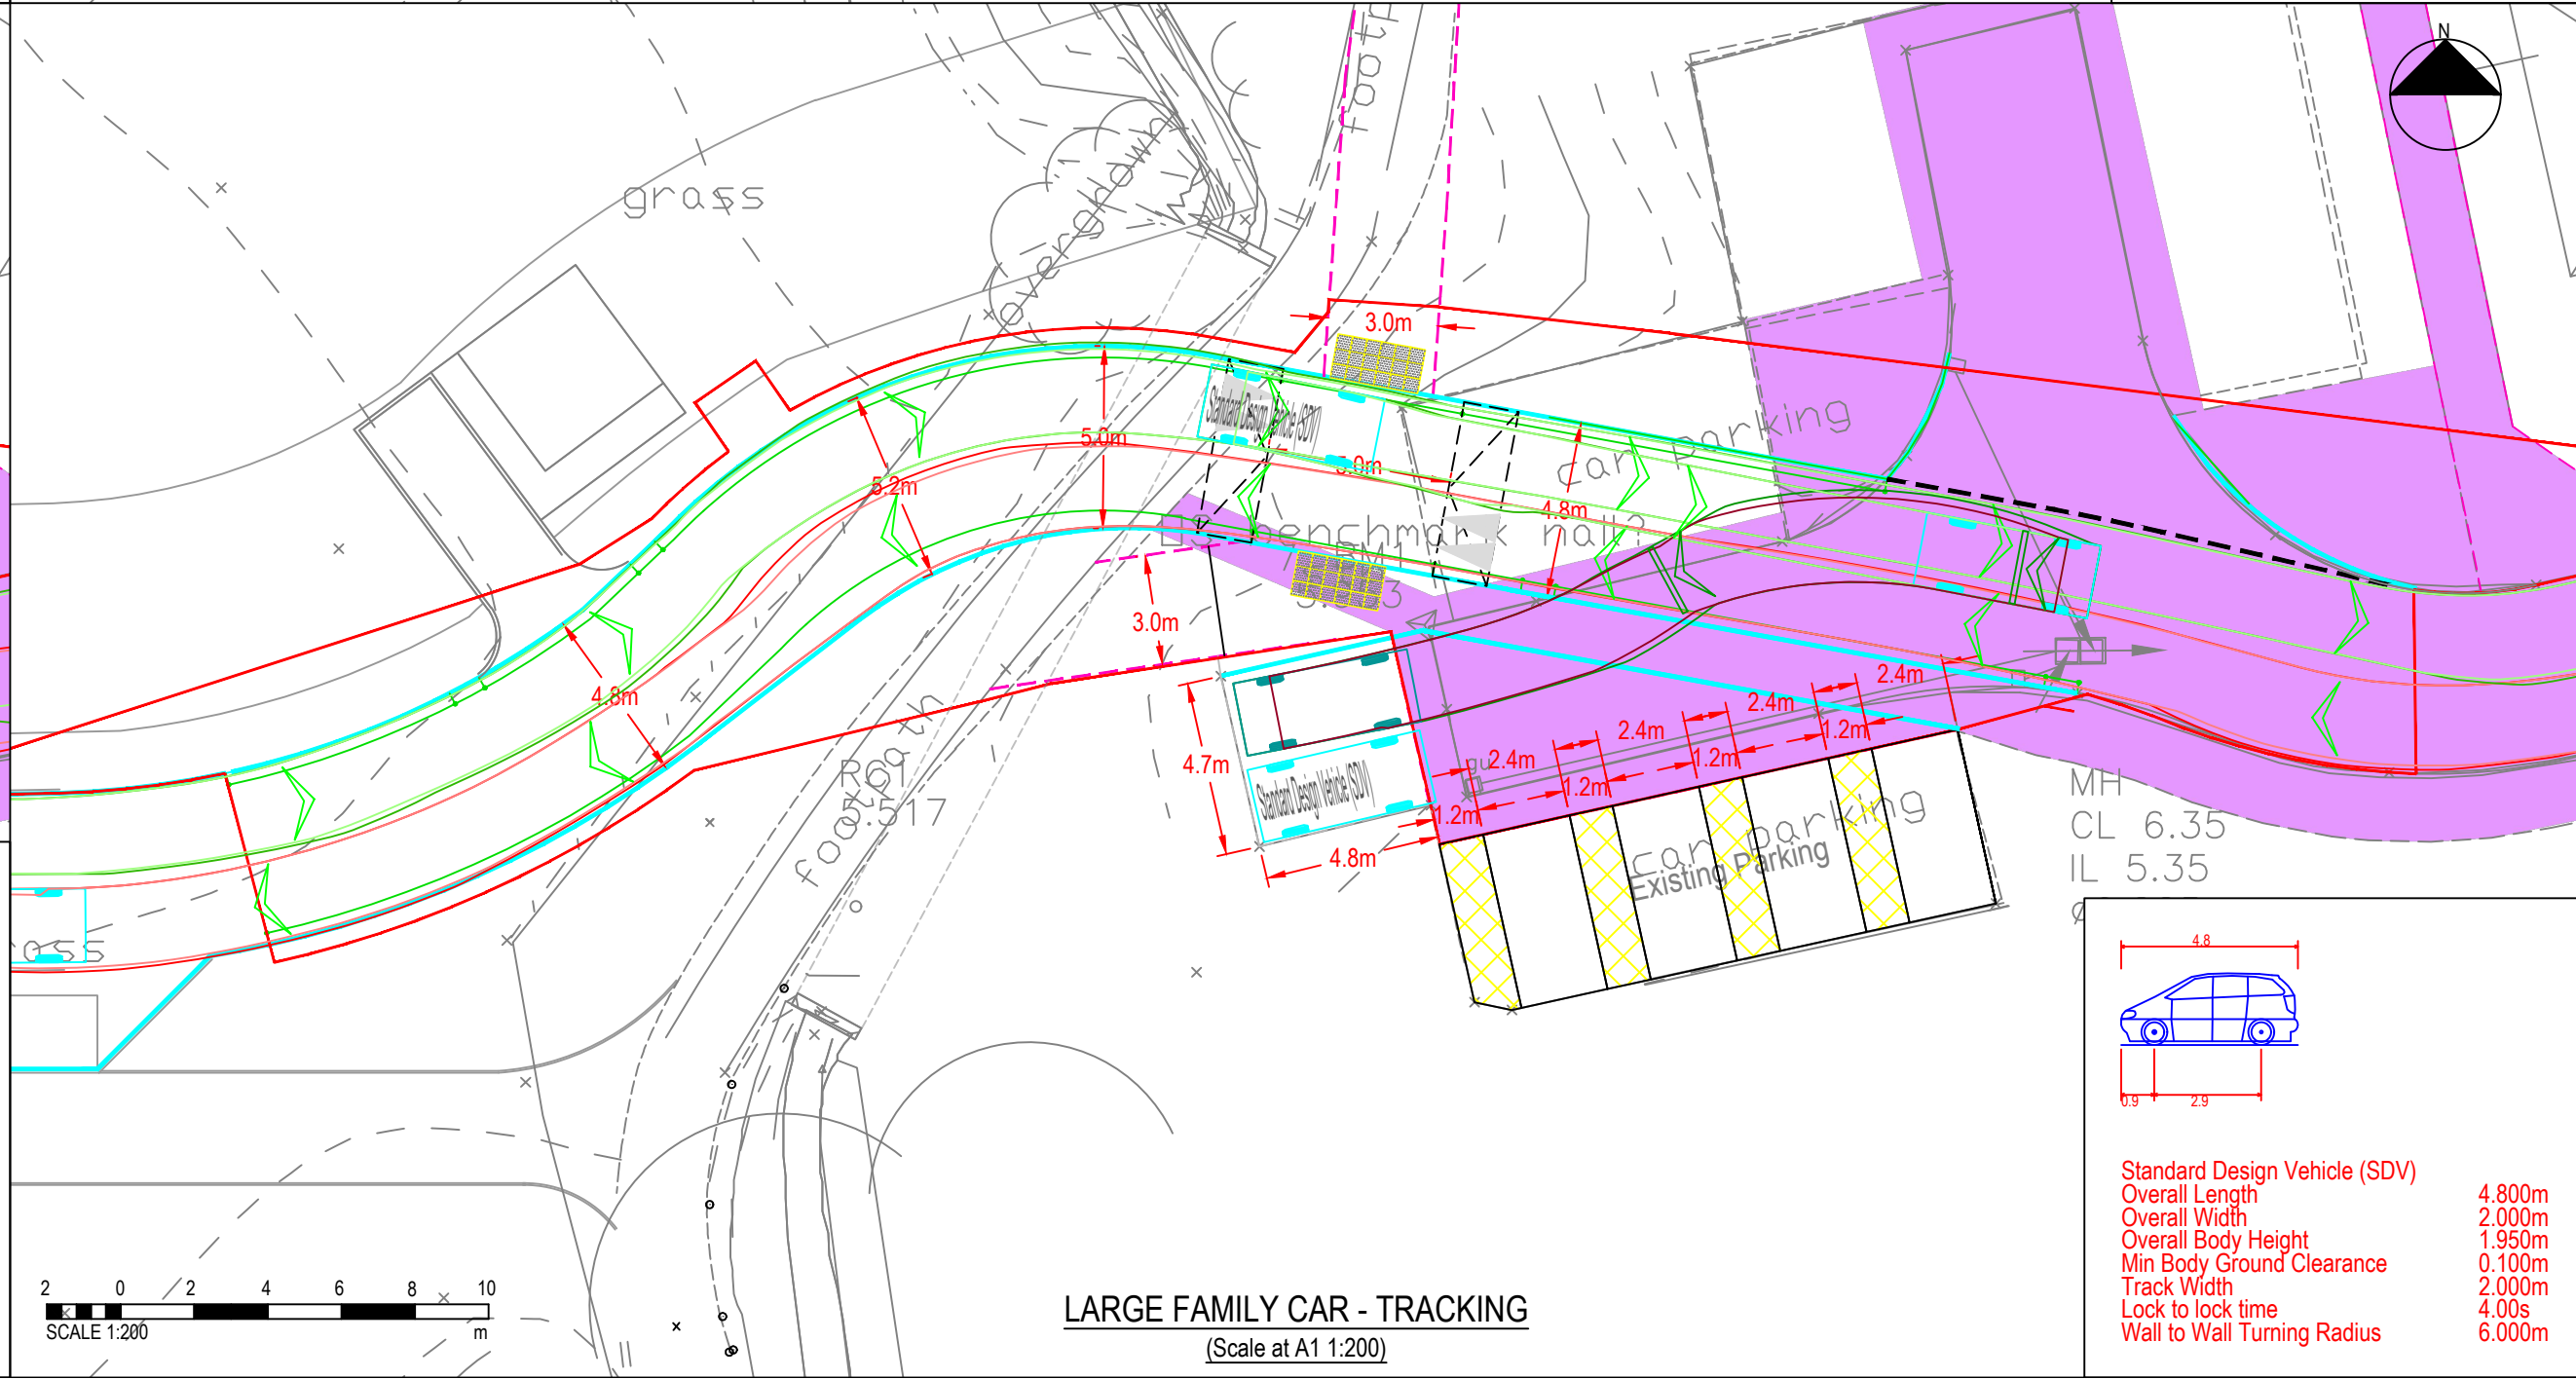

LARGE FAMILY CAR - TRACKING
(Scale at A1 1:200)

DISCLAIMER NOTES:

- THIS DOCUMENT IS COPYRIGHT OF THE ORIGINATOR AND MUST BE TREATED AS CONFIDENTIAL.
- THIS DOCUMENT MUST NOT BE ALTERED, REPRODUCED OR DISTRIBUTED WITHOUT PRIOR WRITTEN CONSENT OF THE ORIGINATOR.
- THIS DOCUMENT MUST NOT BE USED - THE ORIGINATOR ACCEPTS NO RESPONSIBILITY FOR ANY DISCREPANCIES ARISING AS A RESULT OF THE ORIGINATOR'S INFORMATION BEING ALTERED BY OTHERS.
- ANY DISCREPANCY MUST BE REPORTED TO THE ORIGINATOR.
- DO NOT SCALE THIS DOCUMENT - USE FIGURED DIMENSIONS ONLY.
- ALL DIMENSIONS MUST BE CHECKED ON SITE PRIOR TO COMMENCEMENT OF ANY RELATED WORKS.
- THIS DOCUMENT MUST BE READ IN CONJUNCTION WITH ALL SUPPORTING DOCUMENTS PRODUCED BY THE ORIGINATOR AND OTHER PROJECT DISCIPLINES.
- THE ORIGINATOR ACCEPTS NO RESPONSIBILITY FOR THE ACCURACY OF BACKGROUND INFORMATION PRODUCED BY THIRD PARTIES - THIS MUST BE TREATED AS INDICATIVE ONLY.
- USERS OF THIS DOCUMENT ARE RESPONSIBLE FOR CHECKING WHICH REVISION IS CURRENT.
- THE DOCUMENT STATUS "INFORMATION" OR "PRELIMINARY" INDICATES THAT THIS DRAWING IS FOR REFERENCE PURPOSES ONLY - THE ORIGINATOR WILL ACCEPT NO RESPONSIBILITY FOR THE COMPLETENESS OF INFORMATION UNDER THIS STATUS.
- THE DOCUMENT STATUS "RECORD" OR "AS BUILT" HAS BEEN PREPARED, IN PART, BASED UPON INFORMATION FURNISHED BY OTHERS. WHILE THIS INFORMATION IS BELIEVED TO BE RELIABLE, THE ORIGINATOR ASSUMES NO RESPONSIBILITY FOR THE ACCURACY OF THIS "RECORD" OR "AS BUILT" DOCUMENT OR FOR ANY ERRORS OR OMISSIONS THAT MAY HAVE BEEN INCORPORATED INTO IT AS A RESULT OF INCORRECT INFORMATION PROVIDED TO THE ORIGINATOR. THOSE RELYING ON THE "RECORD" OR "AS BUILT" DOCUMENT ARE ADVISED TO OBTAIN INDEPENDENT VERIFICATION OF ITS ACCURACY.

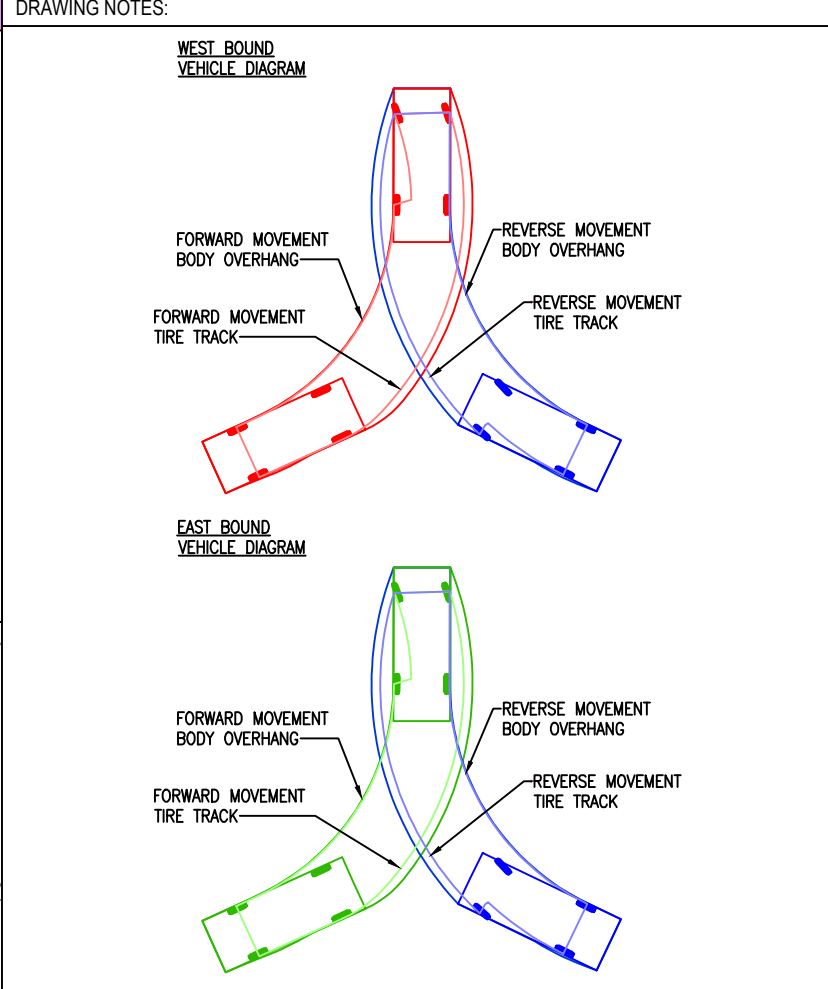

NOTE:
Vehicles have been tracked at 10mph in line with HCC TG2

C4	[Red line boundary amended & 10mph note added]	08.05.26	JF	TC
C3	Latest layout updated	07.05.26	JF	TC
C2	Updated layout to suit tracking	19.03.26	PJ	TC
C1	Updated to Ridge border	02.01.26	PJ	PB
P1	Preliminary issue	03.11.23	AK	RL
REV	DESCRIPTION	DATE	BY	CHKD
ORIGINATOR: www.ridge.co.uk				

RIDGE

PROJECT NUMBER: 23339

CLIENT: DOSWELL PROJECT

IN ASSOCIATION WITH:









PROJECT: COLDHARBOUR FARM ROAD EMSWORTH

TITLE: S278 TRACKING

DRAWN BY:	AK	CHECKED BY:		APPROVED BY:	
SCALE:	AS SHOWN @ A1	DATE:	03.11.2023		
STATUS:	DESCRIPTION:				


DRAWING No: JUBB_XX_XX_DR_C_1200

PROJECT:	ORG:	FUNCTION:	SPATIAL:	FORM:	DISCIPLINE:	NUMBER:	REV:
23339	JUBB	XX	XX	DR	X	001200	C4

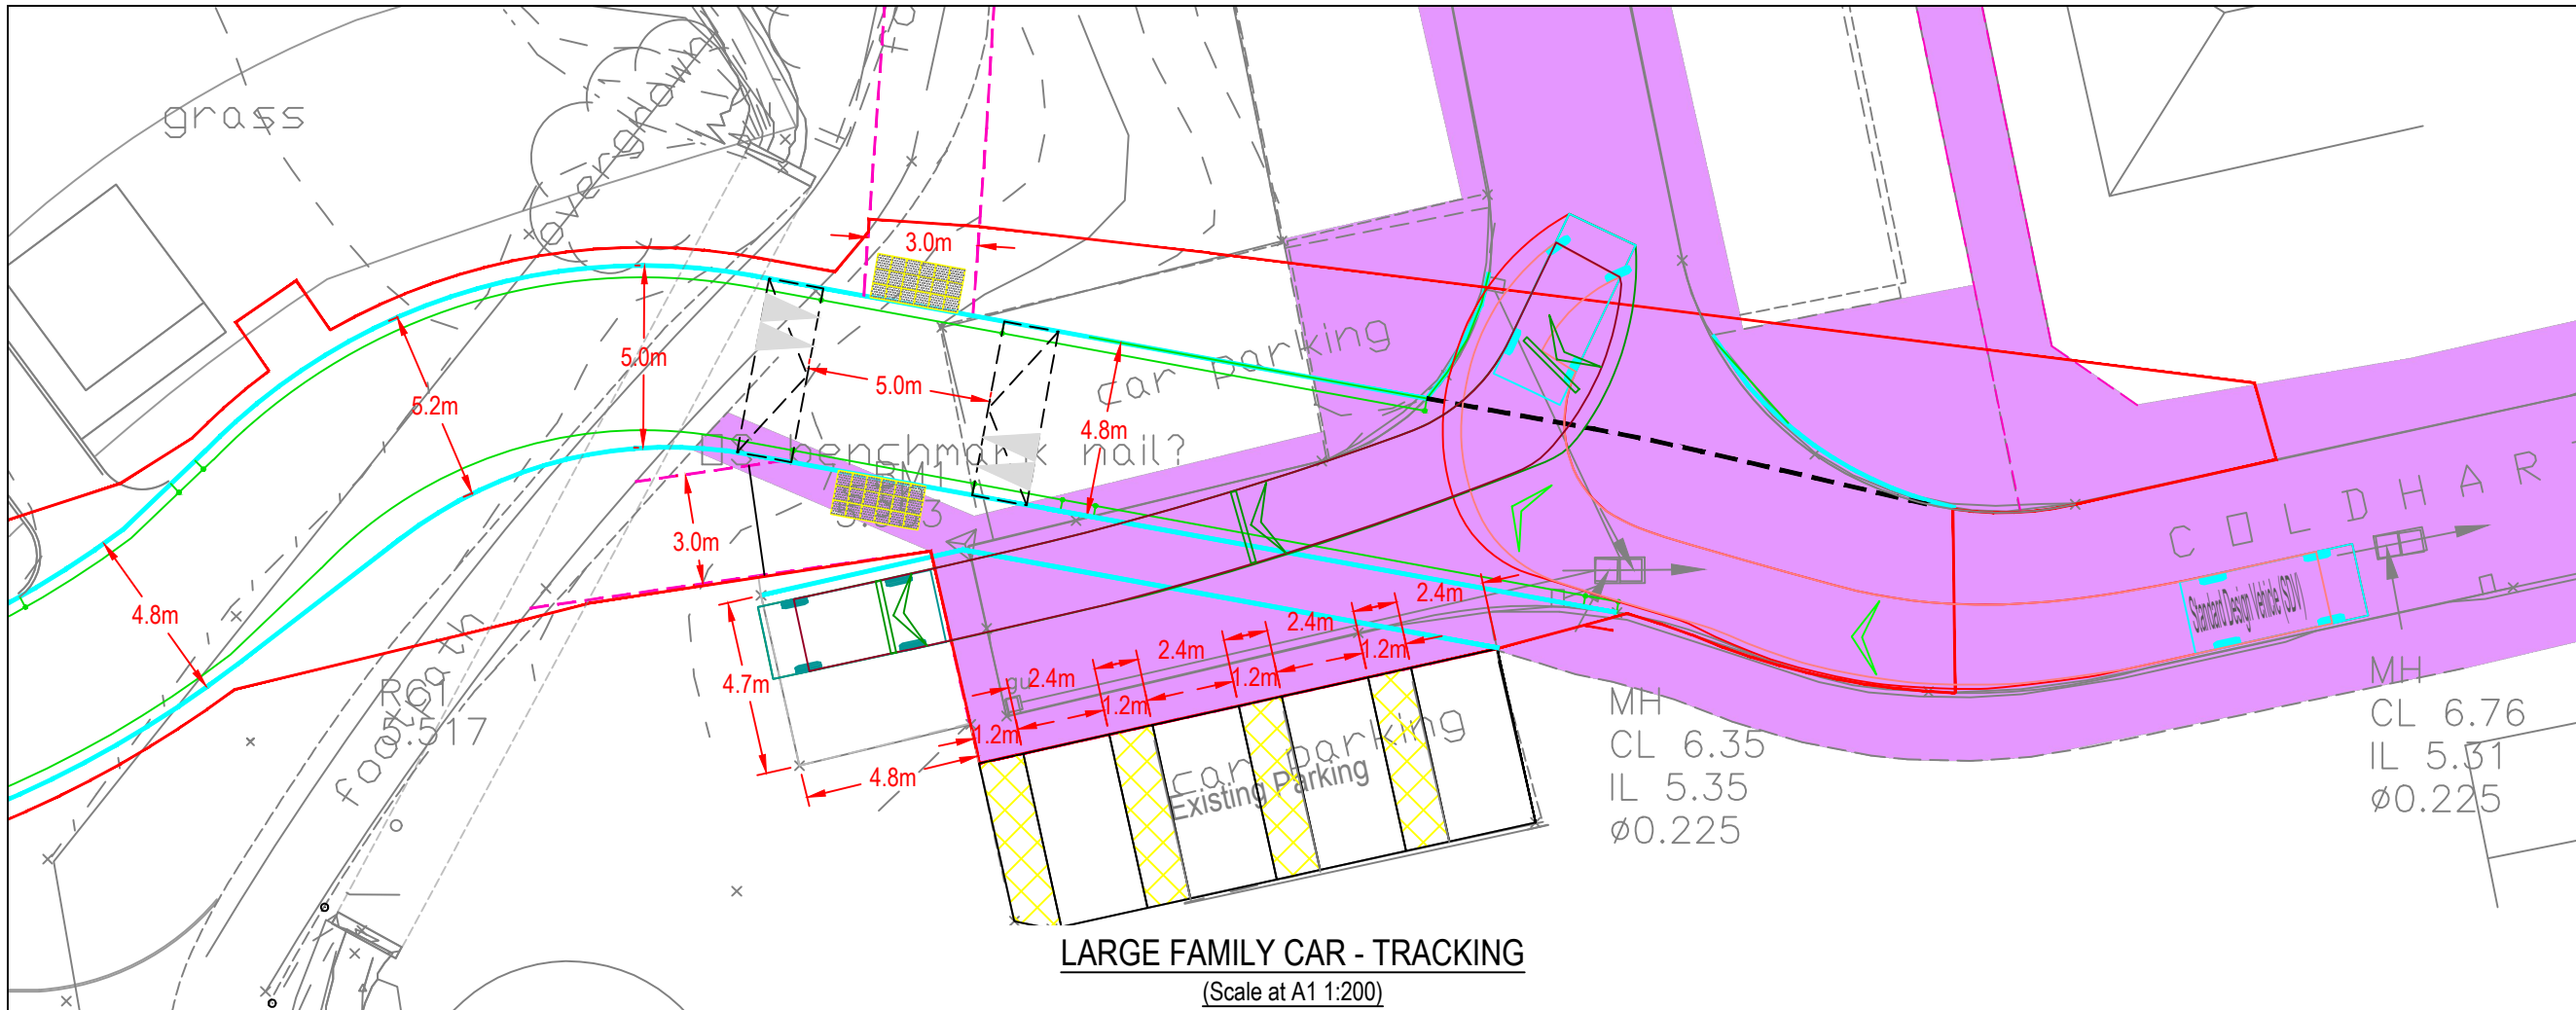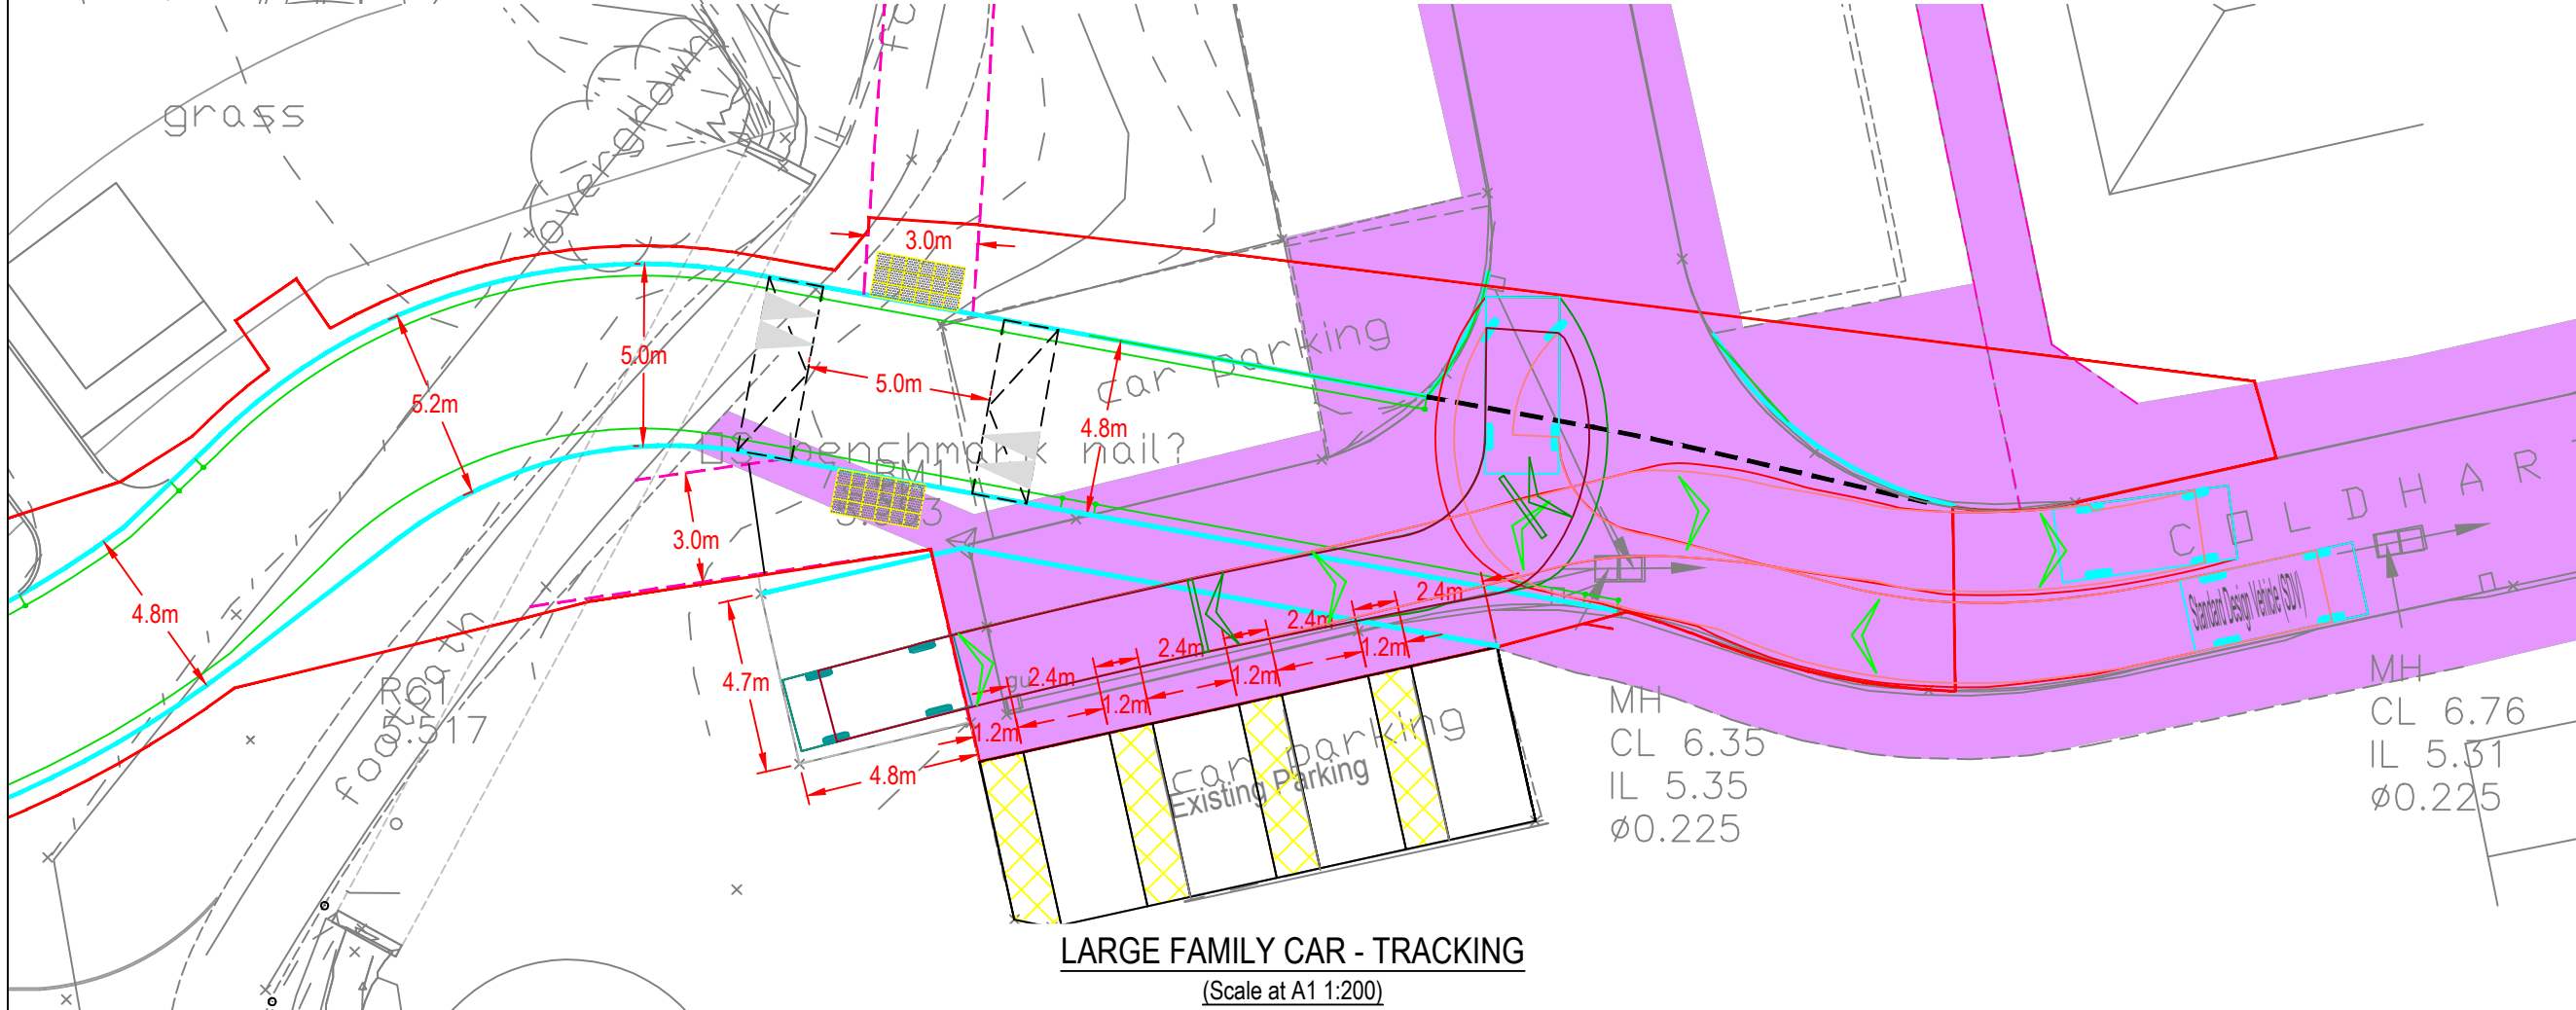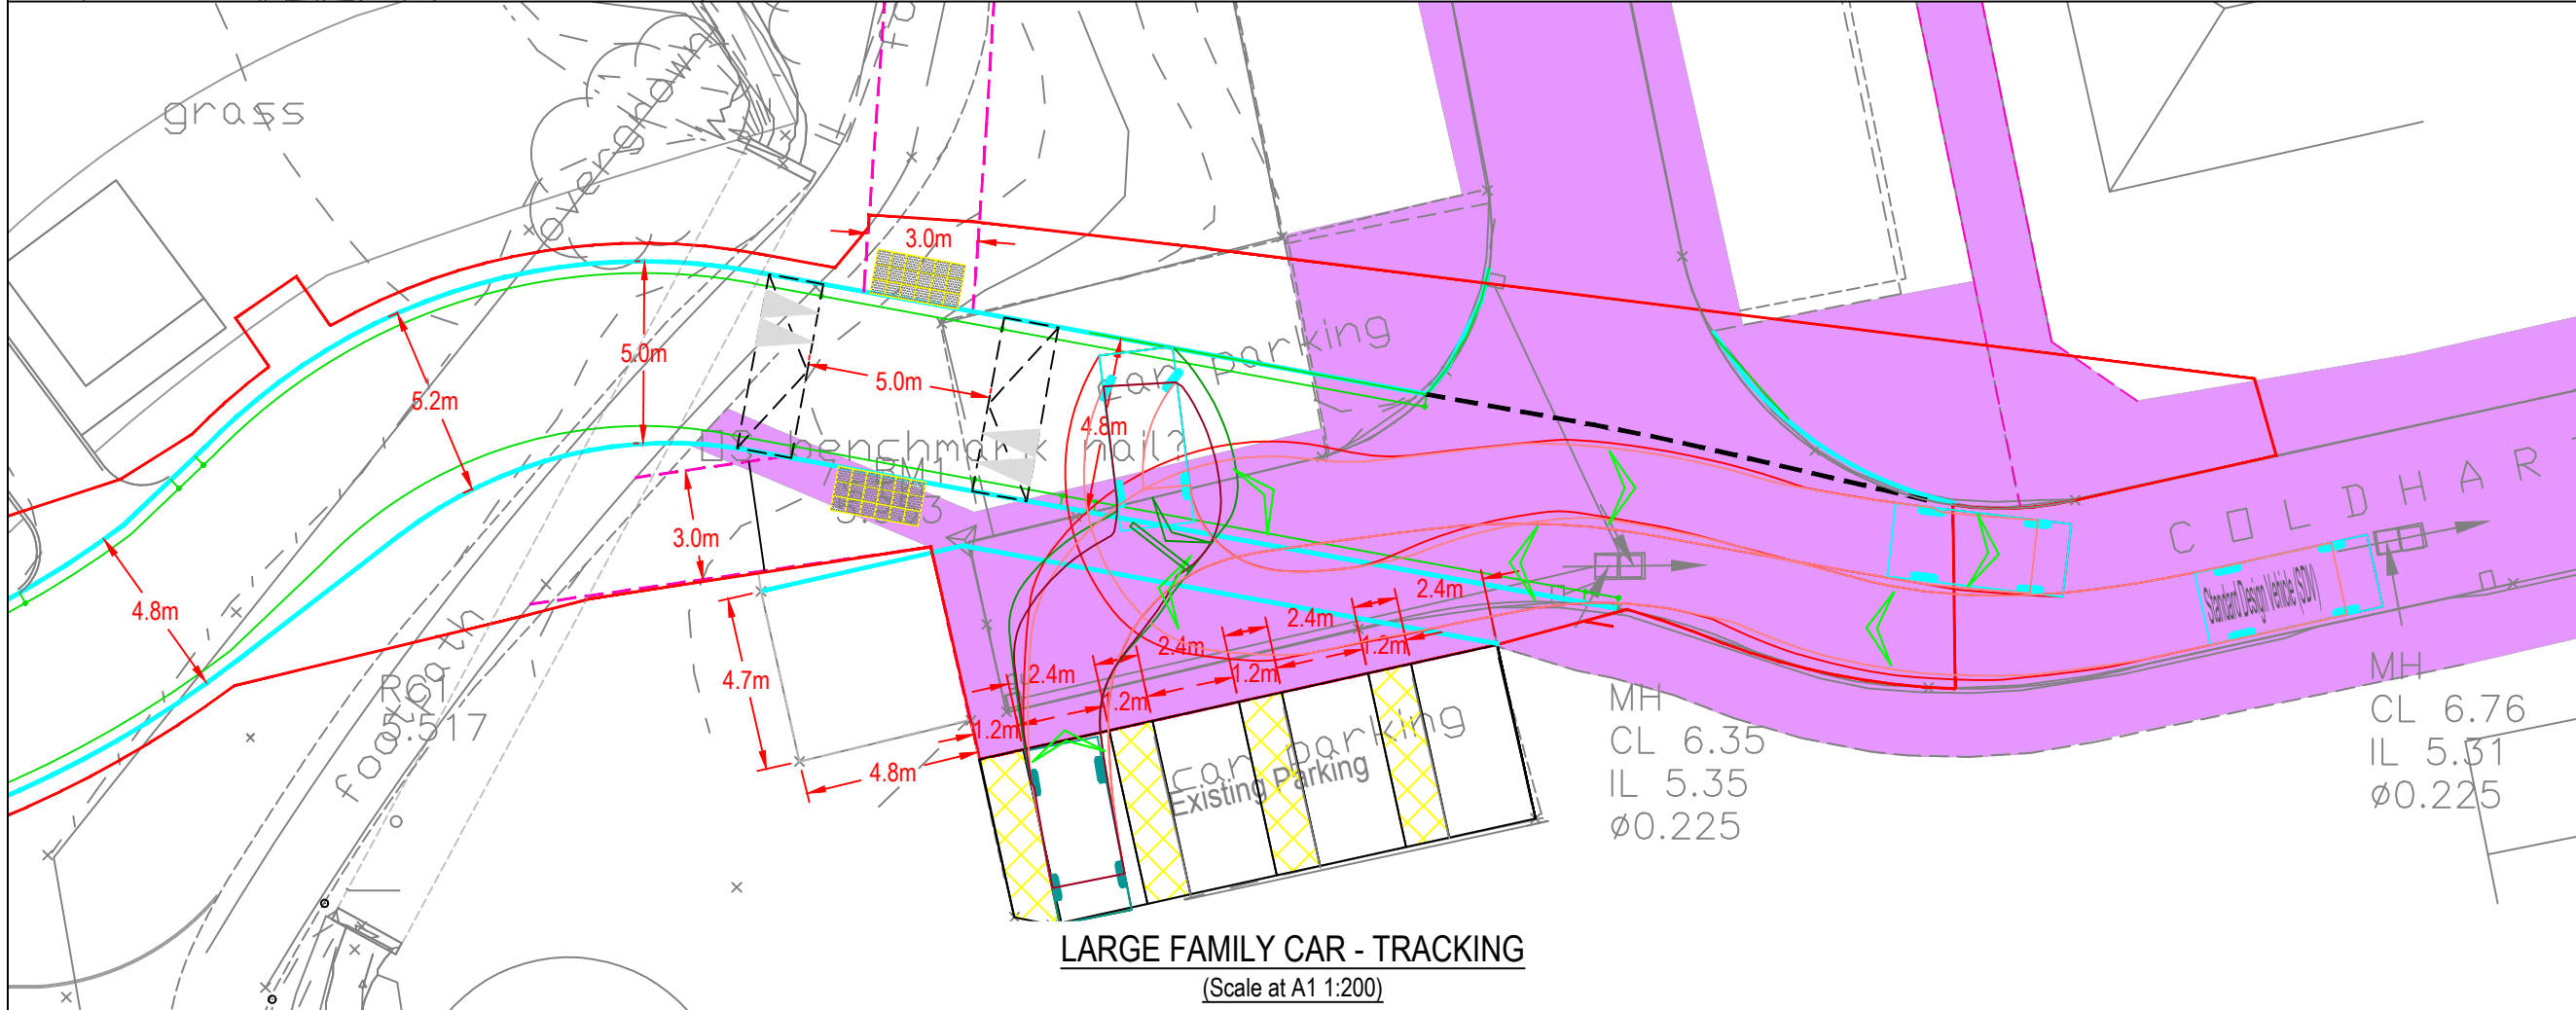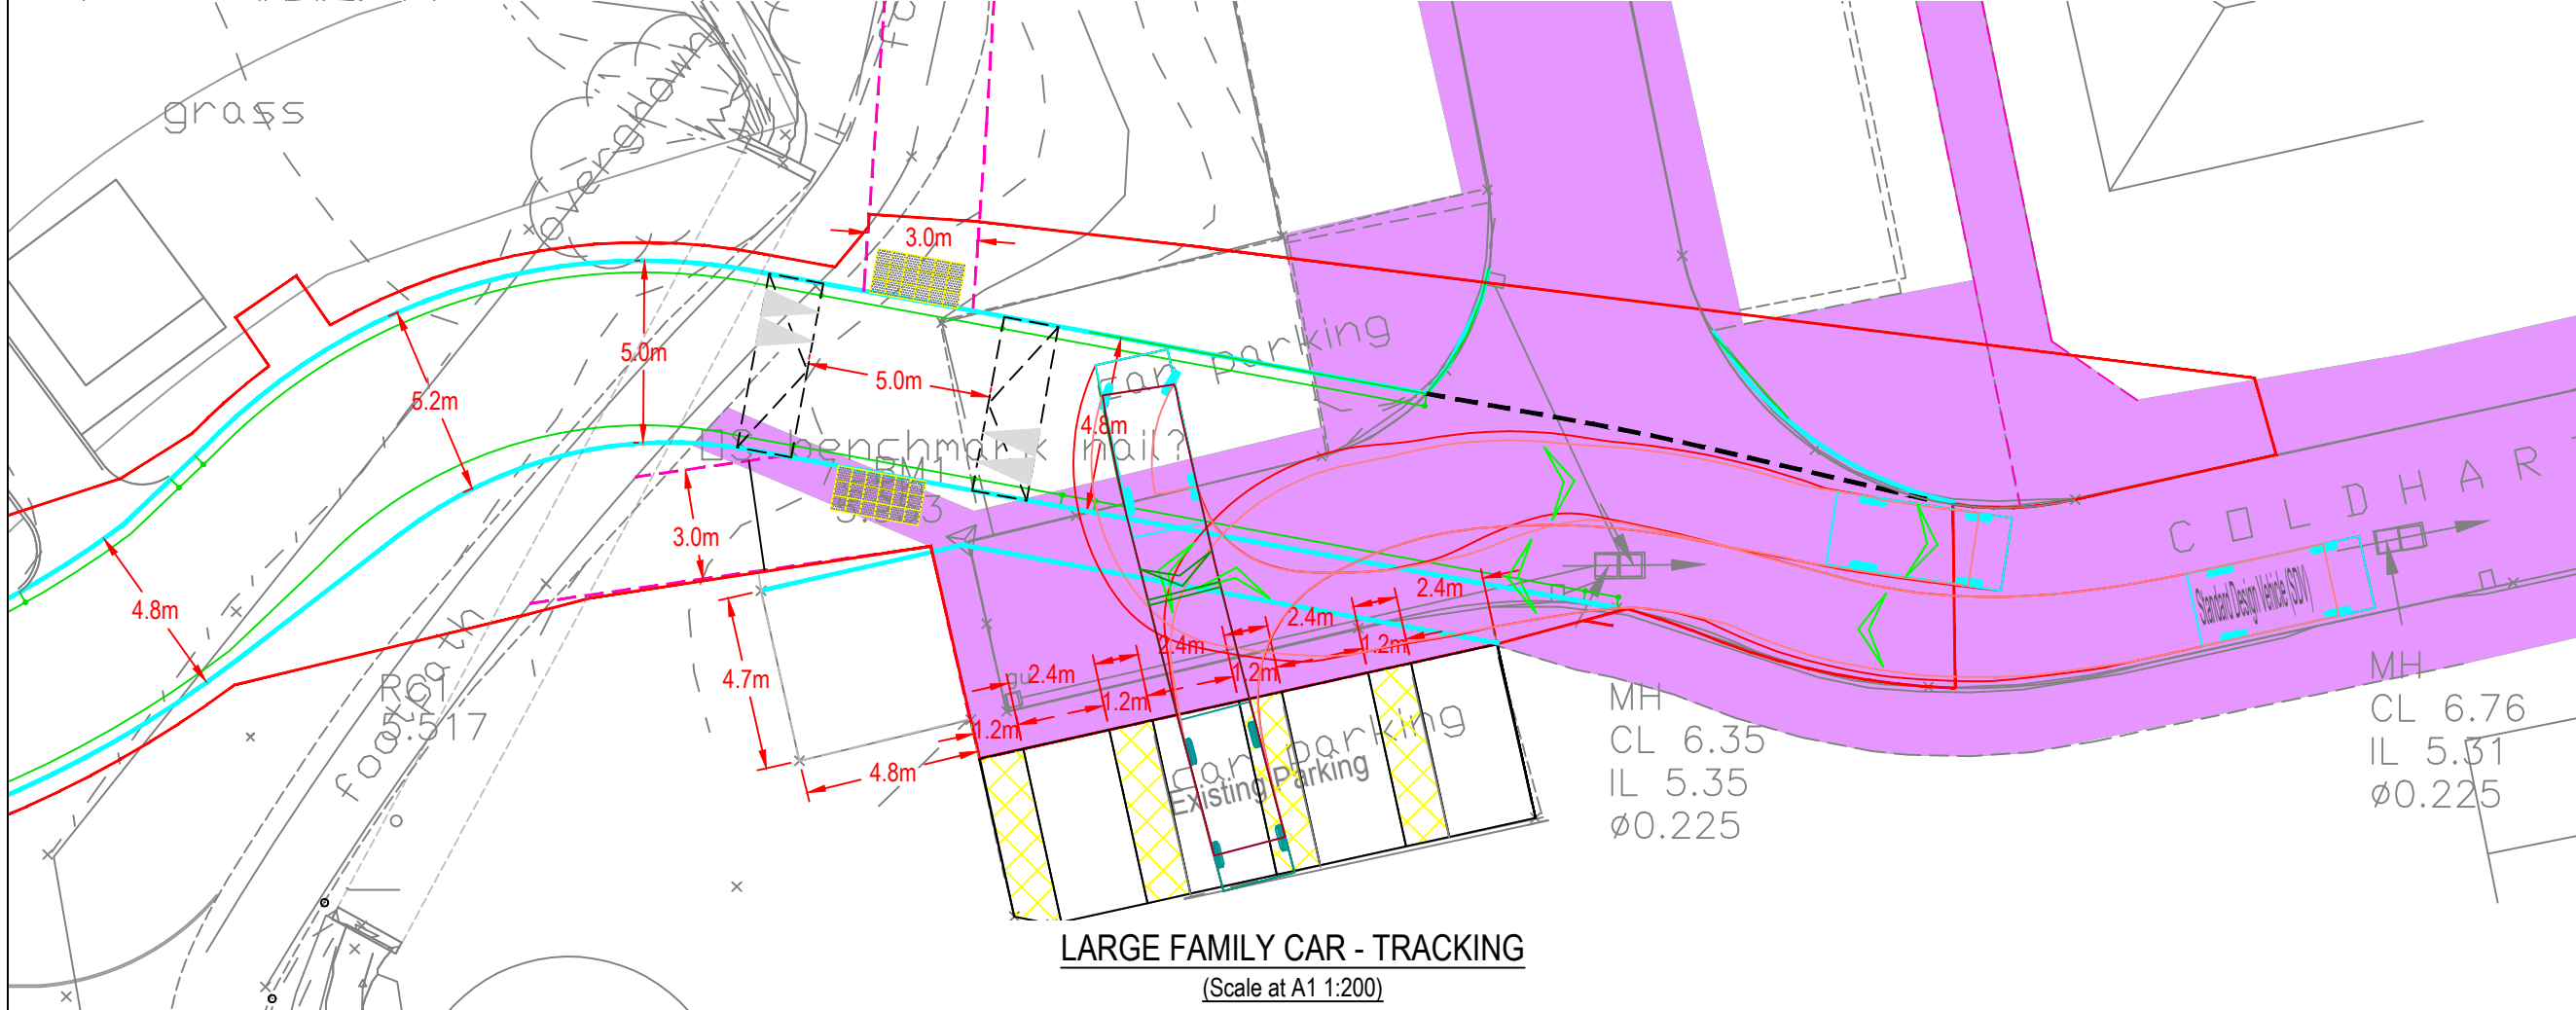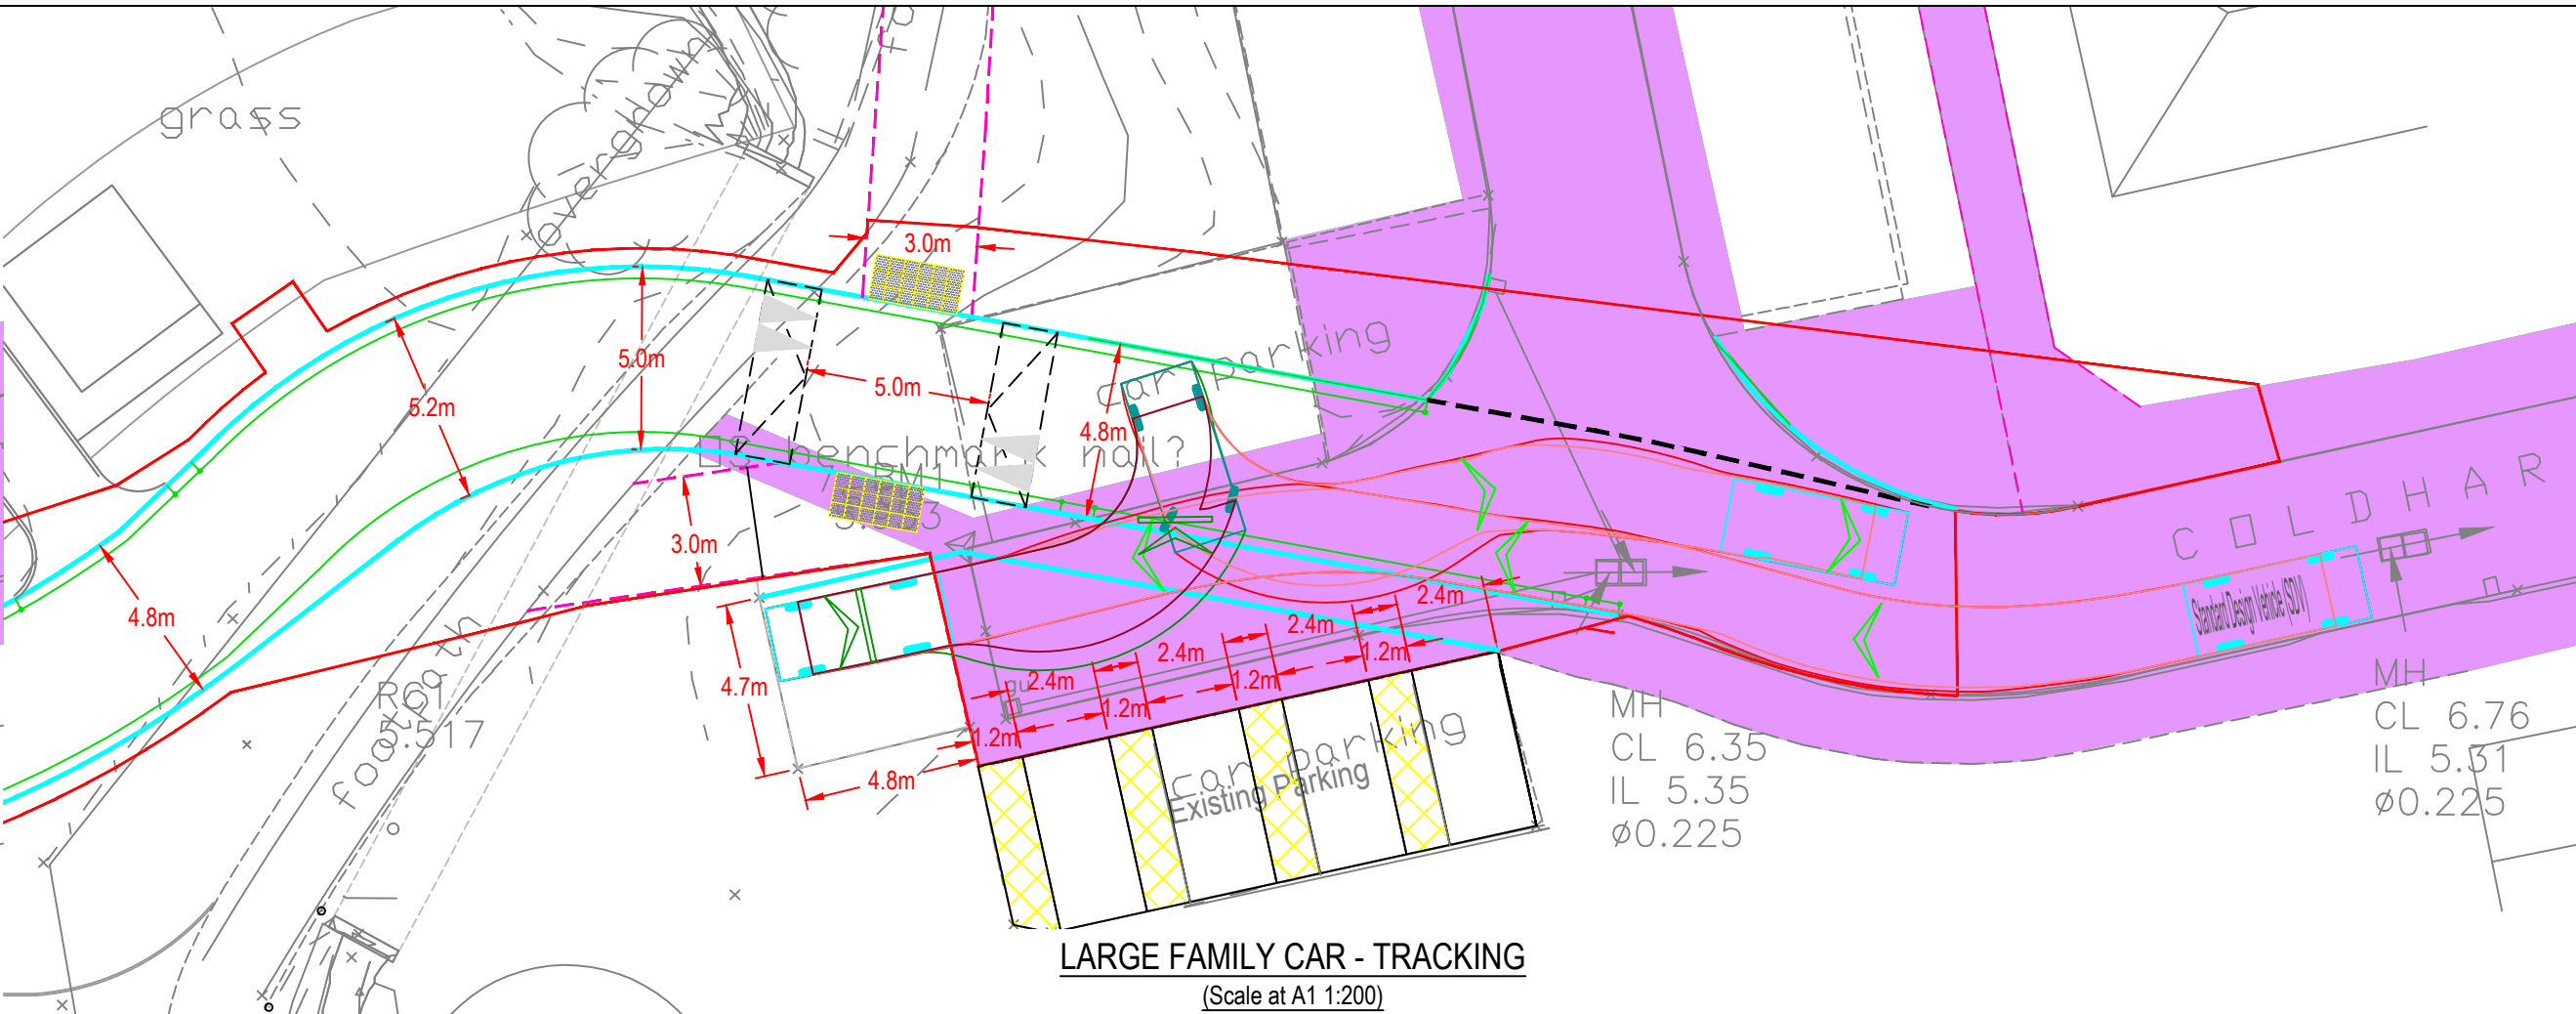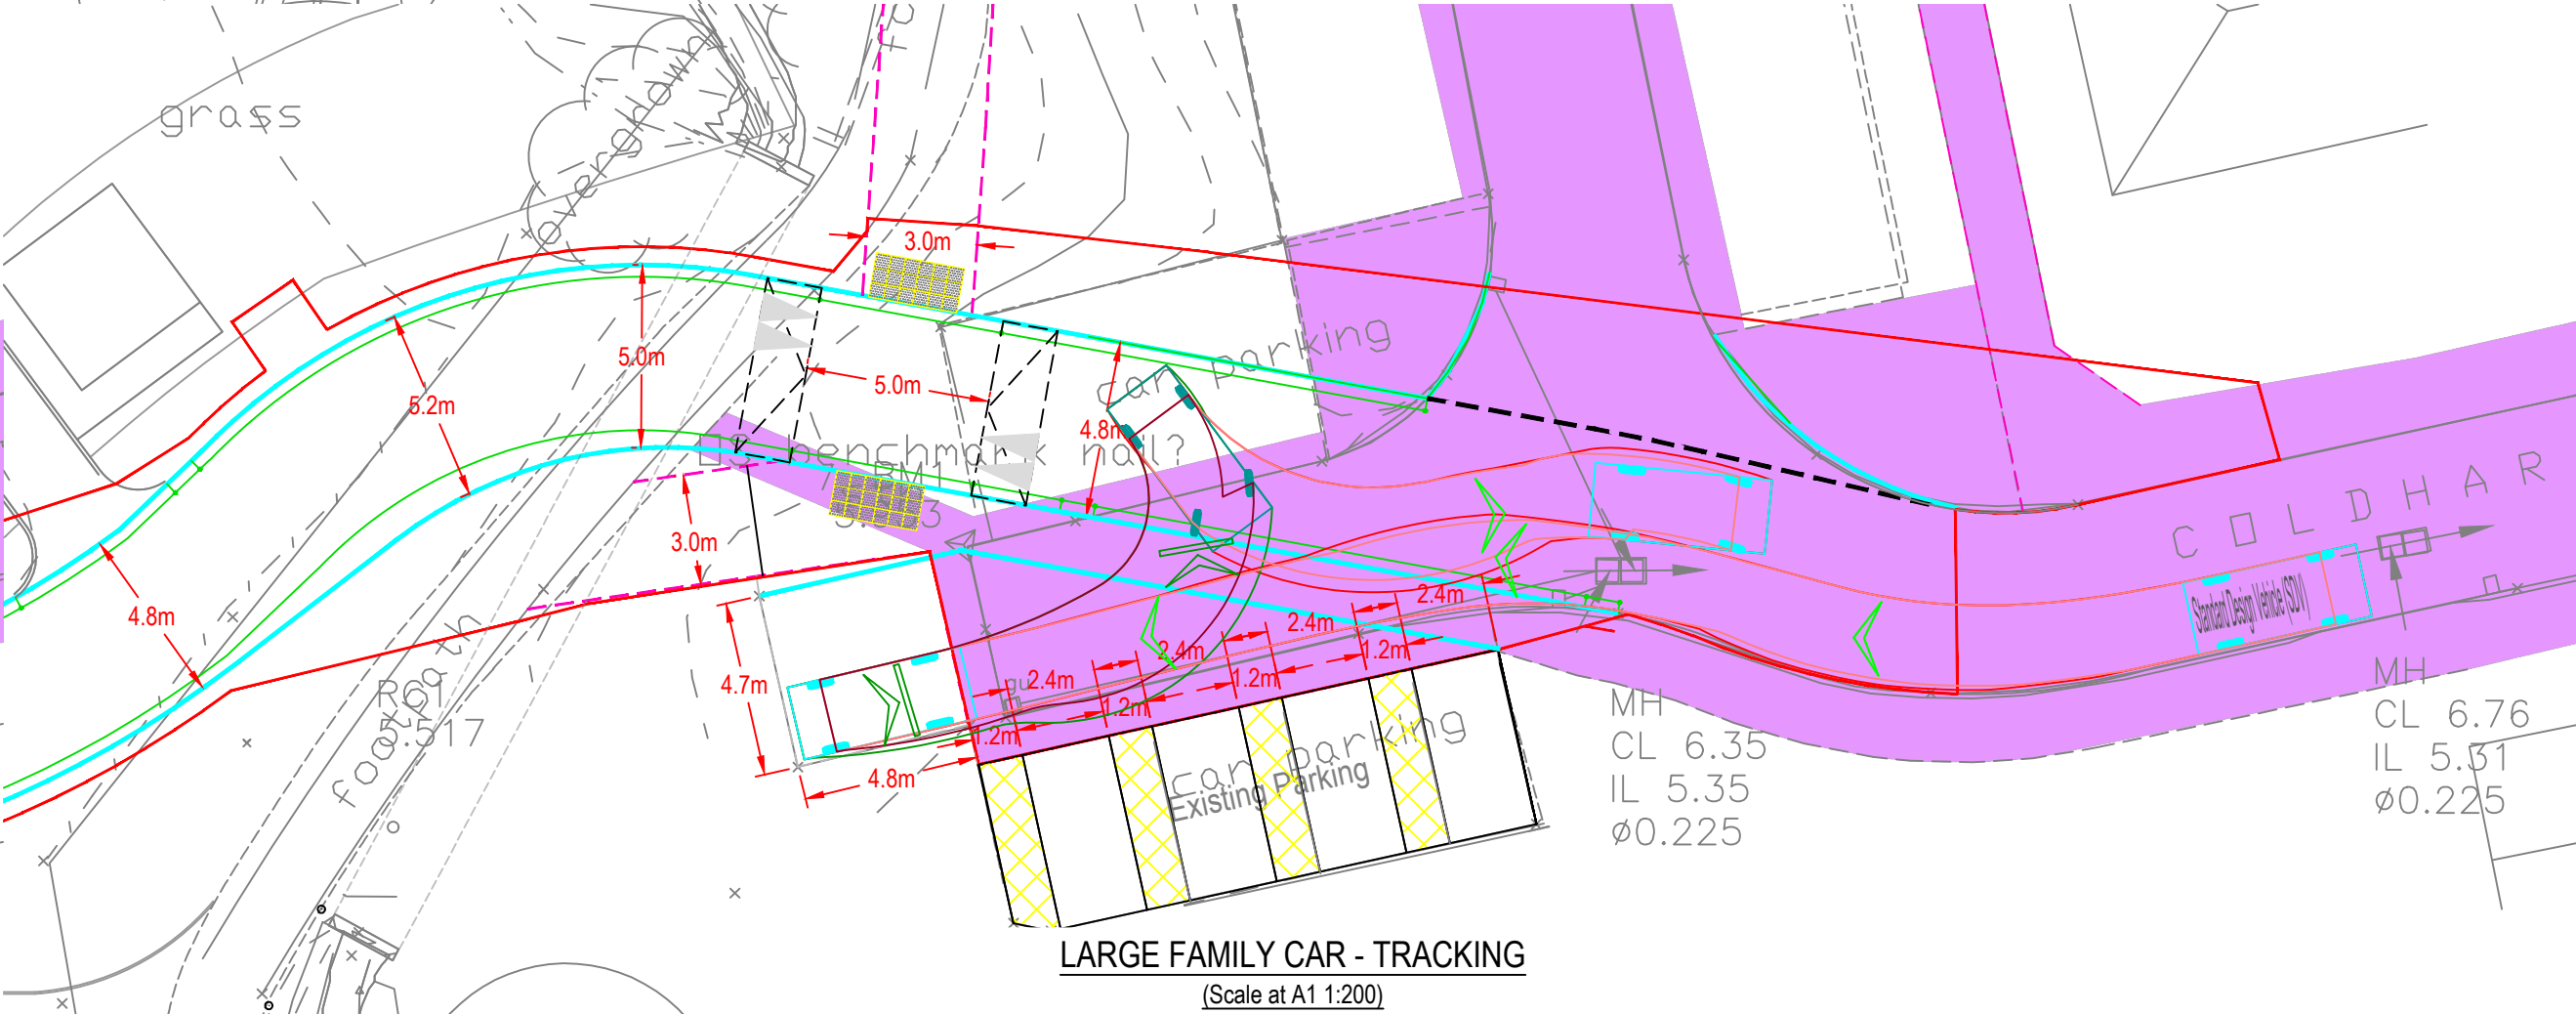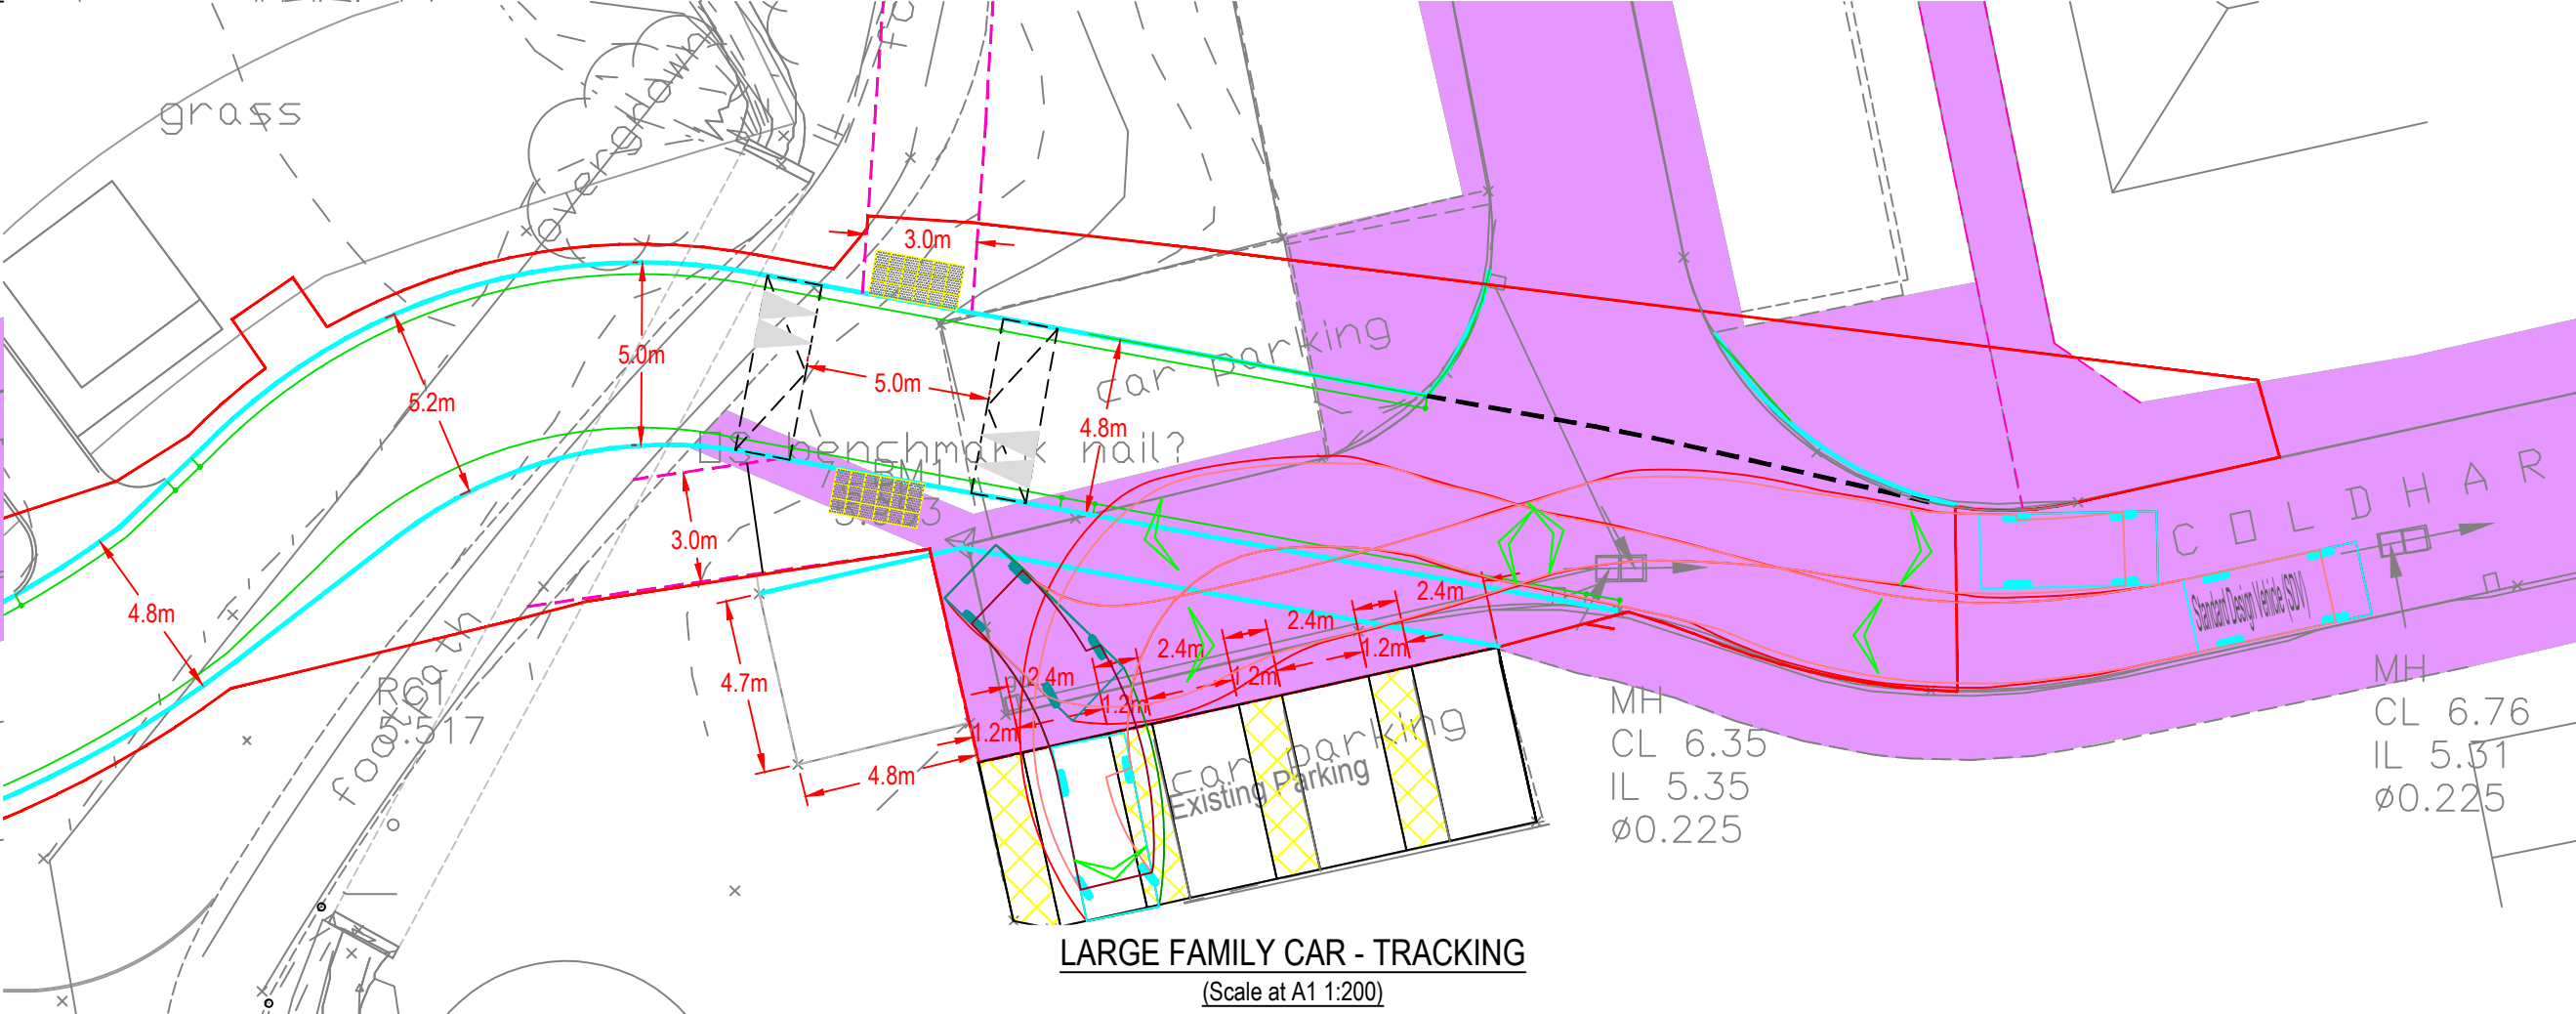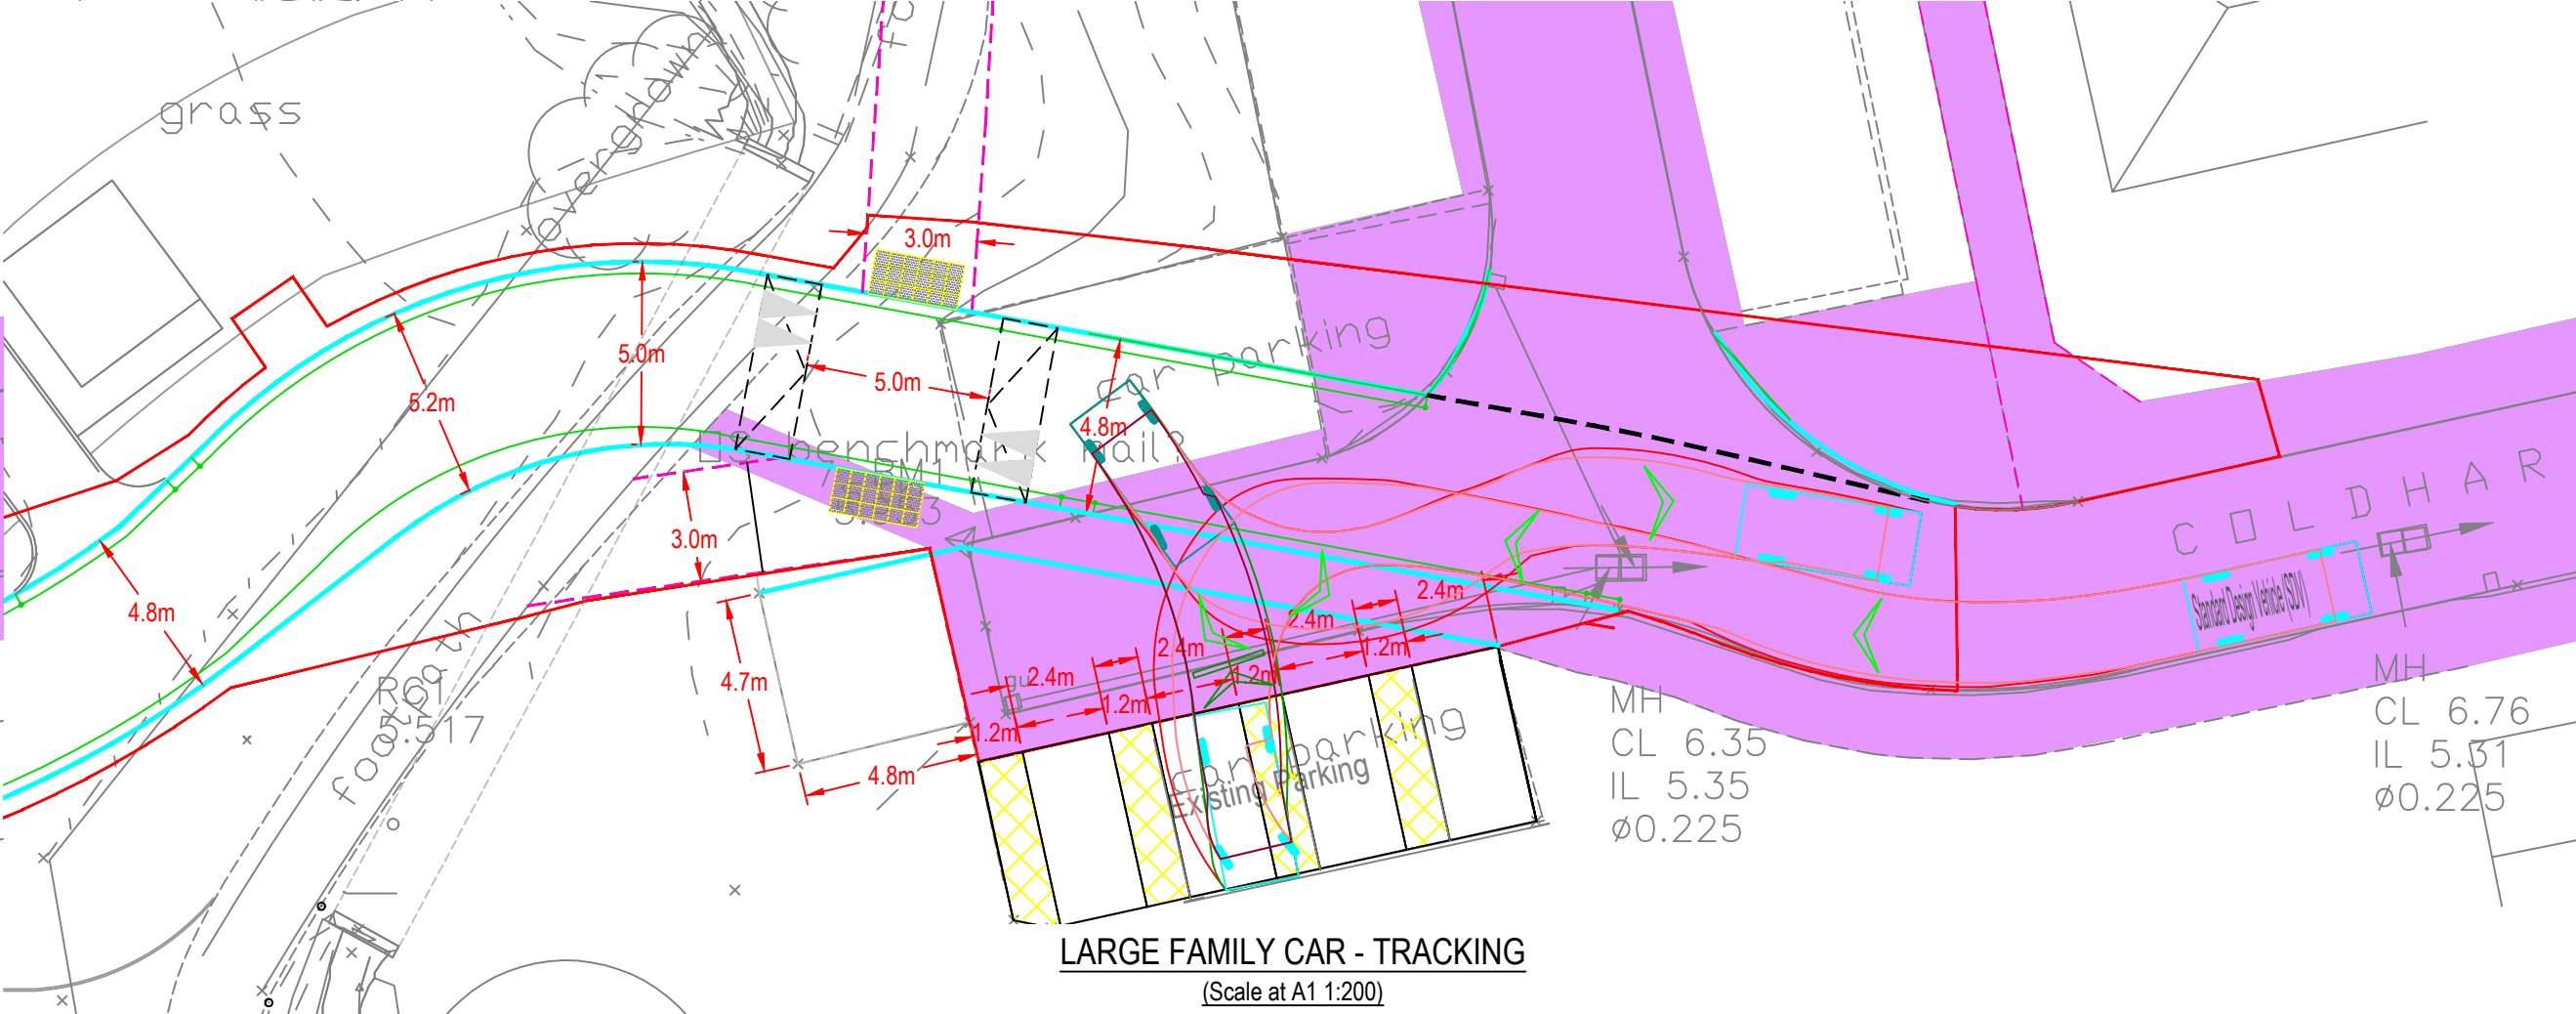


DISCLAIMER NOTES:

- THIS DOCUMENT IS COPYRIGHT OF THE ORIGINATOR AND MUST BE TREATED AS CONFIDENTIAL.
- THIS DOCUMENT MUST NOT BE ALTERED, REPRODUCED OR DISTRIBUTED WITHOUT PRIOR WRITTEN CONSENT OF THE ORIGINATOR.
- THIS DOCUMENT MUST NOT BE ALTERED - THE ORIGINATOR ACCEPTS NO RESPONSIBILITY FOR ANY DISCREPANCIES ARISING AS A RESULT OF THE ORIGINATOR'S INFORMATION BEING ALTERED BY OTHERS.
- ANY DISCREPANCY MUST BE REPORTED TO THE ORIGINATOR.
- DO NOT SCALE THIS DOCUMENT - USE FIGURED DIMENSIONS ONLY.
- ALL DIMENSIONS MUST BE CHECKED ON SITE PRIOR TO COMMENCEMENT OF ANY RELATED WORKS.
- THIS DOCUMENT MUST BE READ IN CONJUNCTION WITH ALL SUPPORTING DOCUMENTS PRODUCED BY THE ORIGINATOR AND OTHER PROJECT DISCIPLINES.
- THE ORIGINATOR ACCEPTS NO RESPONSIBILITY FOR THE ACCURACY OF BACKGROUND INFORMATION PRODUCED BY THIRD PARTIES - THIS MUST BE TREATED AS INDICATIVE ONLY.
- USERS OF THIS DOCUMENT ARE RESPONSIBLE FOR CHECKING WHICH REVISION IS CURRENT.
- THE DOCUMENT STATUS "INFORMATION" OR "PRELIMINARY", INDICATES THAT THIS DRAWING IS FOR REFERENCE PURPOSES ONLY - THE ORIGINATOR WILL ACCEPT NO RESPONSIBILITY FOR THE COMPLETENESS OF INFORMATION UNDER THIS STATUS.
- THE DOCUMENT STATUS "RECORD" OR "AS BUILT" HAS BEEN PREPARED, IN PART, BASED UPON INFORMATION FURNISHED BY OTHERS. WHILE THIS INFORMATION IS BELIEVED TO BE RELIABLE, THE ORIGINATOR ASSUMES NO RESPONSIBILITY FOR THE ACCURACY OF THIS "RECORD" OR "AS BUILT" DOCUMENT OR FOR ANY ERRORS OR OMISSIONS THAT MAY HAVE BEEN INCORPORATED INTO IT AS A RESULT OF INCORRECT INFORMATION PROVIDED TO THE ORIGINATOR. THOSE RELYING ON THE "RECORD" OR "AS BUILT" DOCUMENT ARE ADVISED TO OBTAIN INDEPENDENT VERIFICATION OF ITS ACCURACY.

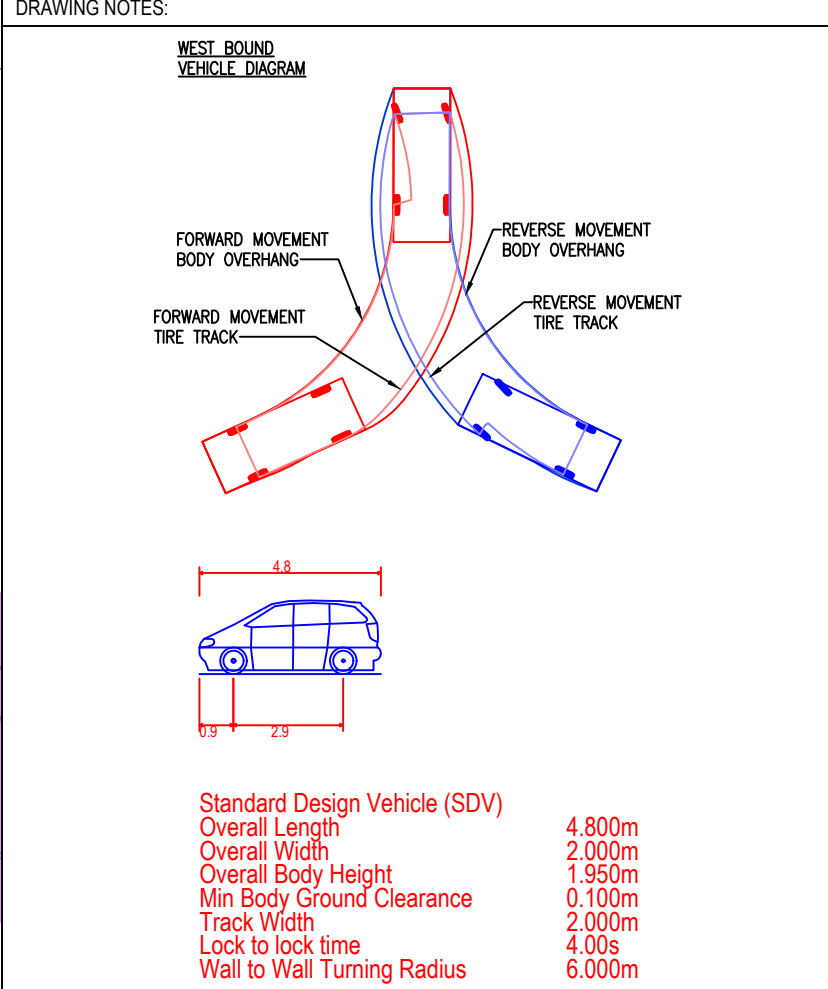

NOTE:
Vehicles have been tracked at 10mph in line with HCC TG2

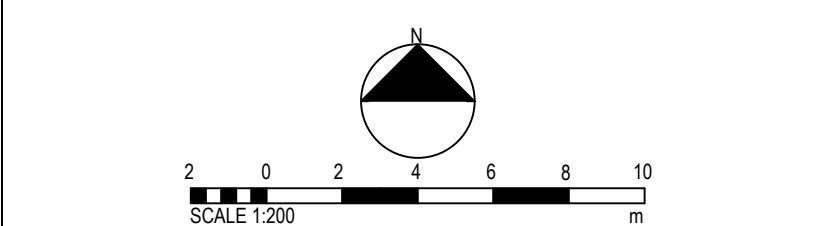

C1	Red line boundary amended & 10mph note added	08/05/26	JF	TC
P2	Car Parking bays sizes increased	23/04/26	JF	TC
P1	Preliminary issue	24/03/26	PJ	TC
REV	DESCRIPTION	DATE	BY	CHKD

ORIGINATOR: www.ridge.co.uk



PROJECT NUMBER: 23339

CLIENT:
DOSWELL PROJECT

IN ASSOCIATION WITH:

PROJECT:
COLDHARBOUR FARM ROAD
EMSWORTH

TITLE:
S278 TRACKING
CAR PARKING
SHEET 1

DRAWN BY:	PJ	CHECKED BY:		APPROVED BY:	
SCALE:	AS SHOWN @ A1	DATE:	24/03/2026		
STATUS:	DESCRIPTION:				

DRAWING No:	JUBB_XX_XX_DR_C_1203				
PROJECT:	23339	ORIG:	JUBB	FUNCTION:	XX
		SPATIAL:	XX	FORM:	DR
		DISCIPLINE:	X	NUMBER:	001203
					C1