

NOTES

PROJECT No. COL.MOD.UK.0009796
BTEE ID. 25456
MBNL ID. HVT018
H3G ID. PO0029

4.A	COL.MOD.UK.0009796 PLANNING		WHP	
4	N/A WAYLEAVE UPDATE	22/07/21	TCS	TCS
3	168478 AS BUILT	12/10/15	HFC	HF
2	168478 PLANNING ISSUE	23/07/15	HFC	CGP
1	168478 CONVERSION	07/07/15	JH	SH
ISS	REVISION	DATE	DRN	APP



CELLNEX UK
R+, 4TH FLOOR, 2 BLA GRAVE STREET, READING, RG1 1AZ
Tel. 020 4526 8553

SITE No **UK-HA-006484**
WARBLINGTON HAVANT ROAD
HAVANT ROAD
WARBLINGTON
LANGSTONE
HAMPSHIRE
PO10 7LG

NGR SU 73110 06030
OS GRID 473110 106030



TITLE
SITE PLAN
PROPOSED
BTEE - PRIMARY AREA POWER RESILIENCE

SCALE 1:100

DRAWN	IM	01/06/11
APPROVED	TCS	22/07/21

DRG No. Sheet 1 of 1 Rev

UKHA006484-02-100-MD004 4.A

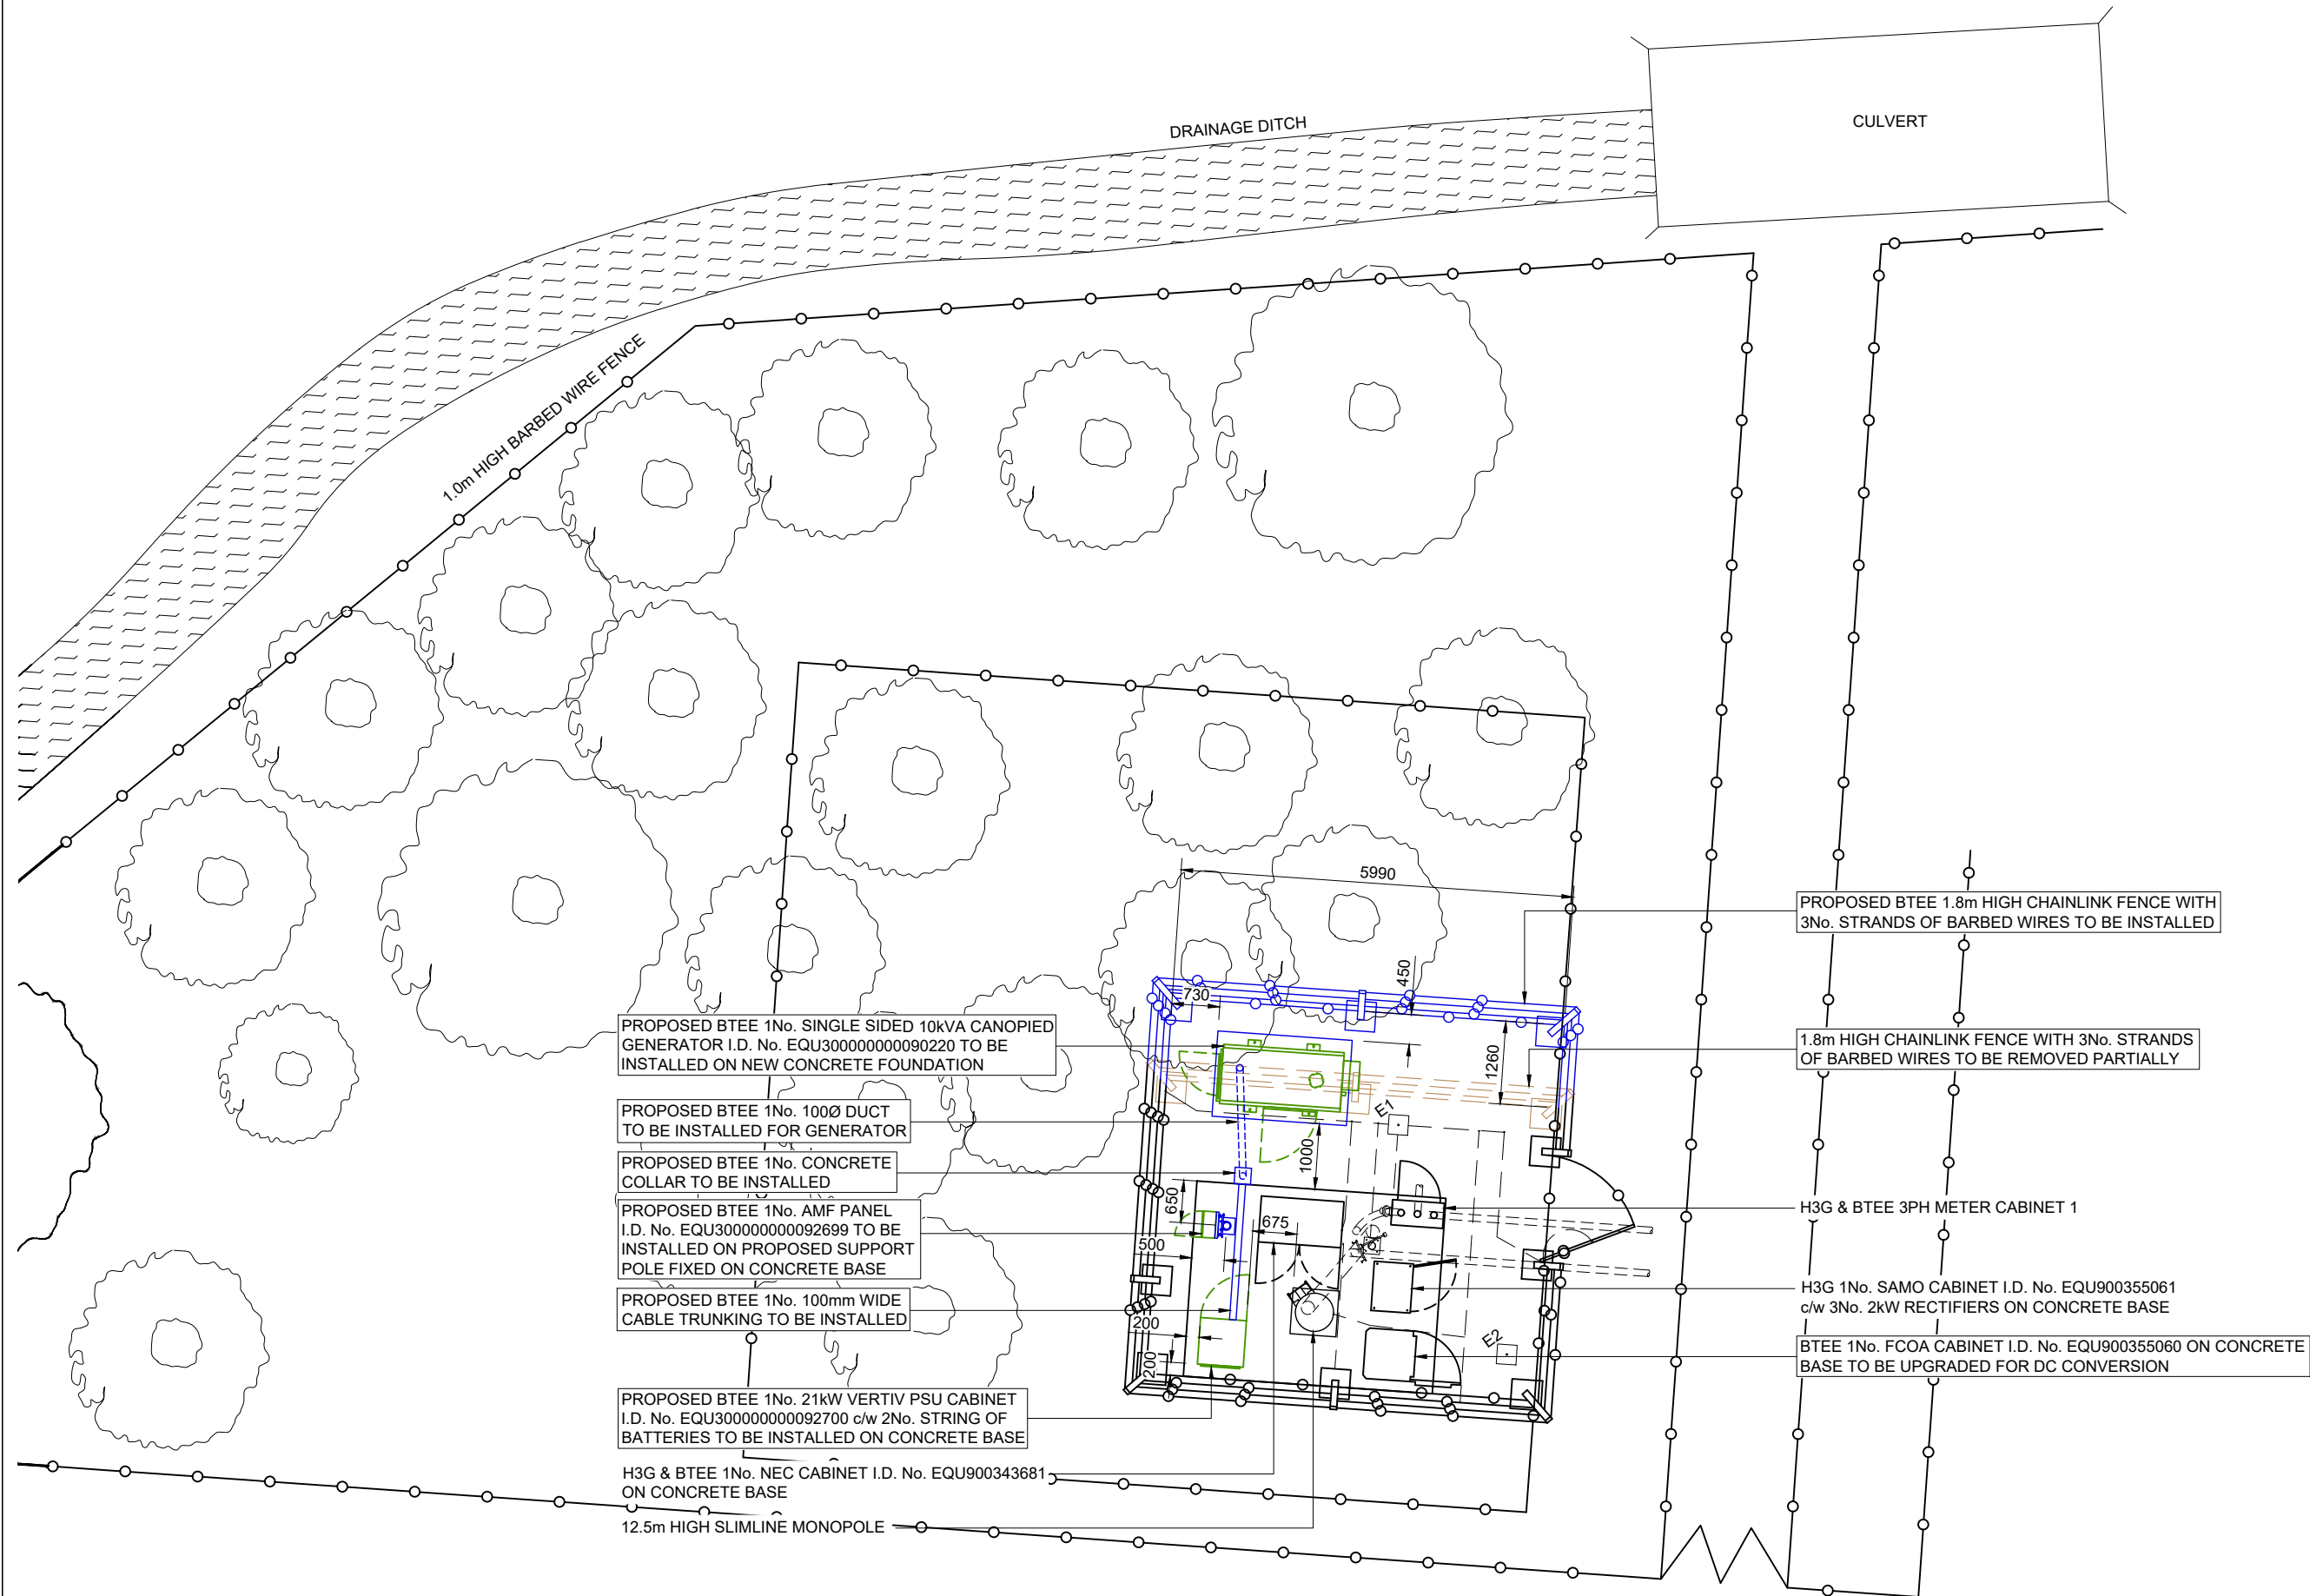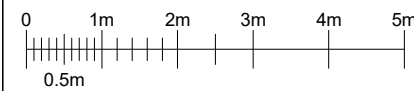

FEINT DETAILS INDICATE LOCATIONS
RESERVED FOR OTHER PROPOSALS
WHICH MAY BE THE SUBJECT OF
SEPARATE APPLICATIONS

NOTES

PROJECT No. COL.MOD.UK.0009796

BTEE ID. 25456

MBNL ID. HVT018

H3G ID. PO0029

4.A	COL.MOD.UK.0009796 PLANNING		WHP	
4	N/A WAYLEAVE UPDATE	22/07/21	TCS	TCS
3	168478 AS BUILT	12/10/15	HFC	HF
2	168478 PLANNING ISSUE	23/07/15	HFC	CGP
1	168478 CONVERSION	07/07/15	JH	SH

ISS	REVISION	DATE	DRN	APP
-----	----------	------	-----	-----

cellnex
driving telecom connectivity
CELLNEX UK
R+, 4TH FLOOR, 2 BLAGRAVE STREET, READING, RG1 1AZ
Tel. 020 4526 8553

SITE No **UK-HA-006484**
WARBLINGTON HAVANT ROAD
HAVANT ROAD
WARBLINGTON
LANGSTONE
HAMPSHIRE
PO10 7LG

NGR SU 73110 06030

OS GRID 473110 106030


TITLE
ELEVATION
PROPOSED
BTEE - PRIMARY AREA POWER RESILIENCE

SCALE 1:100

DRAWN	IM	01/06/11
APPROVED	TCS	22/07/21

DRG No. Sheet 1 of 1 Rev

UKHA006484-02-150-MD004 4.A

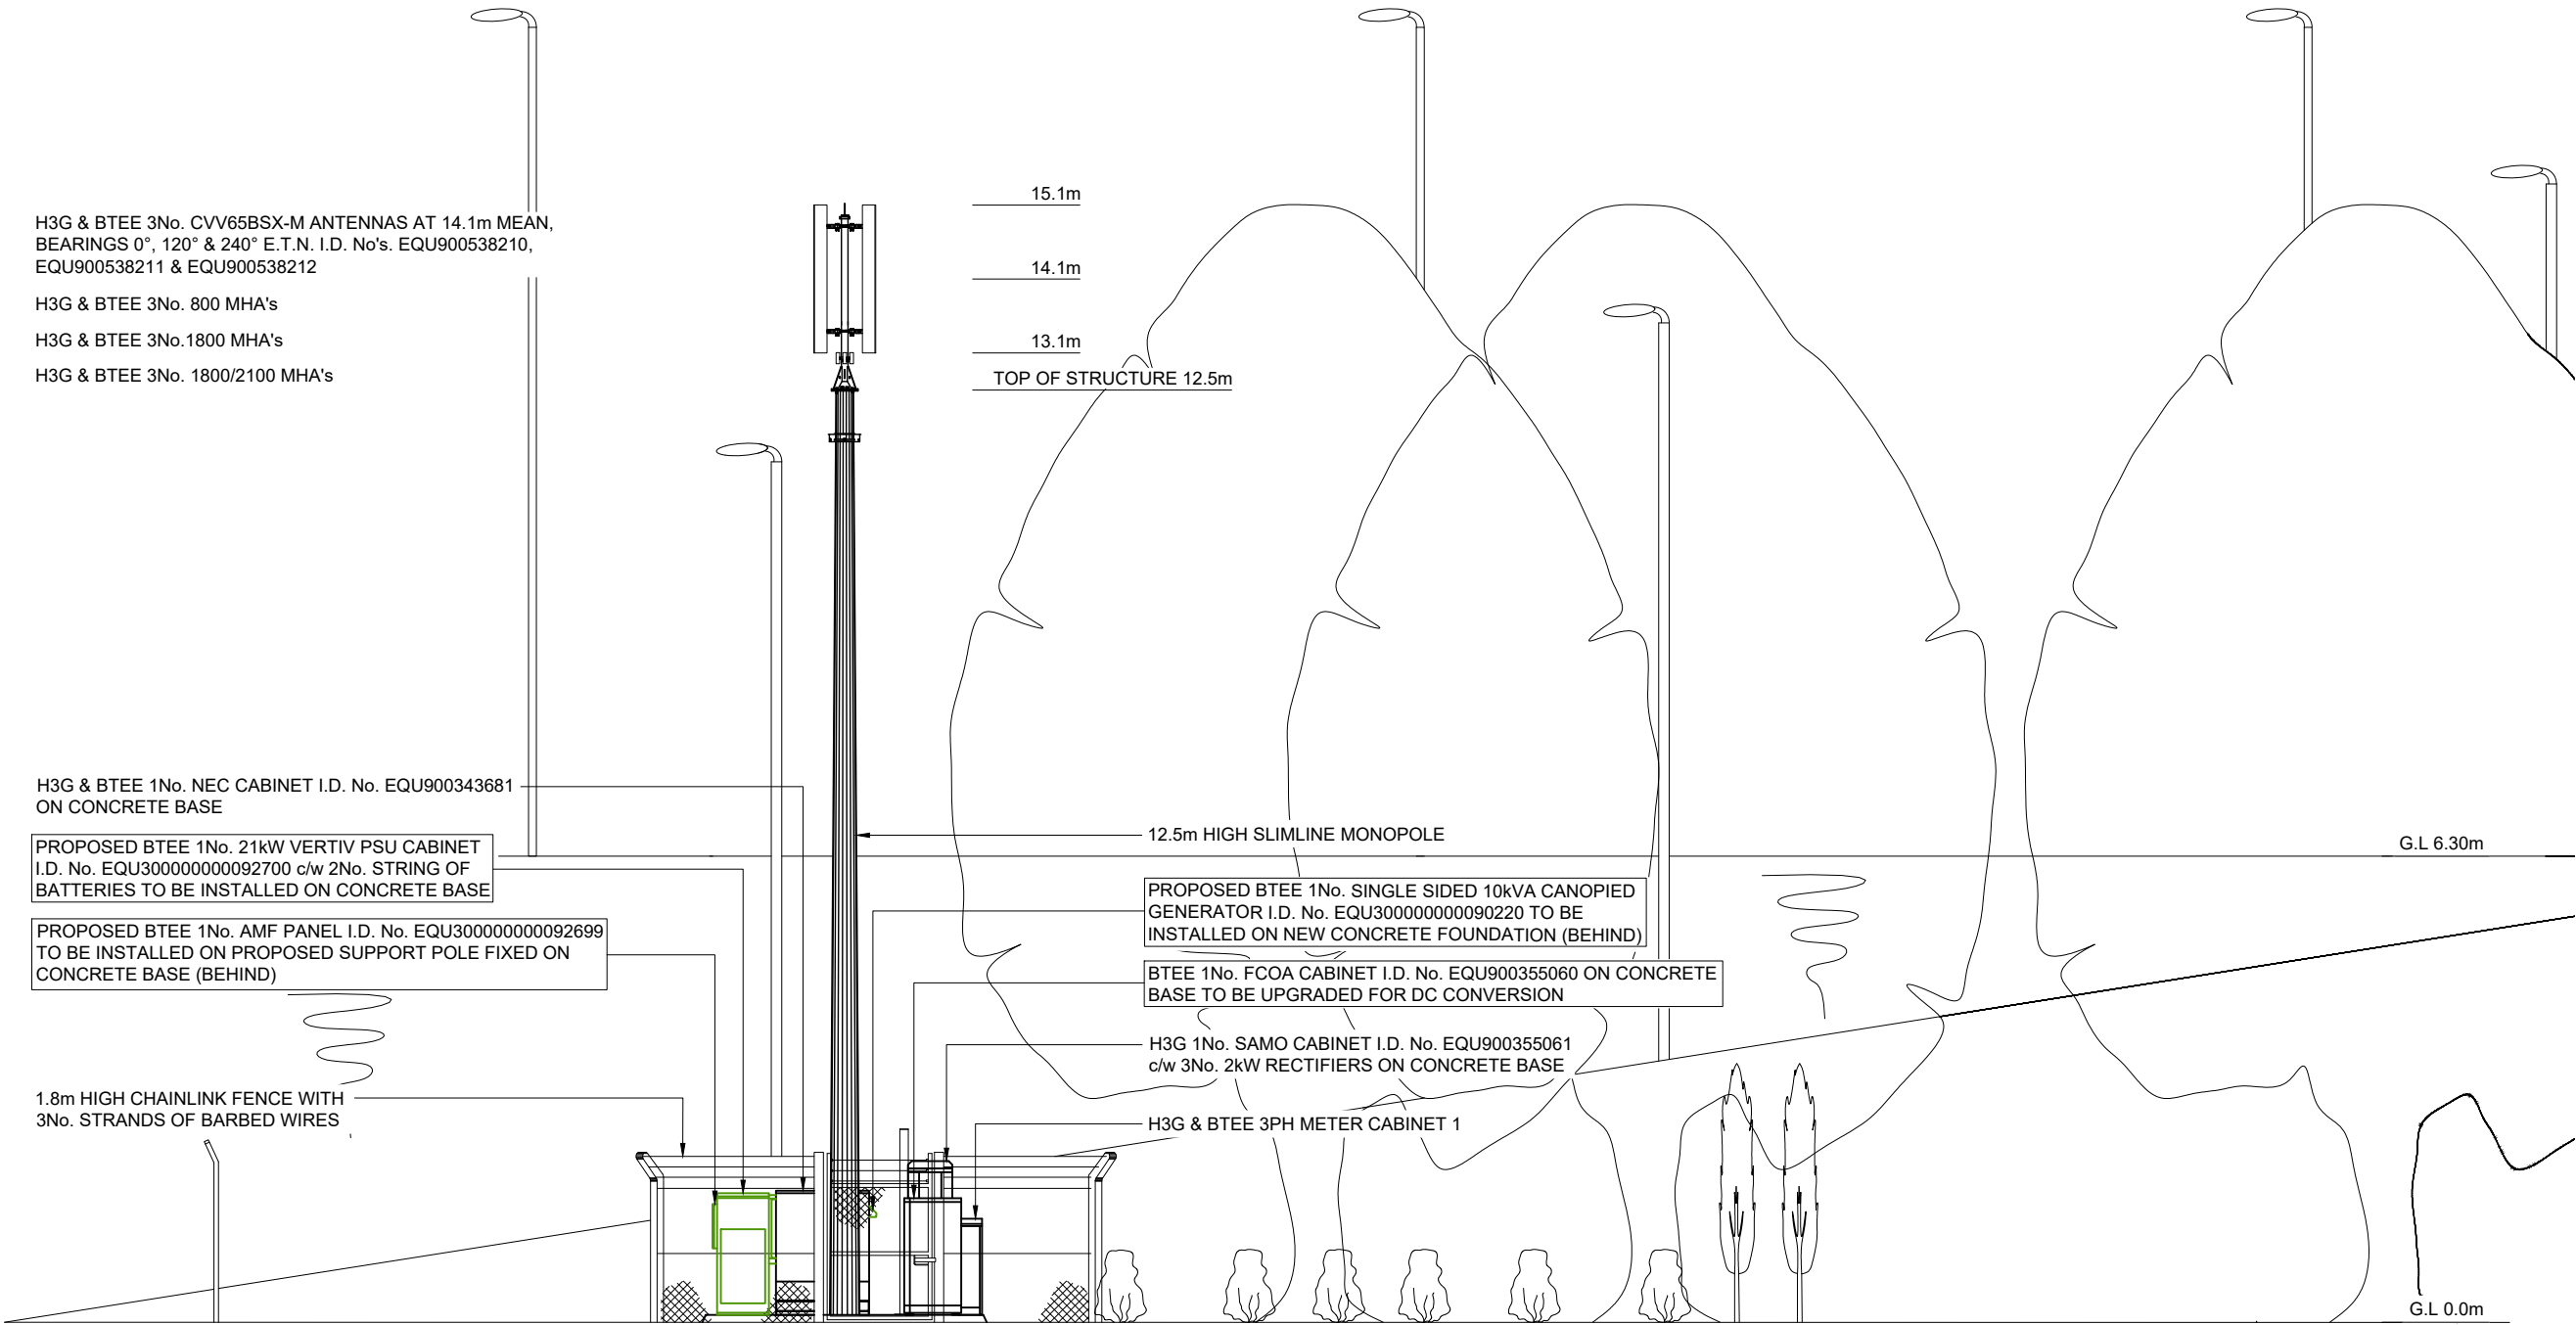

SOUTH ELEVATION



FEINT DETAILS INDICATE LOCATIONS
RESERVED FOR OTHER PROPOSALS
WHICH MAY BE THE SUBJECT OF
SEPARATE APPLICATIONS