

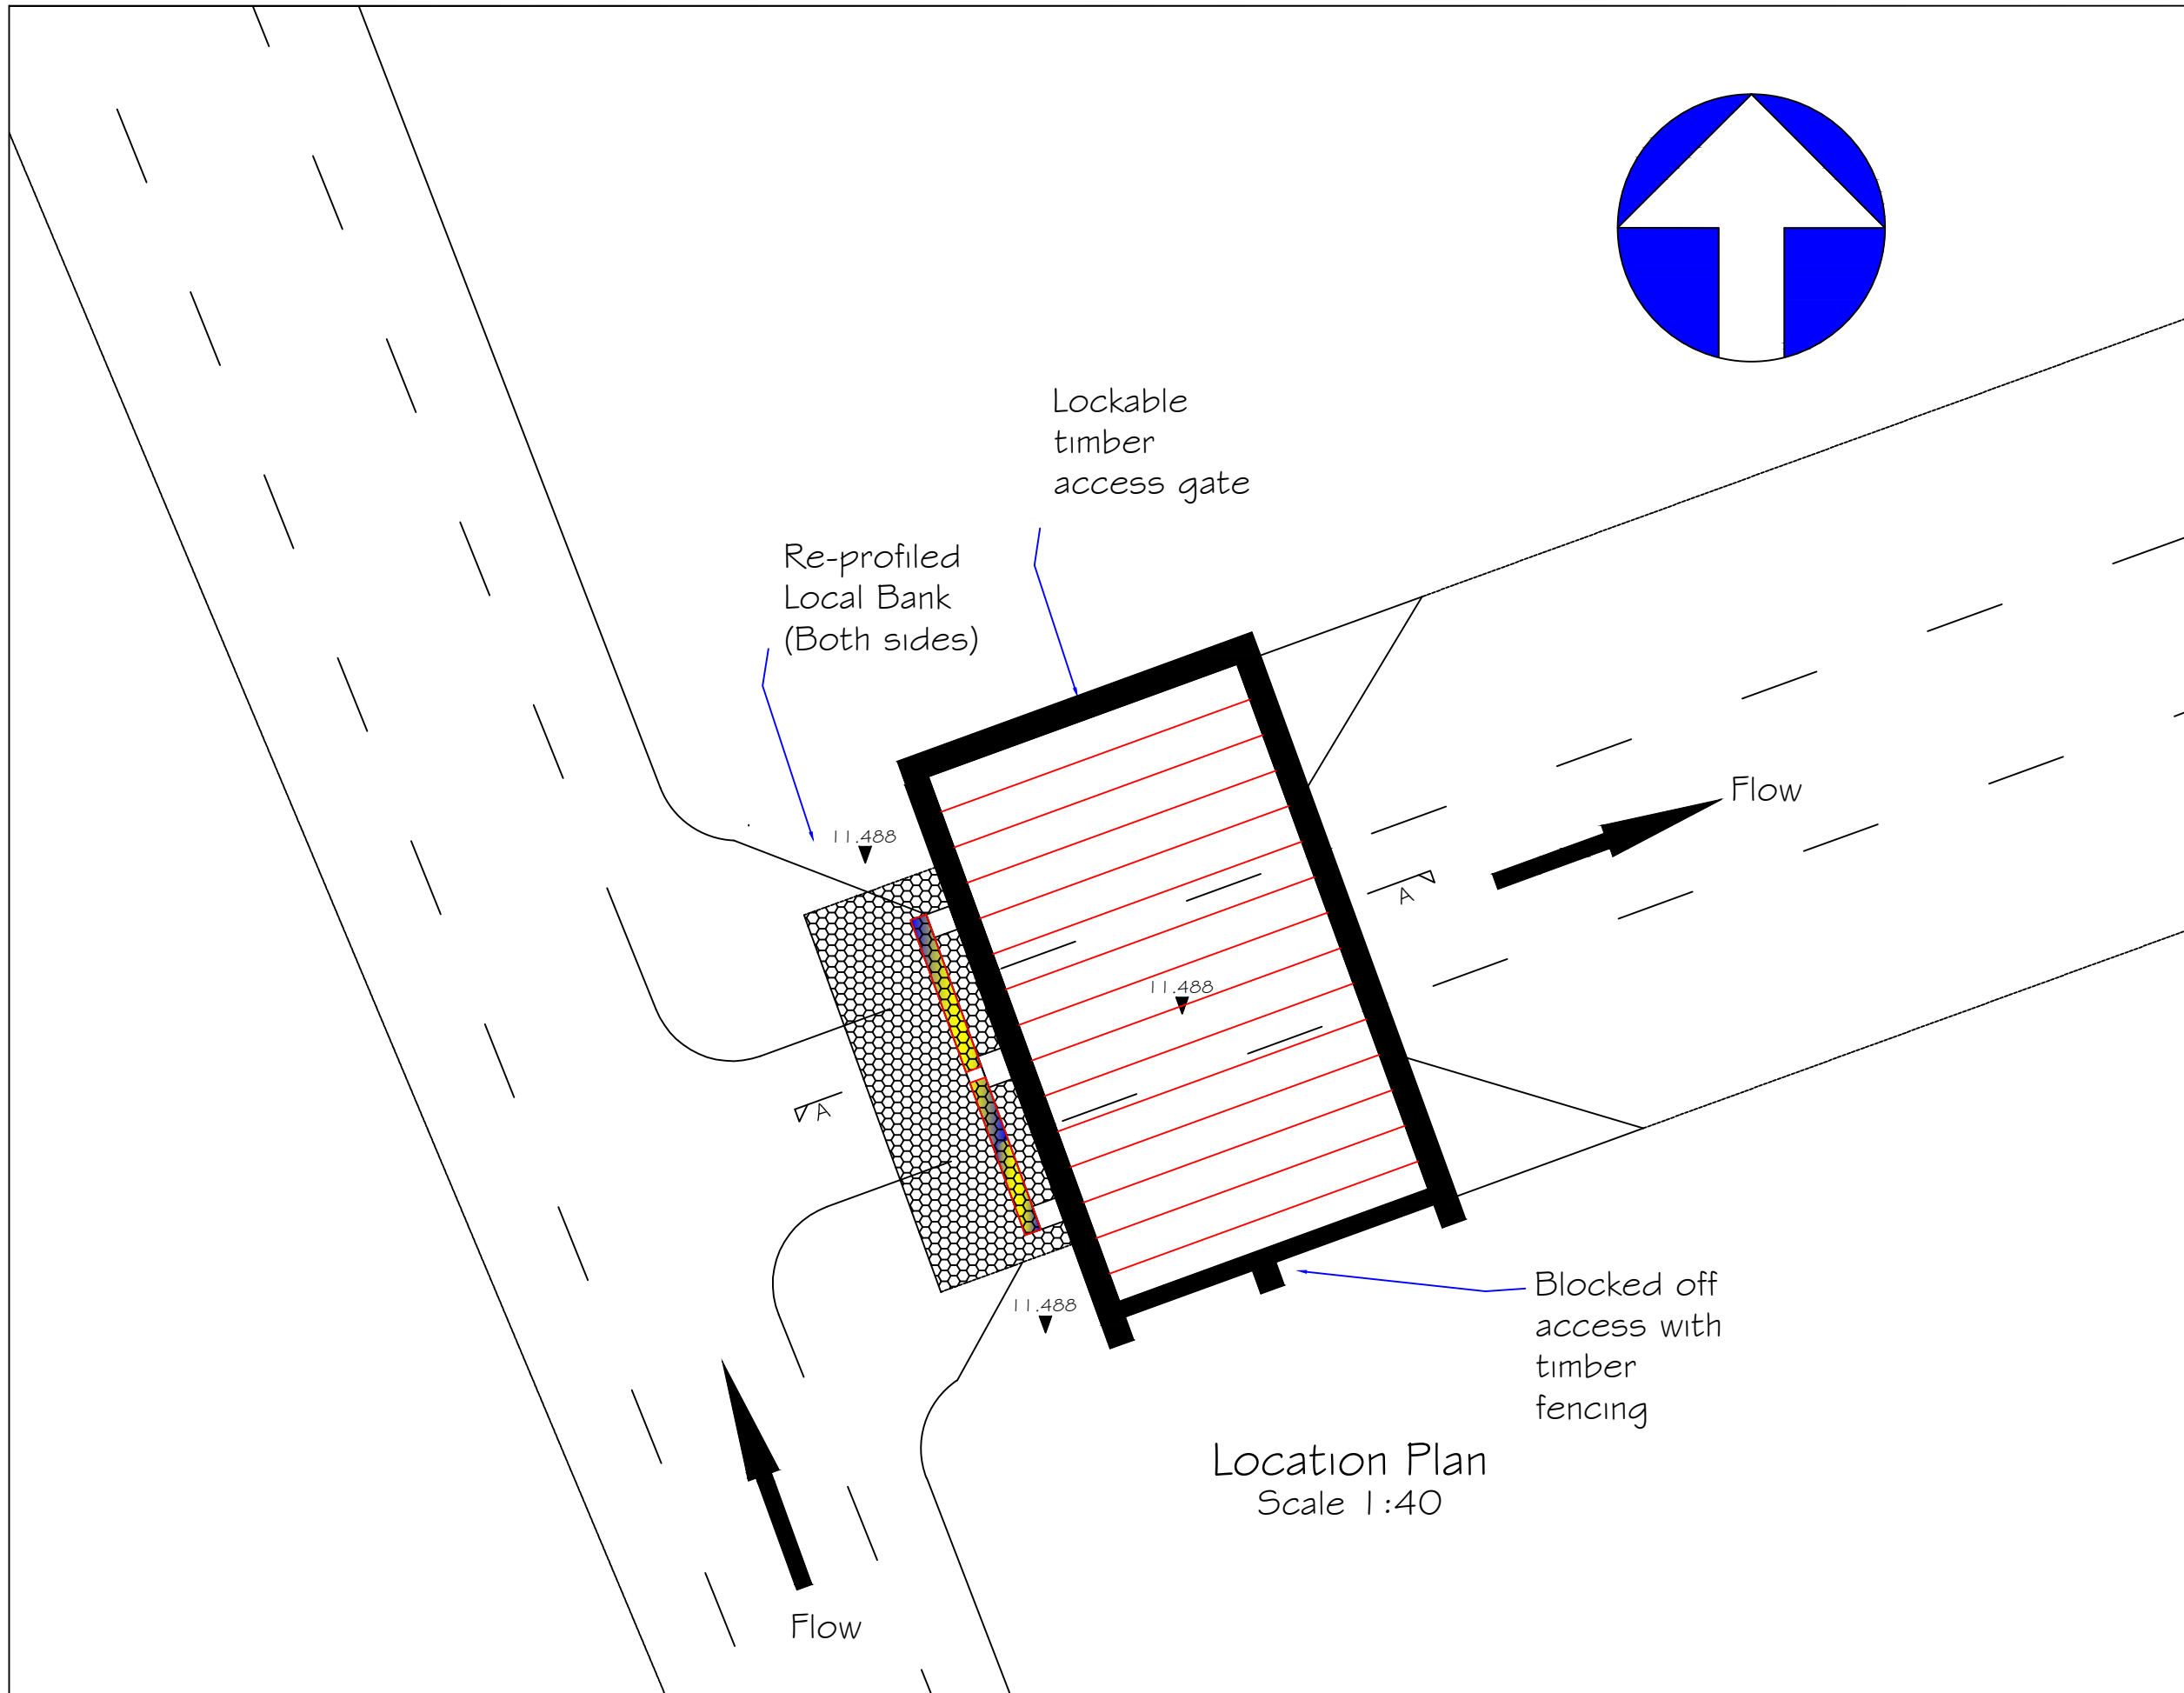
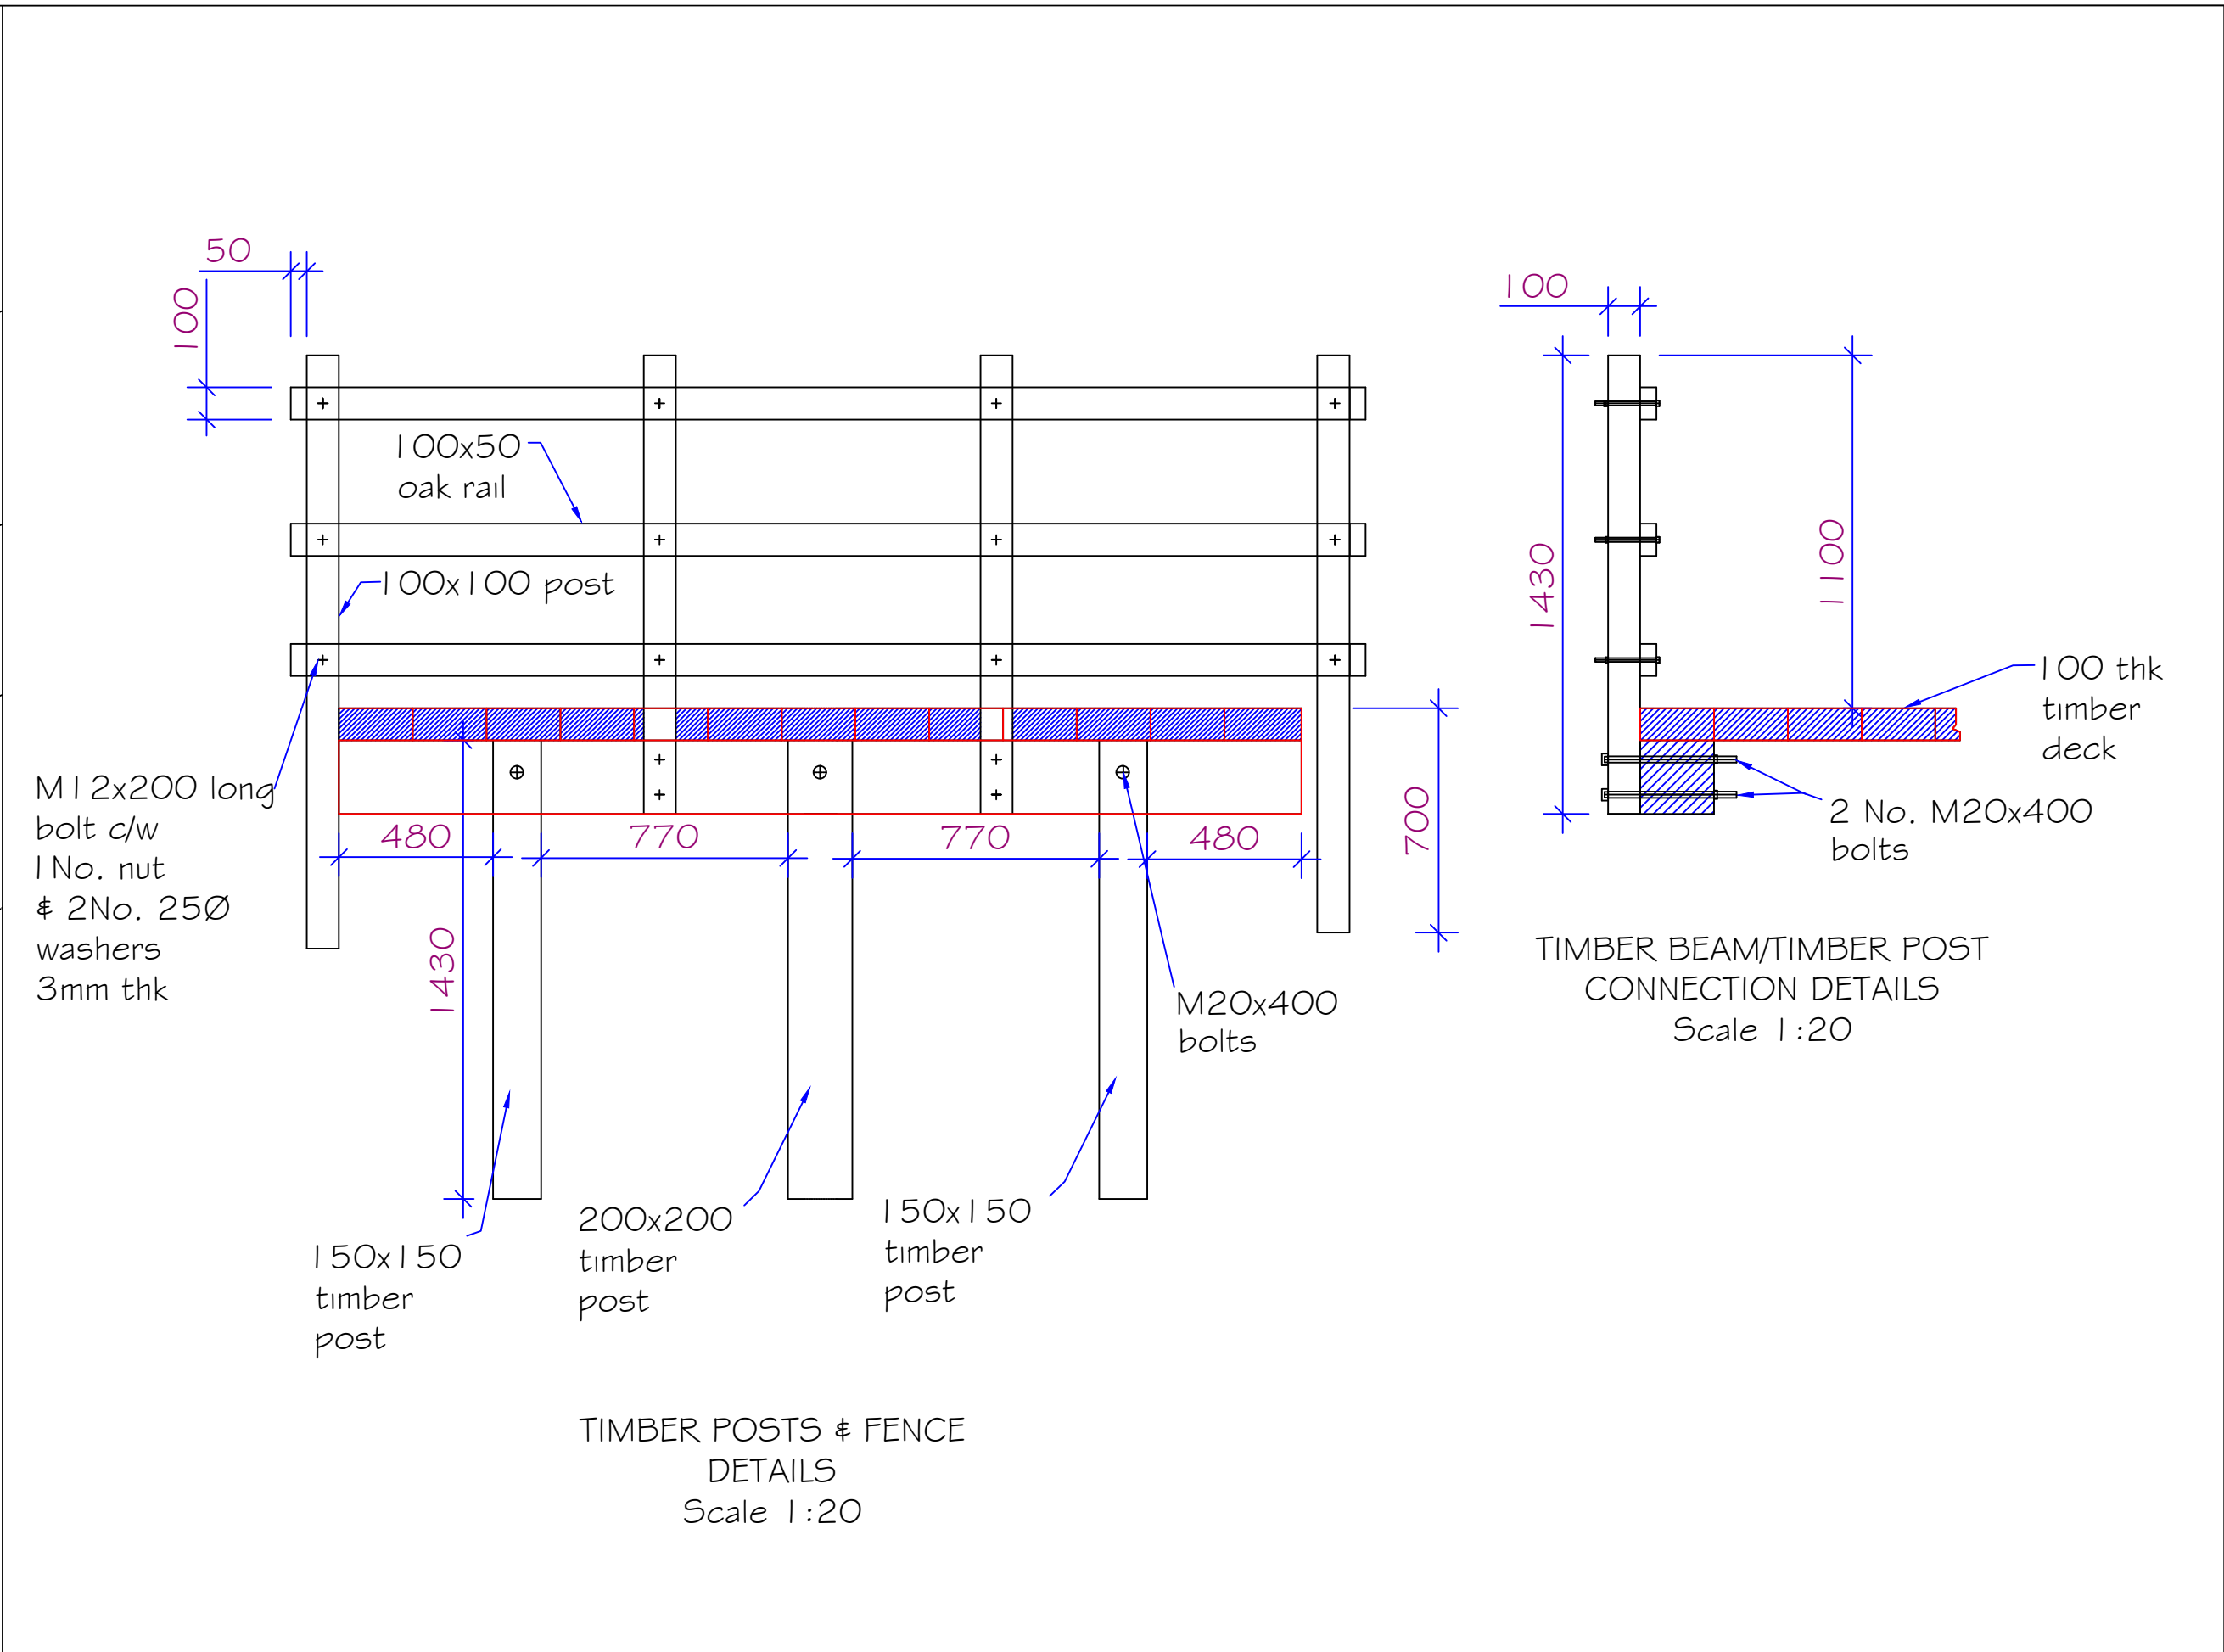


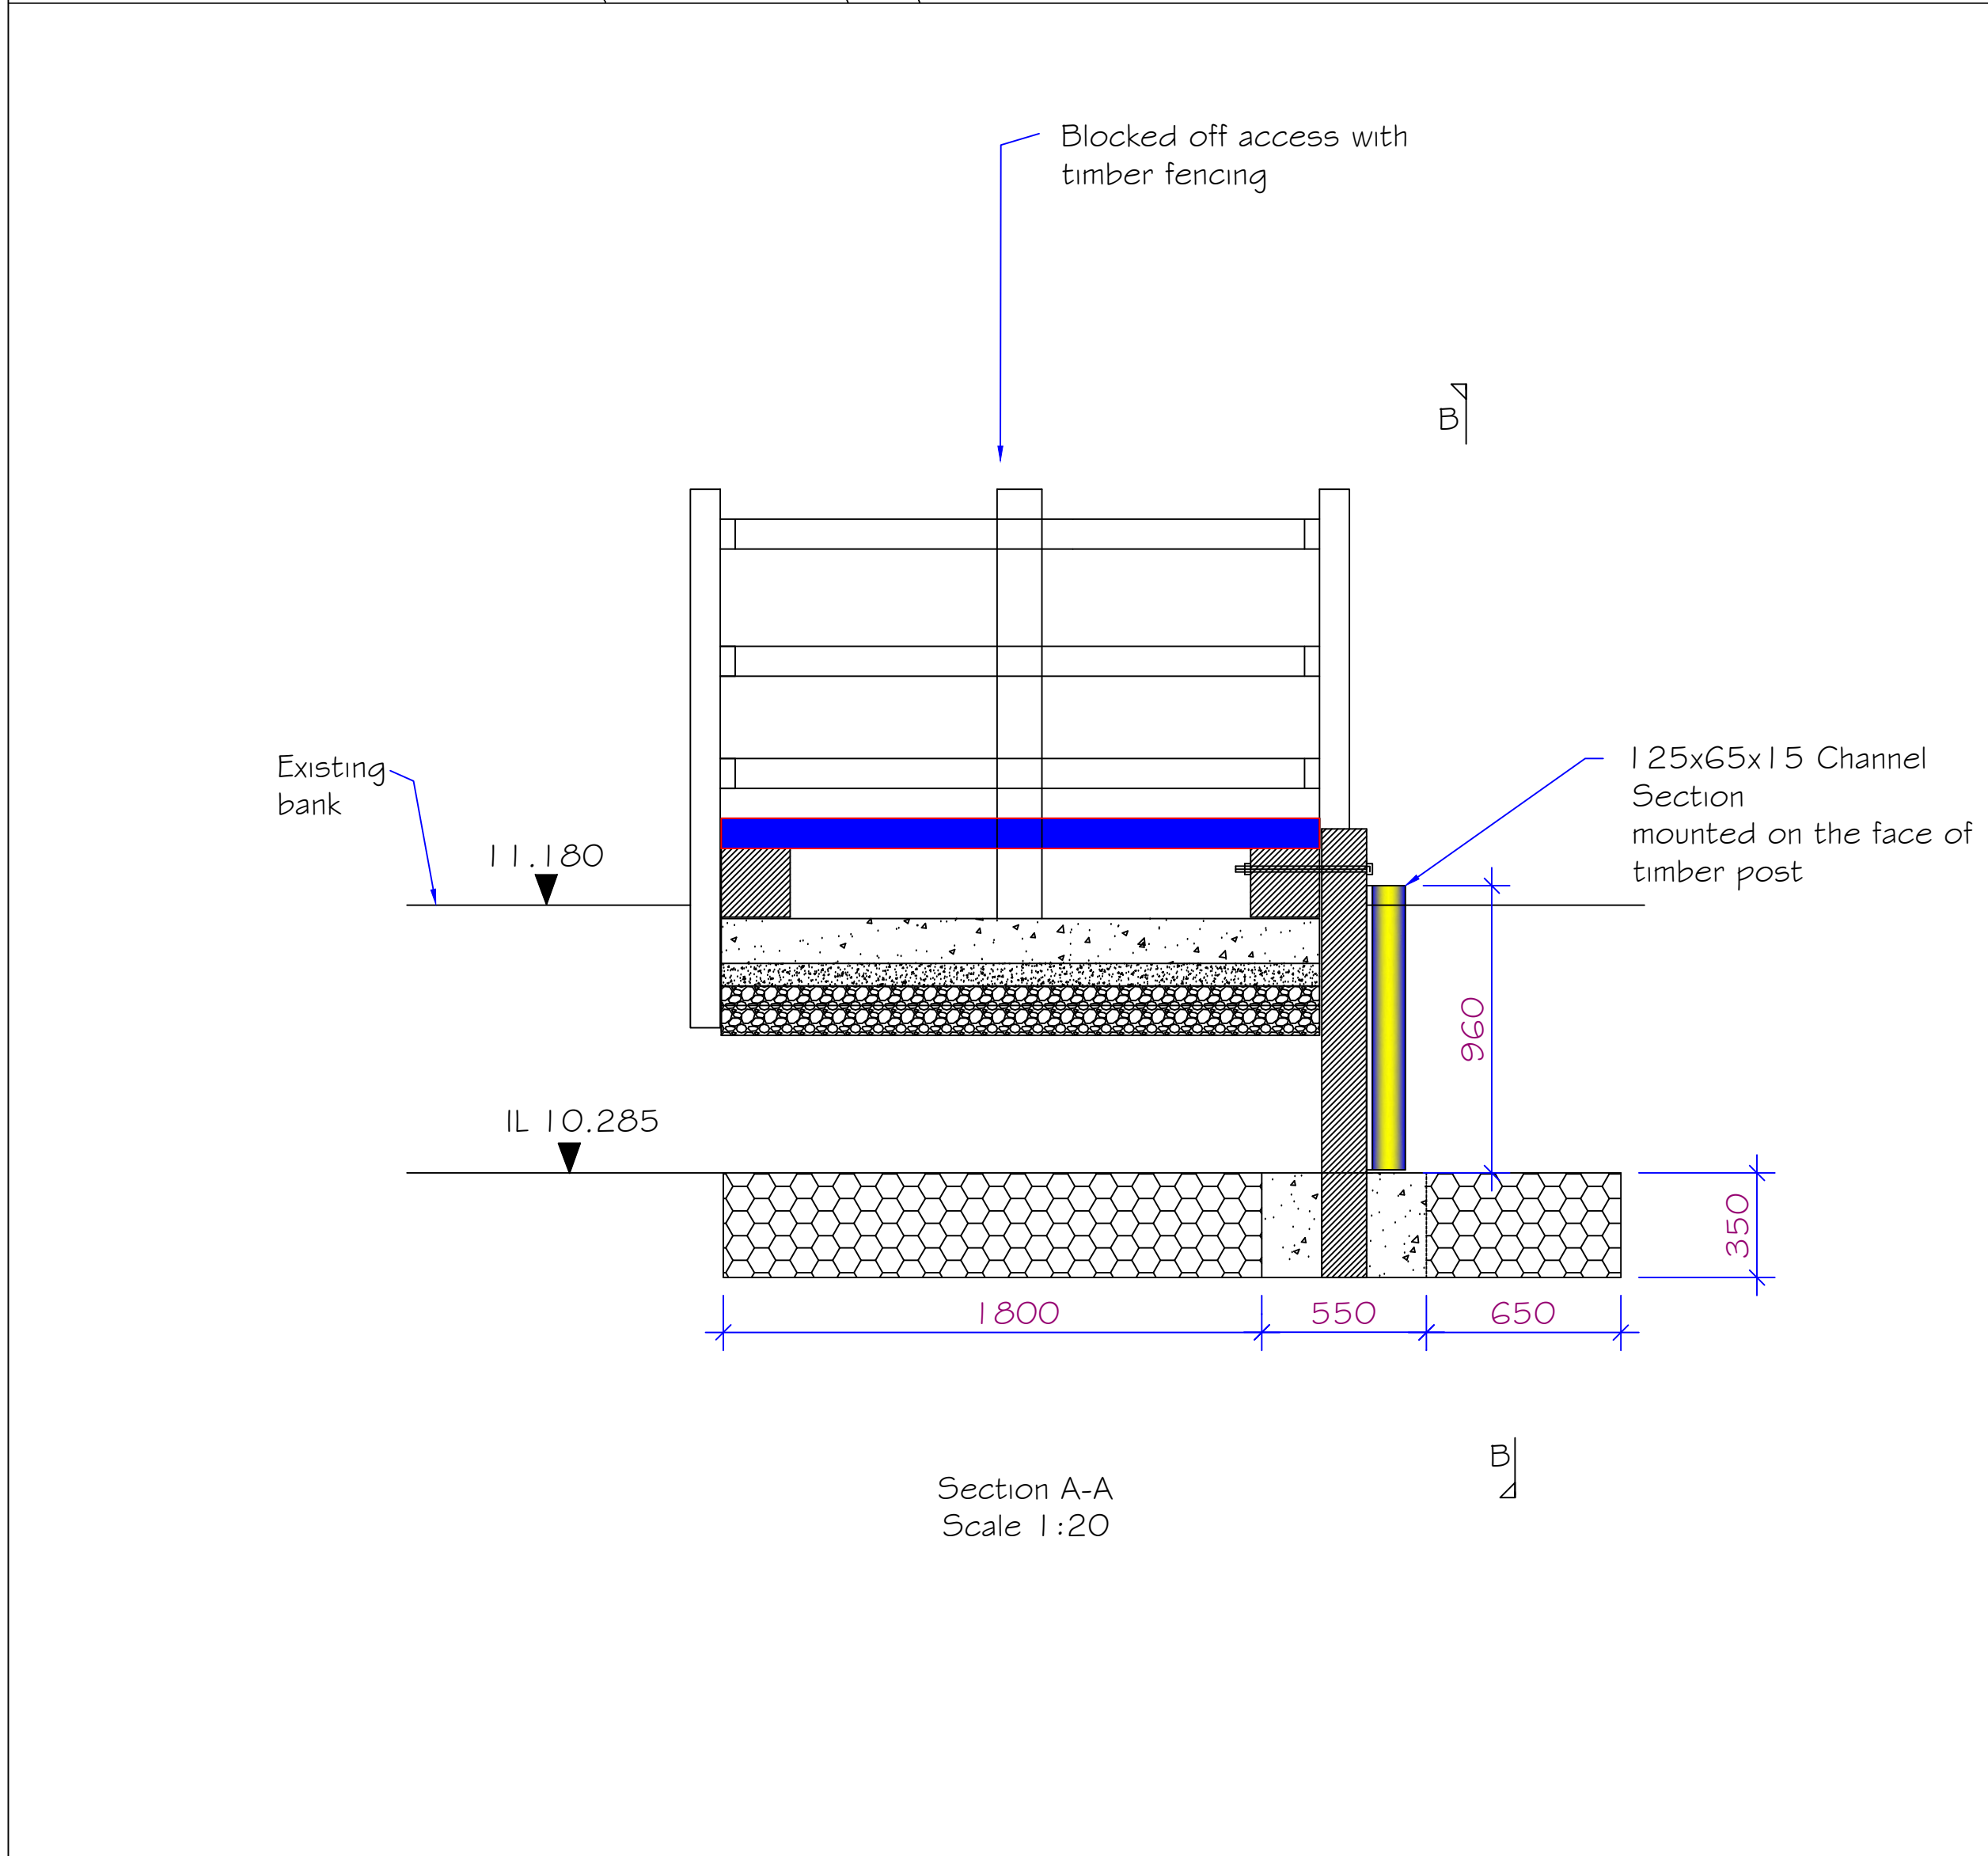

- NOTES
- 1) All Dimensions in mm unless stated
 - 2) All Dimensions to be checked on site before any fabrication work is undertaken
 - 3) Bridge designed for pedestrian loading only
 - 4) Handrail designed for pedestrian loading only
 - 5) All timber to timber interfaces to have full bearing, no packing pieces permitted unless stated
 - 6) All bolts to be installed to a driving fit
 - 7) All bolts to have oversized washers against timber faces
 - 8) Nominal dimensions given for all timber sizes

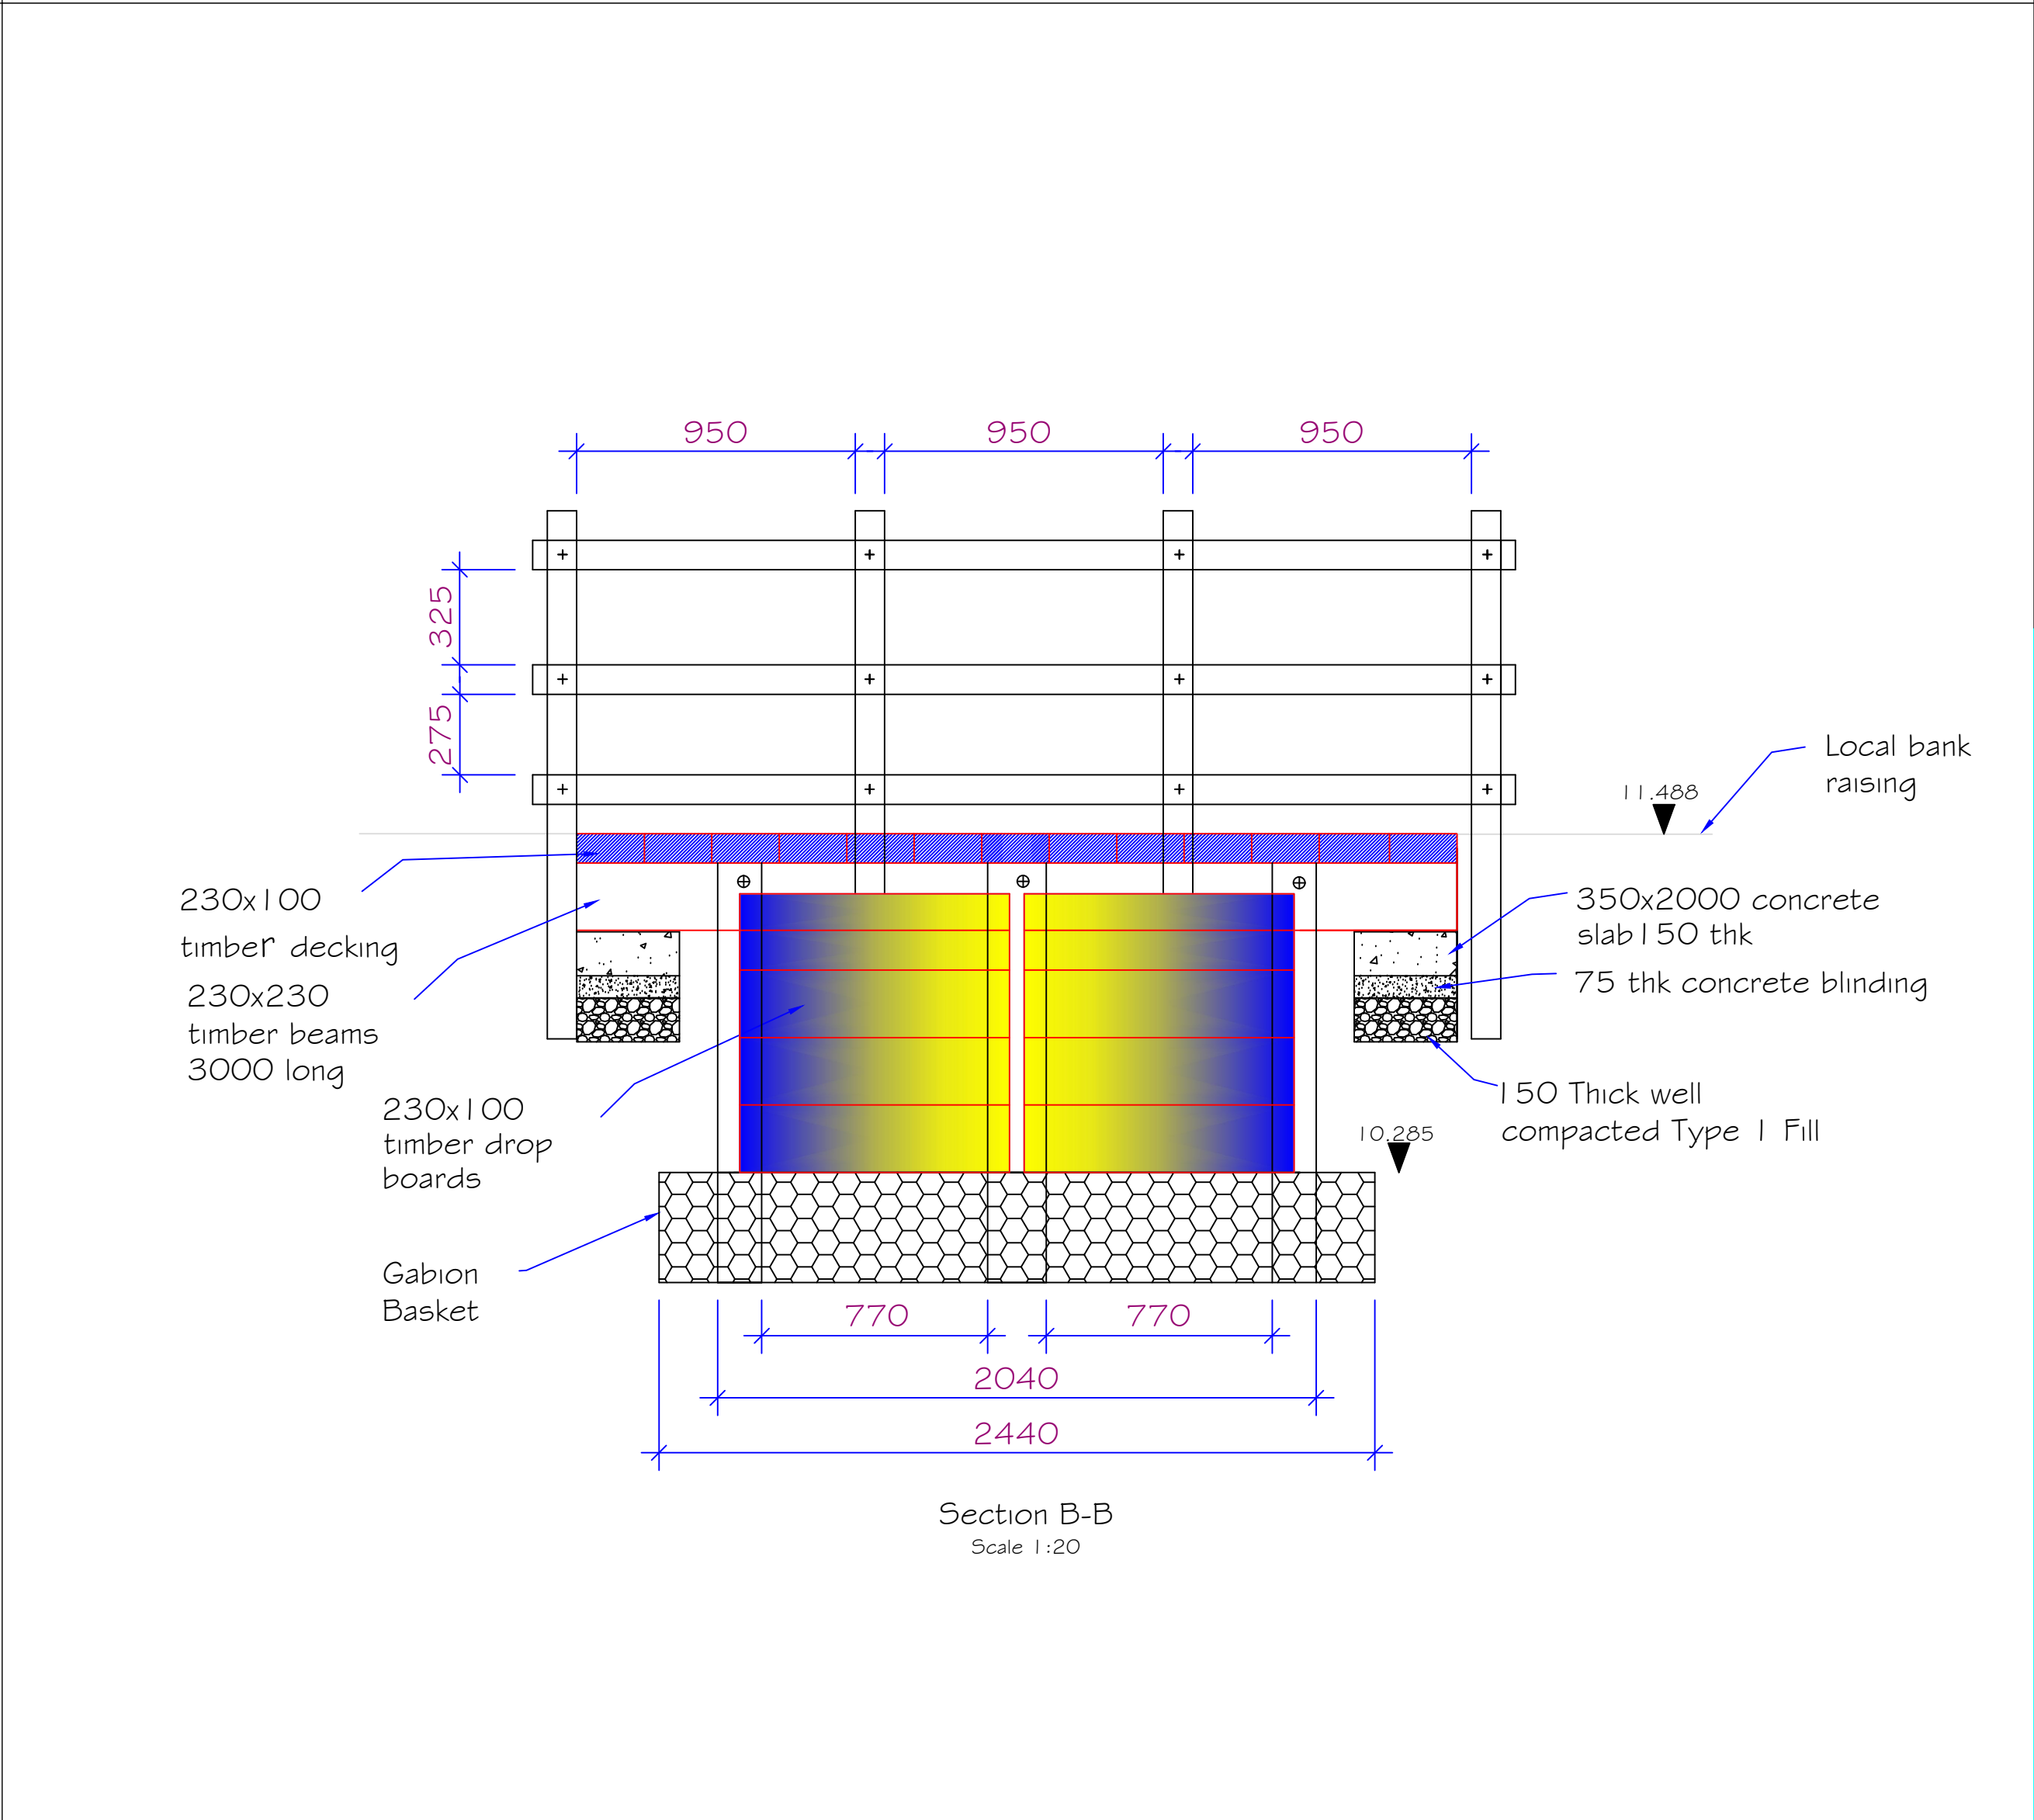

SAFETY, HEALTH AND ENVIRONMENTAL INFORMATION

IN ADDITION TO THE HAZARDS/RISKS NORMALLY ASSOCIATED WITH THE TYPES OF WORK DETAILS ON THIS DRAWING, NOTE THE FOLLOWING SIGNIFICANT RESIDUAL RISKS

- CONSTRUCTION**
1. Working in close proximity to the public.
 2. Pollution of watercourse from concreting activities
 3. Site susceptible to sudden rise in water level.

Rev 1	Access gate details added	Asad Abbas
Rev	Description	By
Rev	Description	By

 **ENVIRONMENT AGENCY**
Asset Performance East Hants and Chichester
Canal Walk Romsey (SO51 7LP)
Hampshire

Tel: 01794832753 Fax:

PROJECT Nore Farm Stream Flood Alleviation Scheme

TITLE Area of Interest 4
Flow control Structure at
Eastern Connection Ditch

Scale	As shown	Date	29/07/2015	Sheet size	A1
Drawn by	Asad Abbas	Checked by	Richard Rowland		

Drg. No. EA-35455-AA-0014 *AS BUILT*