


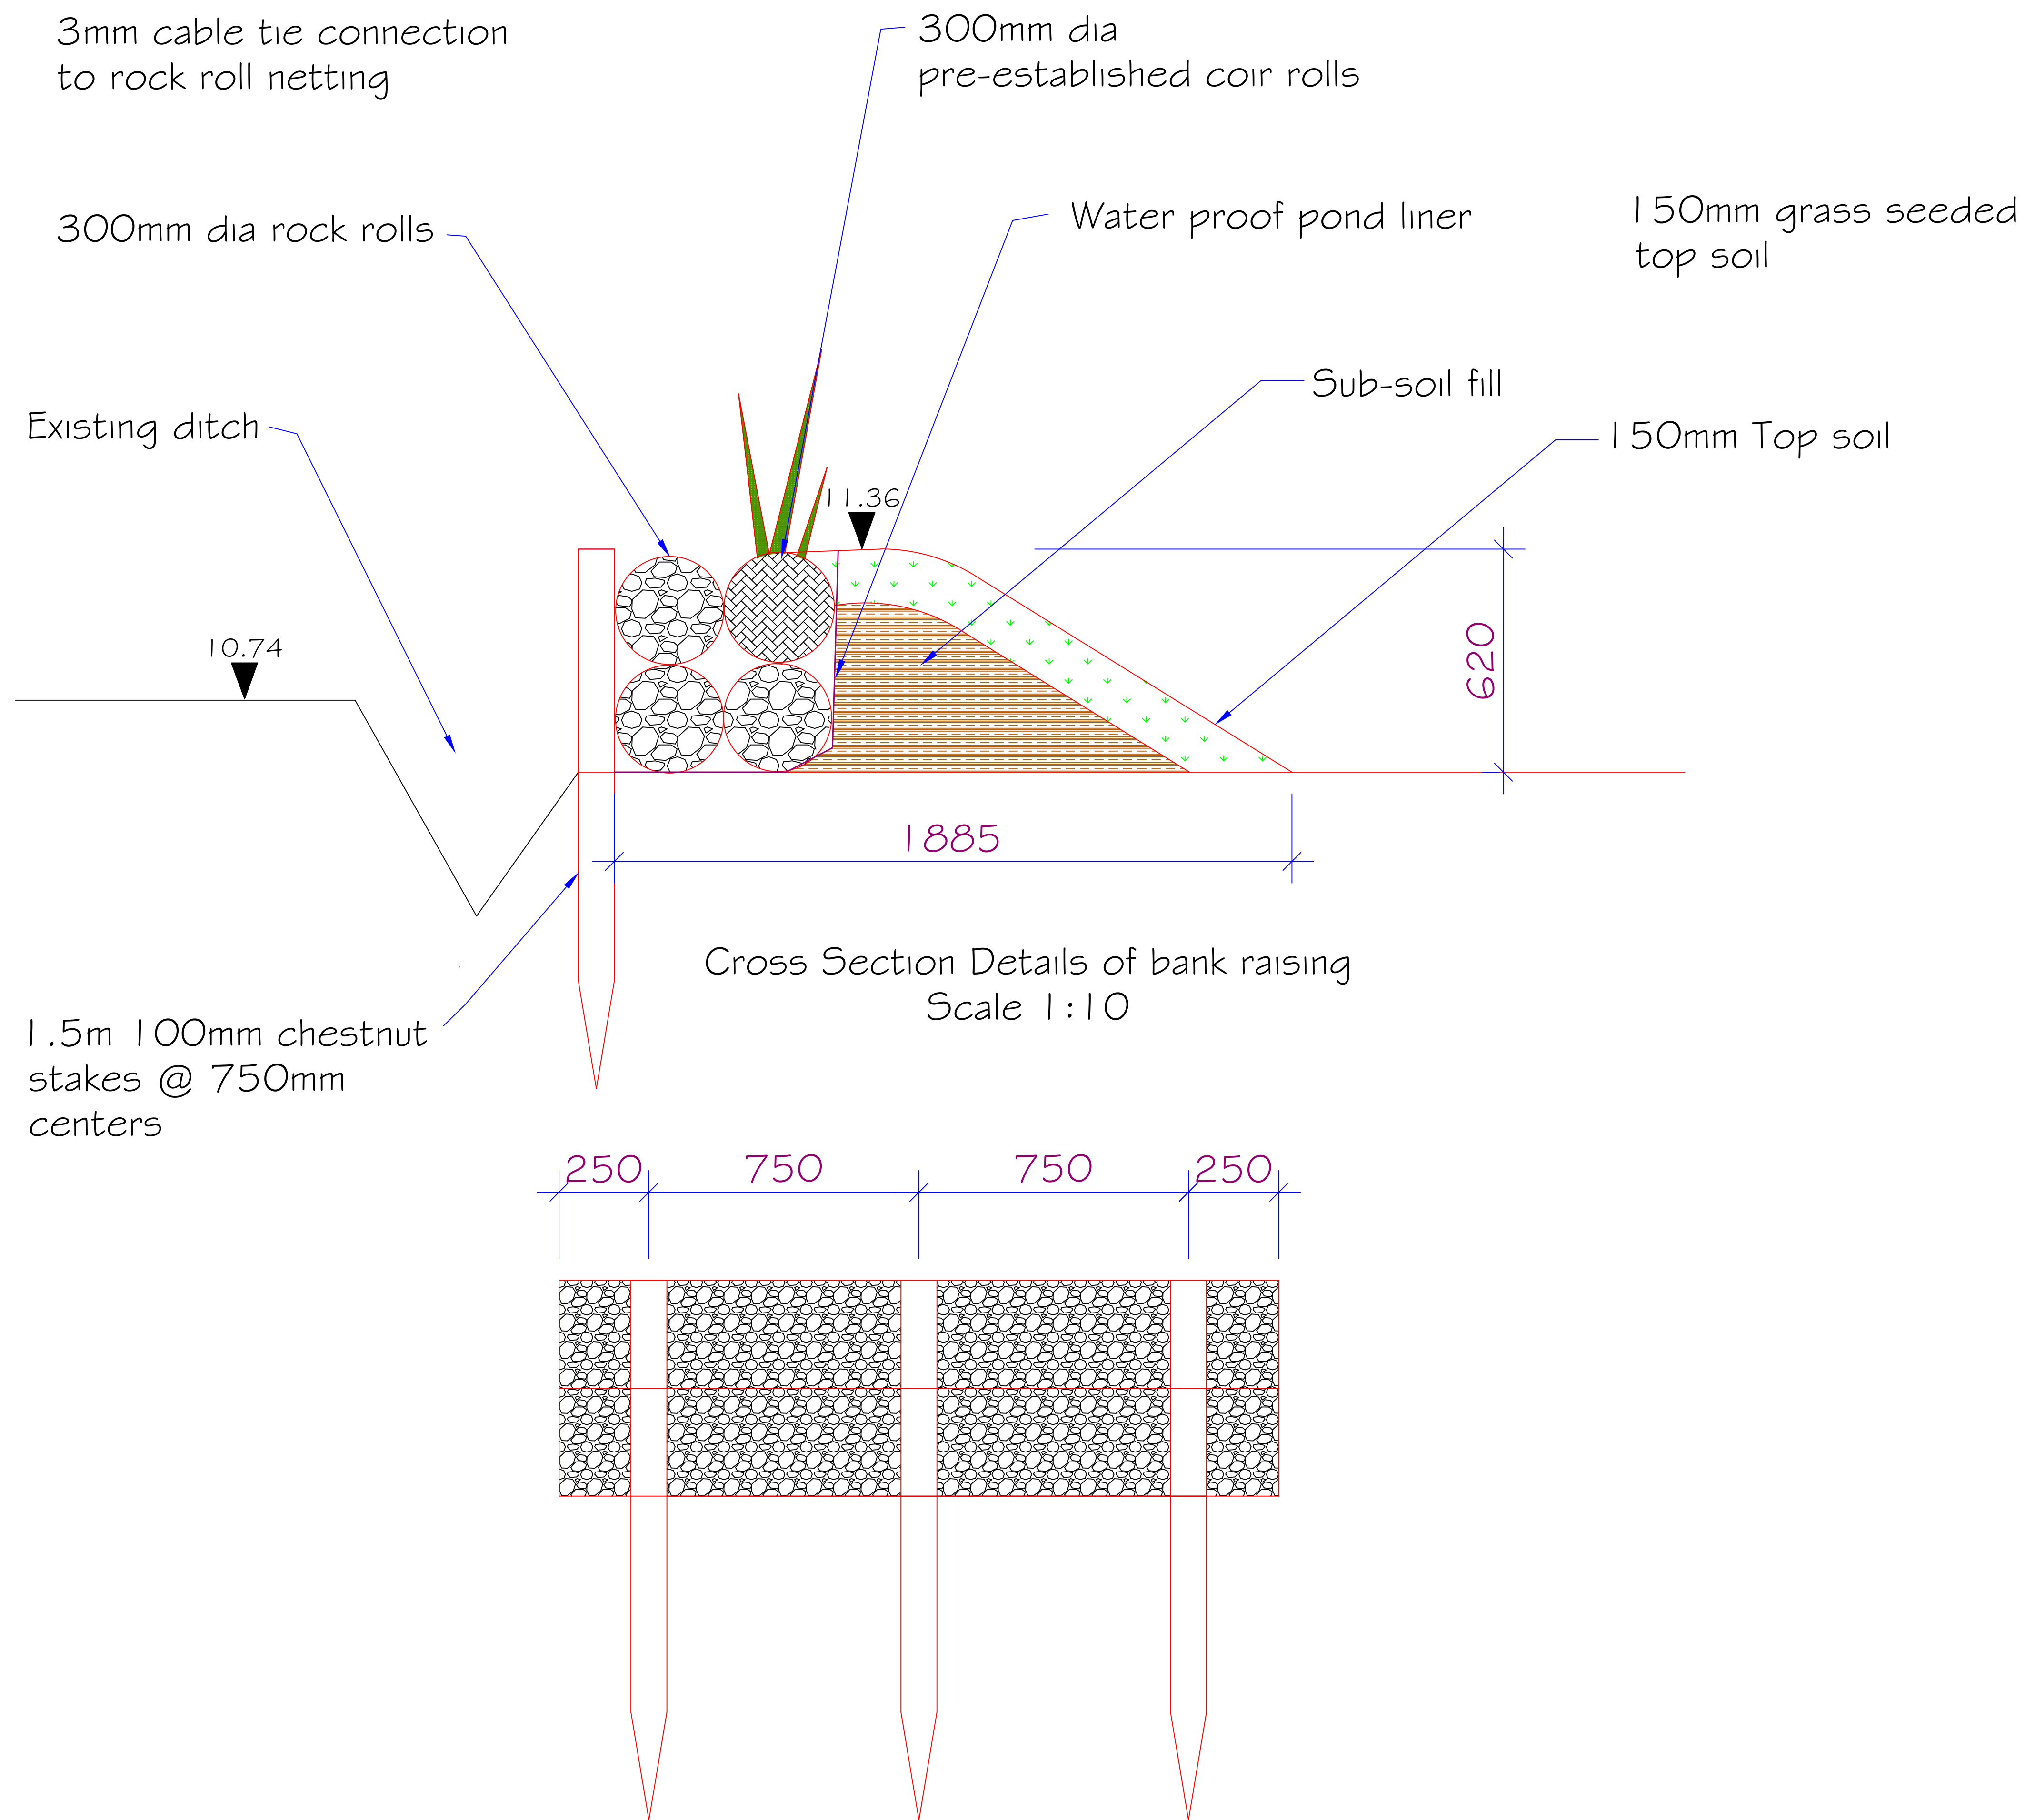

#### NOTES

- 1) All Dimensions in mm unless stated
- 2) All Dimensions to be checked on site
- 3) Nominal dimensions given for all timber sizes
- 4) This drawing to be read in conjunction with MMD-340238-C-DR-00-XX-0010 Rev P3

#### SAFETY, HEALTH AND ENVIRONMENTAL INFORMATION

IN ADDITION TO THE HAZARDS/RISKS NORMALLY ASSOCIATED WITH THE TYPES OF WORK DETAILS ON THIS DRAWING, NOTE THE FOLLOWING SIGNIFICANT RESIDUAL RISKS

#### CONSTRUCTION

1. Working in close proximity to the public.
2. Pollution of watercourse from concreting activities
3. Site susceptible to sudden rise in water level.

| Rev | Description | By |
|-----|-------------|----|
| Rev | Description | By |
| Rev | Description | By |



Asset Performance East Hants and Chichester  
Canal Walk Romsey (SO51 7LP)  
Hampshire

Tel: 01794832753

Fax:

**PROJECT** Nore Farm Stream Flood Alleviation Scheme

**TITLE** Bank raising on eastern ditch

|          |            |            |                 |            |    |
|----------|------------|------------|-----------------|------------|----|
| Scale    | As shown   | Date       | 31/07/2015      | Sheet size | A1 |
| Drawn by | Asad Abbas | Checked by | Richard Rowland |            |    |

**Drg. No.** EA-35455-AA-0015 *AS BUILT*