



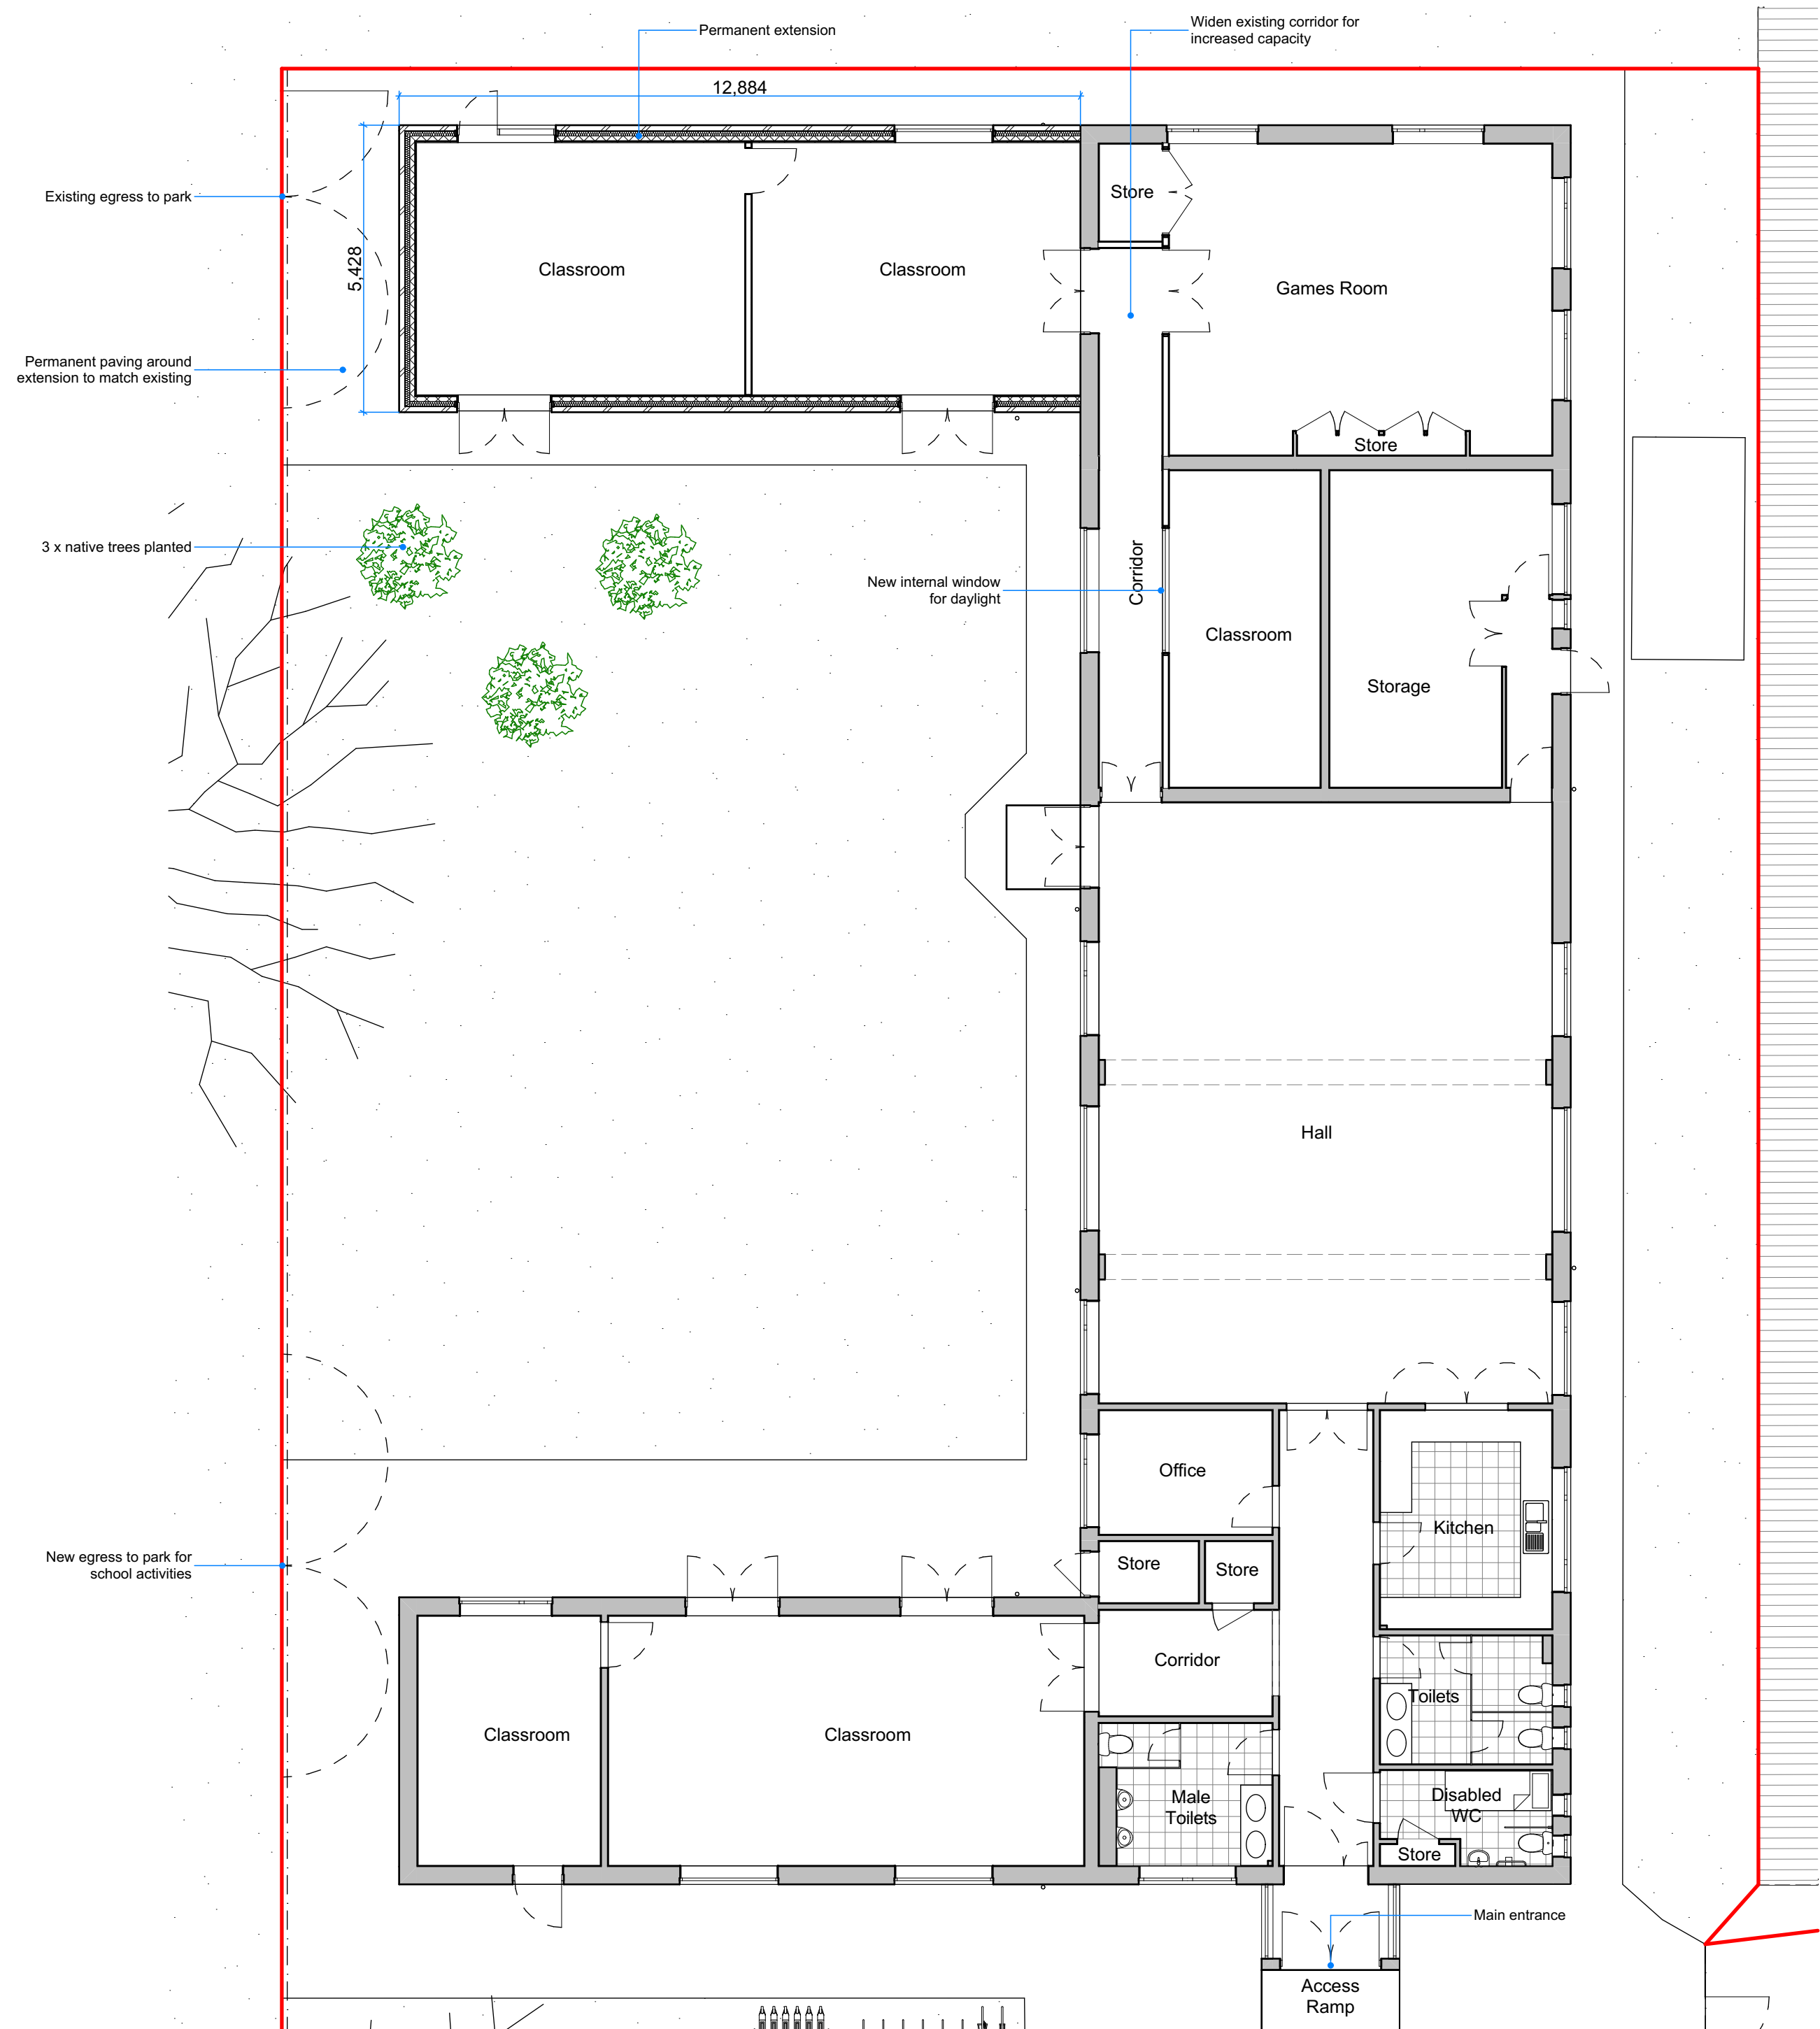


Proposed Ground Floor Plan

1:100

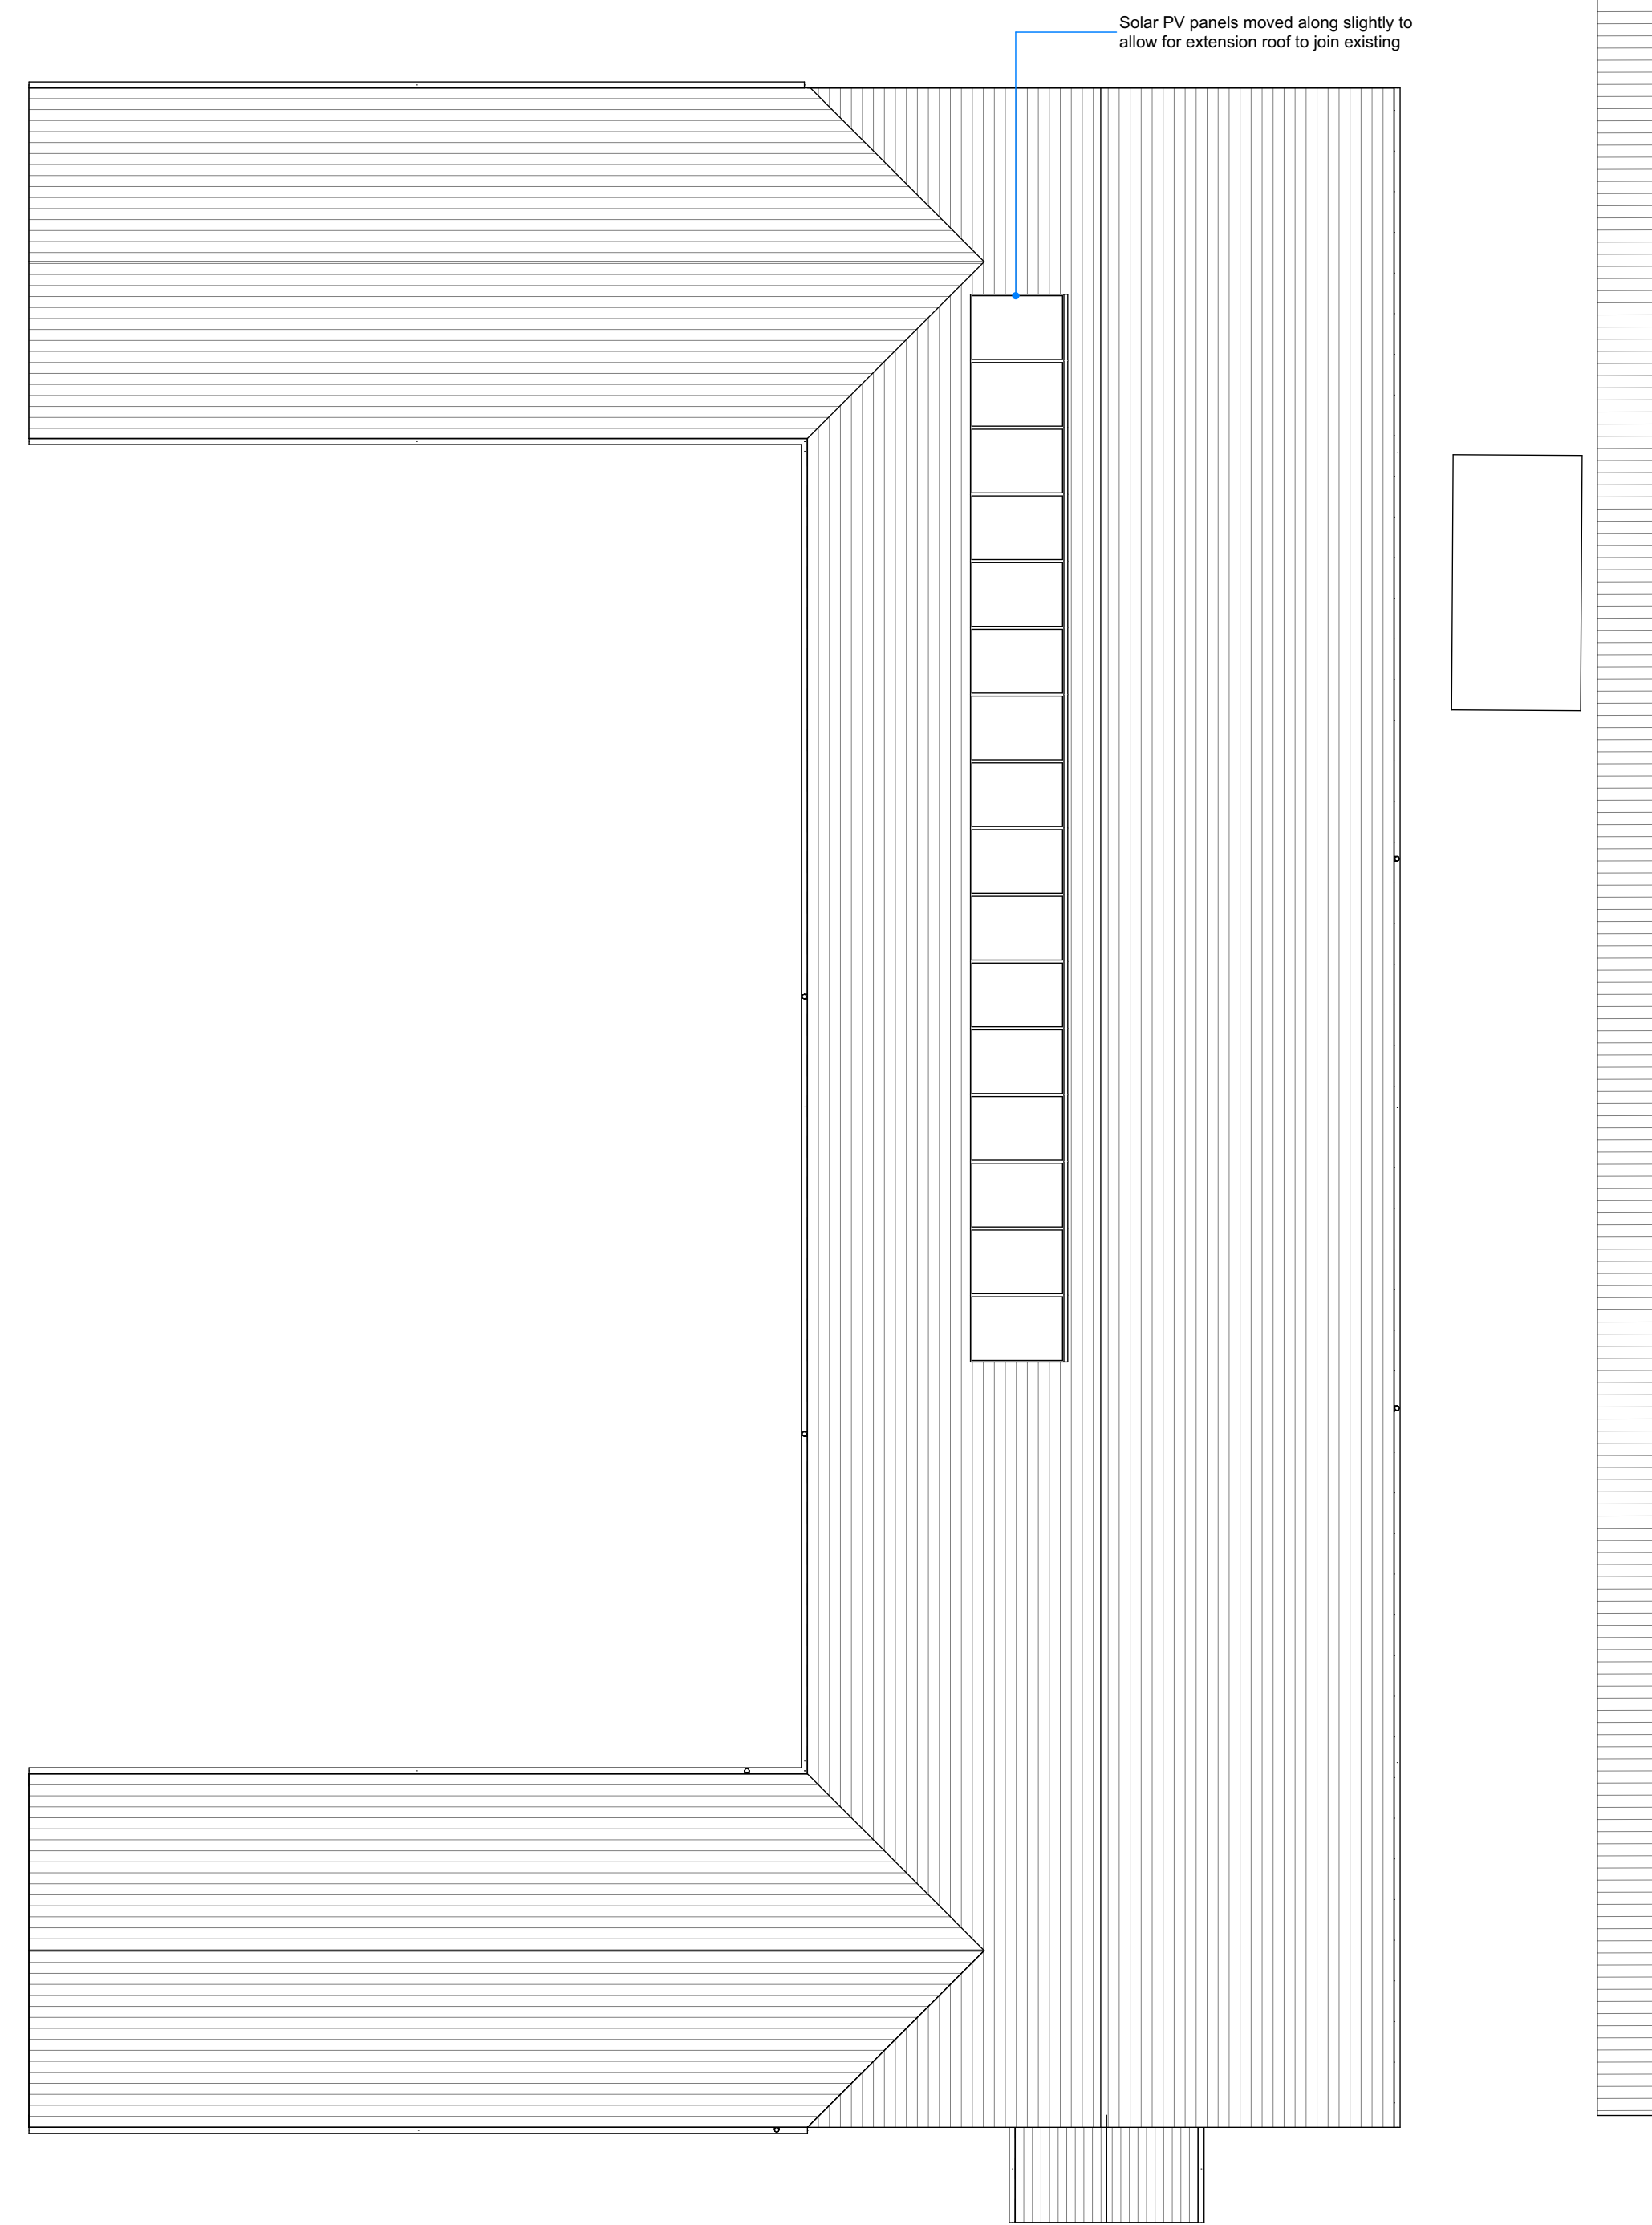


Proposed Roof Plan

1:100

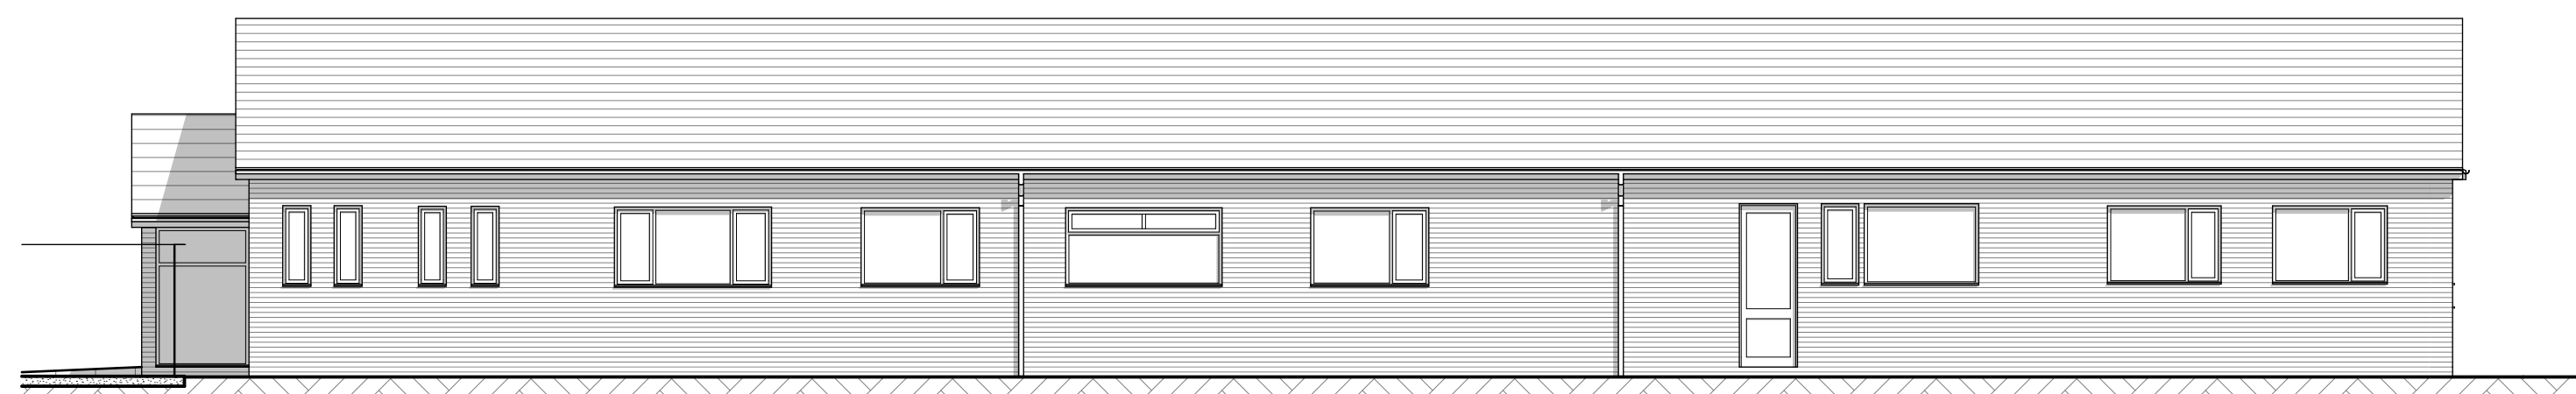


Proposed North West Elevation

1:100

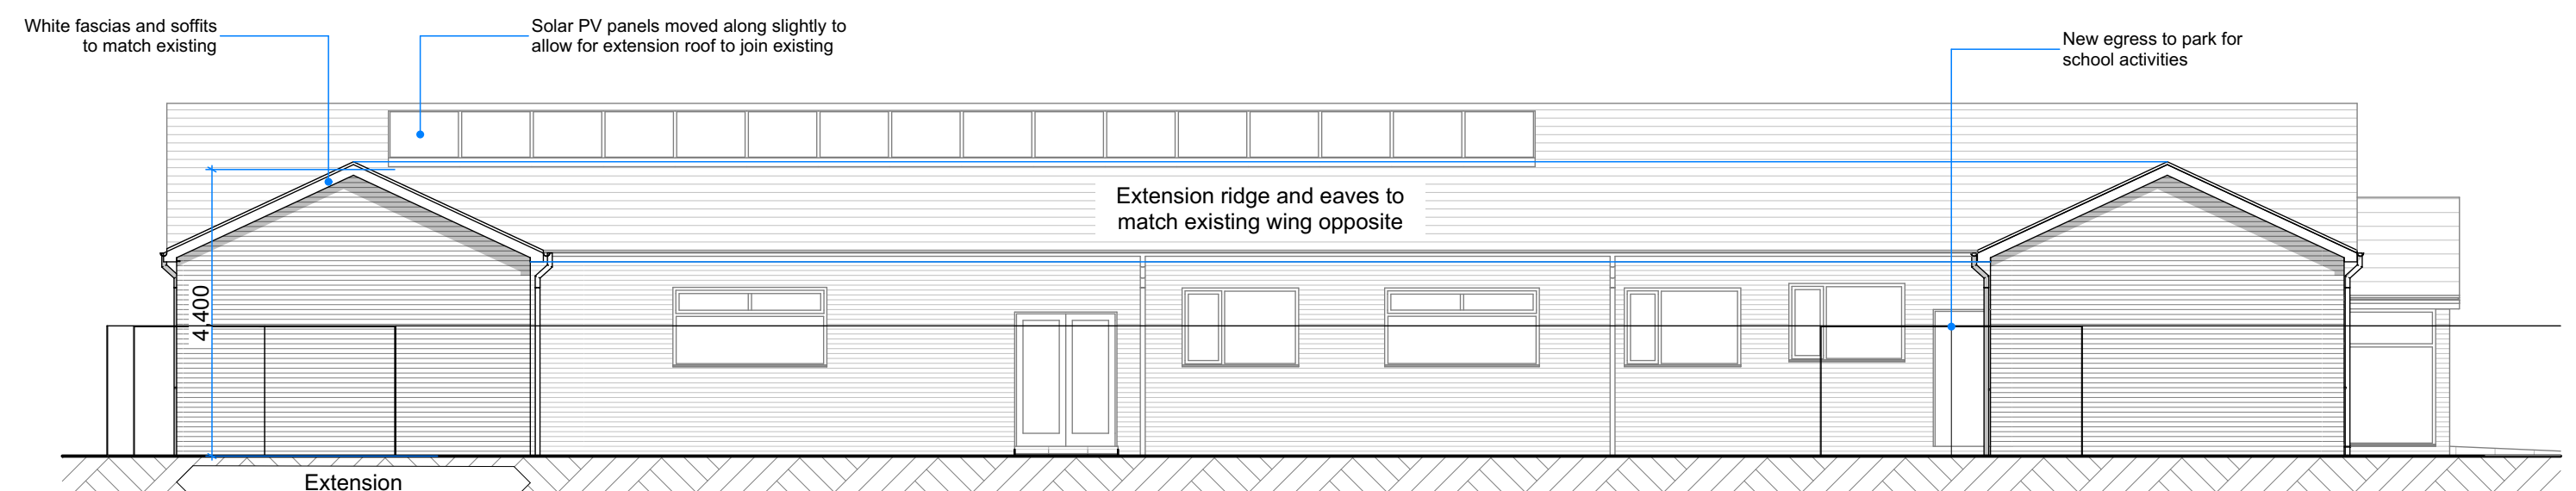


Proposed South East Elevation

1:100

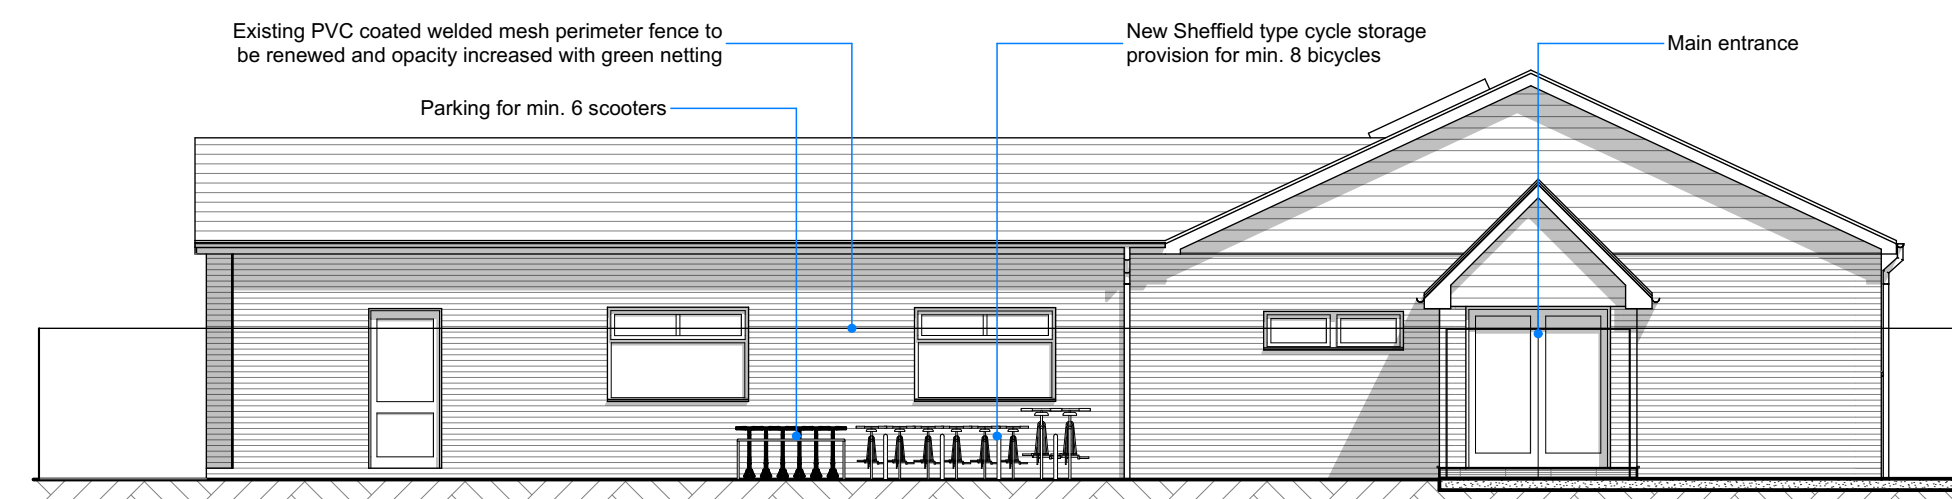

Proposed North East Elevation


1:100

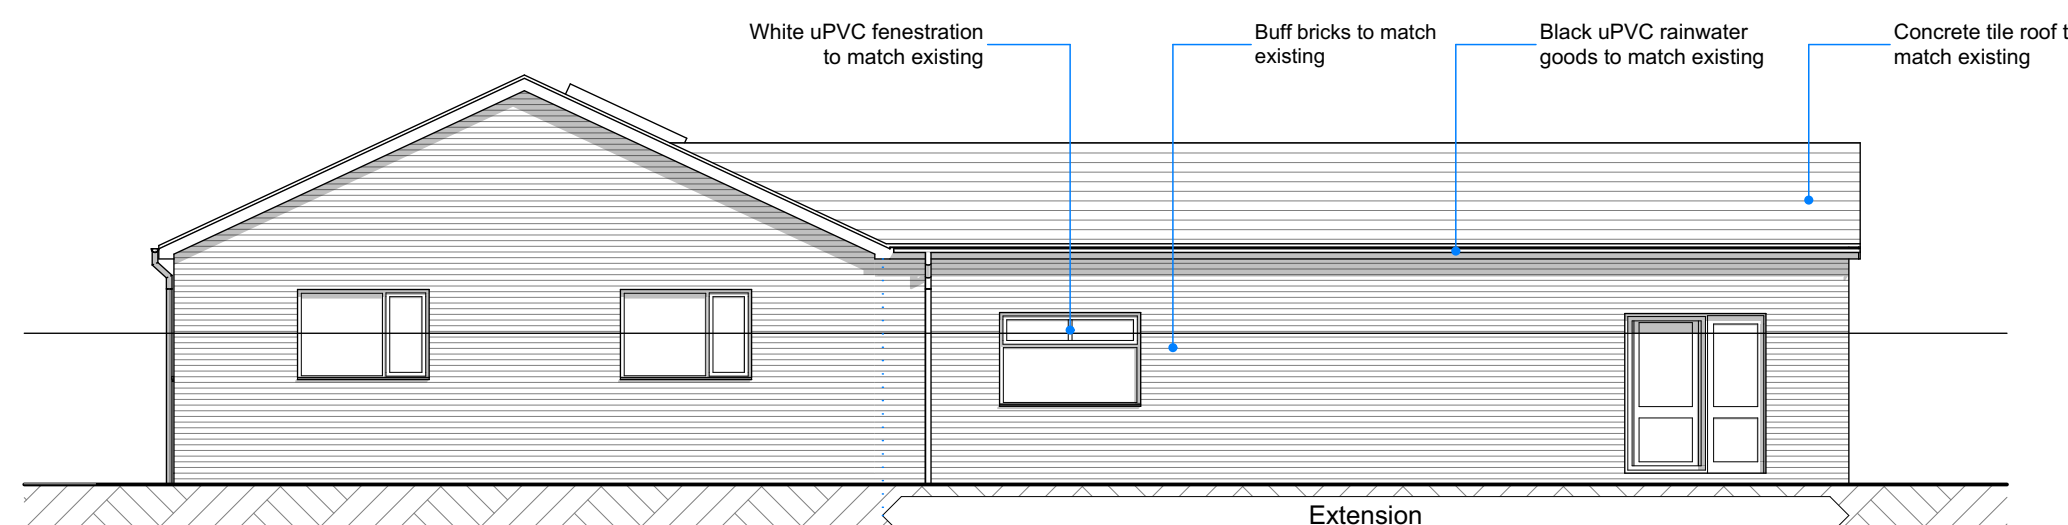

Proposed South West Elevation

1:100




© GRKA 2025
NOT TO BE SCALED. DIMENSIONS TO BE CHECKED ON SITE SCALING
FOR LOCAL AUTHORITY PURPOSES ONLY.

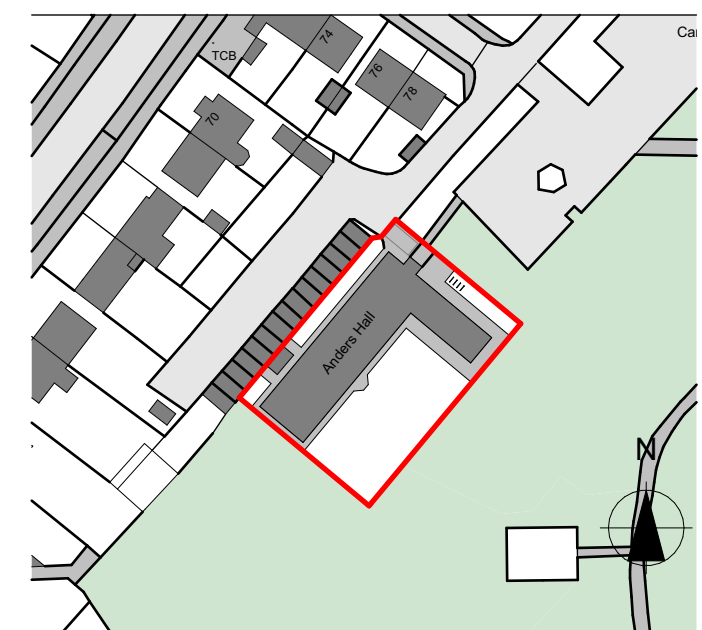

Location Plan

Scale 1:1250

Ordnance Survey (c) Crown Copyright 2025.
All rights reserved. Licence number 100022432

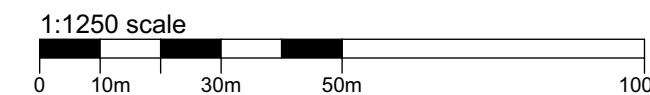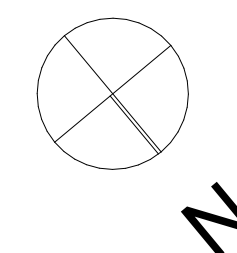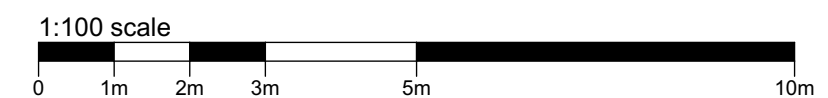

PLANNING APPROVAL

P3	New gate moved slightly, new redline	24.09.26	GM
P2	Bus Access Redline	30.06.26	GM
P1	Planning Issue	08.04.26	GM
Revision	Description	Date	Drawn

Designer :

GRKA
GRK Architecture
www.grka.co.uk

Project :

Growing Places, Waterloooville
Proposed Extension

Drawing :

Proposed Plans and Elevations

Date :

May 2026

Scale :

1:100 @ A1

Drawing No. :

25 / 421 / 102 PLANNING

Status :

PLANNING

Revision:

P3