


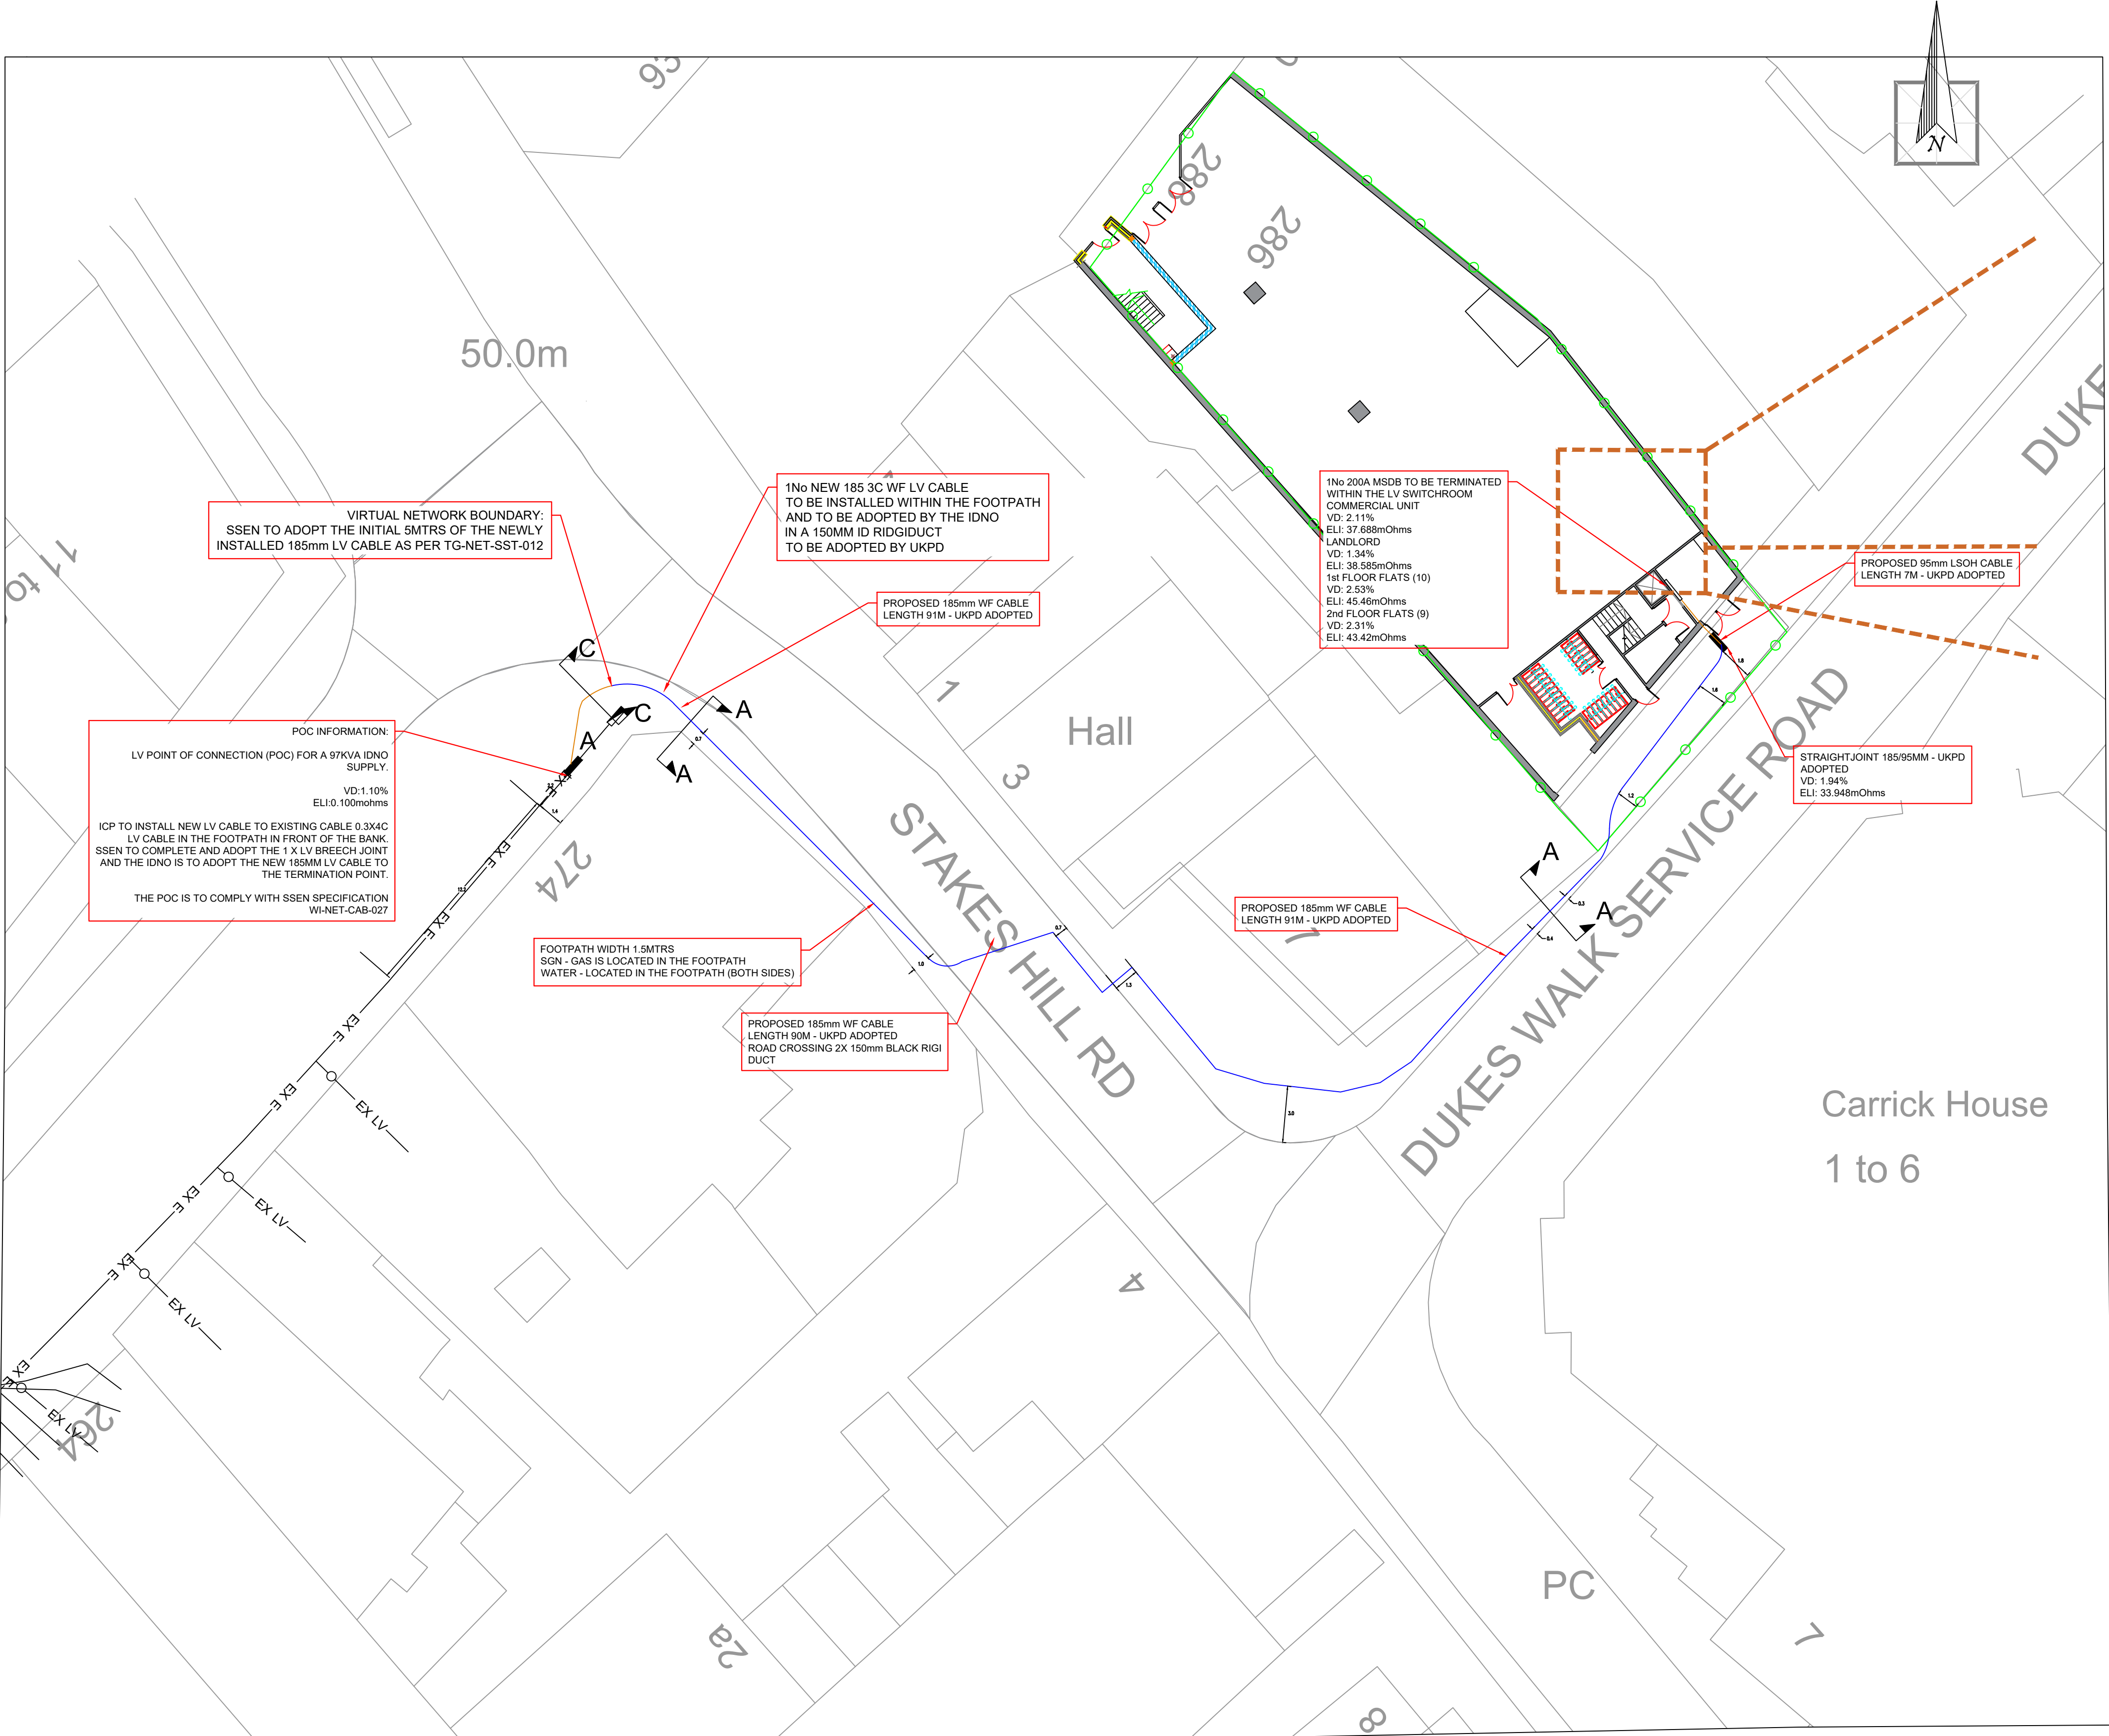

Legend/Key

- SITE BOUNDARY
- EX HV
- EX LV
- NEW HIGH VOLTAGE CABLES
- NEW LOW VOLTAGE CABLES
- NEW LOW VOLTAGE CABLES
- NEW LOW VOLTAGE CABLES
- 35mm² CNE SERVICE CABLES
- 25mm² CNE SERVICE CABLES
- LSOH SERVICE CABLE
- POINT OF CONNECTION, SERVICE BREECH AND POT END JOINT
- POT END JOINT
- 125mm BLACK DUCTING
- METER POSITIONS
- PHASE ALLOCATIONS
- EARTH NODE
- CABLE GENERAL ARRANGEMENT
- TEMPORARY BUILDING SUPPLY
- LANDLORD SUPPLY
- OTHER POINT LOAD (SEE LEADER FOR POINT OF LOAD INFORMATION)
- PROPOSED CULVERTED WATER COURSE

Network/Adopter Ref:	FAQ781 / 214243
Project:	PIV-3062 London Road
Address:	280-282 London Road, Waterlooville, Portsmouth, PO7 7DS
Title:	As-Laid
Date:	31/03/2025
Co-ordinate:	426423, 128556
Scale:	1:200@A1
Created By:	Megan Startup