


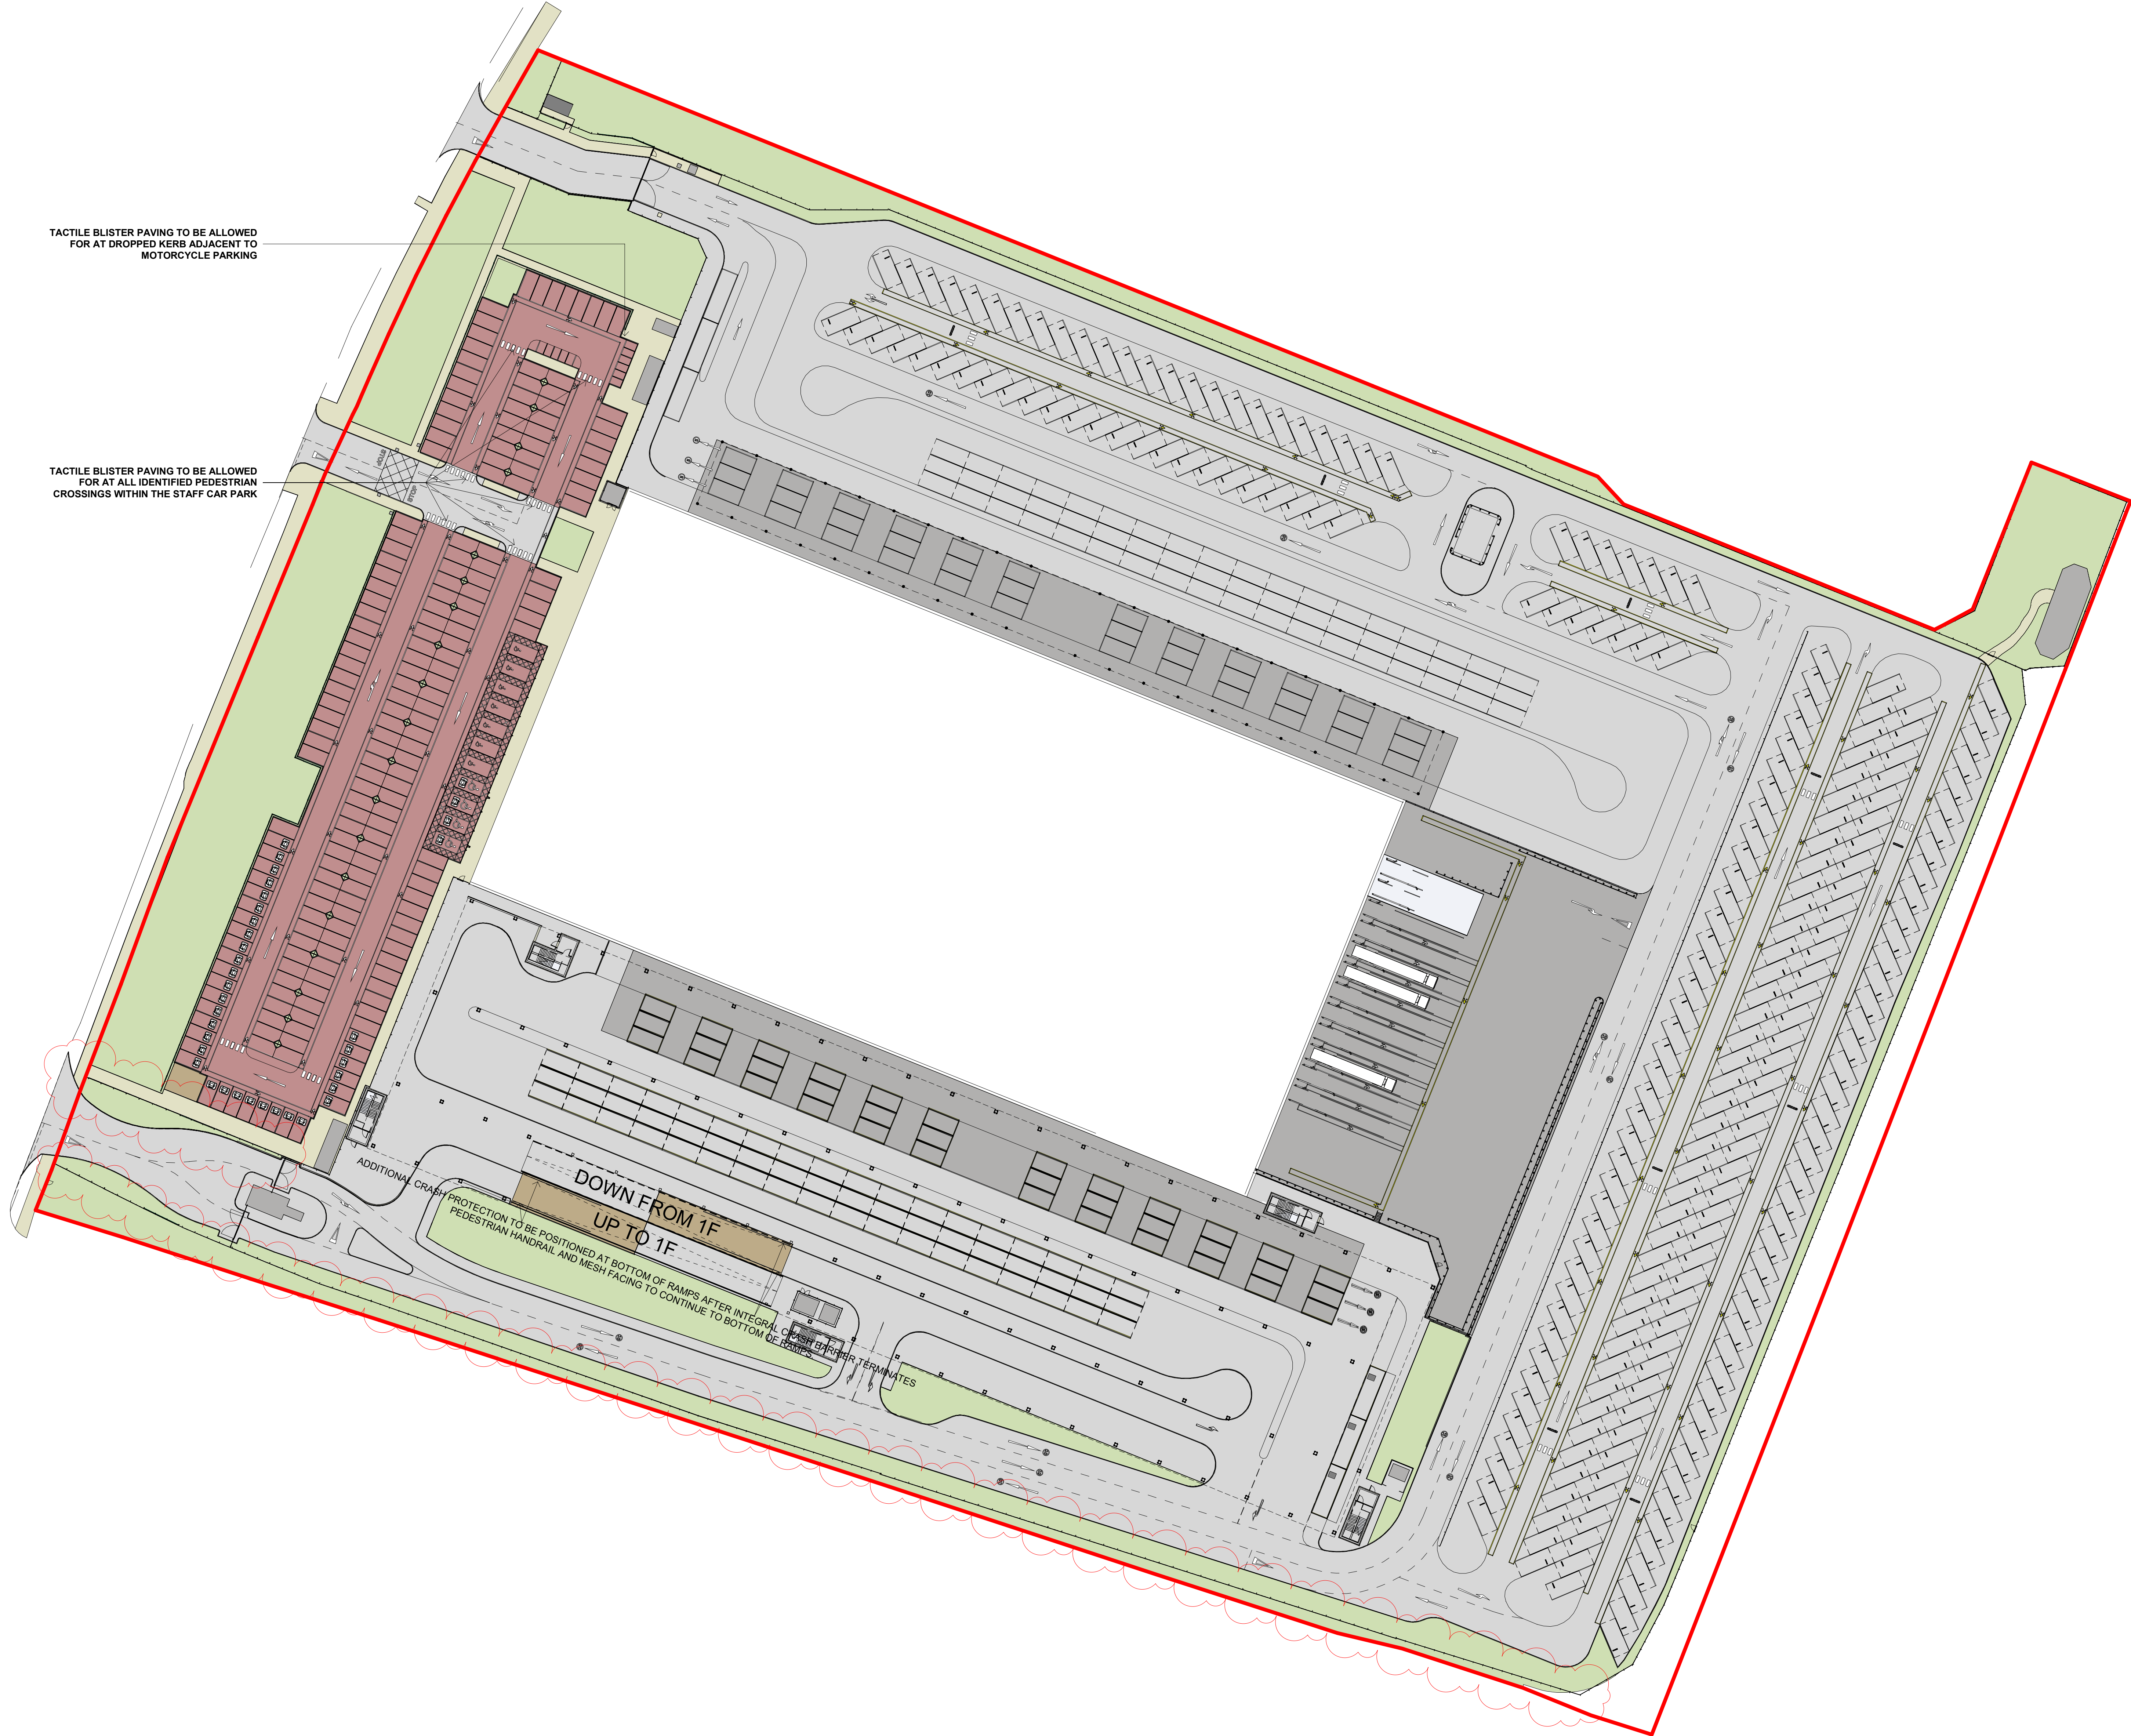

TACTILE PAVING


PEDESTRIAN CROSSINGS



Do not scale this drawing.
Architects are to be notified of any discrepancies.
Contractors must check all dimensions on site.
This drawing is subject to copyright laws and is to be used only for the information as stated only.
For other information refer to the latest version of any cited referenced drawings.
To be read in conjunction with relevant design standards/protocols.

This is a colour drawing. In order to ensure any subsequent reproduction is viewed correctly it should be printed in full colour.

0 5 10 15 20 25
SCALE 1:500
m

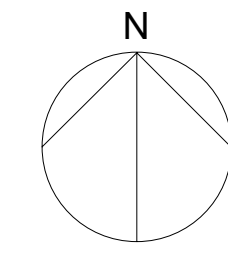

SITE MATERIALS KEY	
	TARMAC
	CONCRETE
	ASPHALT FOOTPATHS
	EXISTING SOFT LANDSCAPING
	PROPOSED SOFT LANDSCAPING
	POROUS BLOCK PAVING
	GRAVEL BED
	TACTILE PAVING

C10	SOUTHERN FENCE REALIGNED, NORTHERN VERGE OF ACCESS 1 CHANGED TO LANDSCAPING	14.12.22	MH	DW
C12	KERBS REMOVED FROM SOUTHERN BLAND N SA FENCE REALIGNED TO SOUTH WEST CORNER OF WAREHOUSE AND TO GAS BOLLER HOUSE. KERB REALIGNED IN SOUTHERN WAT	16.11.22	MH	DW
C11	FENCE LINE UPDATED TO AVOID GAS BOLLER HOUSE. WIND BAR ADDED TO INCLUDE PARKING CANOPY POSITION ADJUSTED TO	07.11.22	MH	DW
C9	ALLOW FOR FUTURE TONGS SINGLE EXTENTS INDICATED TO BASE LAYOUT UPDATED. ADDITIONAL LINDS WORK NOTED TO HEIGHT RESTRICTION AND DOCK DAYS IN LINE WITH TENANT DO AND CONTRACT DOCUMENTS. ENCLOSURES SET OUT TO SUBSTANTIATIONS	21.10.22	DW	DW
C8	KERRING ADJUSTED WITH PRINALE EXTERNAL WORKS DESIGN. PARKING UPDATES. STAGING AREA UPDATES	22.09.22	DW	CV
C7	HEIGHT RESTRICTION DETAILS CLARIFIED SURFACE DRAWINGS UPDATES TO BASE POSITIONS KERBS AND LINING IN SA CAR PARK UPDATED	21.09.22	CV	DW
C6	UPDATED TO REFLECT SITE LAYOUT. DESIGN DEVELOPMENT ADJUSTED TO BETTER ACCOMMODATE POTENTIAL FUTURE SUBSTATION LOCATION	12.07.22	DW	DW
C5	SMOKING SHELTER POSITION ADJUSTED TO BETTER ACCOMMODATE POTENTIAL FUTURE SUBSTATION LOCATION	12.07.22	DW	DW
C4	FENCE LINE ADJUSTED FOLLOWING TSL COMMENTS	07.07.22	DW	DW
C3	WHITE BLOCK TOP PAVERS REMOVED	30.06.22	MH	DW
C2	KERRING TWEAKED	29.06.22	DW	DW
C1	CONSTRUCTION ISSUE	01.04.22	CV	DW
P9	TACTILE PAVING REQUIREMENT NOTED	01.03.22	DW	DW
P7	GRAVEL BED ADDED TO TRANSFORMED LOCATION	03.02.22	DW	DW
P6	EXISTING FENCING TO BE DETACHED AS SHOWN TO SITE ADJUSTED AND PATH PROVIDED AS SHOWN	02.02.22	DW	DW
P5	BLOCK PAVING UPDATES TO SUIT DRAINAGE PROPOSAL	15.12.21	DW	CV
P4	FENCE LINE UPDATED	17.11.21	CV	DW
P3	DRAINAGE UPDATES FOLLOWING INTERNAL REVIEW COMMENTS AND MEETING NOTES 30.07.21	30.07.21	CV	DW
P2	UPDATES TO SOUTHERN BOLLER HOUSE AND SURROUNDING KERBS & FINISHES	23.07.21	DW	RK
P1	UPDATED TO CAPTURE MINOR SITE DESIGN DEVELOPMENT FIRST ISSUE	16.07.21	DW	PW
P0	STATUS	02.07.21	DW	DW

CONSTRUCTION

SMR
SMALLEY MARSEY RISPIN

ARCHITECTS
Floor 2, The Exchange, Station Parade, Harrogate, HG1 1TS
01423 707 757 admin@smrarchitects.co.uk

Project
HAVANT, NEW LANE

Client

Drawing Title
SITE WITH SURFACE FINISHES PLAN

Proj Ref Origin Zone Level Type Role Name Status Rev
DP01 - SMR - 01 - ZZ - DR - A - 3003 - S4 - C13

SMR Job Ref	Sheet	Scale	Notes	Drawn
7379-01-3003	A0	NOTED	DW	DW