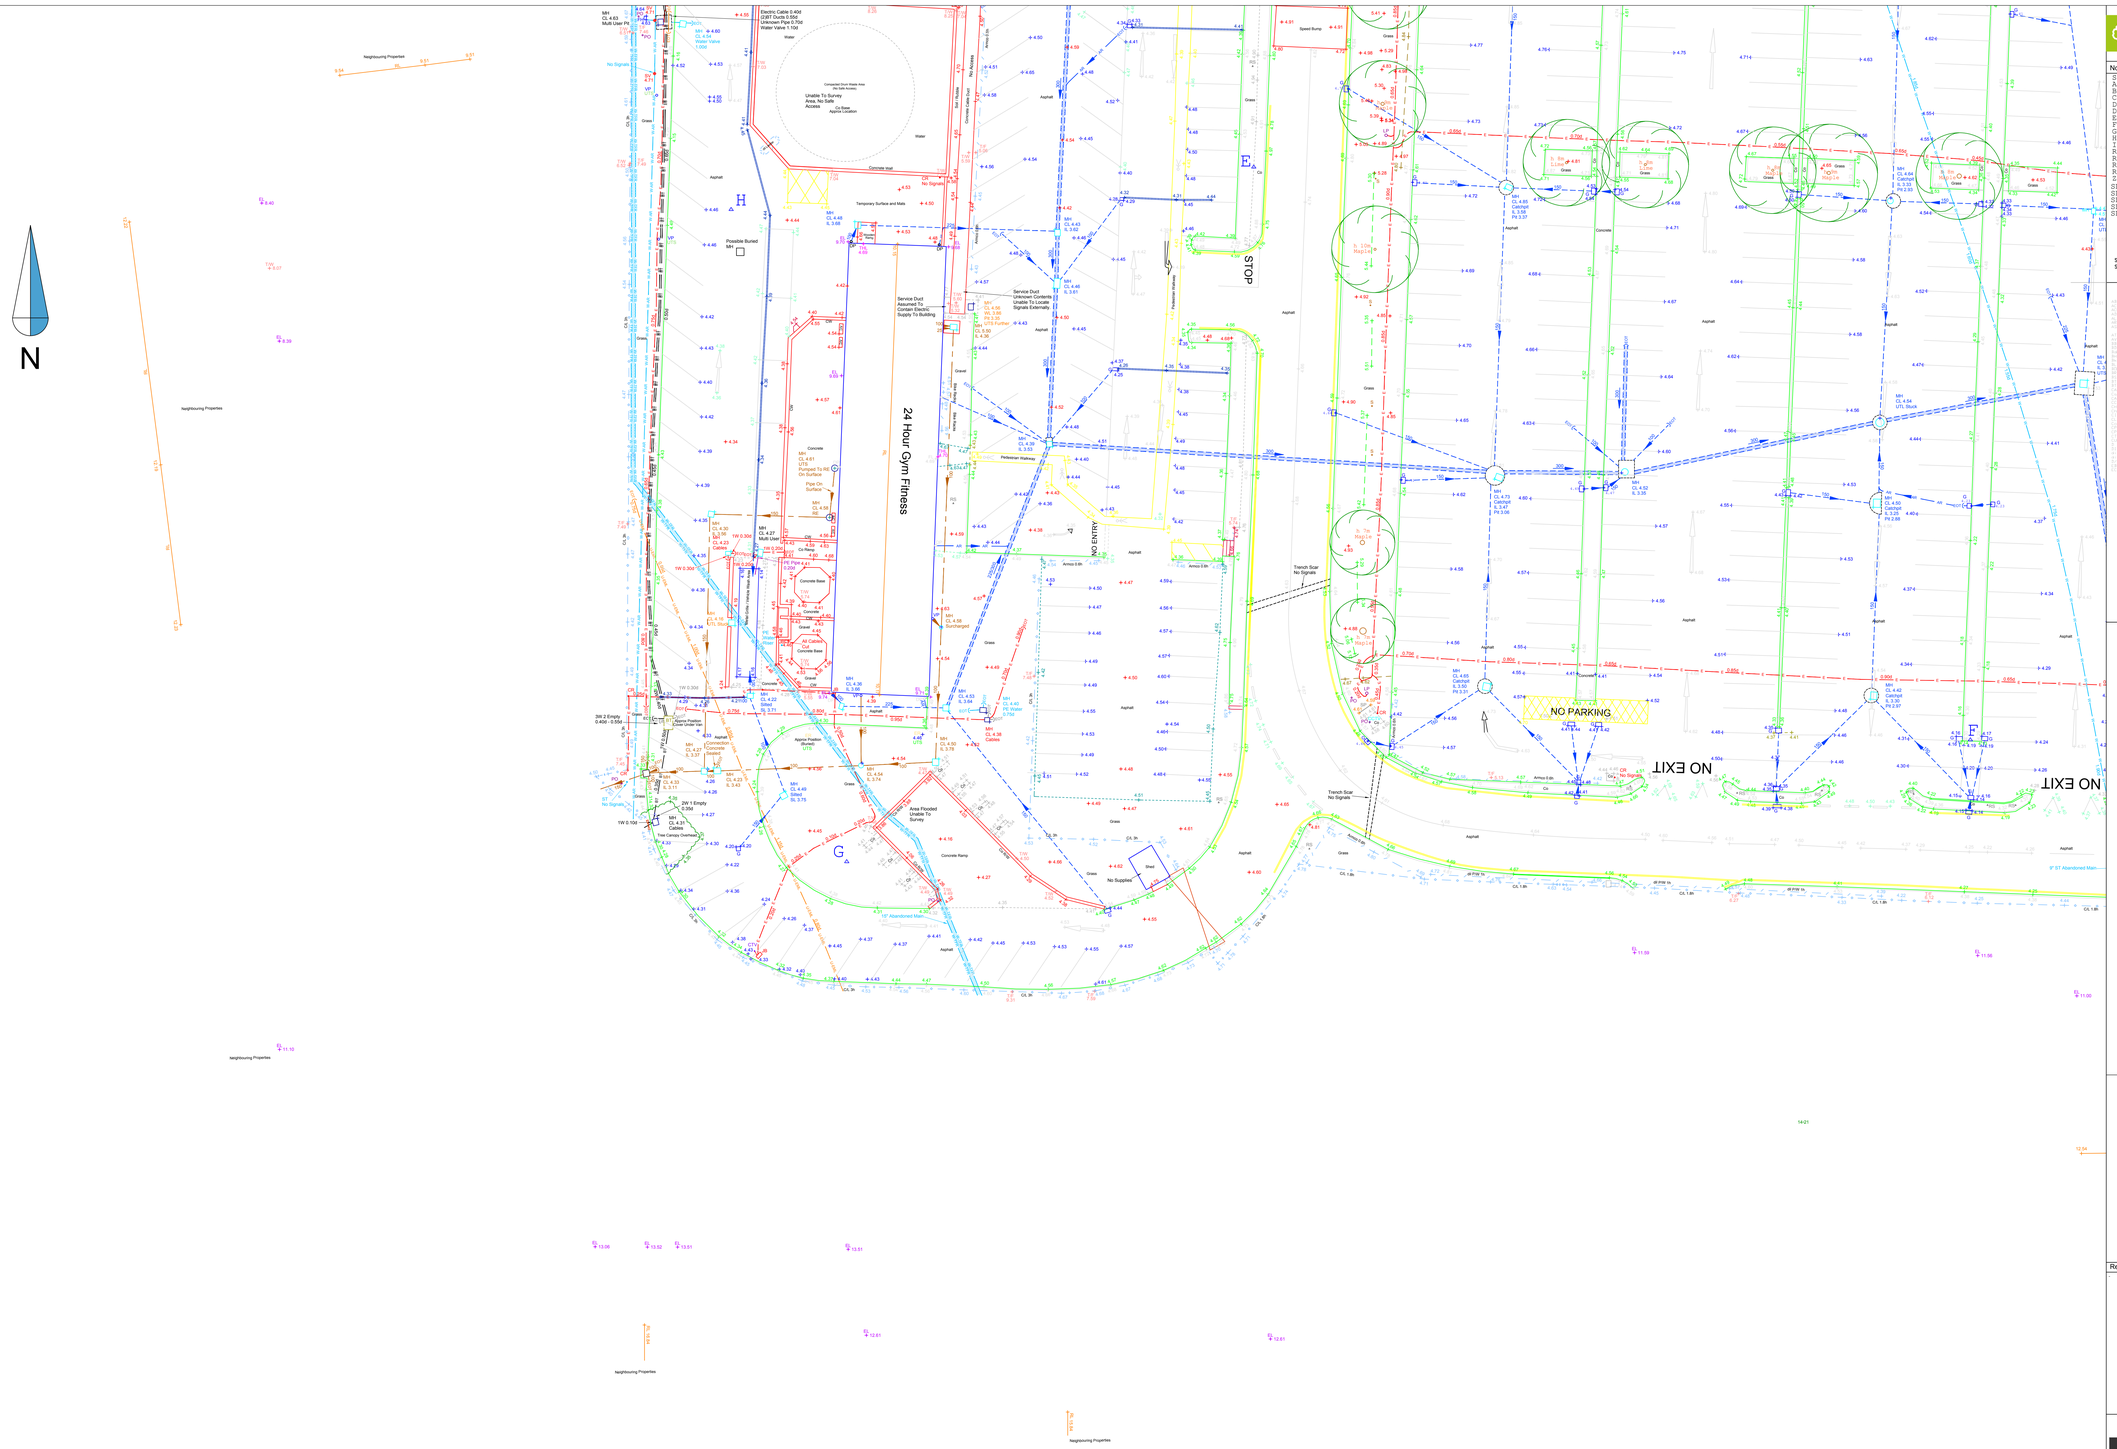

Notes :

Station	Easting	Northing	Level
A	471327.174	105618.327	5.139
B	471287.031	105621.157	5.047
C	471223.321	105623.643	4.907
D	471150.333	105638.388	5.041
DHL	471086.942	105613.662	4.603
E	471138.230	105558.475	4.859
F	471204.372	105505.594	4.301
G	471100.662	105494.346	4.442
H	471089.990	105554.522	4.446
I	471090.650	105580.715	4.591
RI1	471401.011	105657.802	7.633
RI2	471386.909	105675.284	7.584
RI4	471105.132	105819.519	5.133
RI5	471091.903	105809.524	5.373
Z	471338.290	105617.911	5.144
SEA	471441.101	105765.709	7.673
SEB	471500.619	105763.903	8.388
SEC	471416.131	105855.587	7.946
SECHL	471353.984	105867.887	5.373
SED	471516.282	105854.354	5.263

Stations A, B, C, D, DHL, E, F, H, I, Z, RI4, RI5 and SED are marked with a PK Nail.
Stations G, RI1, RI2, SEA, SEB, SEC and SECHL are marked with a Wooden stake.

ON DETAIL SURVEY






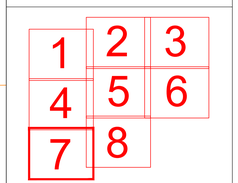

Rev:	Comments	By	Chkd	Date

SURVEYBASE
Surveying & BIM
www.surveybase.co.uk
Bath: 01225 314370 - London: 02039 066892

Langstone Technology Park,
Langstone Road, Havant, PO9 1SA

File Name:
Db4207-USP

Drawing Title :
Utilities Survey Of Langstone Technology Park
Sheet (7 of 8 A0)

Client:	Date
AWW	26/04/2019
	Scale
	A0 @ 1:200

Drawn by:	Checked by:	Project Code:	Revision:
db - AS	db - RI	Db4207-USP	---

Grid Orientation:	Site Level Datum
North GPS	OS GPS

0 3m 6m 9m 12m 15m 18m 21m 24m 27m 30m

All dimensions are to be checked on site where applicable.This drawing must not be scaled, and only written dimensions should be respected.

Tree species and sizes on this drawing are not guaranteed, and if critical should be verified by an arboriculturist. Tree spreads are average about the tree, and heights are approximate at the time of the survey.

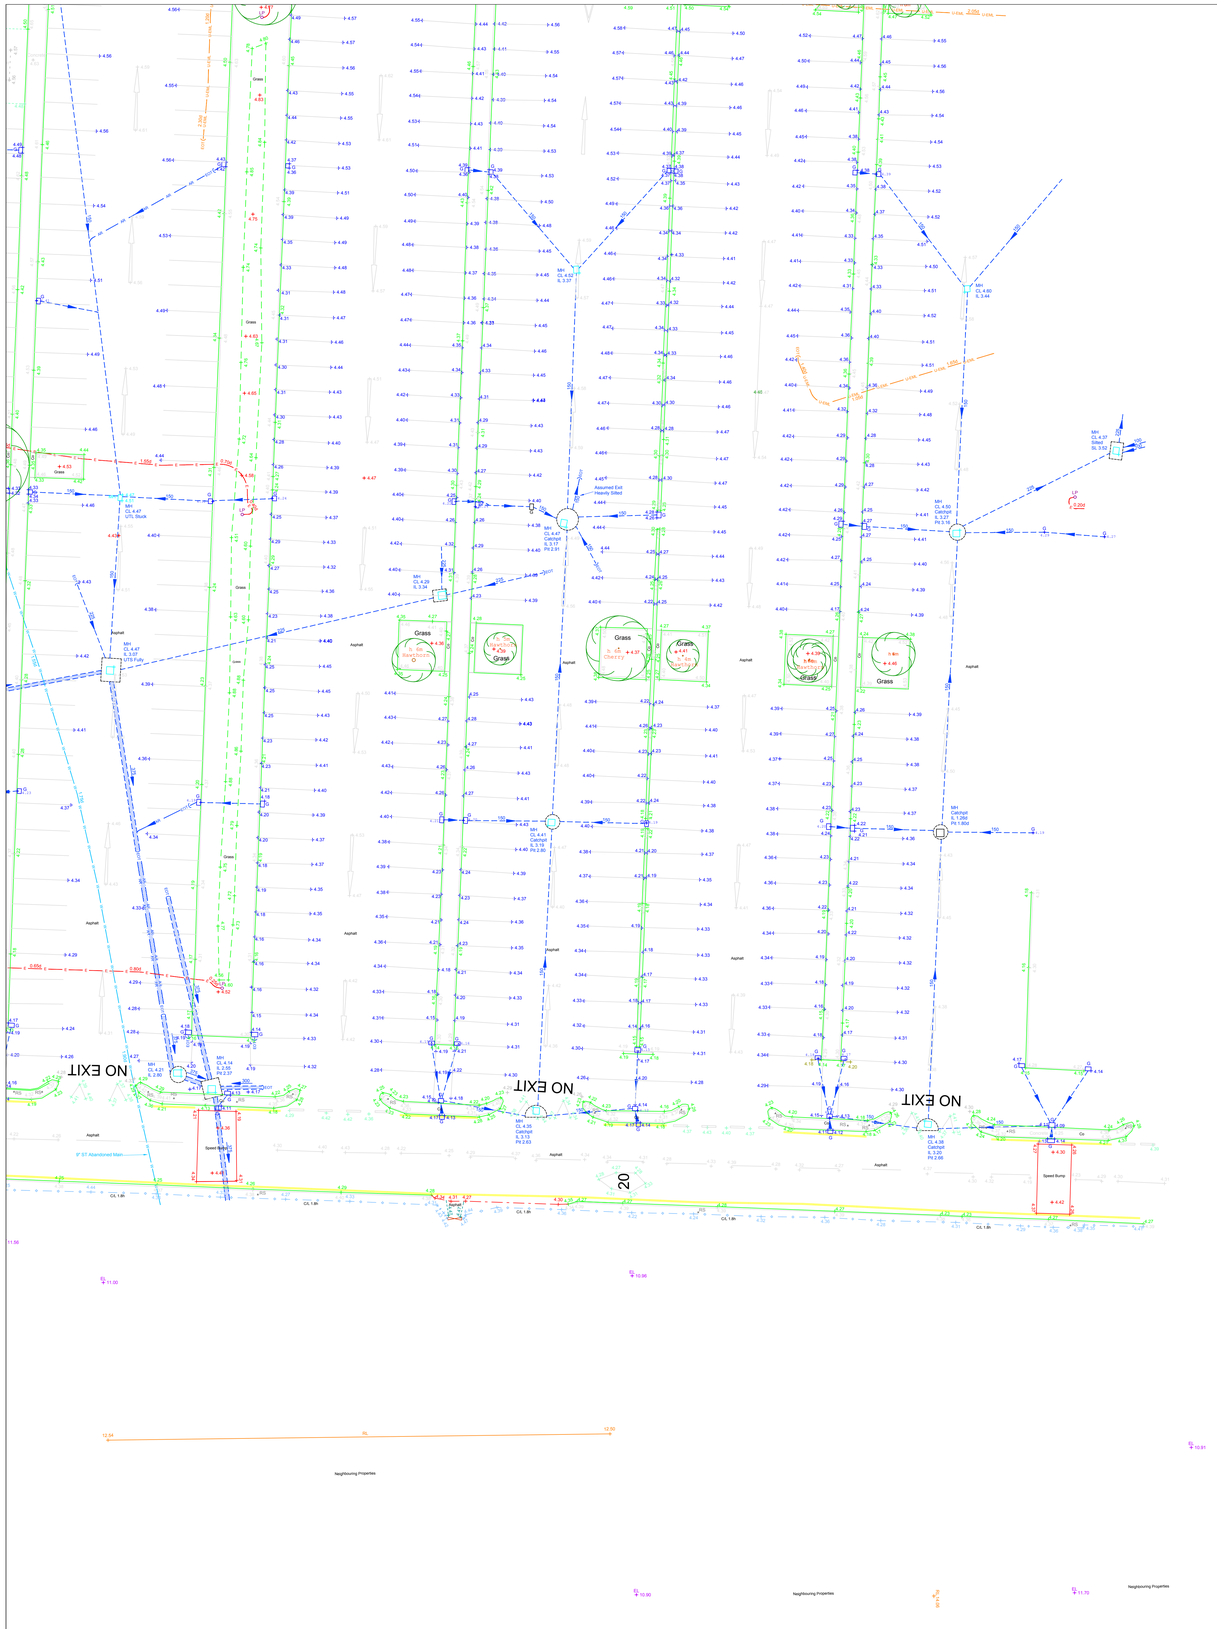

Gas	GAS
Water	W
Telephone	BT
Catv	CATV
CCTV	CCTV
Comms	COM
Fibre Optics	FO
Pipe	PIPE
Vents	V
Fuel	F
Offsets	O
Vapour Recovery	VR
Gauge Lines	G
Unidentified GPR	U.GPR
Unidentified EML	U.ERL
Taken From Records	E.TFR
Assumed Routes	GAS.AR
Empty Ducts	ED
Earth Rod	ER
Rising Main	RM
Overhead	OH
Heating Pipes	H
Traffic Signals	TS

Where chamber extents are significantly greater than the cover size, their approximate extents are shown thus;

ABBREVIATION KEY

AR	assumed route
BD	base bend
BD	backdrop
CP	cable pit
CL	cover level
DP	down pipe
DP	down pipe
EOT	end of trace
EP	electricity pole
FH	fire hydrant
GP	gas
GV	gate valve
HOR	head of run
HL	high level
IC	inspection chamber
IL	invert level
Jun	junction
PRV	pressure reducer
RE	rodding eye
RWP	rainwater pipe
SV	stop valve
SP	soil vent pipe
TP	trapped exit
TFR	taken from records
TP	telegraph pole
UTF	unable to find
UTL	unable to lift
UTS	unable to survey
UTT	unable to trace
VP	vent pipe
WM	water meter
WM	water meter
WO	wash out valve

UTILITY SURVEY NOTES

ELECTROMAGNETIC AND/OR GROUND PENETRATING RADAR TECHNIQUES HAVE BEEN USED TO LOCATE AND MAP UNDERGROUND UTILITIES AND FEATURES ON THIS DRAWING. ALL HAVE MADE EVERY ENDEAVOUR TO MAKE SURE THE INFORMATION SHOWN IS ACCURATE AND THE RESULTS FULLY REFLECT THE EVIDENCE AVAILABLE TO US. HOWEVER, THE RESULTS FROM THESE TYPES OF SURVEYS ARE NOT 100% RELIABLE AND SHOULD THE LOCATION AND DEPTH OF SERVICES/FEATURES BE OF PARTICULAR IMPORTANCE TO A PROJECT, THEN IT IS STRONGLY ADVISED THAT TRIAL EXCAVATIONS SHOULD BE UNDERTAKEN TO CONFIRM SURVEY RESULTS.

ALL HAVE USED ALL RECORD DRAWINGS THAT WERE AVAILABLE TO US BY THE CLIENT OR BY THE STATUTORY UTILITY PROVIDERS AT THE TIME OF THE SURVEY. ANY INFORMATION TAKEN FROM THESE DRAWINGS DE PIPE SIZES, DEPTHS, MATERIALS, ETC. IS ASSUMED TO BE ACCURATE AND WE ACCEPT NO RESPONSIBILITY FOR ANY INACCURACIES STEMMING FROM RECORDS (TFR). HISTORIC RECORD INFORMATION IS OFTEN INCOMPLETE/INACCURATE AND CANNOT BE RELIED UPON.

A SINGLE LINE INDICATING A UTILITY MAY INDICATE THE PRESENCE OF MULTIPLE SERVICES WITHIN CLOSE PROXIMITY TO EACH OTHER. WHERE A SINGLE LINE TYPE IS SHOWN WE RECOMMEND HAND DIGGING WITHIN 0.5m, TO EXPOSE HIDDEN SERVICES.

WHERE QUOTED, DEPTH INFORMATION OF UNDERGROUND SERVICES/FEATURES IS STATED, DEPTHS ARE GENERALLY WITHIN +/- 100 ACCURATE, BUT CANNOT BE GUARANTEED. ANY DEPTHS SHOWN ARE USUALLY TO THE TOP OF SERVICE/FEATURE. (EXCEPTIONS: SEWERS AND DRAINS ARE USUALLY TO INVERT (BASE OF DRAINAGE CHANNEL) UNLESS OTHERWISE STATED.)

AT ASS WE USE SKILLED STAFF AND MODERN CALIBRATED EQUIPMENT TO PERFORM OUR SURVEYS. HOWEVER, THE COMPLETENESS OF ANY UNDERGROUND SURVEY CANNOT BE 100% GUARANTEED AND WE CANNOT BE HELD RESPONSIBLE FOR ANY INACCURACIES BEYOND THOSE THAT COULD BE REASONABLY EXPECTED BY A COMPETENT COMPANY.

CONTRACTORS UTILISING OUR DRAWINGS FOR INTRUSIVE WORK SHOULD TAKE ALL REASONABLE MEASURES TO WORK SAFELY IN ACCORDANCE WITH HSG47 GUIDELINES "AVOIDING DANGER FROM UNDERGROUND SERVICES".

N

0 3m 6m 9m 12m 15m 18m 21m 24m 27m 30m

Notes :

Station	Easting	Northing	Level
A	471327.174	105618.327	5.139
B	471287.031	105621.157	5.047
C	471223.321	105623.643	4.507
D	471190.333	105638.388	5.041
DML	471086.942	105616.462	4.603
E	471138.230	105558.475	4.859
F	471204.372	105505.594	4.301
G	471100.662	105494.346	4.442
H	471089.990	105554.552	4.446
I	471090.650	105580.715	4.591
RI1	471401.011	105657.802	7.633
RI2	471386.909	105675.284	7.584
RI4	471105.132	105819.519	5.133
RI5	471091.903	105809.324	5.373
Z	471338.290	105617.911	5.144
SEA	471441.101	105765.709	7.673
SEB	471500.619	105763.903	8.388
SEC	471416.131	105855.587	7.946
SECHL	471353.954	105867.887	5.373
SED	471516.282	105854.354	5.263

Stations A, B, C, D, DML, E, F, H, I, Z, RI4, RI5 and SED are marked with a PK Nail.
Stations G, RI1, RI2, SEA, SEB, SEC and SECHL are marked with a Wooden stake.

ON DETAIL SURVEY


ON FENCES/RAILS/DIVIDERS

FA	Barbed Wire Fence	FW	Post and Rail Fence
FB	Brick Wall Fence	FX	Post and Wire Fence
FC	Concrete Fence	FY	Post Fence
FD	Corrugated Iron Fence	FZ	Steel Railings
FE	Electric Fence	GA	Gate Fence
FF	Feather Board Fence	GB	Gate Post
FG	Fence	GC	Gate Post Concrete
FH	Fence Hedge	GD	Gate Post Wood
FI	Fence Iron	GE	Gate Post Brick
FJ	Fence Post	GF	Gate Post Metal
FK	Fence Post Concrete	GG	Gate Post Stone
FL	Fence Post Wood	GH	Gate Post Railway Sleeper

ON BUILDINGS


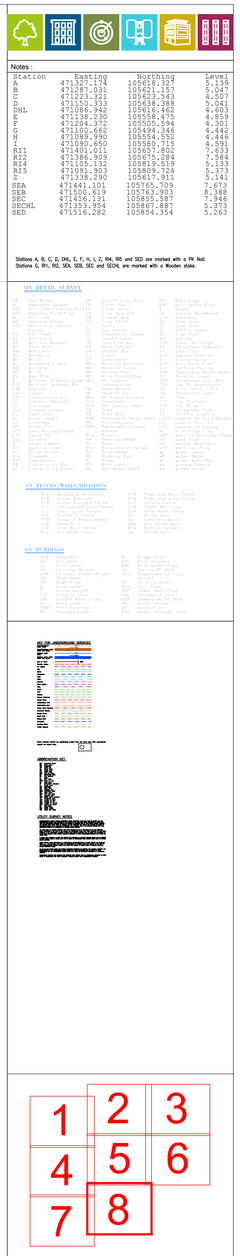

Rev:	Comments	By	Chkd	Date
-	-			-

SURVEYBASE
Surveying & BIM
www.surveybase.co.uk
Bath: 01225 314370 - London: 02039 066892

Langstone Technology Park,
Langstone Road, Havant, PO9 1SA

File Name:
Db4207-USP

Drawing Title :
Utilities Survey Of Langstone Technology Park
Sheet (8 of 8 A0)

Client:
AWW

Date
26/04/2019

Scale
A0 @ 1:200

Drawn by:	Checked by:	Project Code:	Revision:
db - AS	db - RI	Db4207-USP	---

Grid Orientation:	Site Level Datum
North GPS	OS GPS

All dimensions are to be checked on site where applicable.This drawing must not be scaled, and only written dimensions should be respected.

Tree species and sizes on this drawing are not guaranteed, and if critical should be verified by an arboriculturist. Tree spreads are average about the bole, and heights are approximate at the time of the survey.

APPENDIX C

Existing Drainage

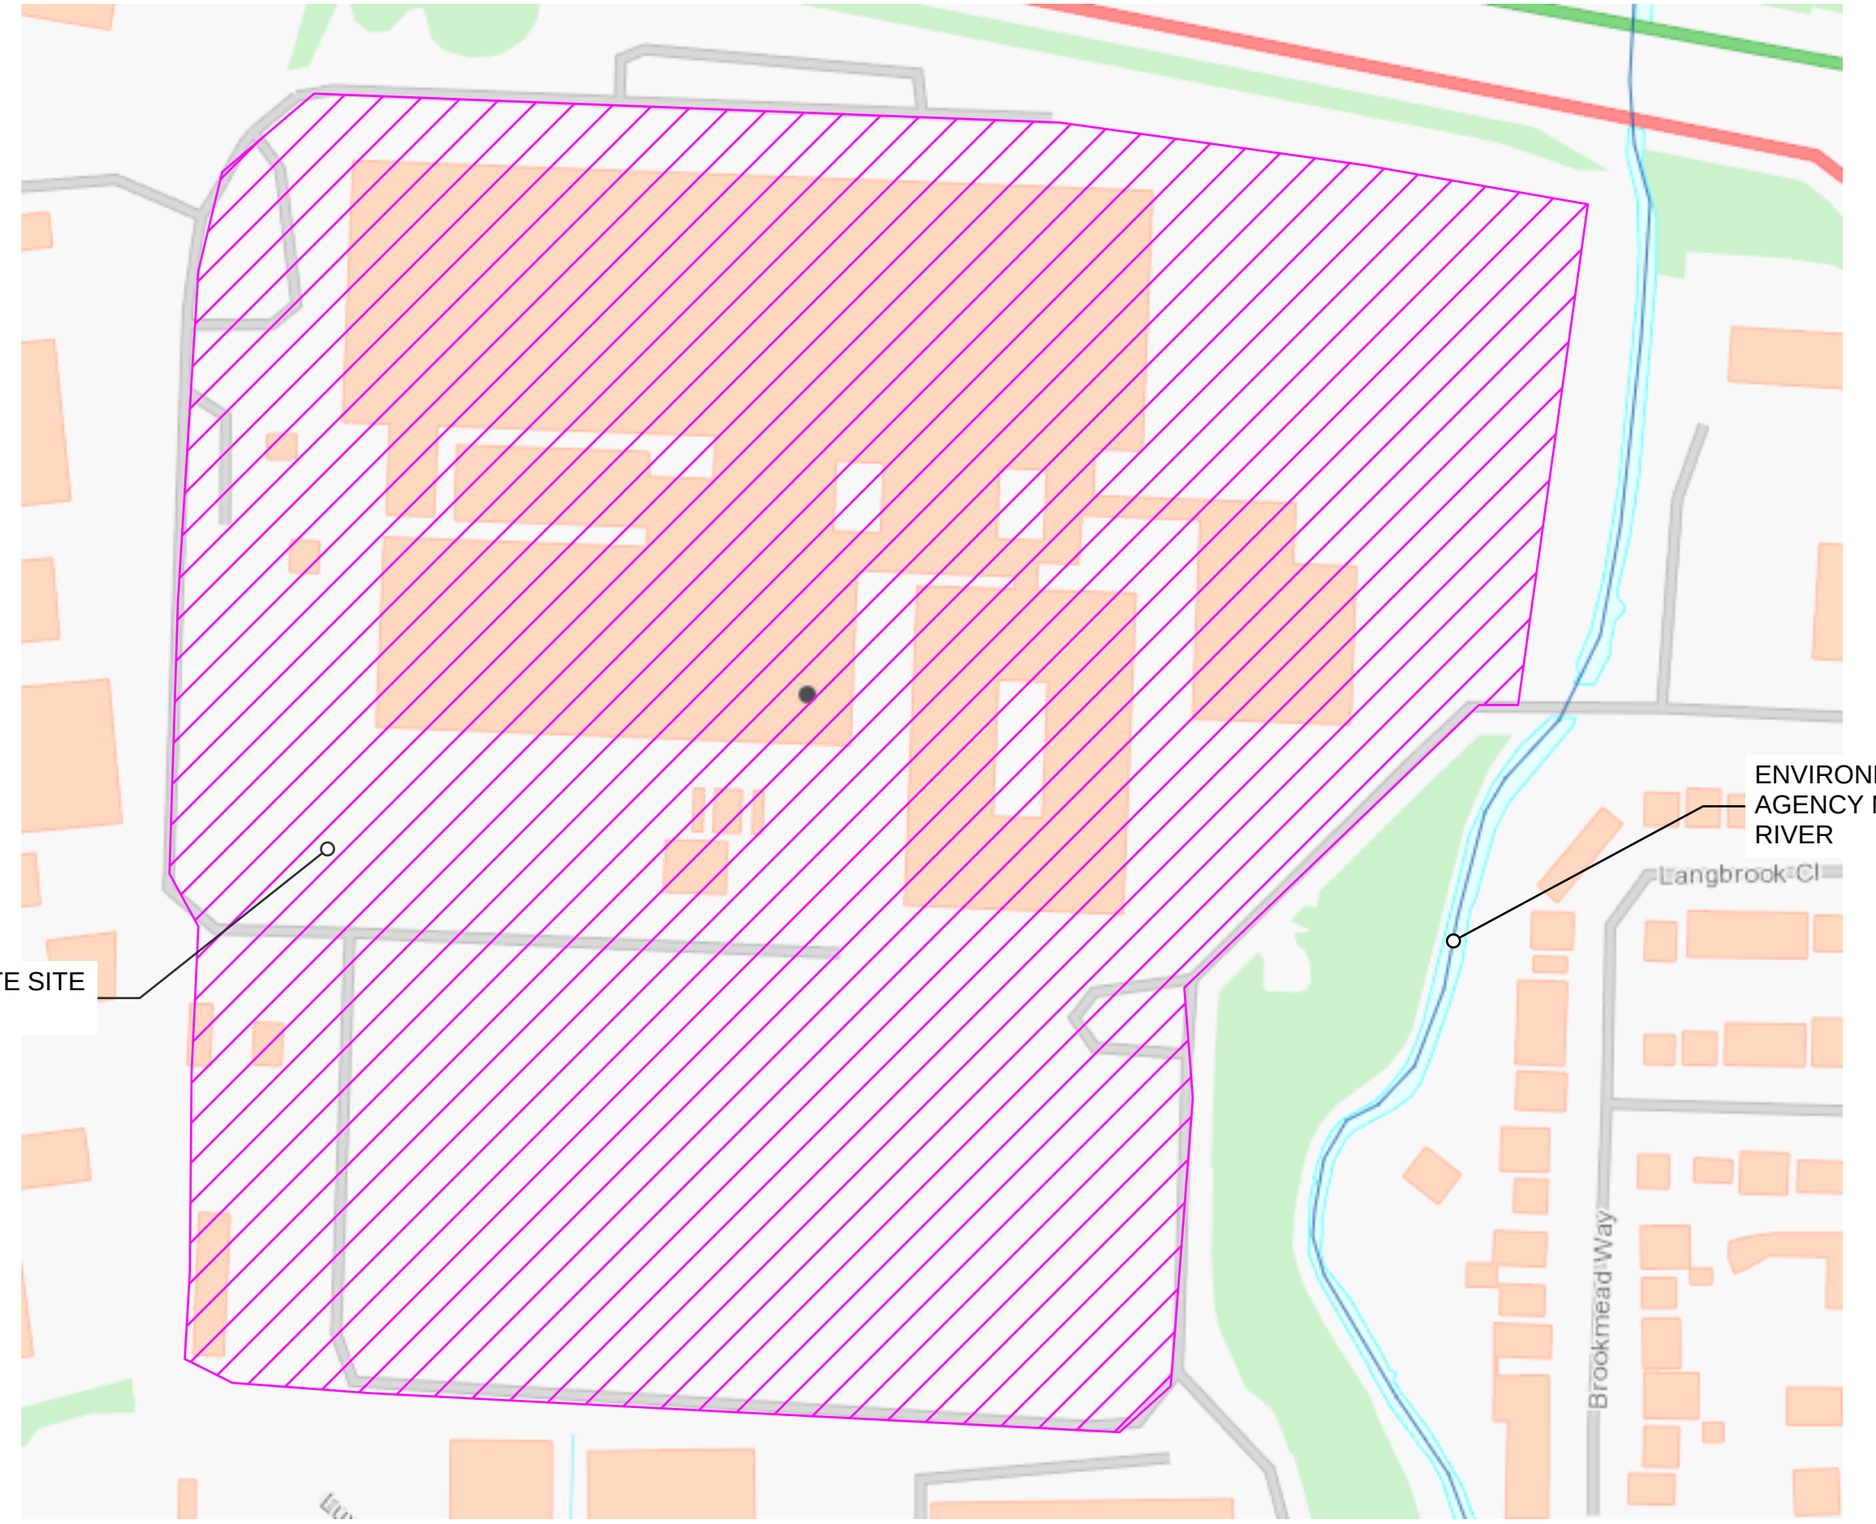

SOURCE: ENVIRONMENT AGENCY MAIN RIVER MAP

clancy consulting
Over 40 years in business

JOB NUMBER : 8/1982

DRAWING NUMBER : SK003

TITLE : EA MAIN RIVER LOCATION

DRAWN BY : CH

DATE : JUNE 2019

REVISION P01

Flow control currently on site in north car park.

The following photos were taken after the CCTV survey was undertaken to identify the previously unknown flow control devices. The restriction on the flow is currently unknown and will be required to be established in detailed design for full hydraulic modelling.

BS EN124 D400

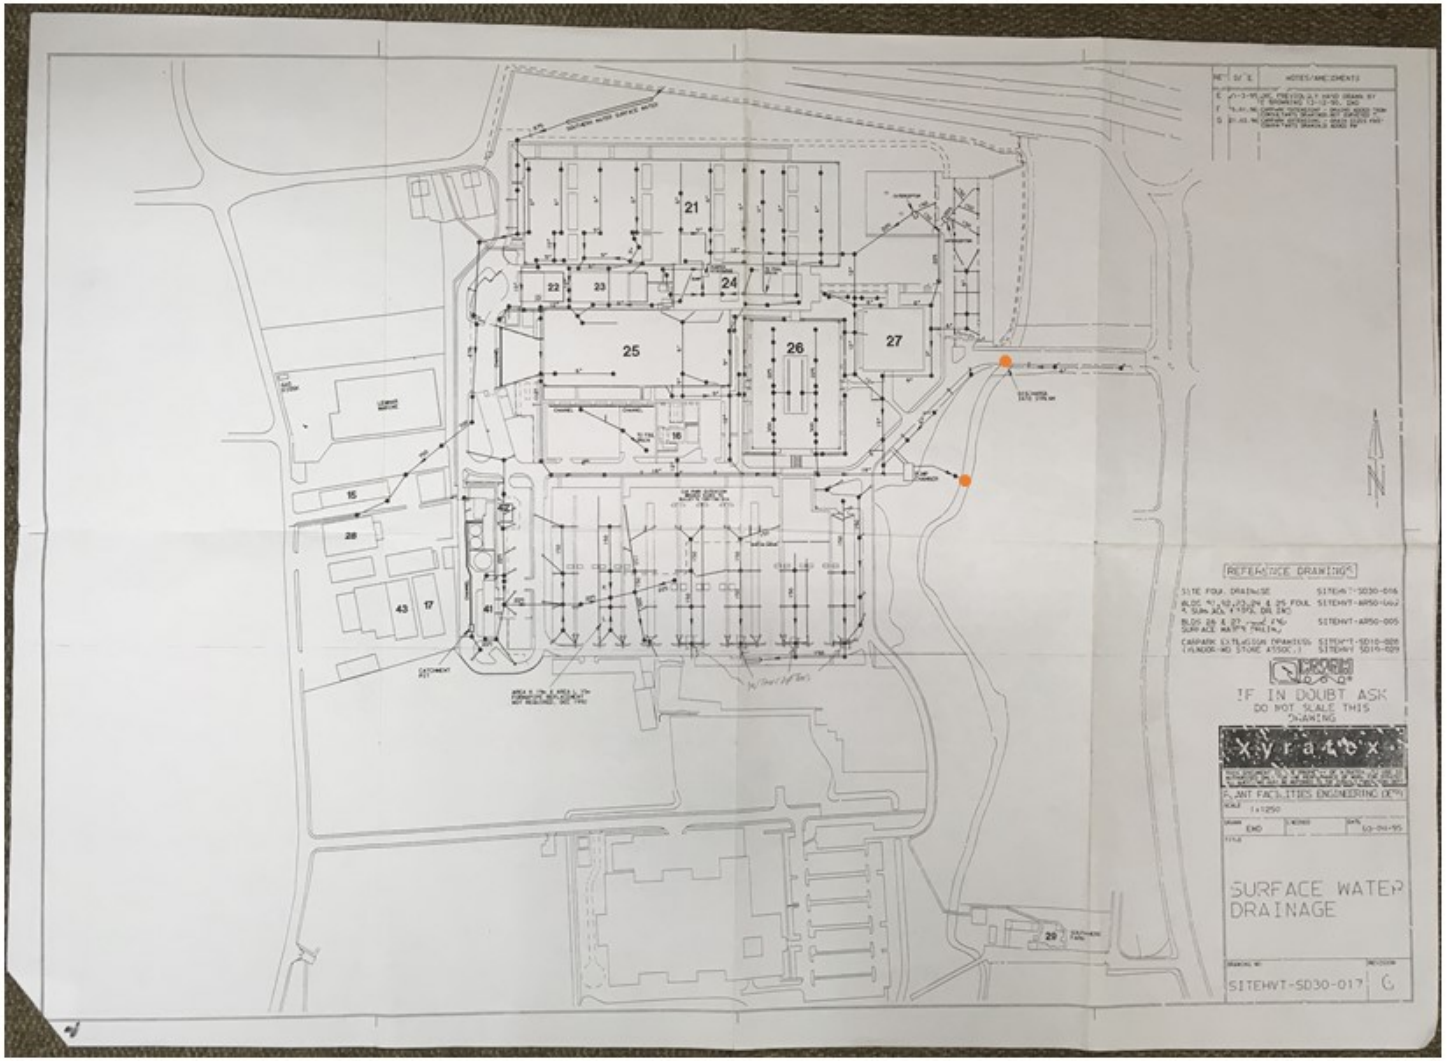

21
22
23
24
25
26
27
16
15
28
43
17
41
29
REFERENCE DRAWINGS
SITE FOUL DRAINAGE
IF IN DOUBT ASK
DO NOT SCALE THIS DRAWING
xyratex
PLANT FACILITIES ENGINEERING DEPT
SCALE 1:1250
DRAWN EMD
DATE 03-04-95
SURFACE WATER DRAINAGE
SITEHVT-SD30-017
G

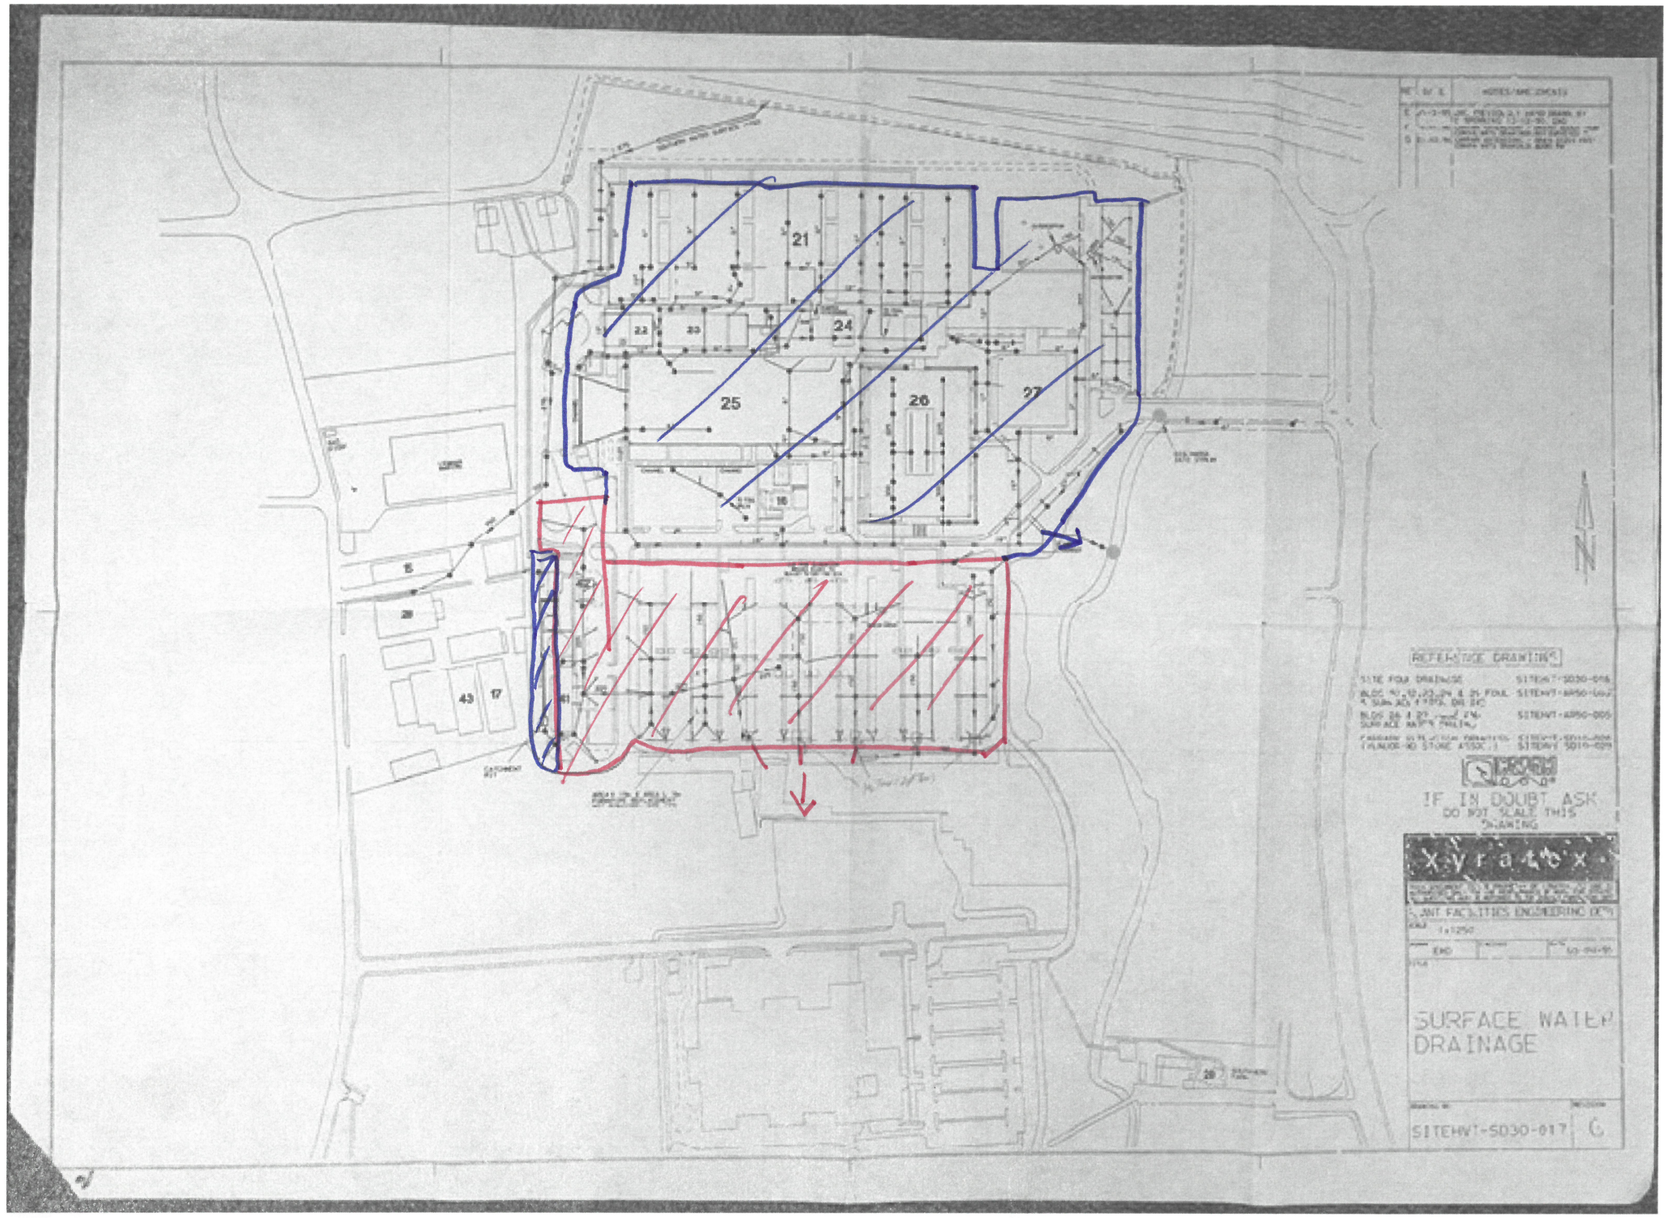
21
22
23
24
25
26
27
18
43
17
REFERENCE DRAWINGS
IF IN DOUBT ASK
DO NOT SCALE THIS
DRAWING
SURFACE WATER
DRAINAGE
SITEHWT-S030-017
C

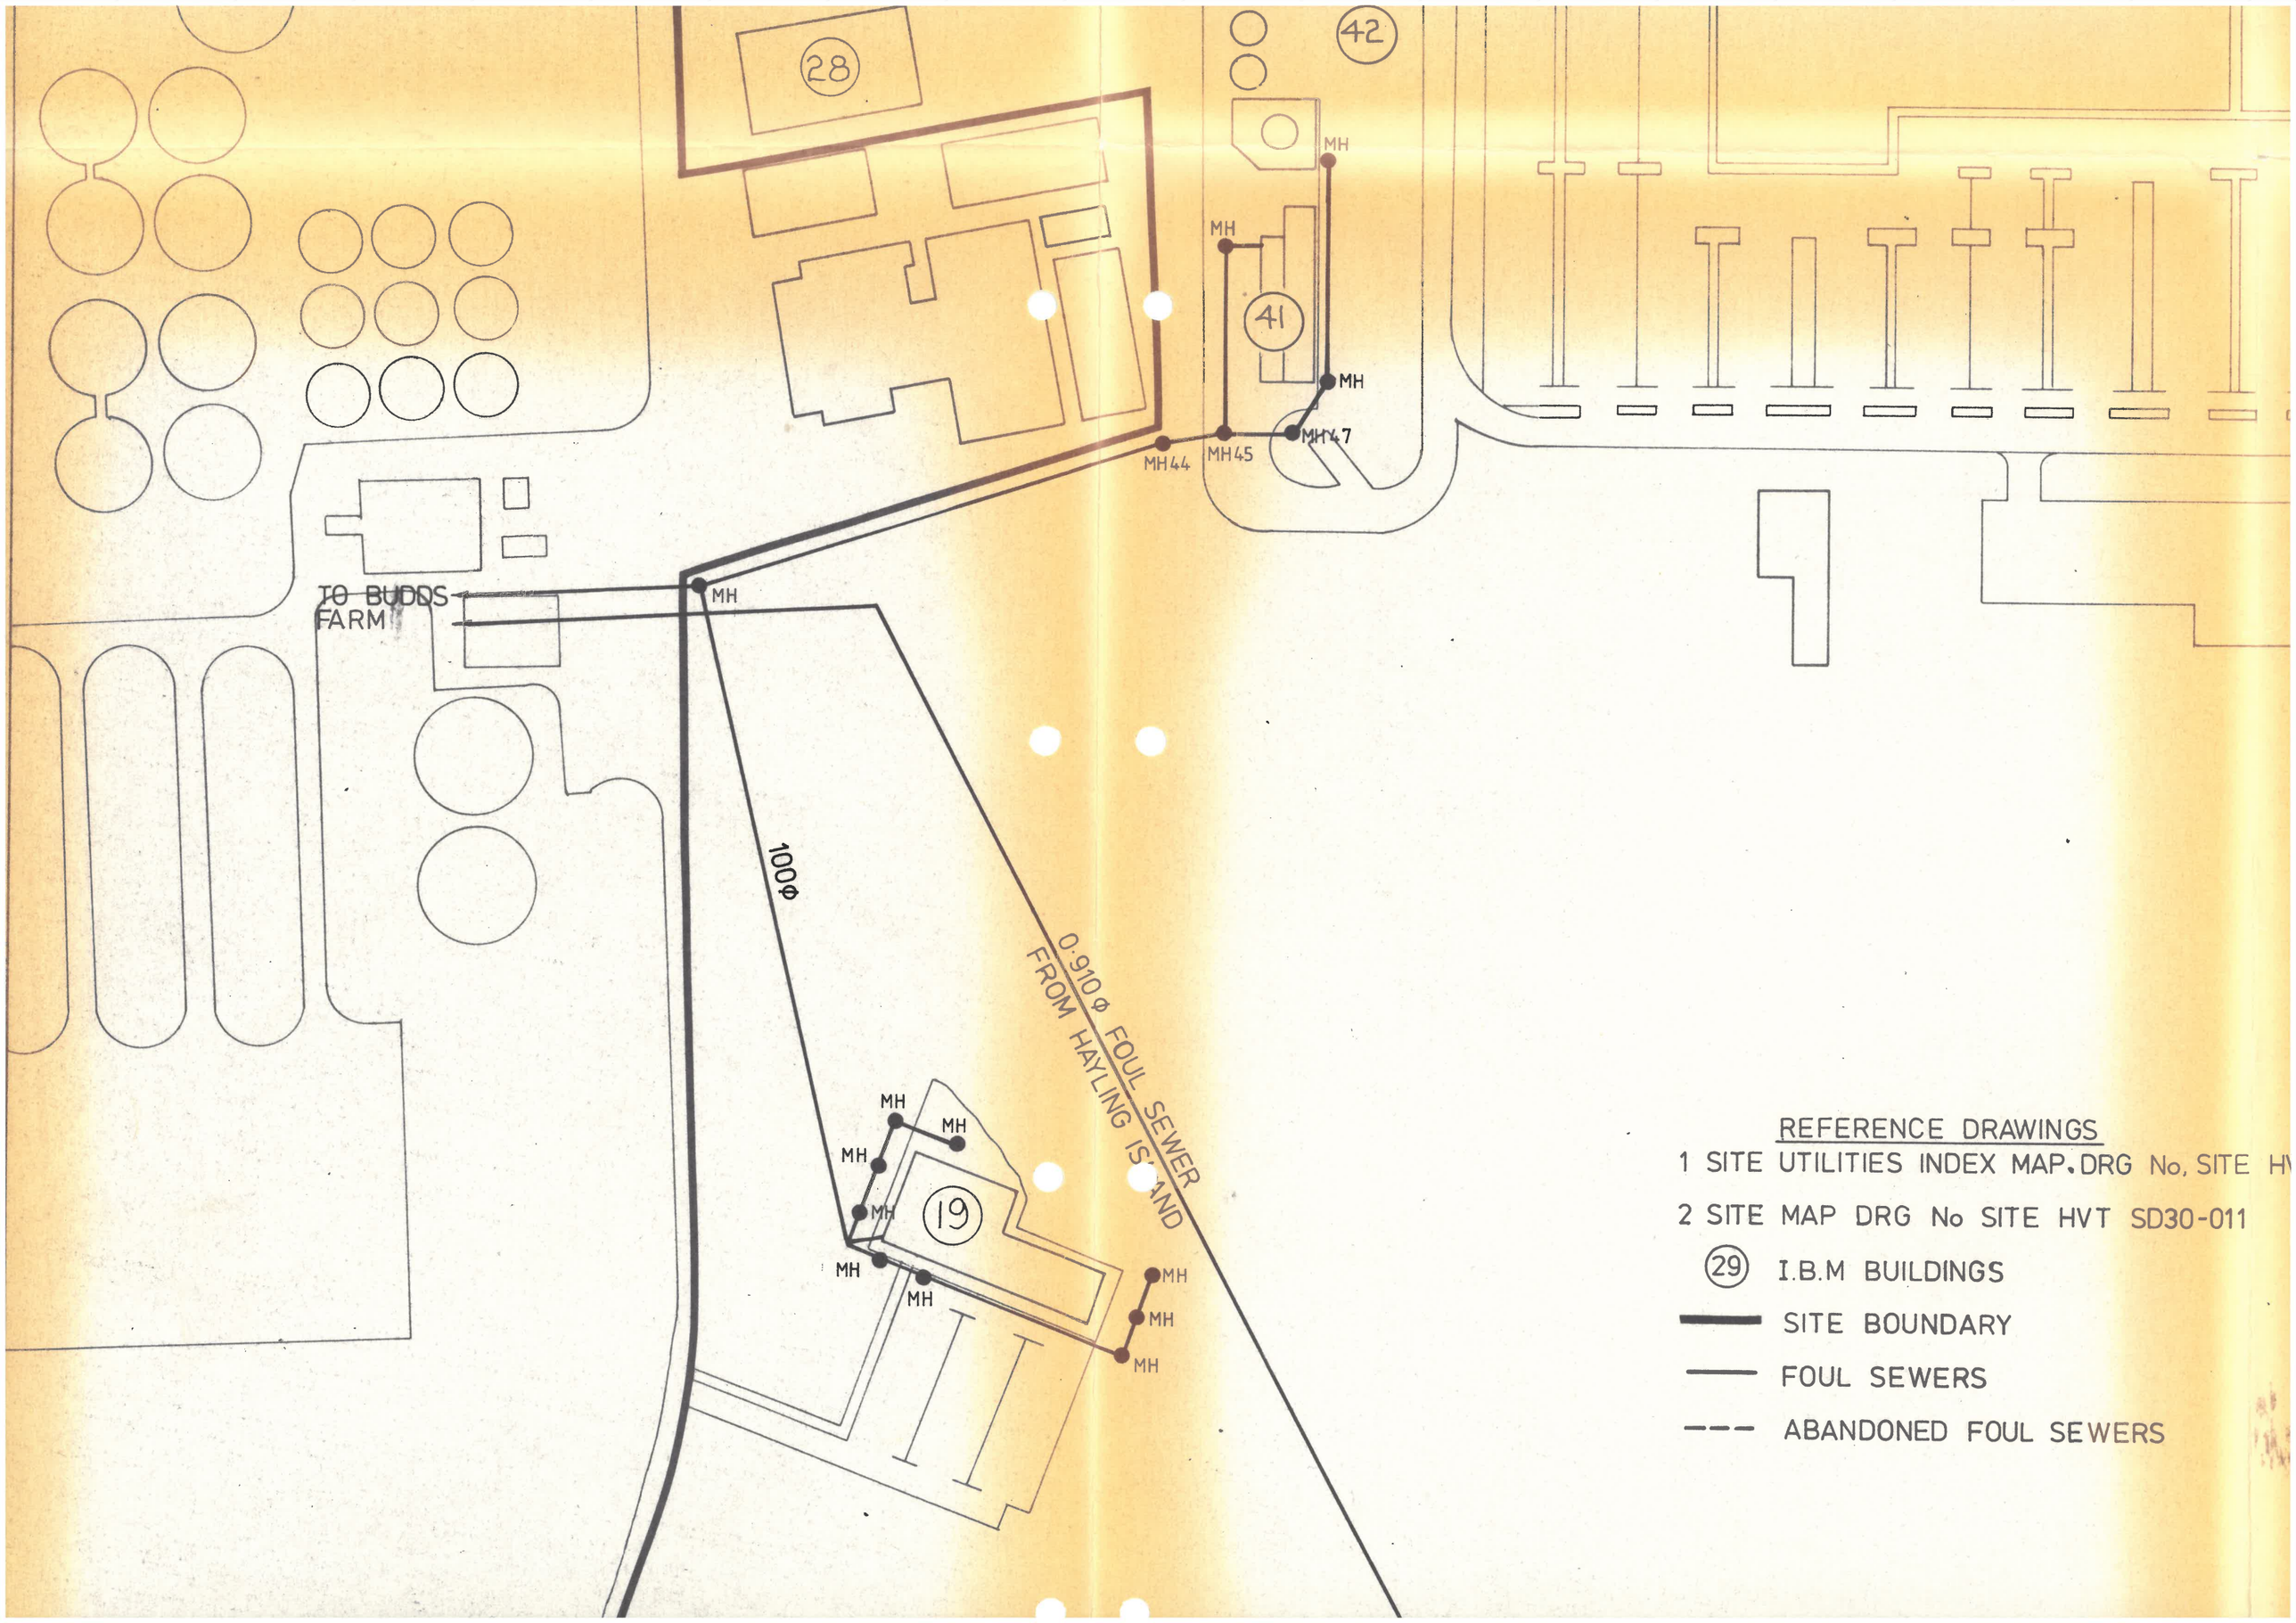
28
42
41
19
MH
MH44
MH45
MH47
TO BUDDS FARM
100Φ
0.910Φ FOUL SEWER FROM HAYLING ISLAND
REFERENCE DRAWINGS
1 SITE UTILITIES INDEX MAP. DRG No, SITE HV
2 SITE MAP DRG No SITE HVT SD30-011
29 I.B.M BUILDINGS
SITE BOUNDARY
FOUL SEWERS
ABANDONED FOUL SEWERS

SEWER RECORDS PAGE 1 OF 2

105916

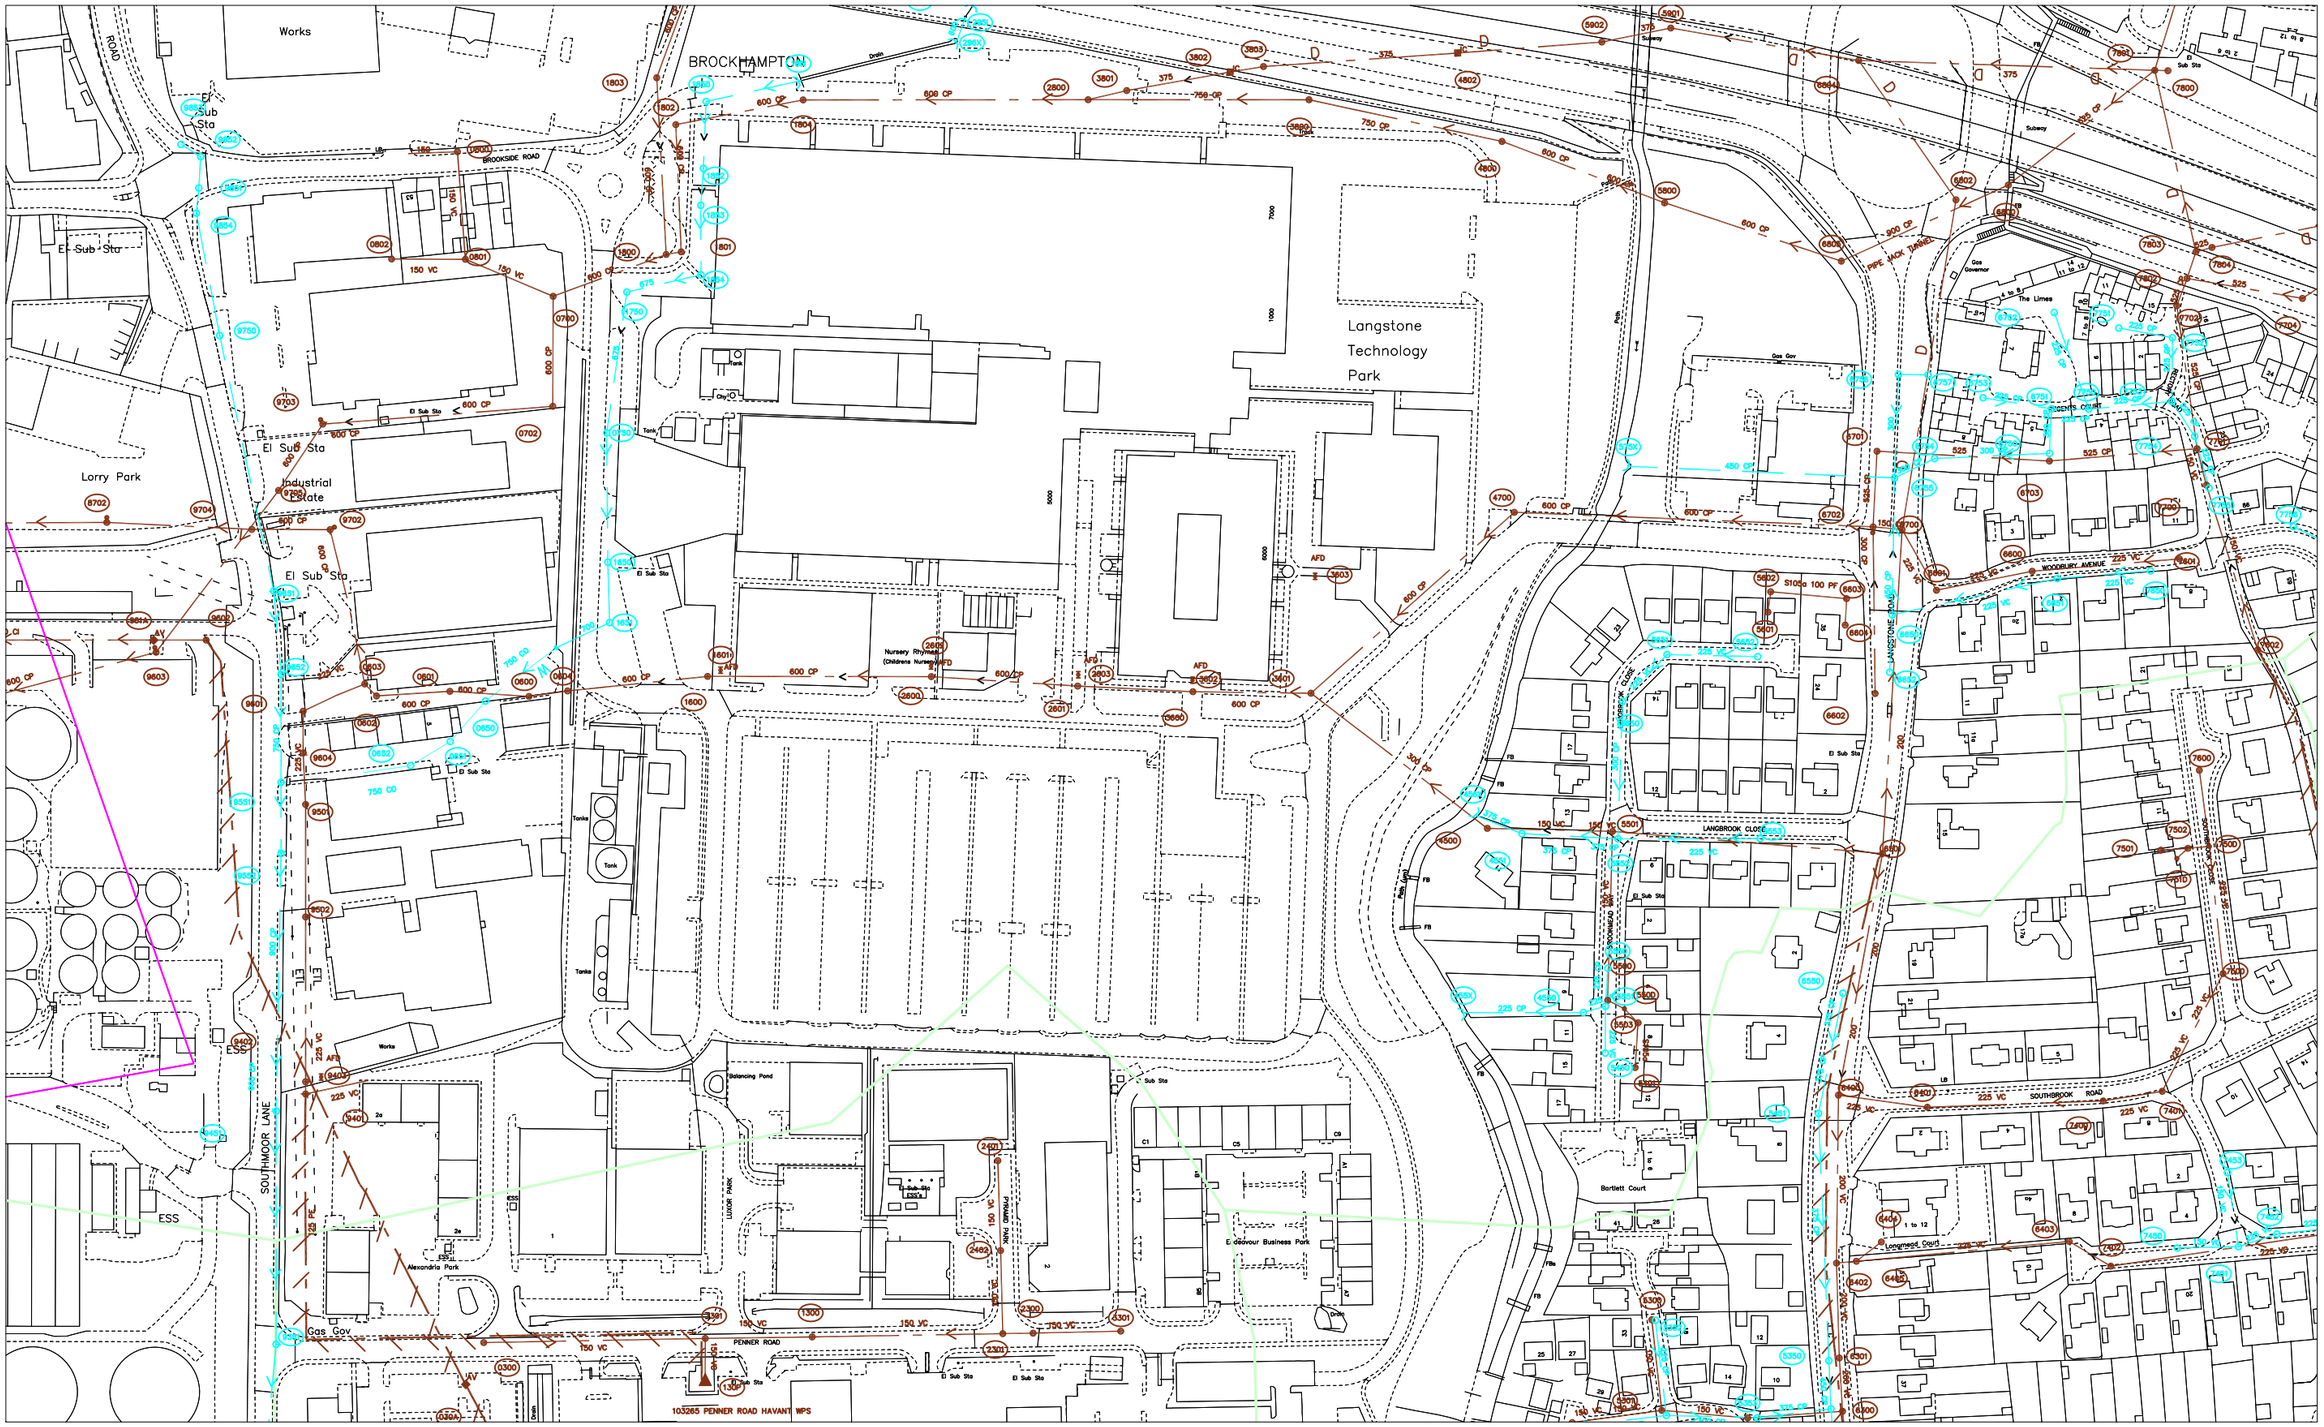

105338

470855

471797

O.S. REF. SU7105NW	Drawn by: ghoshri	The positions of pipes shown on this plan are believed to be correct, but Southern Water Services Ltd accept no responsibility in the event of inaccuracy. The actual positions should be determnined on site. WARNING: BAC pipes are constructed of Bonded Asbestos Cement WARNING: Unknown (UNK) materials may Include Bonded Asbestos Cement
	Scale: 1:2500	
Title: Langstone Technology Park 2B	Date: 12/10/2015	Based upon Ordnance Survey Digital Data with the permission of the controller of H.M.S.O. Crown Copyright Reserved Licence No. WU 298530.

N

Southern Water

SEWER RECORDS PAGE 2 OF 2

Node	Cover	Invert	Size	Material	Shape	
0300X	4.118	1.693	150	VC	CIRC	
030AX			900	UNK	CIRC	
0600X	4.04	1.19	600	CP	CIRC	
0601X	3.95		600	CP	CIRC	
0602X	3.9	0.94	600	CP	CIRC	
0603X	3.89		600	CP	CIRC	
0604X			UNK	UNK	CIRC	
0650X			750	CO	CIRC	
0651X			750	CO	CIRC	
0652X			750	CO	CIRC	
065ZX		4.346	750	CO	CIRC	
0700X	4.64		600	CP	CIRC	
0702X	4.41	1.26	600	CP	CIRC	
0750X	5.1	3.7	UNK	UNK	CIRC	
0800X	4.51		150	VC	CIRC	
0801X	4.8		150	VC	CIRC	
0802X	4.75	3.44	150	VC	CIRC	
1300X	4.232	0.803	150	VC	CIRC	
1301X	4.244	0.309	150	VC	CIRC	
130PX			125	PE	CIRC	
1600X	5.09	1.14	600	CP	CIRC	
1650X	5.416	3.516	UNK	UNK	CIRC	
1651X	5.426		700	UNK	CIRC	
1750X			675	UNK	CIRC	
1800X	5.54	1.61	600	CP	CIRC	
1801X	5.35	1.45	600	CP	CIRC	
1802X	5.3	1.7	600	CP	CIRC	
1803X	4.96	2.1	600	CP	CIRC	
1804X	5.39	1.79	600	CP	CIRC	
1850X			UNK	UNK	CIRC	
1852X	5.528	3.958	UNK	UNK	CIRC	
1853X	5.415	3.975	UNK	UNK	CIRC	
1854X	6.59	3.905	675	UNK	CIRC	
185IX	−1		UNK	UNK	CIRC	
2300X	4.149	1.549	150	VC	CIRC	
2301X	4.165	1.456	150	VC	CIRC	
2401X	4.057	1.981	150	VC	CIRC	
2402X	3.976	1.7	150	VC	CIRC	
2600X	4.72	1.48	600	CP	CIRC	
2601X	5.64		600	CP	CIRC	
2800X	5.69		600	CP	CIRC	
295IX	−1		600	UNK	CIRC	
3301X	4.2	1.816	150	VC	CIRC	
3600X	4.701	1.711	UNK	UNK	CIRC	
3601X	6.13		600	CP	CIRC	
3800X	6.1	2.7	750	CP	CIRC	
3801Y	5.383		UNK	UNK	CIRC	*
3801X	5.383	1.939	375	UNK	CIRC	*
3803X	5.913	2.161	375	UNK	CIRC	
4500X	4.6	2.43	300	CP	CIRC	
4550X	4.78	4.03	225	CP	CIRC	
4551X	4.95	4.34	375	CP	CIRC	
4700X	5.18	2.18	600	CP	CIRC	
4800X	5.84		750	CP	CIRC	
5300X	5.15	4.61	150	VC	CIRC	
5301X	5.42		150	VC	CIRC	
5350X	5.58	3.78	450	CP	CIRC	
5351X	5.43		450	CP	CIRC	
5352X	5.19	4.34	225	CP	CIRC	
5353X	5.56	3.67	375	CP	CIRC	
5354X	5.42		300	CP	CIRC	
5401X			UNK	UNK	CIRC	
5450X	4.86	4.29	225	VC	CIRC	
5451X	6.33	4.27	375	CP	CIRC	
5500X	4.6	3.71	150	VC	CIRC	

Node	Cover	Invert	Size	Material	Shape	
5501X	5.05	3.41	150	VC	CIRC	
5503X			UNK	UNK	CIRC	
550DX			UNK	UNK	CIRC	
5550X	5.03	4.26	225	CP	CIRC	
5551X	4.91		225	VC	CIRC	
5552X	5.15	4.37	375	CP	CIRC	
5553X	6.12	5.23	225	VC	CIRC	
5601X			100	PF	CIRC	
5602X			100	PF	CIRC	
5650X	5.37	4.62	300	CP	CIRC	
5651X	5.77	4.98	225	VC	CIRC	
5652X	6.57	5.71	225	VC	CIRC	
5800X	5.02	2.52	600	CP	CIRC	
5901X	7.48	3.228	375	UNK	CIRC	
5902X	7.583	3.124	375	UNK	CIRC	
6300X	5.37		200	VC	CIRC	
6301X	5.52	3.78	200	VC	CIRC	
6400X	6.05		200	VC	CIRC	
6401X	6.12	4.73	225	VC	CIRC	
6402X	5.62		200	VC	CIRC	
6403X	5.76	4.37	225	VC	CIRC	
6404X			UNK	UNK	CIRC	
6405X			225	VC	CIRC	
6501X	6.486	5.557	200	UNK	CIRC	*
6501Y	6.486	5.078	200	UNK	CIRC	*
6501Y	6.486		UNK	UNK	CIRC	*
6550X	6.3	4.5	375	CP	CIRC	
6600X	7.02	5.59	225	VC	CIRC	
6601X	6.94	5.29	225	VC	CIRC	
6602X			300	CP	CIRC	
6603X			100	PF	CIRC	
6650X	7.02		450	CP	CIRC	
6651X	7.11	6.4	225	VC	CIRC	
6652X	6.842	5.322	UNK	UNK	CIRC	
6700Y	7.12	4.52	UNK	UNK	CIRC	*
6700X	7.12		150	CP	CIRC	*
6701X	7.23	3.28	525	CP	CIRC	
6702X	7.07		600	CP	CIRC	
6703X	7.84	3.58	525	UNK	CIRC	
6750X	7.88	5.5	300	CP	CIRC	
6751X	7.97		300	CP	CIRC	
6752X	8.31	6.71	225	CP	CIRC	
6753X	7.98	6.05	225	CP	CIRC	
6754X	7.92	5.31	300	CP	CIRC	
6755X	7.429		450	CP	CIRC	
6756X	7.64	6.795	300	UNK	CIRC	
6757X	7.354	6.869	UNK	UNK	CIRC	
6800X	8.23	3.18	900	CP	CIRC	
6804X	9.101	3.514	UNK	UNK	CIRC	
6805X	6.53	2.58	600	CP	CIRC	
7400X	6.01	5.01	225	VC	CIRC	
7401X	5.92	5.12	225	VC	CIRC	
7402X	5.694	4.499	UNK	UNK	CIRC	
7450X	5.48	4.56	150	VC	CIRC	
7451X	5.26		225	VC	CIRC	
7452X	5.45	4.18	225	VC	CIRC	
7453X	5.17	4.42	150	VC	CIRC	
7500X	6.16	5.2	225	VC	CIRC	
7501X			UNK	UNK	CIRC	
7502X			UNK	UNK	CIRC	
750DX			225	VC	CIRC	
751DX			UNK	UNK	CIRC	
7600X	6.72	5.71	225	VC	CIRC	
7601X	7.15	5.9	225	VC	CIRC	
7602X	7.01	5.11	150	VC	CIRC	

Node	Cover	Invert	Size	Material	Shape	
7650X	7.23	6.55	225	VC	CIRC	
7700X	7.09	3.94	150	VC	CIRC	
7701X	7.34		525	CP	CIRC	
7702X	7.92	4.02	525	CP	CIRC	
7704Y	8.767		525	UNK	CIRC	
7750X	7.8		225	CP	CIRC	
7751X	8.01	6.44	225	CP	CIRC	
7752X	7.87	6.27	225	CP	CIRC	
7753X	7.6		225	CP	CIRC	
7754X	7.47	6.2	225	CP	CIRC	
7755X	7.36	6.38	225	CP	CIRC	
7756X	6.852	5.972	UNK	UNK	CIRC	
7800X	8.2	3.7	525	CP	CIRC	
7801Y	8.12		525	CP	CIRC	*
7801Y	8.12		375	UNK	CIRC	*
7801X	8.12	3.47	UNK	UNK	CIRC	*
7802X	8.53		525	CP	CIRC	
7803X	8.274		UNK	UNK	CIRC	
7804X	8.172	4.107	525	UNK	CIRC	
8702X	4.51	0.36	600	CP	CIRC	
9351X	3.04	1.54	900	CP	CIRC	
9401X	3.14	1.96	225	VC	CIRC	
9402X	3.04	1.94	225	VC	CIRC	
9451X	2.84	1.69	900	CP	CIRC	
9501X	3.4	1.61	225	VC	CIRC	
9502X	3.39	1.88	225	VC	CIRC	
9551X	3.59	1.98	750	CP	CIRC	
9552X	3.33	1.76	900	CP	CIRC	
9601X	3.81		225	VC	CIRC	
9602X			UNK	UNK	CIRC	
9603X	4.42	0.64	600	CP	CIRC	
9604X	3.49	1.54	225	VC	CIRC	
961AX	3.99	1.56	900	CI	CIRC	
9651X	3.95	2.26	750	CP	CIRC	
9652X	3.76	2.11	750	CP	CIRC	
9702X	4.14	0.57	600	CP	CIRC	
9703X	4.73	0.85	600	CP	CIRC	
9704X	3.96	0.52	600	CP	CIRC	
9705X	4.54	0.87	600	CP	CIRC	
9750X	4.59		750	CP	CIRC	
9851X			600	CP	CIRC	
9852X			600	CP	CIRC	
9853X			675	CP	CIRC	
9854X			750	CP	CIRC	

Node	Cover	Invert	Size	Material	Shape

LINE STYLES / COLOURS

Brown: Foul; Foul Syphon Sewer; Foul Vacuum Main; Foul Rising Main
Red: Combined; Combined Syphon Sewer; Combined Rising Main; Lateral Drain
Orange: Building Over Agreement Area
Dark Blue: Treated Effluent
Purple: Sludge; Sewer Catchment; Section 104 Area
Light Blue: Surface Water; Surface Water Rising Main
Yellow: Private
Green: Access Shaft; Decommissioned

MATERIALS

AK Alkathene
BAC Bonded Asbestos Cement
BRC Brick (Common)
BRE Brick (Engineering)
CC Concrete Box Culvert
CI Cast Iron
CO Concrete (In-Situ)
CP Concrete (Pre-Cast)
CSB Concrete Segments (bolted)
CSU Concrete Segments (unbolted)
DI Ductile Iron
GRC Glass Reinforced Concrete
GRP Glass Reinforced Plastic
MAC Masonry in regular Courses
MAR Masonry in random Courses
PE Polyethylene
PF Pitch Fibre
PP Polypropylene
PVC Polyvinyl Chloride
RPM Reinforced Plastic Matrix
SI Spun Iron
ST Steel
VC Vitrified Clay
XXX Other
ZZZ Unknown

Manhole (SW)
Manhole (F&C)
Lamp hole (SW)
Lamp hole (F&C)
Pumping Station (SW)
Pumping Station (F&C)
Side entry manhole (SW)
Side entry Manhole (F&C)
Blind shaft (SW)
Blind shaft (F&C)
Ejector station (SW)
Ejector station (F&C)
Watertight door (SW)
Watertight door (F&C)
Flushing ch. Mn=e (SW)
Flushing ch. Mn=e (F&C)
Flushing ch. No=e (SW)
Flushing ch. No=e (F&C)
Demarcation Chamber

LEGEND - SEWERS

Washout (SW)
Washout (F&C)
Rodding Eye (SW)
Rodding Eye (F&C)
Gauging point (SW)
Gauging point (F&C)
Intercept chamber (SW)
Intercept chamber (F&C)
Storm Tank (SW)
Storm Tank (F&C)
Vortex chamber (SW)
Vortex chamber (F&C)
Label ellipse
Dummy/S24 manhole
Outfall
Penstock chamber
Damboards
Storm Overflow
Backdrop manhole

Other (s)
Other
Change in sewer (s)
Change in sewer
Reflux valve
Flap valve
Cascade
Anode
Valve
Closed Valve
Air Valve
Hatch box (SW)
Hatch box (F&C)
Direction arrow
Emptying valve
Catchpit
Soakaway
Inlet
Balancing Pond

Wastewater treatment works
Marine treatment works
Outfall headworks
Vent
Vent column
Tidal storage tank
Blank end
Head of Public Sewer
Micro Pumping Station

SHAPES (S)

A Arched
B Barrel
C Circular
E Egg
H Horseshoe
R Rectangular
S Square
T Trapezoidal
U U Shape
X Other

NODE REFERENCING SYSTEM

1st digit: hundred metre easting identifier
2nd digit: hundred metre northing identifier
3rd digit: sewer type identifier
0-4 = Foul/Combined
5-9 = Surface Water
4th digit: next sequential node

Drawn by:	ghoshri
Title:	Langstone Technology Park 2B
Date:	12/10/2015

Southern Water

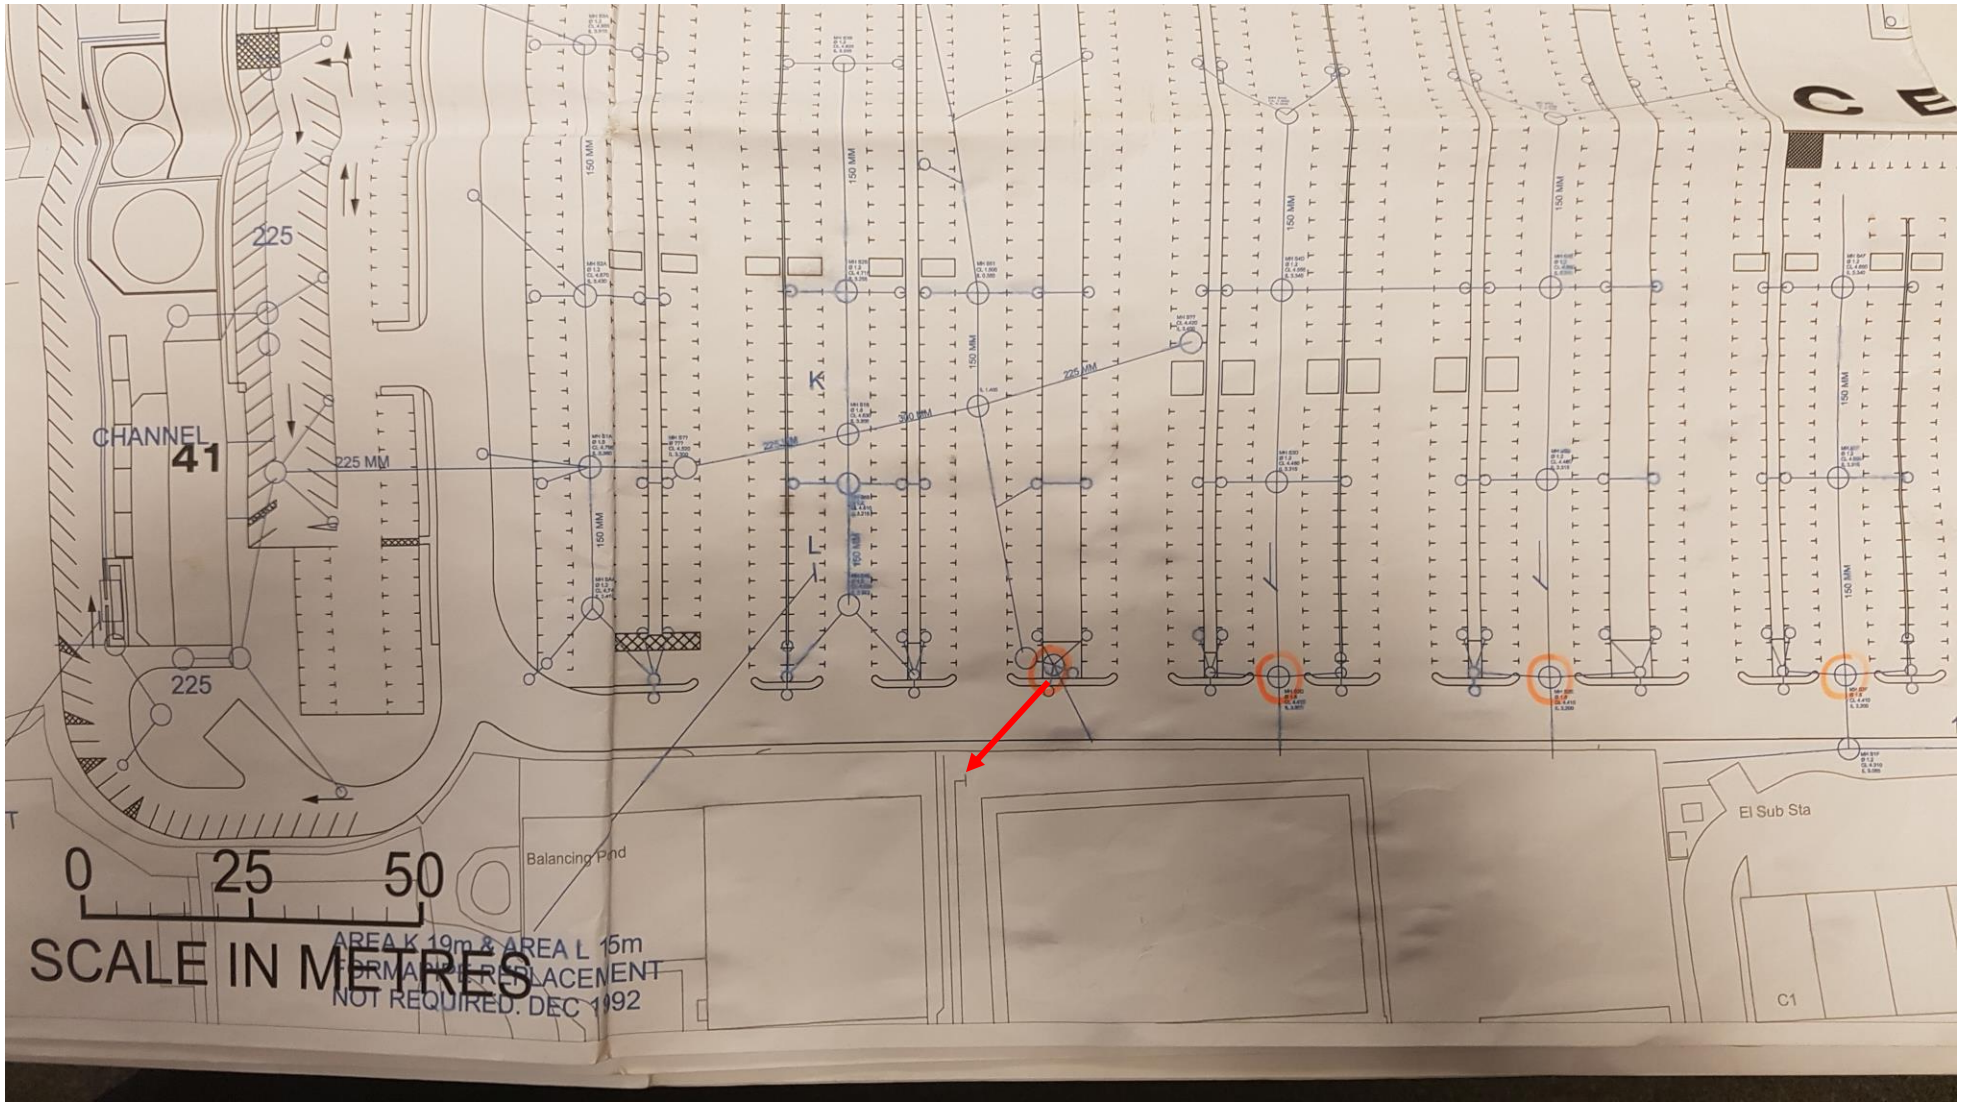
CHANNEL
41
225
225
225 MM
150 MM
K
L
Balancing Pond
El Sub Sta
C1
0 25 50
SCALE IN METRES
AREA K 19m & AREA L 15m
FORMAL PIPE REPLACEMENT
NOT REQUIRED. DEC 1992

APPENDIX D

Drainage Calculations

DESIGN RAINFALL

In accordance with the Wallingford Procedure

Tedds calculation version 2.0.01

Design rainfall intensity

Location of catchment area	Bournemouth
Storm duration	D = **15** min
Return period	Period = **1** yr
Ratio 60 min to 2 day rainfall of 5 yr return period	r = **0.350**
5-year return period rainfall of 60 minutes duration	M5_60min = **19.0** mm
Increase of rainfall intensity due to global warming	$p_{climate}$ = **0** %
Factor Z1 (Wallingford procedure)	Z1 = **0.62**
Rainfall for 15min storm with 5 year return period	$M5\_15min_i = Z1 \times M5\_60min$ = **11.7** mm
Factor Z2 (Wallingford procedure)	Z2 = **0.61**
Rainfall for 15min storm with 1 year return period	$M1\_15min = Z2 \times M5\_15min_i$ = **7.2** mm
Design rainfall intensity	I_{max} = M1_15min / D = **28.7** mm/hr

Maximum surface water runoff

Catchment area	A_{catch} = **2044** m^2
Percentage of area that is impermeable	p = **46** %
Maximum surface water runoff	$Q_{max} = A_{catch} \times p \times I_{max}$ = **7.5** l/s

DESIGN RAINFALL

In accordance with the Wallingford Procedure

Tedds calculation version 2.0.01

Design rainfall intensity

Location of catchment area	Bournemouth
Storm duration	D = **15** min
Return period	Period = **30** yr
Ratio 60 min to 2 day rainfall of 5 yr return period	r = **0.350**
5-year return period rainfall of 60 minutes duration	M5_60min = **19.0** mm
Increase of rainfall intensity due to global warming	$p_{climate}$ = **0** %
Factor Z1 (Wallingford procedure)	Z1 = **0.62**
Rainfall for 15min storm with 5 year return period	$M5\_15min_i = Z1 \times M5\_60min$ = **11.7** mm
Factor Z2 (Wallingford procedure)	Z2 = **1.50**
Rainfall for 15min storm with 30 year return period	$M30\_15min = Z2 \times M5\_15min_i$ = **17.6** mm
Design rainfall intensity	I_{max} = M30_15min / D = **70.4** mm/hr

Maximum surface water runoff

Catchment area	A_{catch} = **2044** m^2
Percentage of area that is impermeable	p = **46** %
Maximum surface water runoff	$Q_{max} = A_{catch} \times p \times I_{max}$ = **18.4** l/s

DESIGN RAINFALL

In accordance with the Wallingford Procedure

Tedds calculation version 2.0.01

Design rainfall intensity

Location of catchment area	Bournemouth
Storm duration	D = **15** min
Return period	Period = **100** yr
Ratio 60 min to 2 day rainfall of 5 yr return period	r = **0.350**
5-year return period rainfall of 60 minutes duration	M5_60min = **19.0** mm
Increase of rainfall intensity due to global warming	$p_{climate}$ = **0** %
Factor Z1 (Wallingford procedure)	Z1 = **0.62**
Rainfall for 15min storm with 5 year return period	$M5\_15min_i = Z1 \times M5\_60min$ = **11.7** mm
Factor Z2 (Wallingford procedure)	Z2 = **1.94**
Rainfall for 15min storm with 100 year return period	$M100\_15min = Z2 \times M5\_15min_i$ = **22.7** mm
Design rainfall intensity	I_{max} = M100_15min / D = **90.8** mm/hr

Maximum surface water runoff

Catchment area	A_{catch} = **2044** m^2
Percentage of area that is impermeable	p = **46** %
Maximum surface water runoff	$Q_{max} = A_{catch} \times p \times I_{max}$ = **23.7** l/s

DESIGN RAINFALL

In accordance with the Wallingford Procedure

Tedds calculation version 2.0.01

Design rainfall intensity

Location of catchment area	Bournemouth
Storm duration	D = **15** min
Return period	Period = **1** yr
Ratio 60 min to 2 day rainfall of 5 yr return period	r = **0.350**
5-year return period rainfall of 60 minutes duration	M5_60min = **19.0** mm
Increase of rainfall intensity due to global warming	$p_{climate}$ = **0** %
Factor Z1 (Wallingford procedure)	Z1 = **0.62**
Rainfall for 15min storm with 5 year return period	$M5\_15min_i = Z1 \times M5\_60min$ = **11.7** mm
Factor Z2 (Wallingford procedure)	Z2 = **0.61**
Rainfall for 15min storm with 1 year return period	$M1\_15min = Z2 \times M5\_15min_i$ = **7.2** mm
Design rainfall intensity	I_{max} = M1_15min / D = **28.7** mm/hr

Maximum surface water runoff

Catchment area	A_{catch} = **25439** m^2
Percentage of area that is impermeable	p = **100** %
Maximum surface water runoff	$Q_{max} = A_{catch} \times p \times I_{max}$ = **203.2** l/s

DESIGN RAINFALL

In accordance with the Wallingford Procedure

Tedds calculation version 2.0.01

Design rainfall intensity

Location of catchment area	Bournemouth
Storm duration	D = **15** min
Return period	Period = **30** yr
Ratio 60 min to 2 day rainfall of 5 yr return period	r = **0.350**
5-year return period rainfall of 60 minutes duration	M5_60min = **19.0** mm
Increase of rainfall intensity due to global warming	$p_{climate}$ = **0** %
Factor Z1 (Wallingford procedure)	Z1 = **0.62**
Rainfall for 15min storm with 5 year return period	$M5\_15min_i = Z1 \times M5\_60min$ = **11.7** mm
Factor Z2 (Wallingford procedure)	Z2 = **1.50**
Rainfall for 15min storm with 30 year return period	$M30\_15min = Z2 \times M5\_15min_i$ = **17.6** mm
Design rainfall intensity	I_{max} = M30_15min / D = **70.4** mm/hr

Maximum surface water runoff

Catchment area	A_{catch} = **25439** m^2
Percentage of area that is impermeable	p = **100** %
Maximum surface water runoff	$Q_{max} = A_{catch} \times p \times I_{max}$ = **497.6** l/s

DESIGN RAINFALL

In accordance with the Wallingford Procedure

Tedds calculation version 2.0.01

Design rainfall intensity

Location of catchment area	Bournemouth
Storm duration	D = **15** min
Return period	Period = **100** yr
Ratio 60 min to 2 day rainfall of 5 yr return period	r = **0.350**
5-year return period rainfall of 60 minutes duration	M5_60min = **19.0** mm
Increase of rainfall intensity due to global warming	$p_{climate}$ = **0** %
Factor Z1 (Wallingford procedure)	Z1 = **0.62**
Rainfall for 15min storm with 5 year return period	$M5\_15min_i = Z1 \times M5\_60min$ = **11.7** mm
Factor Z2 (Wallingford procedure)	Z2 = **1.94**
Rainfall for 15min storm with 100 year return period	$M100\_15min = Z2 \times M5\_15min_i$ = **22.7** mm
Design rainfall intensity	I_{max} = M100_15min / D = **90.8** mm/hr

Maximum surface water runoff

Catchment area	A_{catch} = **25439** m^2
Percentage of area that is impermeable	p = **100** %
Maximum surface water runoff	$Q_{max} = A_{catch} \times p \times I_{max}$ = **641.6** l/s

Greenfield runoff estimation for sites

www.uksuds.com | Greenfield runoff tool

Calculated by:	
Site name:	Langstone Technology Park (Area 3)
Site location:	Havant

This is an estimation of the greenfield runoff rate limits that are needed to meet normal best practice criteria in line with Environment Agency guidance "Preliminary rainfall runoff management for developments", W5-074/A/TR1/1 rev. E (2012) and the SuDS Manual, C753 (Ciria, 2015). This information on greenfield runoff rates may be the basis for setting consents for the drainage of surface water runoff from sites.

Site coordinates

Latitude:	50.84623° N
Longitude:	0.98899° W
Reference:	
Date:	2019-06-17 10:02

Methodology	IH124

Site characteristics

Total site area (ha)	0.1822

Methodology

Qbar estimation method	Calculate from SPR and SAAR
SPR estimation method	Calculate from SOIL type

	Default	Edited
SOIL type	3	3
HOST class	---	---
SPR/SPRHOST	0.37	0.37

Hydrological characteristics

	Default	Edited
SAAR (mm)	719	719
Hydrological region	7	7
Growth curve factor: 1 year	0.85	0.85
Growth curve factor: 30 year	2.3	2.3
Growth curve factor: 100 year	3.19	3.19

Notes:

(1) Is Q_{BAR} < 2.0 l/s/ha?

(2) Are flow rates < 5.0 l/s?

Where flow rates are less than 5.0 l/s consents are usually set at 5.0l/s if blockage from vegetation and other materials is possible. Lower consent flow rates may be set in which case blockage work must be addressed by using appropriate drainage elements

(3) Is SPR/SPRHOST ≤ 0.3?

Greenfield runoff rates

	Default	Edited
Qbar (l/s)	0.54	0.54
1 in 1 year (l/s)	0.46	0.46
1 in 30 years (l/s)	1.24	1.24
1 in 100 years (l/s)	1.72	1.72

This report was produced using the greenfield runoff tool developed by HR Wallingford and available at www.uksuds.com. The use of this tool is subject to the UK SuDS terms and conditions and licence agreement, which can both be found at http://uksuds.com/terms-and-conditions.htm. The outputs from this tool have been used to estimate storage volume requirements. The use of these results is the responsibility of the users of this tool. No liability will be accepted by HR Wallingford, the Environment Agency, CEH, Hydrosolutions or any other organisation for use of this data in the design or operational characteristics of any drainage scheme.