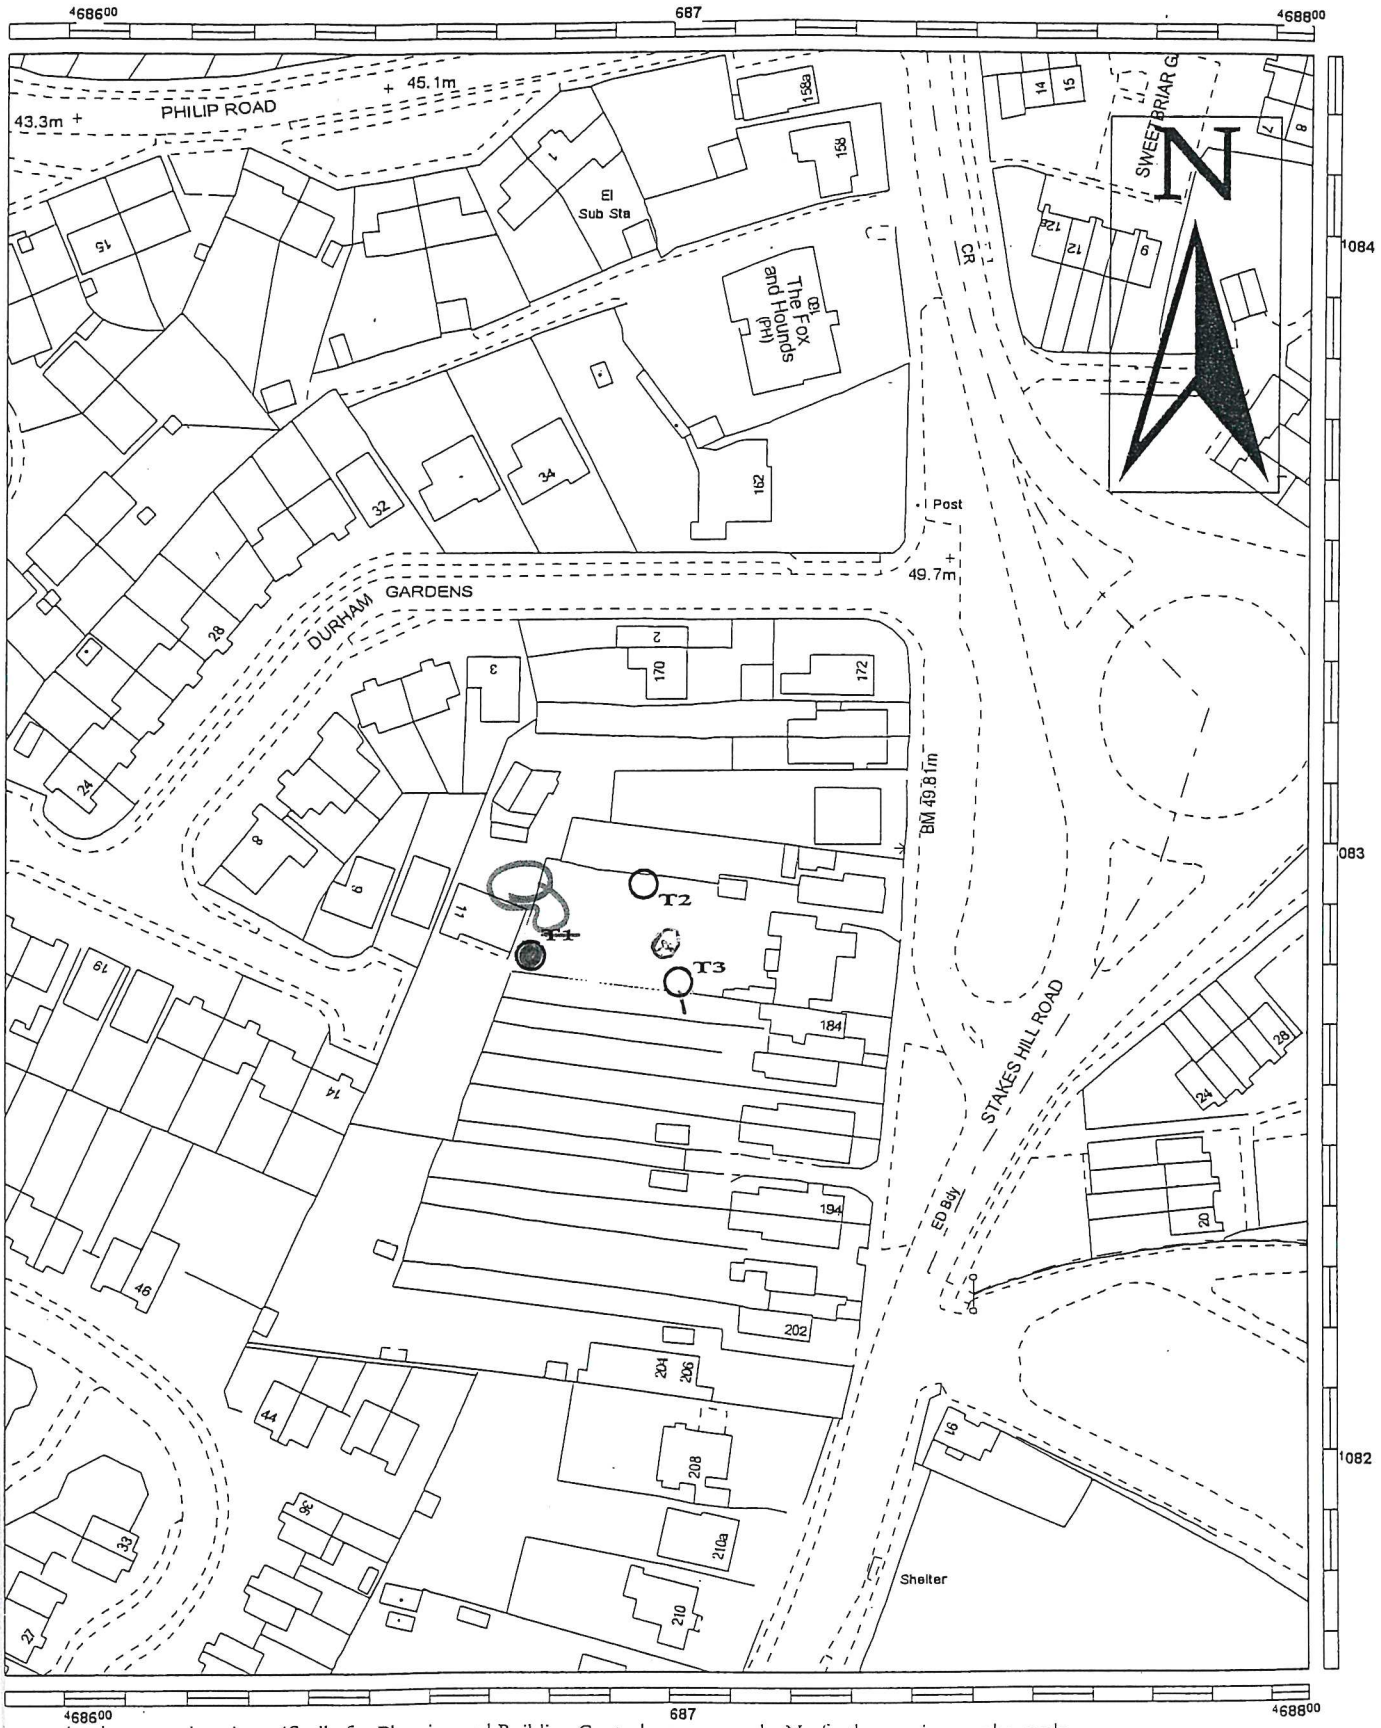


s copy has been produced specifically for Planning and Building Control purposes only. No further copies may be made.

Kingaby, ARICS Dip.Tp MRTPI,
ead of Planning &
evelopment.
vic Offices, Civic Centre Rd,
vant, Hants. PO9 2AX.
vant (01705) 474174.

Havant Borough Council

Title: TPO 1701
182 Stakes Hill Road
Waterlooville

~~T1~~	~~*Fraxinus excelsior*~~	~~"Common_Ash"~~
T2	*Fraxinus excelsior*	"Common_Ash"
T3	*Betula pendula*	"Silver_Birch"

Drawn By: KO

Scale: 1:1250

Drawing No.: T/ 1701 /01

Date: 21/07/98

Reproduced from the Ordnance Survey Digital Data with the permission of the Controller of HMSO, Crown Copyright Reserved 1997. Licence No LA078204.