

Notes


- This drawing is the property of fabrik ltd. It must not be copied or reproduced without written consent.
- Only figured dimensions are to be taken from this drawing. All contractors must visit site and be responsible for taking and checking all dimensions related to the works shown on the drawing.
- This drawing uses coloured lines. Please do not rely on a monochrome copy.





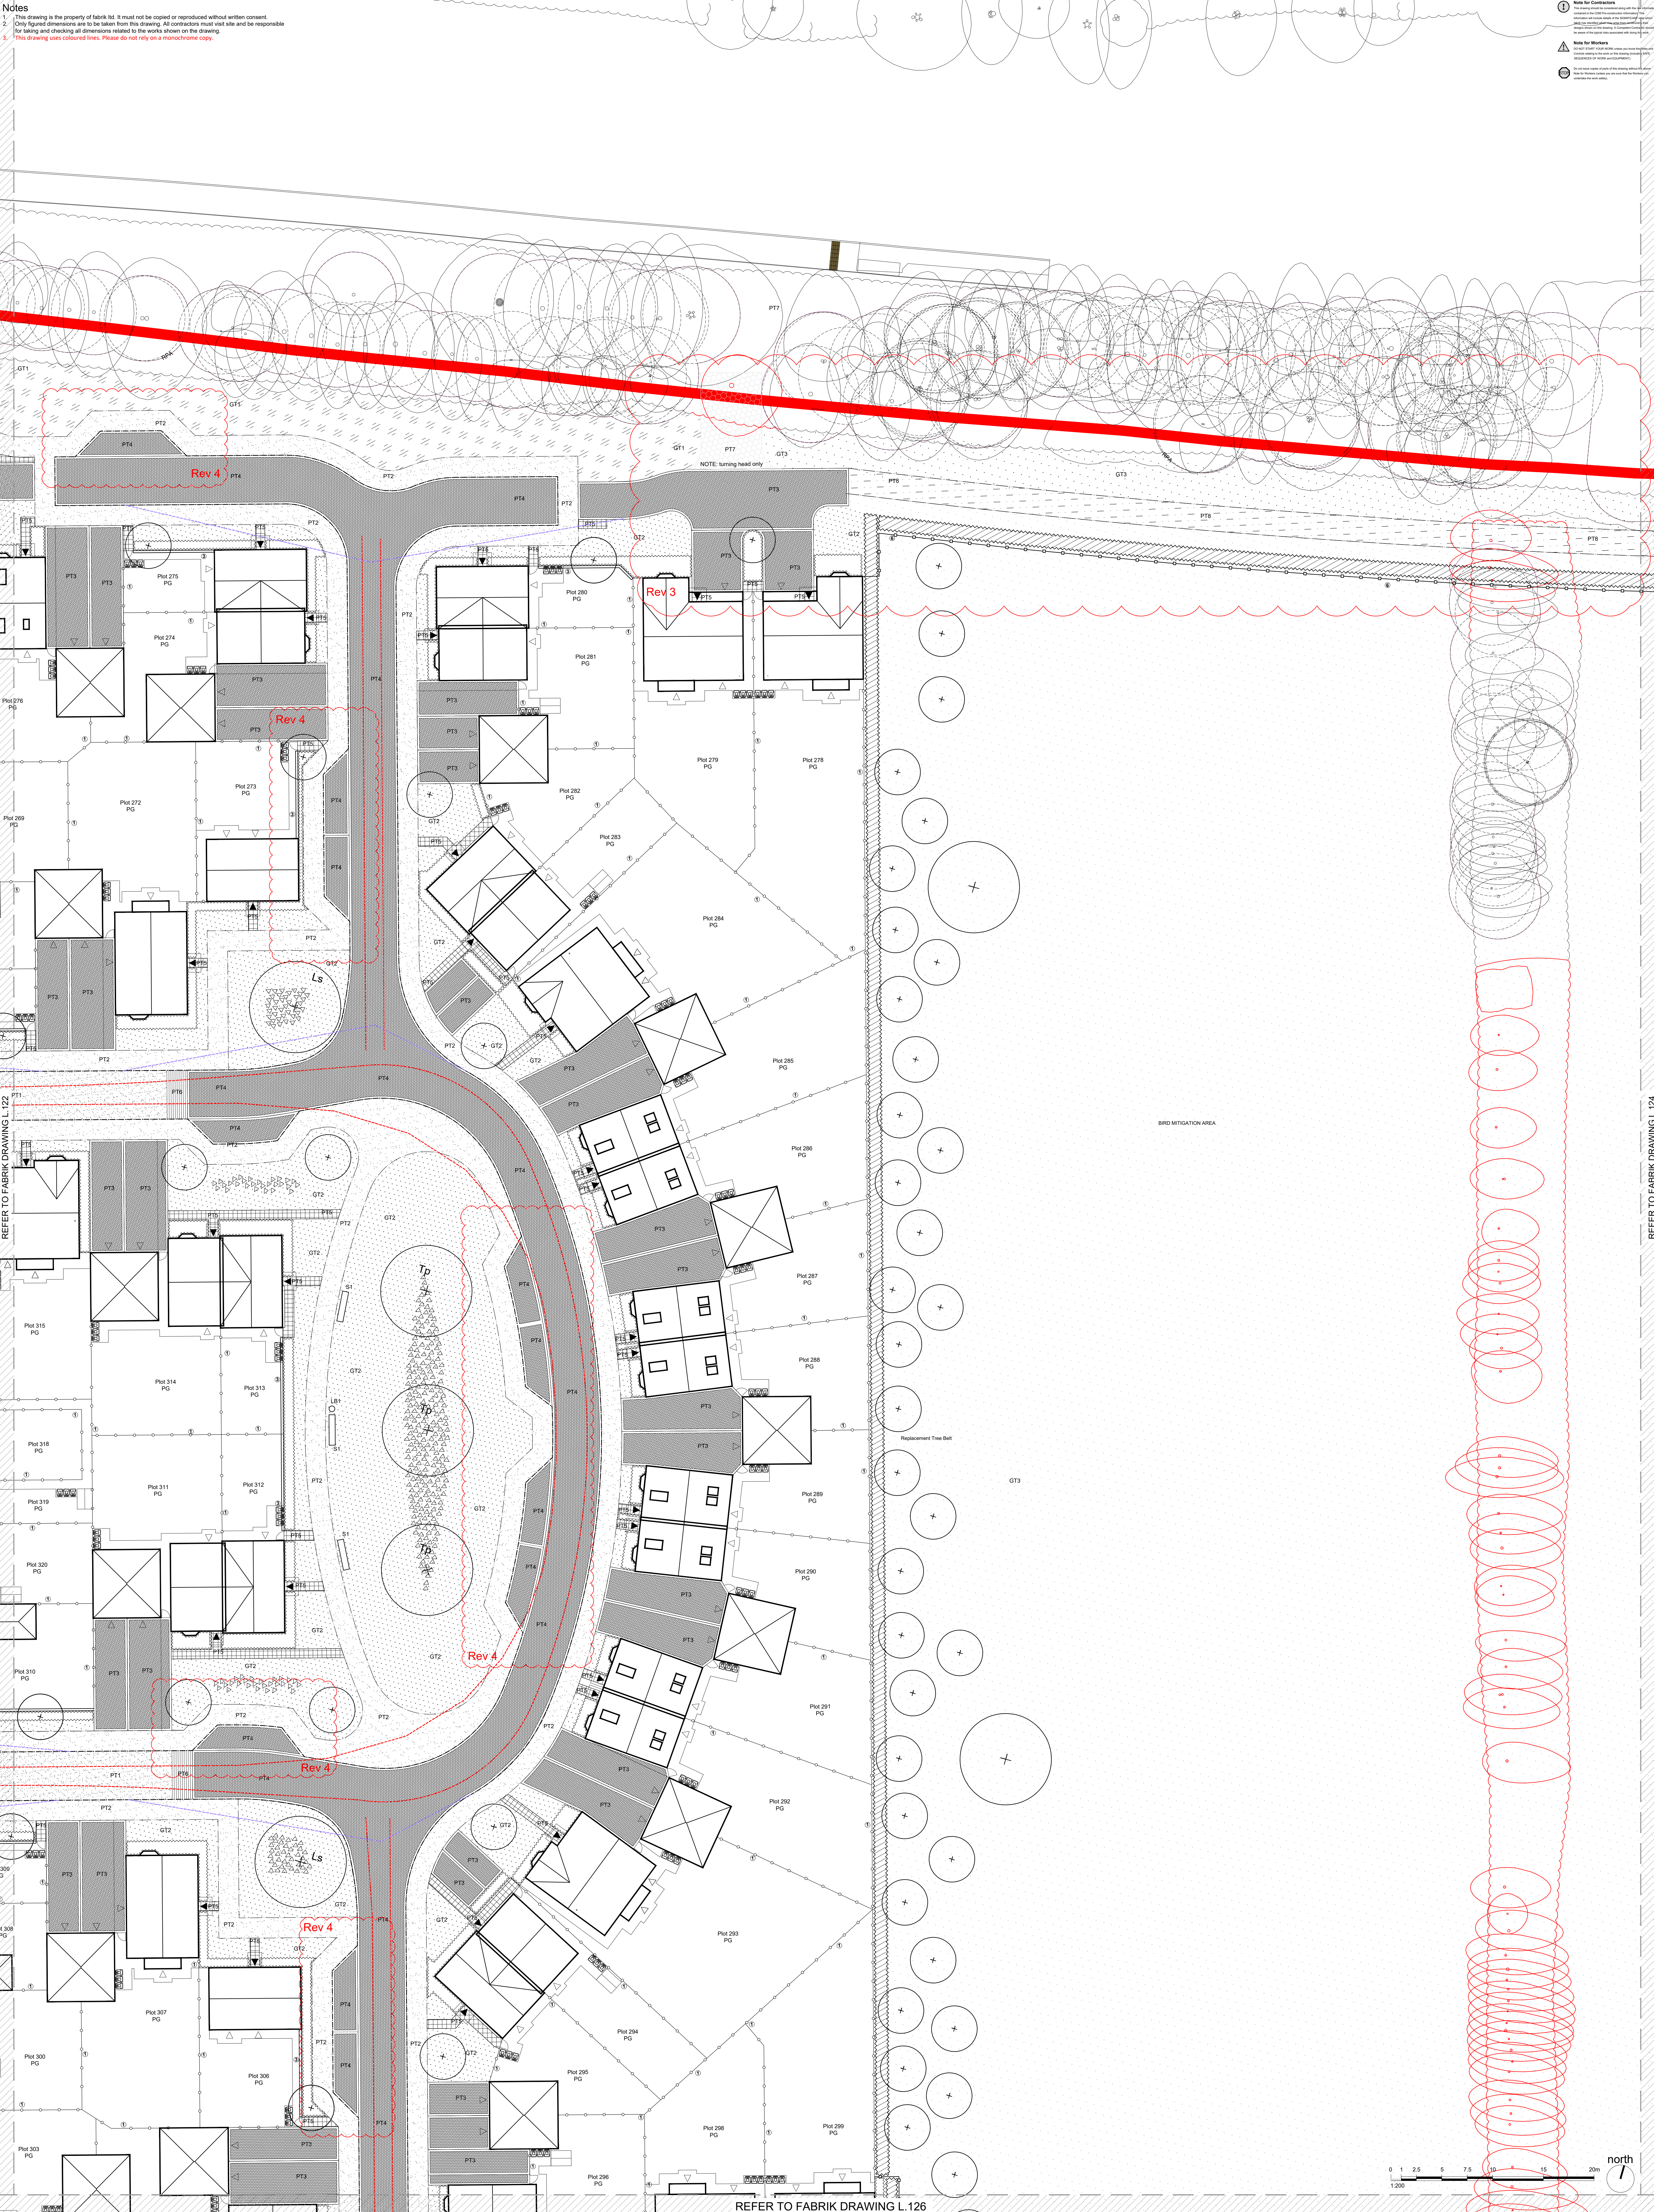

fabrik
Linden House
16 Linden Street
Alton
Hampshire
GU34 1HG

T : 01420 593250
E : info@fabrik.com
W : www.fabrik.com

120	121	122	123	124
129	128	127	126	125

Notes
The landscape design is subject to confirmation on all existing and proposed above and below ground services.

External References:

- D2434 Forty Acre Farm, Bedhampton/Drawings/Architect/Rev18-09-2019/Proposed Site Layout
- D2434 Forty Acre Farm, Bedhampton/Drawings/Architect/Rev18-04-20 car/home/PAD08_site
- D2434 Forty Acre Farm, Bedhampton/Drawings/Engineer/Rev18-04-18/Rev1805-E4519/07-2009 - Levels Strategy - Standard/999 - YR6/Fu-level strategy
- D2434 Forty Acre Farm, Bedhampton/Drawings/Engineer/Rev18-09-21 rcp highways/B05 E4519 Highway Strategy Plans/X-Highway-Layout/Review
- D2434 Forty Acre Farm, Bedhampton/Drawings/Site Survey/Rev18-09-20/08/01 - Forty Acre
- D2434 Forty Acre Farm, Bedhampton/Drawings/Site Survey/Rev18-04-20/16270-B12 - Standard/16270-B12

No.	Date	Reason
04	26_09_18	Updated to latest highways layout
03	21_08_18	Updated to latest architects base and to address officer comments
02	01_05_18	Updated to latest architects layout, boundary types added and existing tree retained.
01	26_04_18	Updated to latest architects layout

cam
cam
cam
clk
clk
Name

Project
Forty Acre Farm, Bedhampton
for Barratt David Wilson Homes Southampton

Drawing
Combined Hard and Soft Landscape General
Arrangement Plan (Sheet 4 of 10)

Scale
1:200 @ A0

Date
April '18

Checked
pb

Drawn
clk

Drawing No
D2434 L. 123

Revision
04

☐ Preliminary
☒ Issued for Planning Approval
☐ Issued for Construction

☐ Issued for Design Information
☐ Issued for Tender
☐ As Built

Drawing sheet size - A0
Copyright Reserved ©