DRIFTWOOD CAFE, 44 HIGH STREET, EMSWORTH

AS BUILT

NOTES:

Dimensions to be checked on site before commencing work. Any discrepancies shall be reported to the architect immediately.

Do not scale from these drawings except for planning purposes.

Use figured dimensions only.

Where applicable this drawing is to be read in conjunction with other consultants' drawings.

All drawings to be read in conjunction with specification and all other drawings including structural engineer and mechanical and electrical drawings / specification

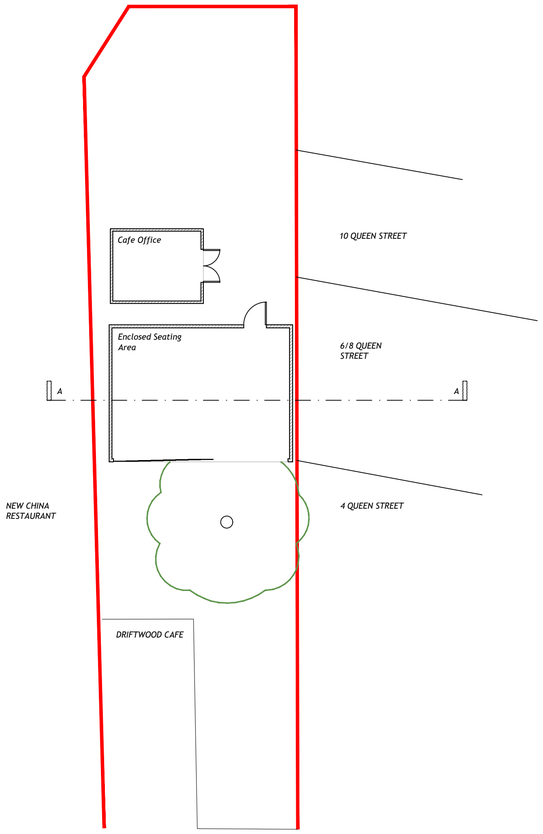

GROUND FLOOR PLAN
1:100

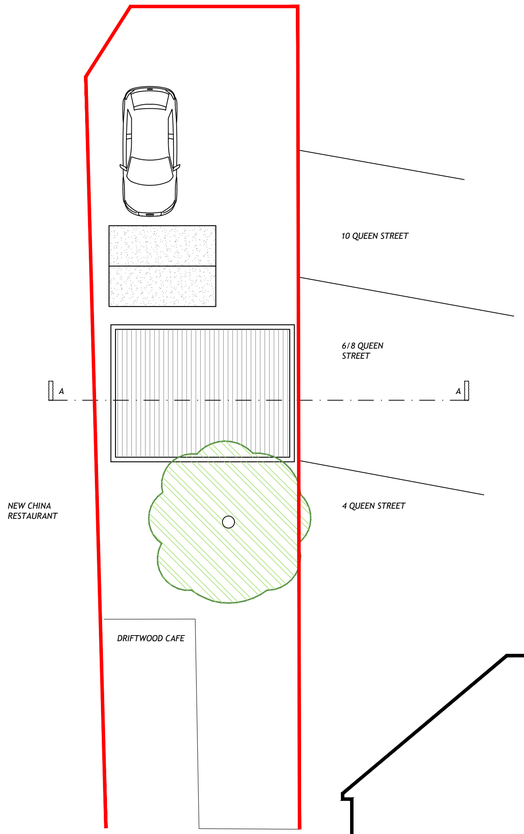

ROOF PLAN
1:100

BLOCK PLAN
Ordnance Survey (c) Crown Copyright 2018. All rights reserved. Licence number 100022432
1:500

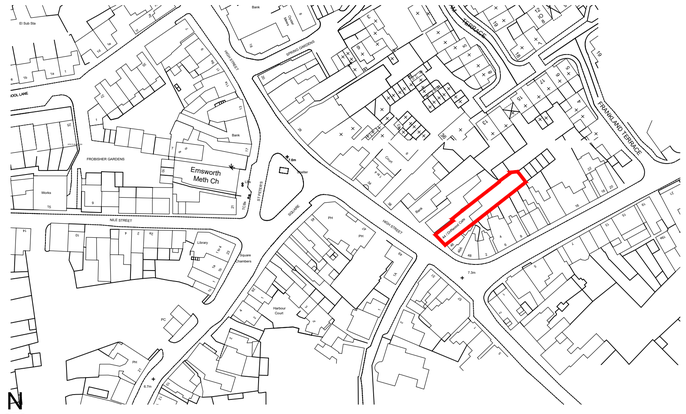

LOCATION PLAN
Ordnance Survey (c) Crown Copyright 2018. All rights reserved. Licence number 100022432
1:1250

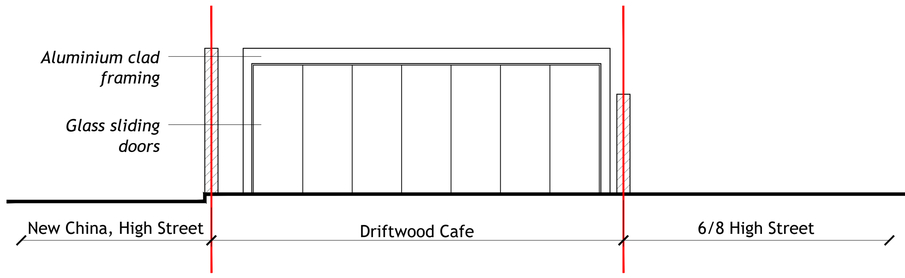

FRONT ELEVATION
[west] 1:100

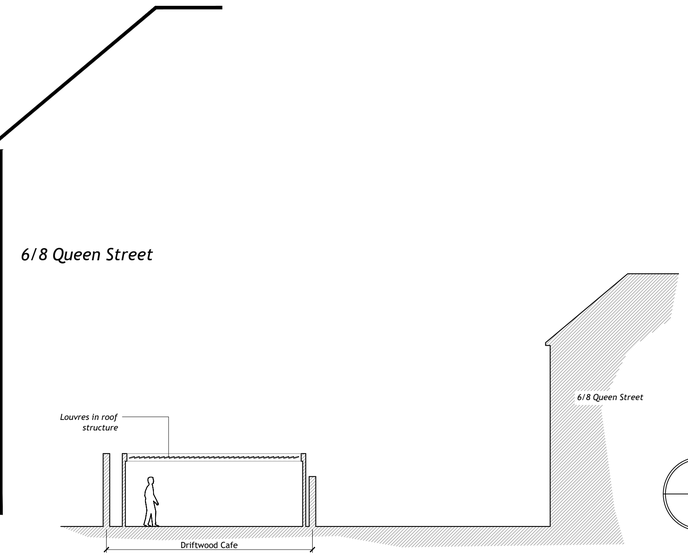

SECTION A-A
1:100

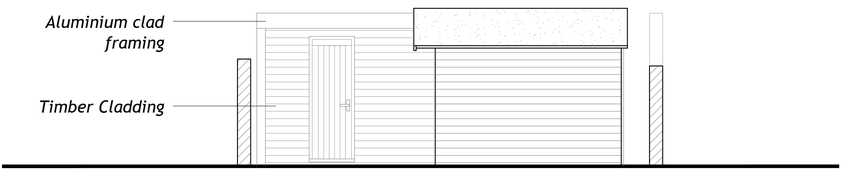

REAR ELEVATION
[east] 1:100

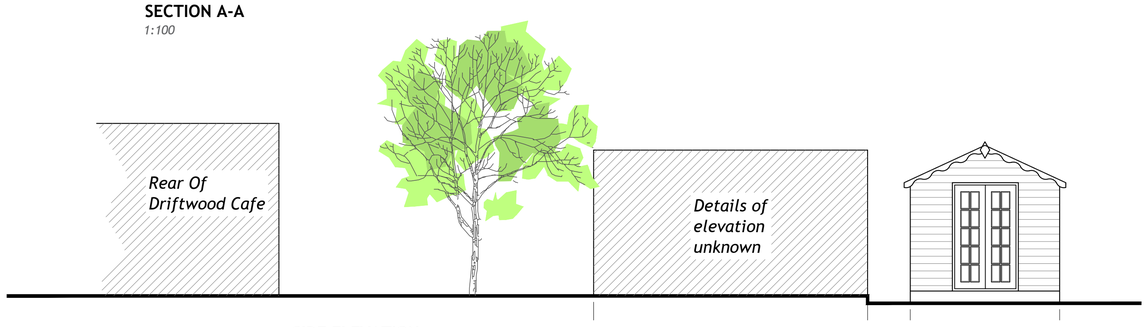

SIDE ELEVATION
[south] 1:100

REV	DATE	AMENDMENT	DRAWN

hd architects

Helyer Davies Architects Ltd
1 The Old Flour Mill,
Emsworth, PO10 7BT
01243 370 715

www.hdarchitects.co.uk mail@hdarchitects.co.uk

PROJECT
Driftwood Cafe
44 Highstreet
Emsworth
PO10 7AW

DRAWING
As Built Plans
As Built Elevations
As Built Section
As Built Location and Block Plan

SCALE
as noted @A1

DATE July 2018 DRAWN JF

DRAWING NUMBER
18112-02

REVISION
*