1 | E-01 Existing South Elevation (pre-installation)
- | 1:100

1 | E-01 Proposed South Elevation (as-installed)
- | 1:100

LEGEND

1. Installed air conditioning unit:
Mitsubishi air conditioning units
Models
MXZ-3F54VF3
MUZ-EF35VG
MUZ-EF25VG

2 | E-02 Existing West Elevation (pre-installation)
- | 1:100

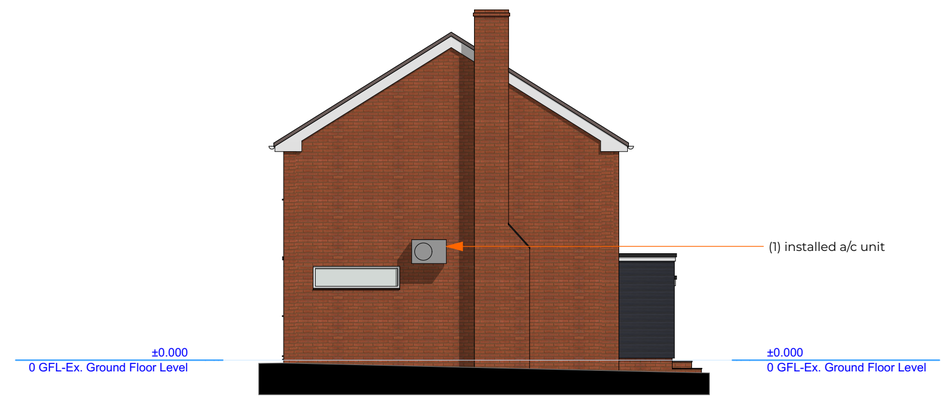

2 | E-02 Proposed West Elevation (as-installed)
- | 1:100

3 | E-03 Existing North Elevation (pre-installation)
- | 1:100

3 | E-03 Proposed North Elevation (as-installed)
- | 1:100

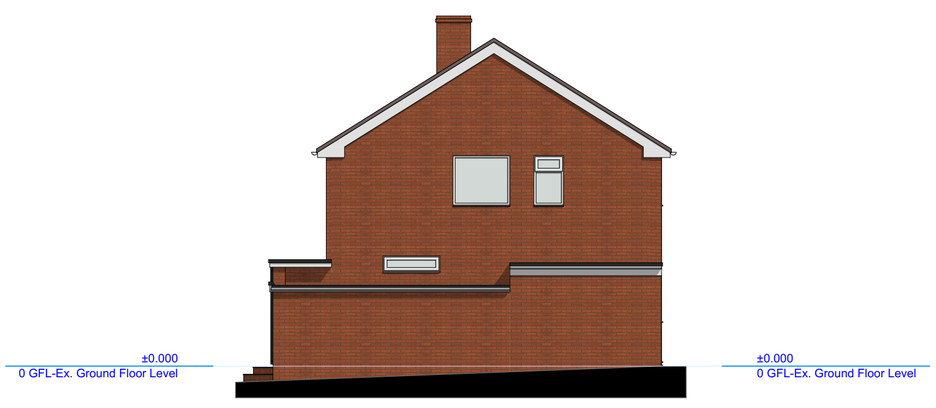

4 | E-04 Existing East Elevation (pre-installation)
- | 1:100

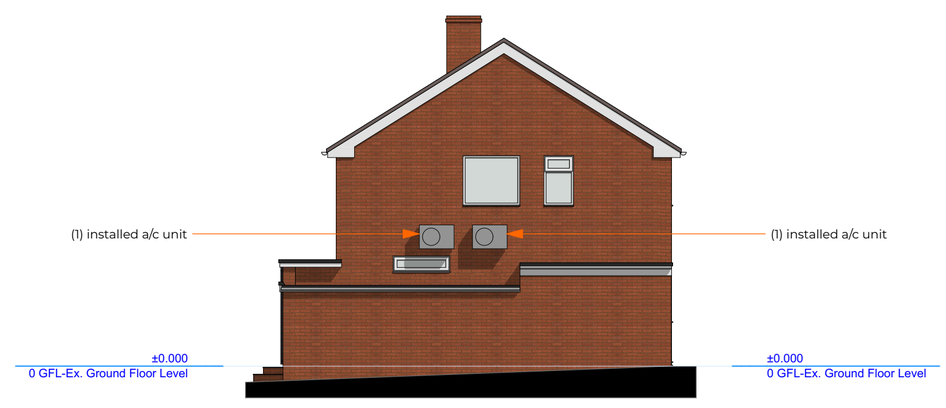

4 | E-04 Proposed East Elevation (as-installed)
- | 1:100

Scale 1:100
1 0 1 2 3 4 5m

Street scene and side views of '4 Bramley Close' and installed air conditioning units/neighbouring properties

client
Mr. K. Rashid

project
Retrospective planning application for
3x air conditioning units (installed)
4 Bramley Close, Waterlooville. PO7 7SU.

drawing title
'Indicative' Elevations
(Pre-installation of and as-installed a/c units)

date
05 July 2022

project number/drawing number
0729-01.002.01

scale
1:100

paper size
A1

revision

RevID	ChID	Transmittal Set Name	Date
01		Retrospective Planning Application	05/07/2022

status/purpose/disclaimer
☐ preliminary ☐ planning ☐ building regulations
☐ production ☐ tender ☐ construction ☐ as built ☐ other

studio
The Steven Barlow Partnership
The Studio, 81 Manor Road,
Portsmouth, Hampshire. PO1 5LB.
United Kingdom.

call +44 (0) 800 756 9776
email info@tsbp-architecture.co.uk
visit (https://) tsbp-architecture.co.uk

This drawing is protected by copyright of THE STEVEN BARLOW PARTNERSHIP under The Copyright, Designs and Patents Act 1988 and the reproduction or use in any form without prior written consent from THE STEVEN BARLOW PARTNERSHIP will be an infringement of copyright.

Only the original drawing should be relied on. Plans are liable to distortion in transmission to the web. Do not scale off this drawing in any event except for planning application purposes. Figured dimensions must be used if in doubt contact THE STEVEN BARLOW PARTNERSHIP.

Contractor to check and verify all levels, datum's and dimensions on site and shall report any discrepancies or omissions to THE STEVEN BARLOW PARTNERSHIP prior to commencement of work and during construction phase. This drawing is to be read and understood in conjunction with structural, mechanical, electrical and/or any other consultant/s documentation as may be applicable to the project prior to the commencement of work and it's duration.

This drawing including notes has been prepared and produced for the client named for the project detailed and solely for the purposes indicated and is not intended for use by any other person or for any other purpose.

© Copyright 2022 - The Steven Barlow Partnership (TSBP Architecture)
Chartered Institute of Architectural Technologists Chartered Practice
Principal - Steven V. Barlow FCIAT

4 Bramley Close, Waterlooville. PO7 7SU.