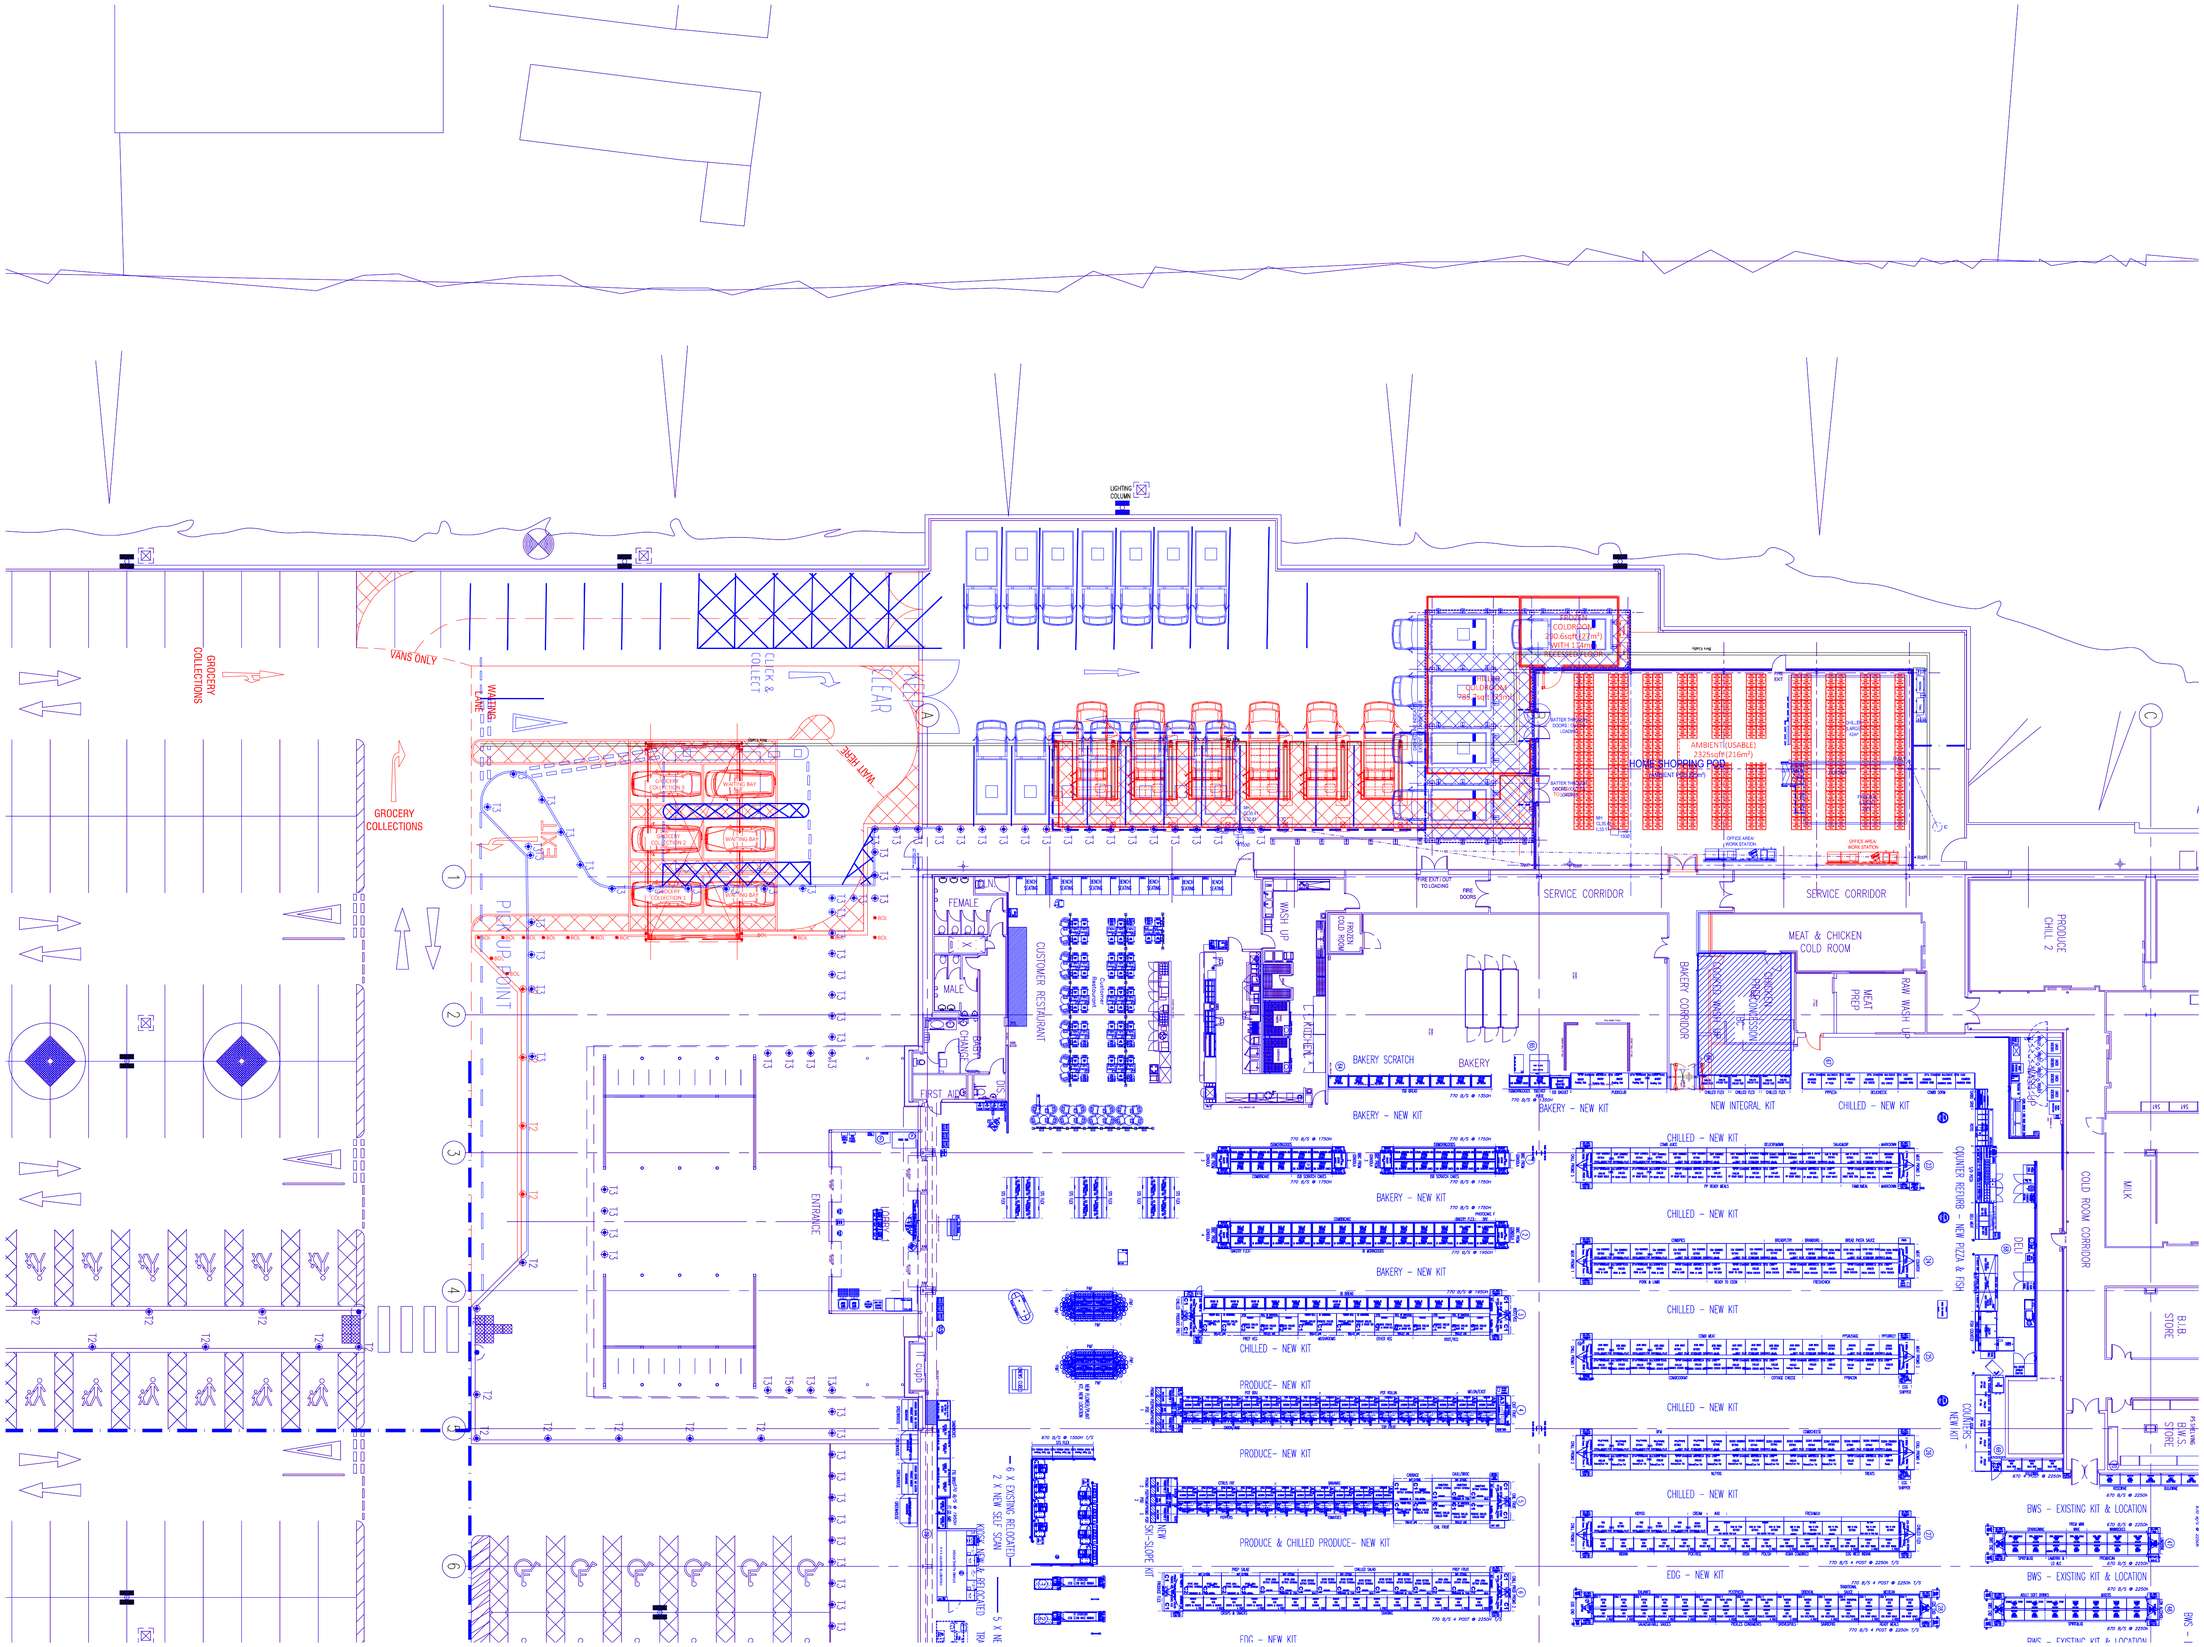

1 PL_08 EXISTING AND PROPOSED OVERLAY

Scale 1:200 @ A1

0m 2 4 6 8 10 12 14 16 18 20

1:200

© Whittam Cox Architects - Disclaimer:

This drawing is copyright of WCEC Group Ltd trading as Whittam Cox Architects, and shall not be reproduced nor used for any other purpose without the written permission of the Architects. This drawing must be read in conjunction with all other related drawings and documentation. It is the contractors responsibility to ensure full compliance with the Building Regulations. Do not scale from this drawing, use figured dimensions only. It is the contractors responsibility to check and verify all dimensions on site. Any discrepancies to be reported immediately. IF IN DOUBT ASK.
Materials not in conformity with relevant British or European Standards/Codes of practice or materials known to be deleterious to health & safety must not be used or specified on this project.

NOTES :

This drawing is to be read in conjunction with the following Whittam Cox Architects and ASDA documentation :

- Project specific Scope Of Works

Any discrepancies between this drawing and the above should be reported to the contract administrator.

C.D.M :

There are **NO SIGNIFICANT** risks associated with the works on this drawing that a competent contractor would not forsee

KEY TO LINETYPES :

Red lines = **PROPOSED LAYOUT**

Blue lines = **EXISTING LAYOUT**

No.	Date	Description	Drawn/Chkd By
A	14/06/21	Second Issue. Additional van loading bay.	MS / SJS
-	17/05/21	First Issue.	MS/SJS

PLANNING

CLIENT

ASDA

PROJECT

PROPOSED HOME SHOPPING
ASDA HAVANT

TITLE

EXISTING & PROPOSED
HOME SHOPPING
OVERLAY

DRAWING STATUS

PLANNING

DRAWN	MS	CHECKED	SJS
SCALE	1:200 @ A1		
DATE	MAY 2021		

Whittam Cox ARCHITECTS
Chesterfield / 01246 260261
London / 020 3388 0019
Leeds / 0113 3366018
whittamcox.com

JOB NO.	DRAWING NO.	REV
200486	PL_08	A