


DO NOT SCALE FROM THIS DRAWING.
ALL DIMENSIONS TO BE CHECKED ON SITE.
FOR REFERENCED VIEWS REFER TO DWF- BAMD- Z2- GF- DR- A
SERIES OF DRAWINGS
Status Code for defined in BS1192:
Work in Progress (WIP)
S1 - Initial Status or WIP
S2 - Issued for co-ordination
S3 - Issued for internal review
S4 - Issued for construction approval
Shared
Documentation (Pre-construction)
D1 - Issued for costing
D2 - Issued for tender
D3 - Issued for contractor design
D4 - Issued for
Documentation (Construction)
A - Issued for construction
B - Issued for construction but with comments
C - Comprehensive revision required
Active
AB - Record Drawing

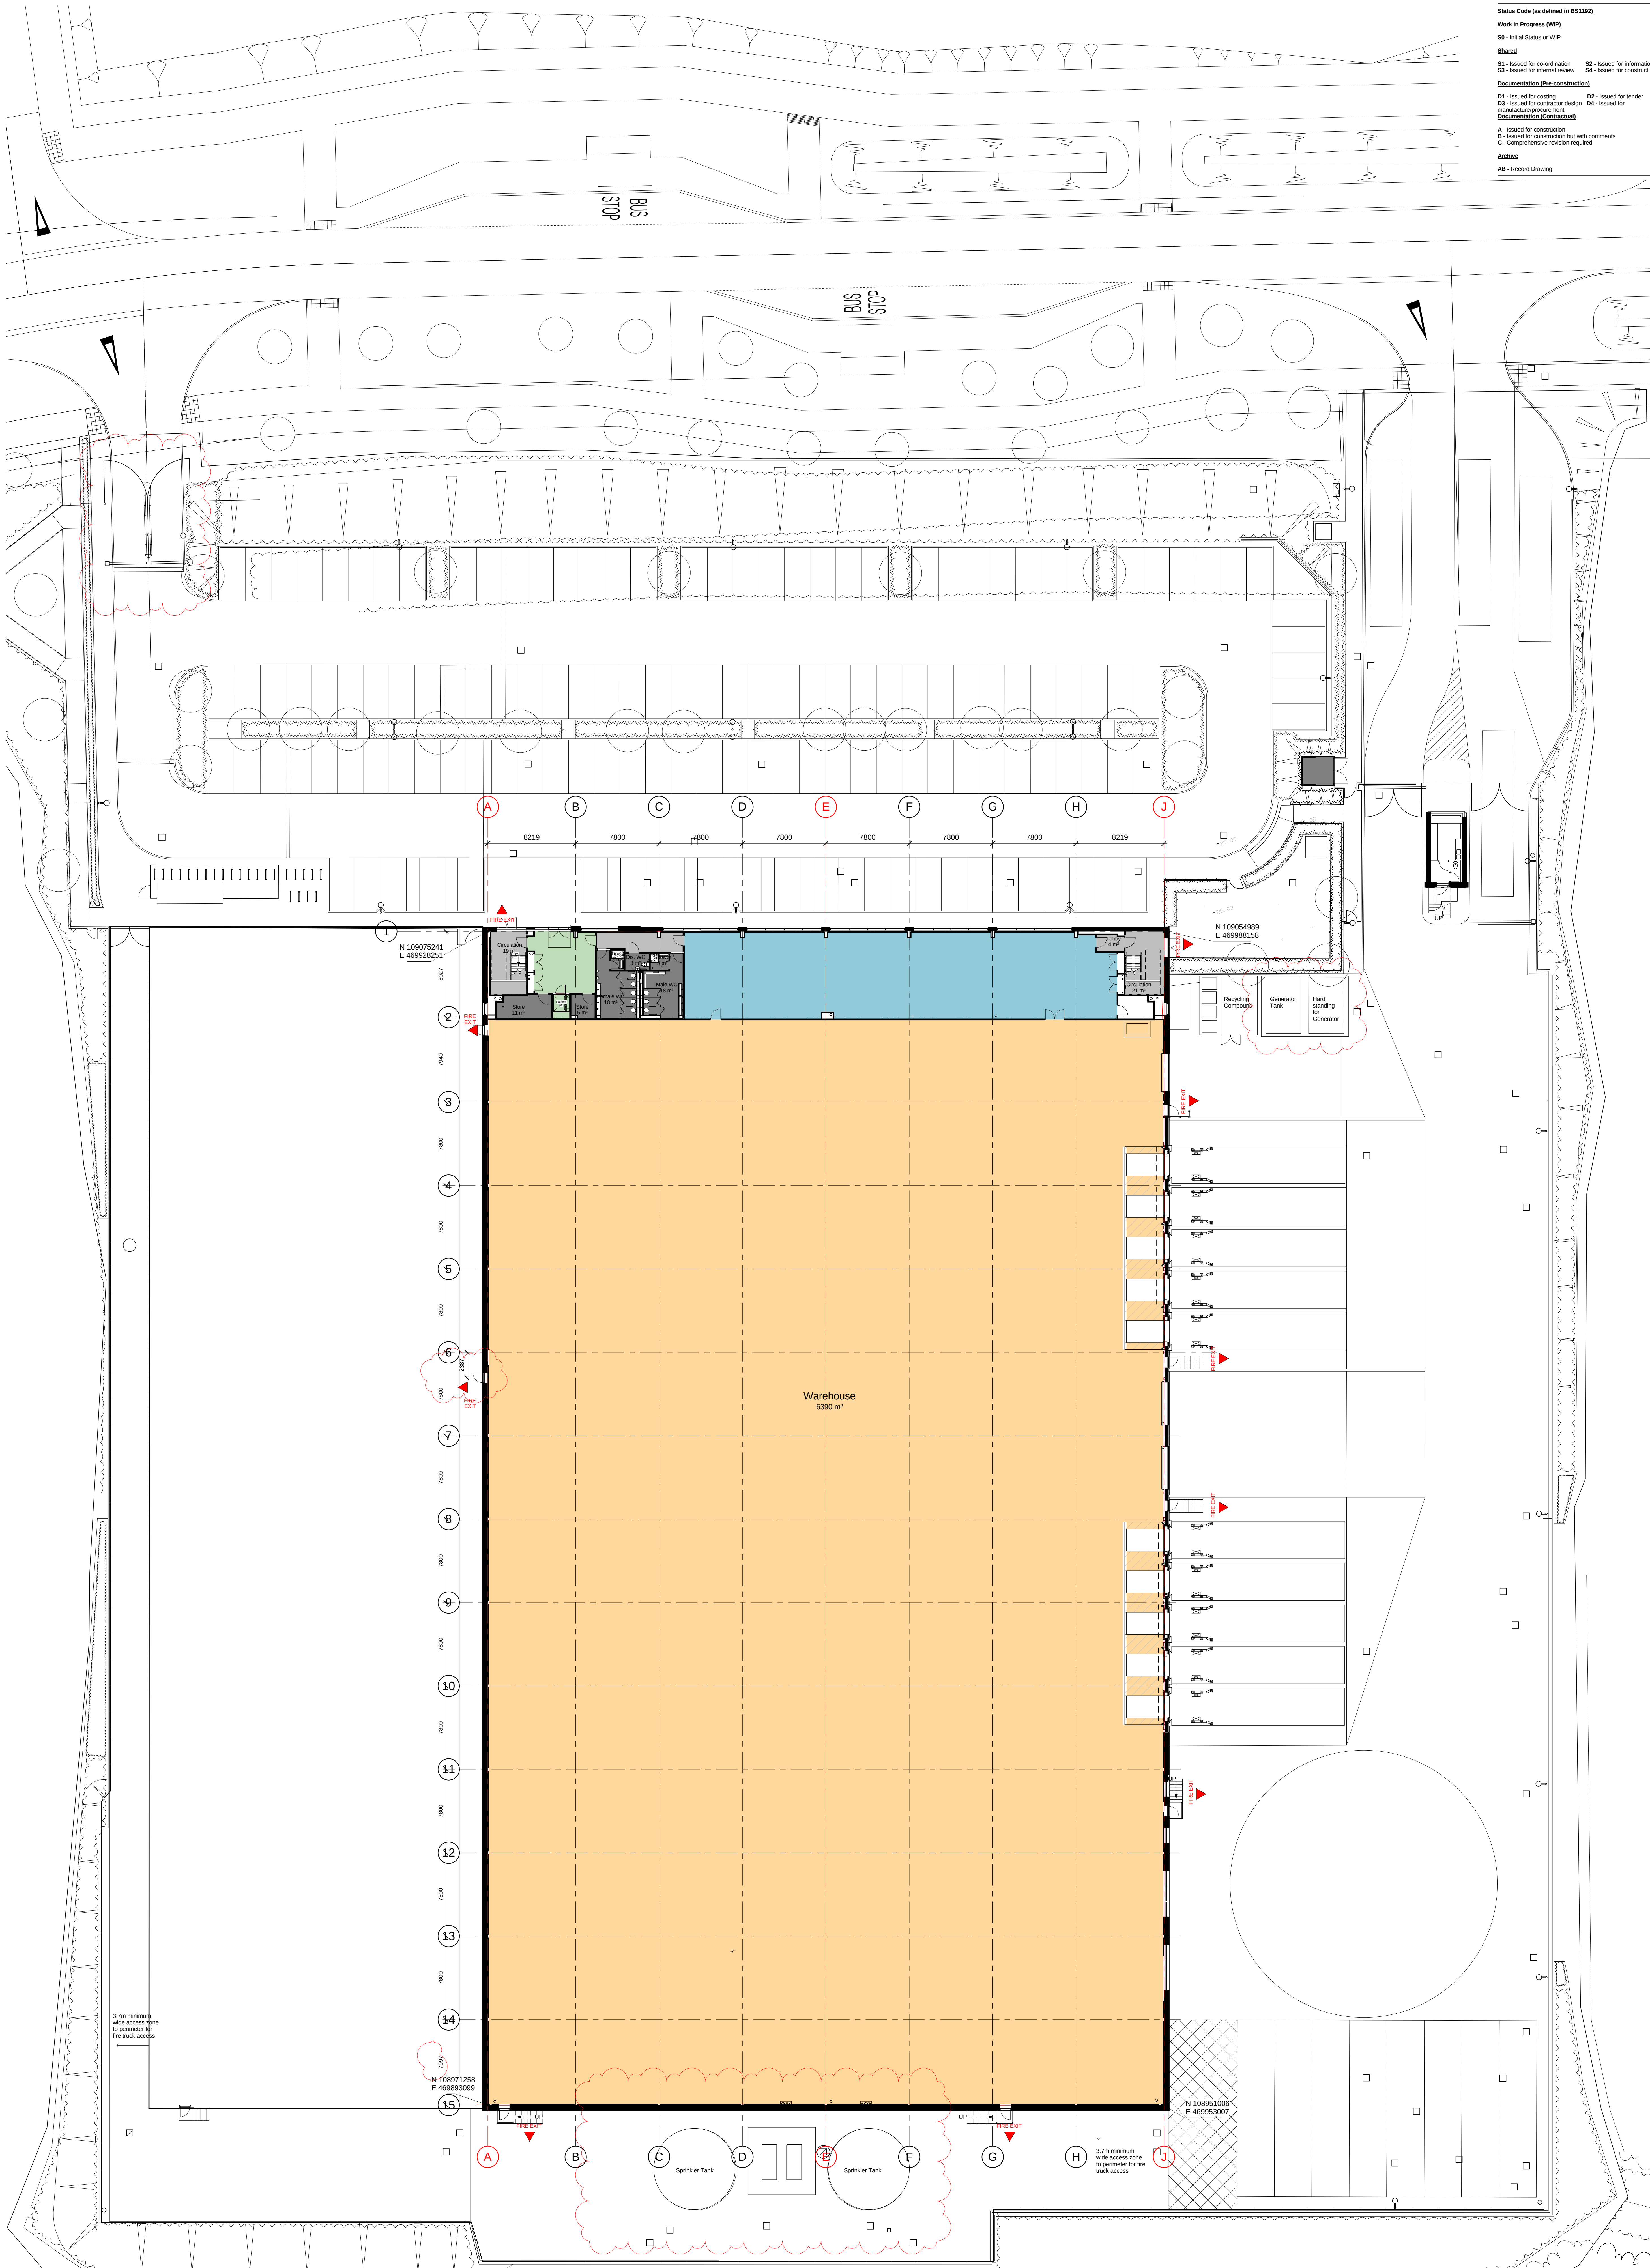

Department Legend

- Admin
- Circulation
- Office
- Toilets and Servicing
- Warehouse Floor

1 00 - Ground Floor Cat B
1 : 200

Portsmouth
CITY COUNCIL

bam

BAM Design
Architectural
Structural Engineering
Environmental Services
Building Information Systems

B8 Warehouse, Plot 2
Dunsbury Hill Farm

Ground Floor GA Plan -
Portsmouth CC Cat. B

Scale: 1 : 200 @ A0
Date: 31/07/15
Drawn: JW
Checked: SL
BAM job no.: 4487
Rev: A
DHF- BAMD- Z2- GF- DR- A- 11001 P21

P21 JR JR 24.10.15 Landscape underlay updated for NMA following changes requested by FF 15.09.15
P20 JW JR 05.04.16 WHB Numbers updated

info@bam.co.uk
www.bam.co.uk