© INTERSECT SURVEYS
NOT TO BE REPRODUCED WITHOUT PERMISSION

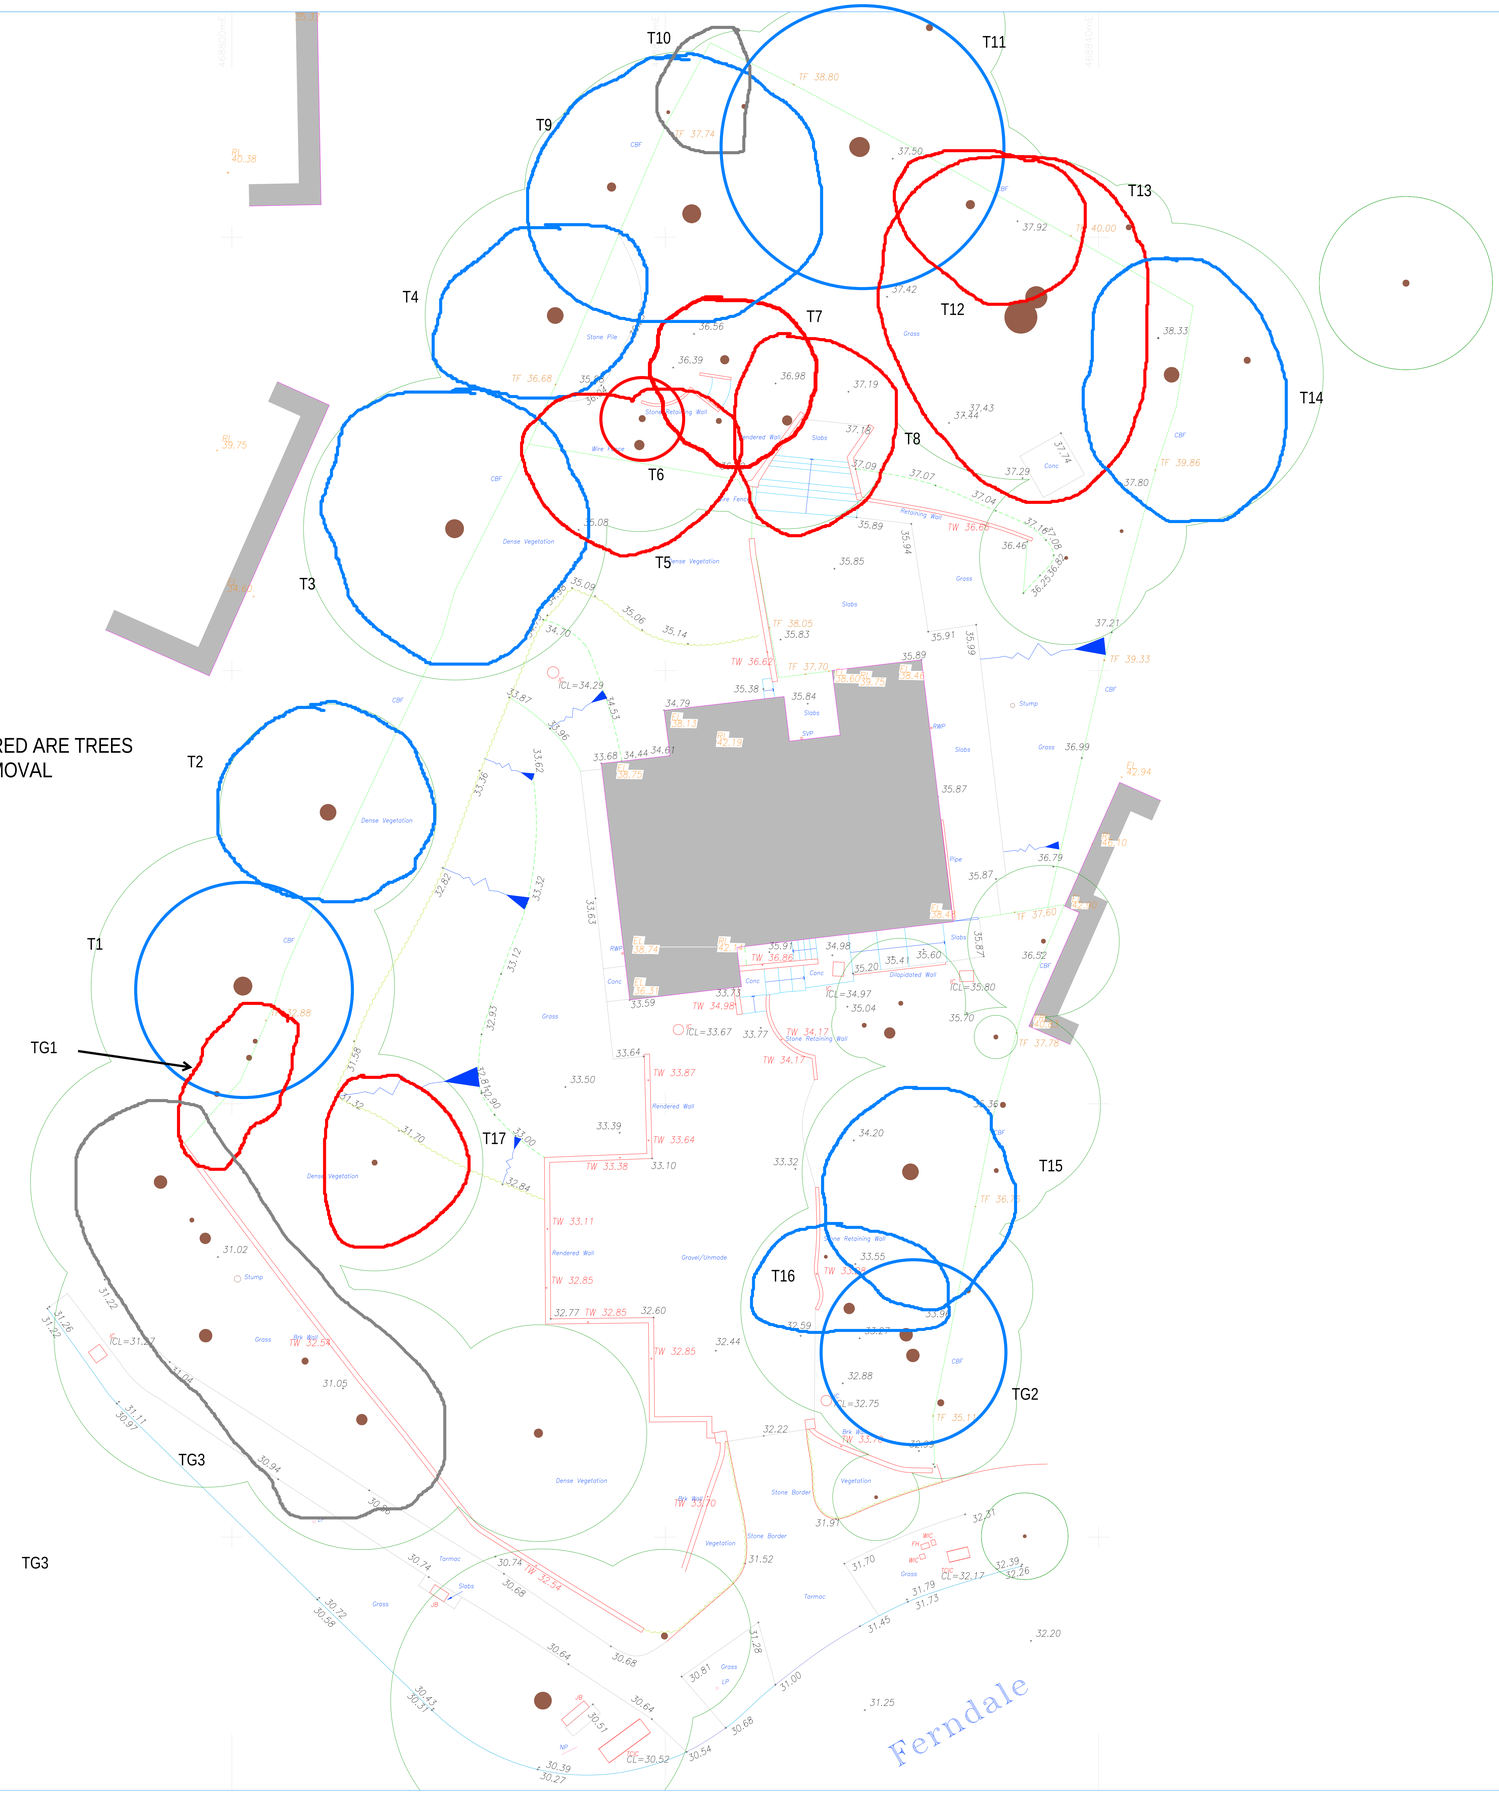

CROWN SPREADS SHOWN IN RED ARE TREES PROPOSED FOR REMOVAL

N

DATUM NOTES

THE SURVEY GRID SHOWN ON THIS DRAWING IS POSITIONED ON ORDNANCE SURVEY (OS) NATIONAL GRID, OBTAINED BY MULTIPLE NETWORK RTK GPS OBSERVATIONS.

DRAWING UNITS ARE METRES.

ALL LEVELS ARE IN METRES AND ARE ABOVE ORDNANCE SURVEY NEWLYN DATUM DERIVED BY ACTIVE GPS OBSERVATIONS TAKEN OVER AN EXTENDED PERIOD OF TIME.

ALL QUOTED DIMENSIONS ARE IN METRES.

This drawing has been produced for the purpose of the original commissioning agent.
Intersect Surveys will accept no responsibility for details that are subsequently found to be the consequence of undisclosed facts or that were obscured from view at the time of survey or that have been altered since the survey.
All data remains the property of Intersect Surveys until full payment has been received.

ABBREVIATIONS

AB	Air Brick	DH	Duct Height	PRF	Post & Rail Fence
BO	Ballard or Bollom Heights	DP	Down Pipe	PWF	Post & Wire Fence
BB	Belisha Beacon	ECB	Electricity Control Box	R	Render
BO	Back Drop	ELEC	Electricity	RAD	Radiator
BH	Borehole or Beam Height	EP	Electricity Pole	RE	Reading Eye
BL	Bollard	FB	Fence Base	RG	Reading Ground
BP	Brick Pierions	FH	Fire Hydrant	RS	Road Sign
BRW	Brick Retaining Wall	FL	Floor Level	RSJ	Rolled Steel Joist
BS	Bus Stop	G	Gully	RWP	Rain Water Pipe
BT	British Telecom	GV	Gate Valve	S	Spread or Share
BTCB	BT Control Box	H	Height in Metres	SC	Stop Cock
BW	Brick Wall	H	Window Head Height	SL	Soffit Level or Skylight
BWF	Barbed Wire Fence	HT	Height	SP	Arch Springer Height
C	Centre Line Height	I	Inspection Cover	SPB	Single Parking Bollard
CB	Control Box	IL	Invert Level	SW	Stone Wall
CBF	Close Boarded Fence	IRF	Iron Railing Fence	TCSJ	Traffic Control
CBW	Concrete Block Wall	IWF	Interwoven Fence	T	Top Heights
CCB	Cable TV Control Box	KO	Kerb Outlet	TL	Traffic Light
CF	Concrete Panel Fence	L	Light	TP	Telephone Pole
CL	Cover Level	LP	Lamp Post	UTL	Unable To Lift
CLF	Chain Link Fence	MH	Manhole	UTT	Unable To Trace
CPF	Concrete Post & Panel Fence	MK	Mark Point	V	Vent
CRF	Concrete Panel Fence	OH	Open Flow Pipe	VP	Vent Pipe
CPS	Concrete Paving Slabs	OH	Overhead	W	Window
CR	Arch Crown Height	P	Post	WL	Water Level
CRW	Concrete Retaining Wall	PALF	Palisade Fence	WM	Water Meter
CT	Cable Telephone	PF	Post & Fence	WPF	Wooden Post Fence
CTV	Cable Television	PT	Trial Pit	WRF	Wooden Panel Fence
CW	Concrete Wall	PL	Pavement Light	WV	Water Valve
D	Diameter or Doors	PM	Parking Meter	Ø	Diameter

KEY

- Top / Bottom — BANKS
- OVERHEAD CABLES
- EDGE OF VEGETATION
- GATE
- SURVEY STATION
- O.S BENCH MARK

Revision	Description	Date

Drawing Status:

INTERSECT SURVEYS
T: 020 3857 4831 M: 07535 236 812
www.intersectsurveys.co.uk

Client: THORNS YOUNG

Project: 1 FERNDALE, PO7 7NZ

Title: TOPOGRAPHICAL SURVEY

Drawn: KD	Surveyed:	Date: 19.12.19
Cad File: 50401-001		Scale@A1 100
Drawing Number 50401-001		Revision A