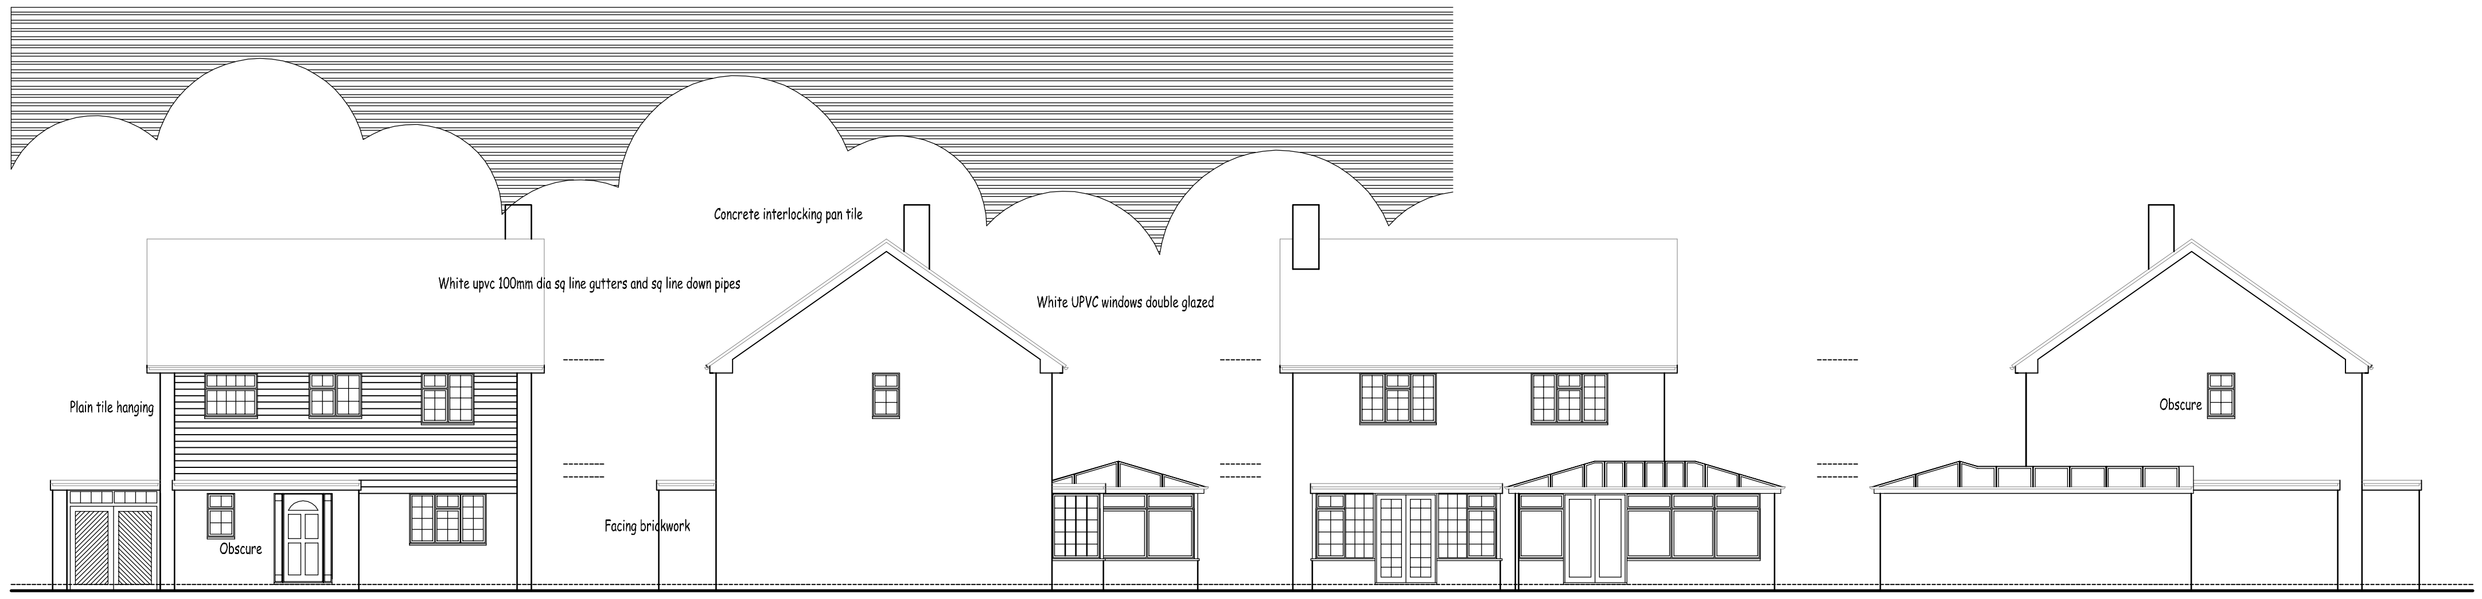


# Billet Avenue

## Waterlooville, Hampshire.

0 1M Scale 1:100 10M

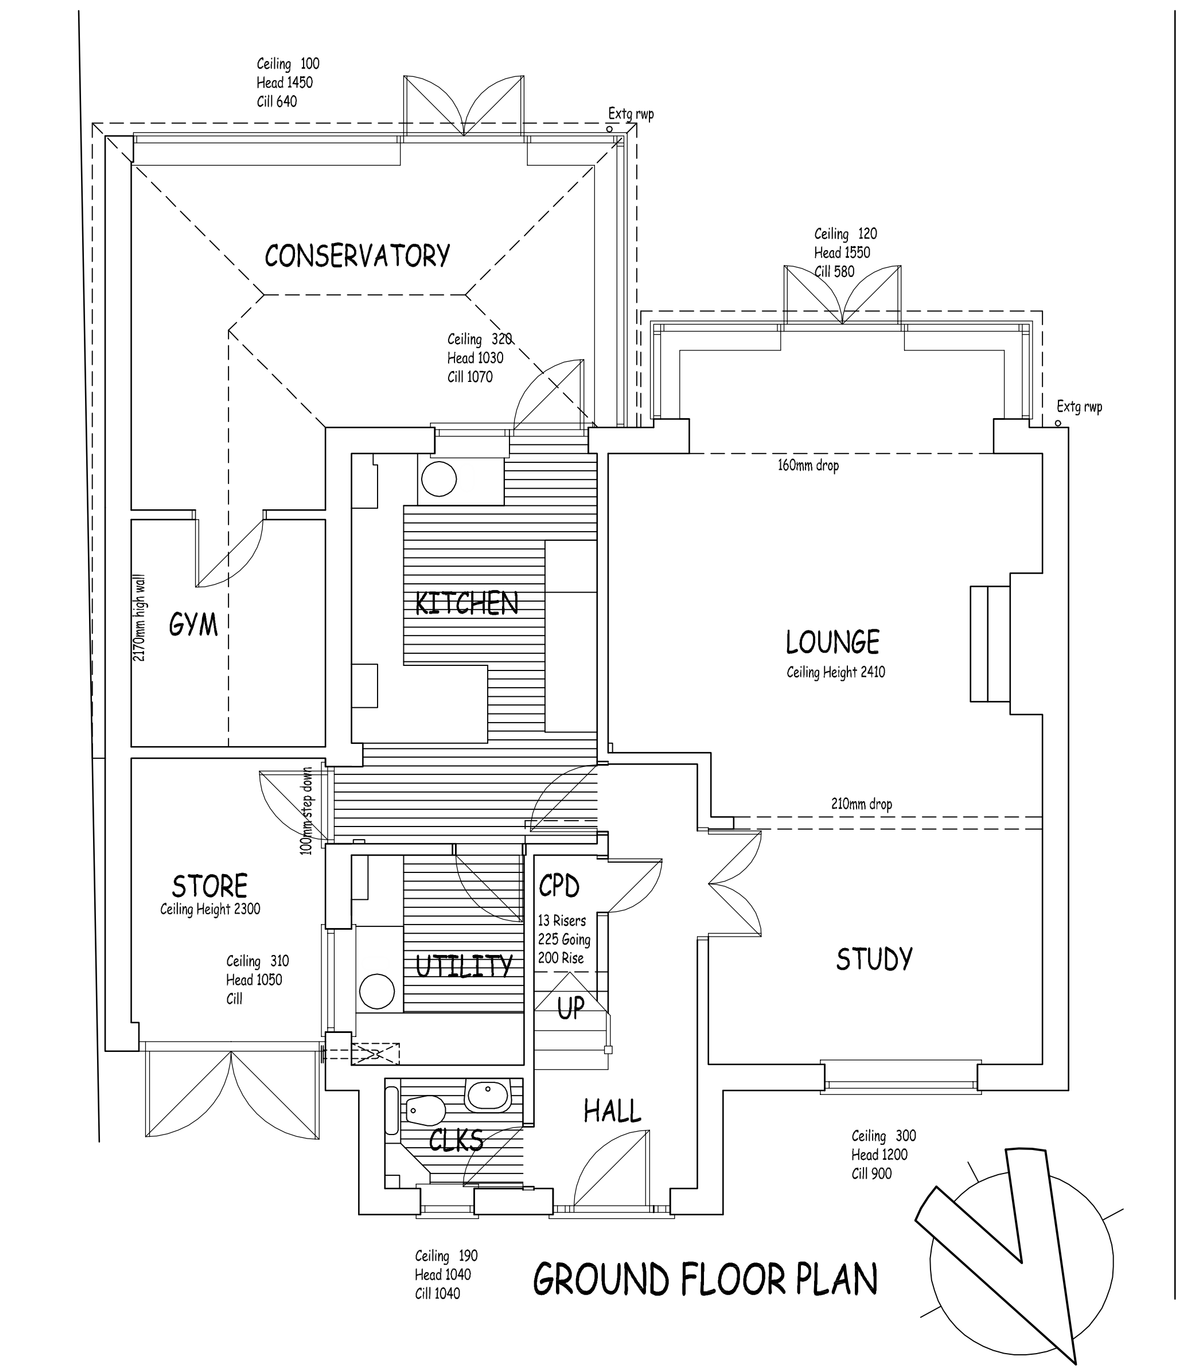


GROUND FLOOR PLAN

0 1M Scale 1:50 10M

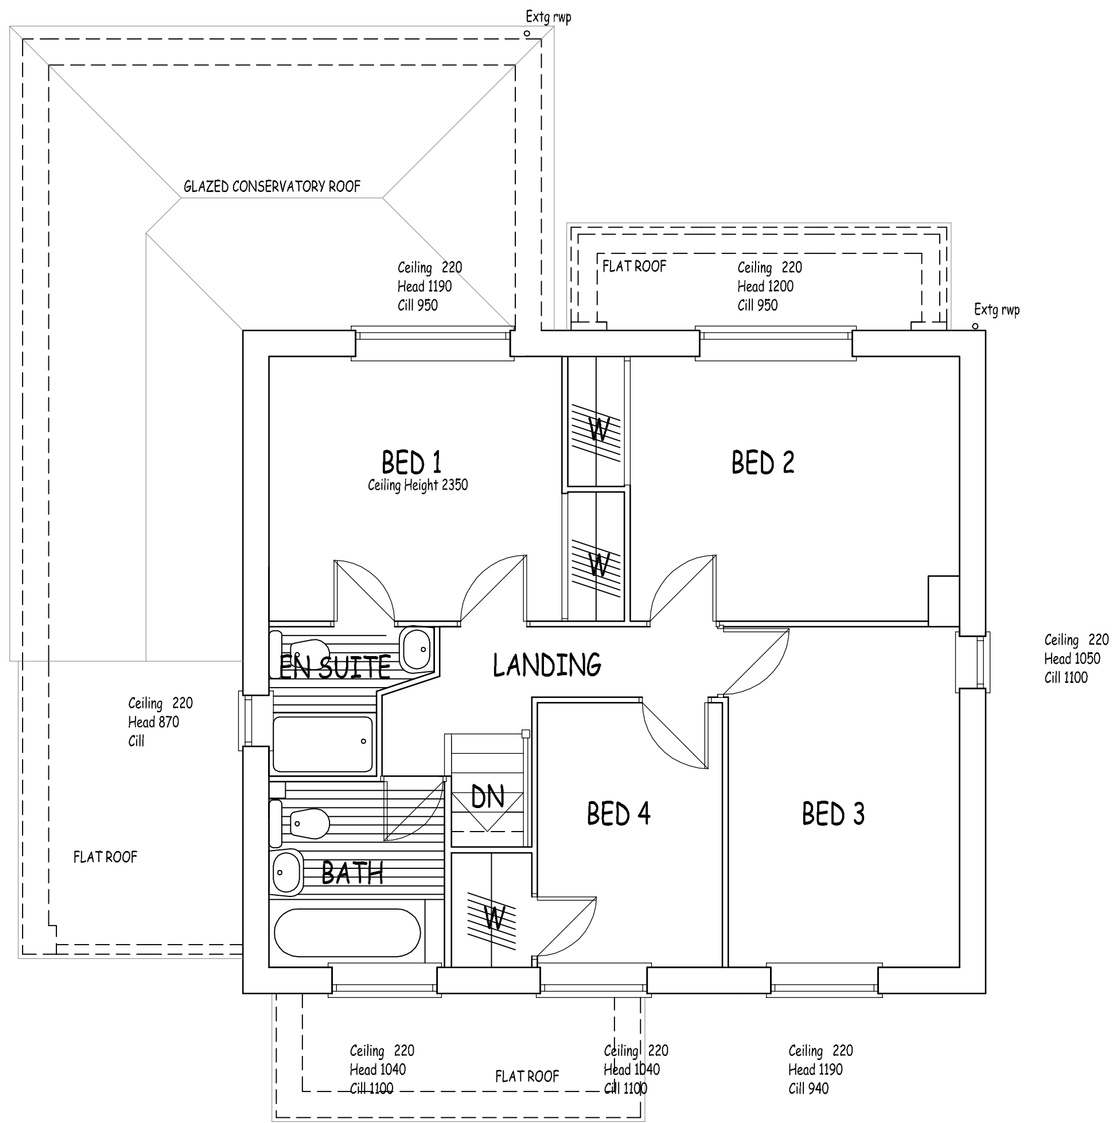


FIRST FLOOR PLAN

A 09/08/16 CLIENT DETAILS CHANGED

This drawing is protected by copyright and may not be copied or disclosed to third parties without the expressed permission of Town & Country Architecture.

Preference should be given to written figured dimensions over scale measurements. Discrepancies of any kind must be reported to Town & Country Architecture.

TOWN & COUNTRY ARCHITECTURE
ARCHITECTURAL TECHNOLOGISTS & PLANNING CONSULTANTS
4 FOXGLOVES
THE MEADOWS
FAREHAM
HAMPSHIRE PO16 8UW
TELEPHONE: (01329) 238492
FACSIMILE: (01329) 238492

PROJECT
AS BUILT PLAN
2A Billet Avenue
Waterlooville
Hampshire

CLIENT
Mr.& Mrs.B.Russell
-

SCALE 1:50 1:100

DATE

DRAWN P.T.E MCIAT ACIOB -

CHECKED

DRWG. NO. 12/24/01

REVISION A