
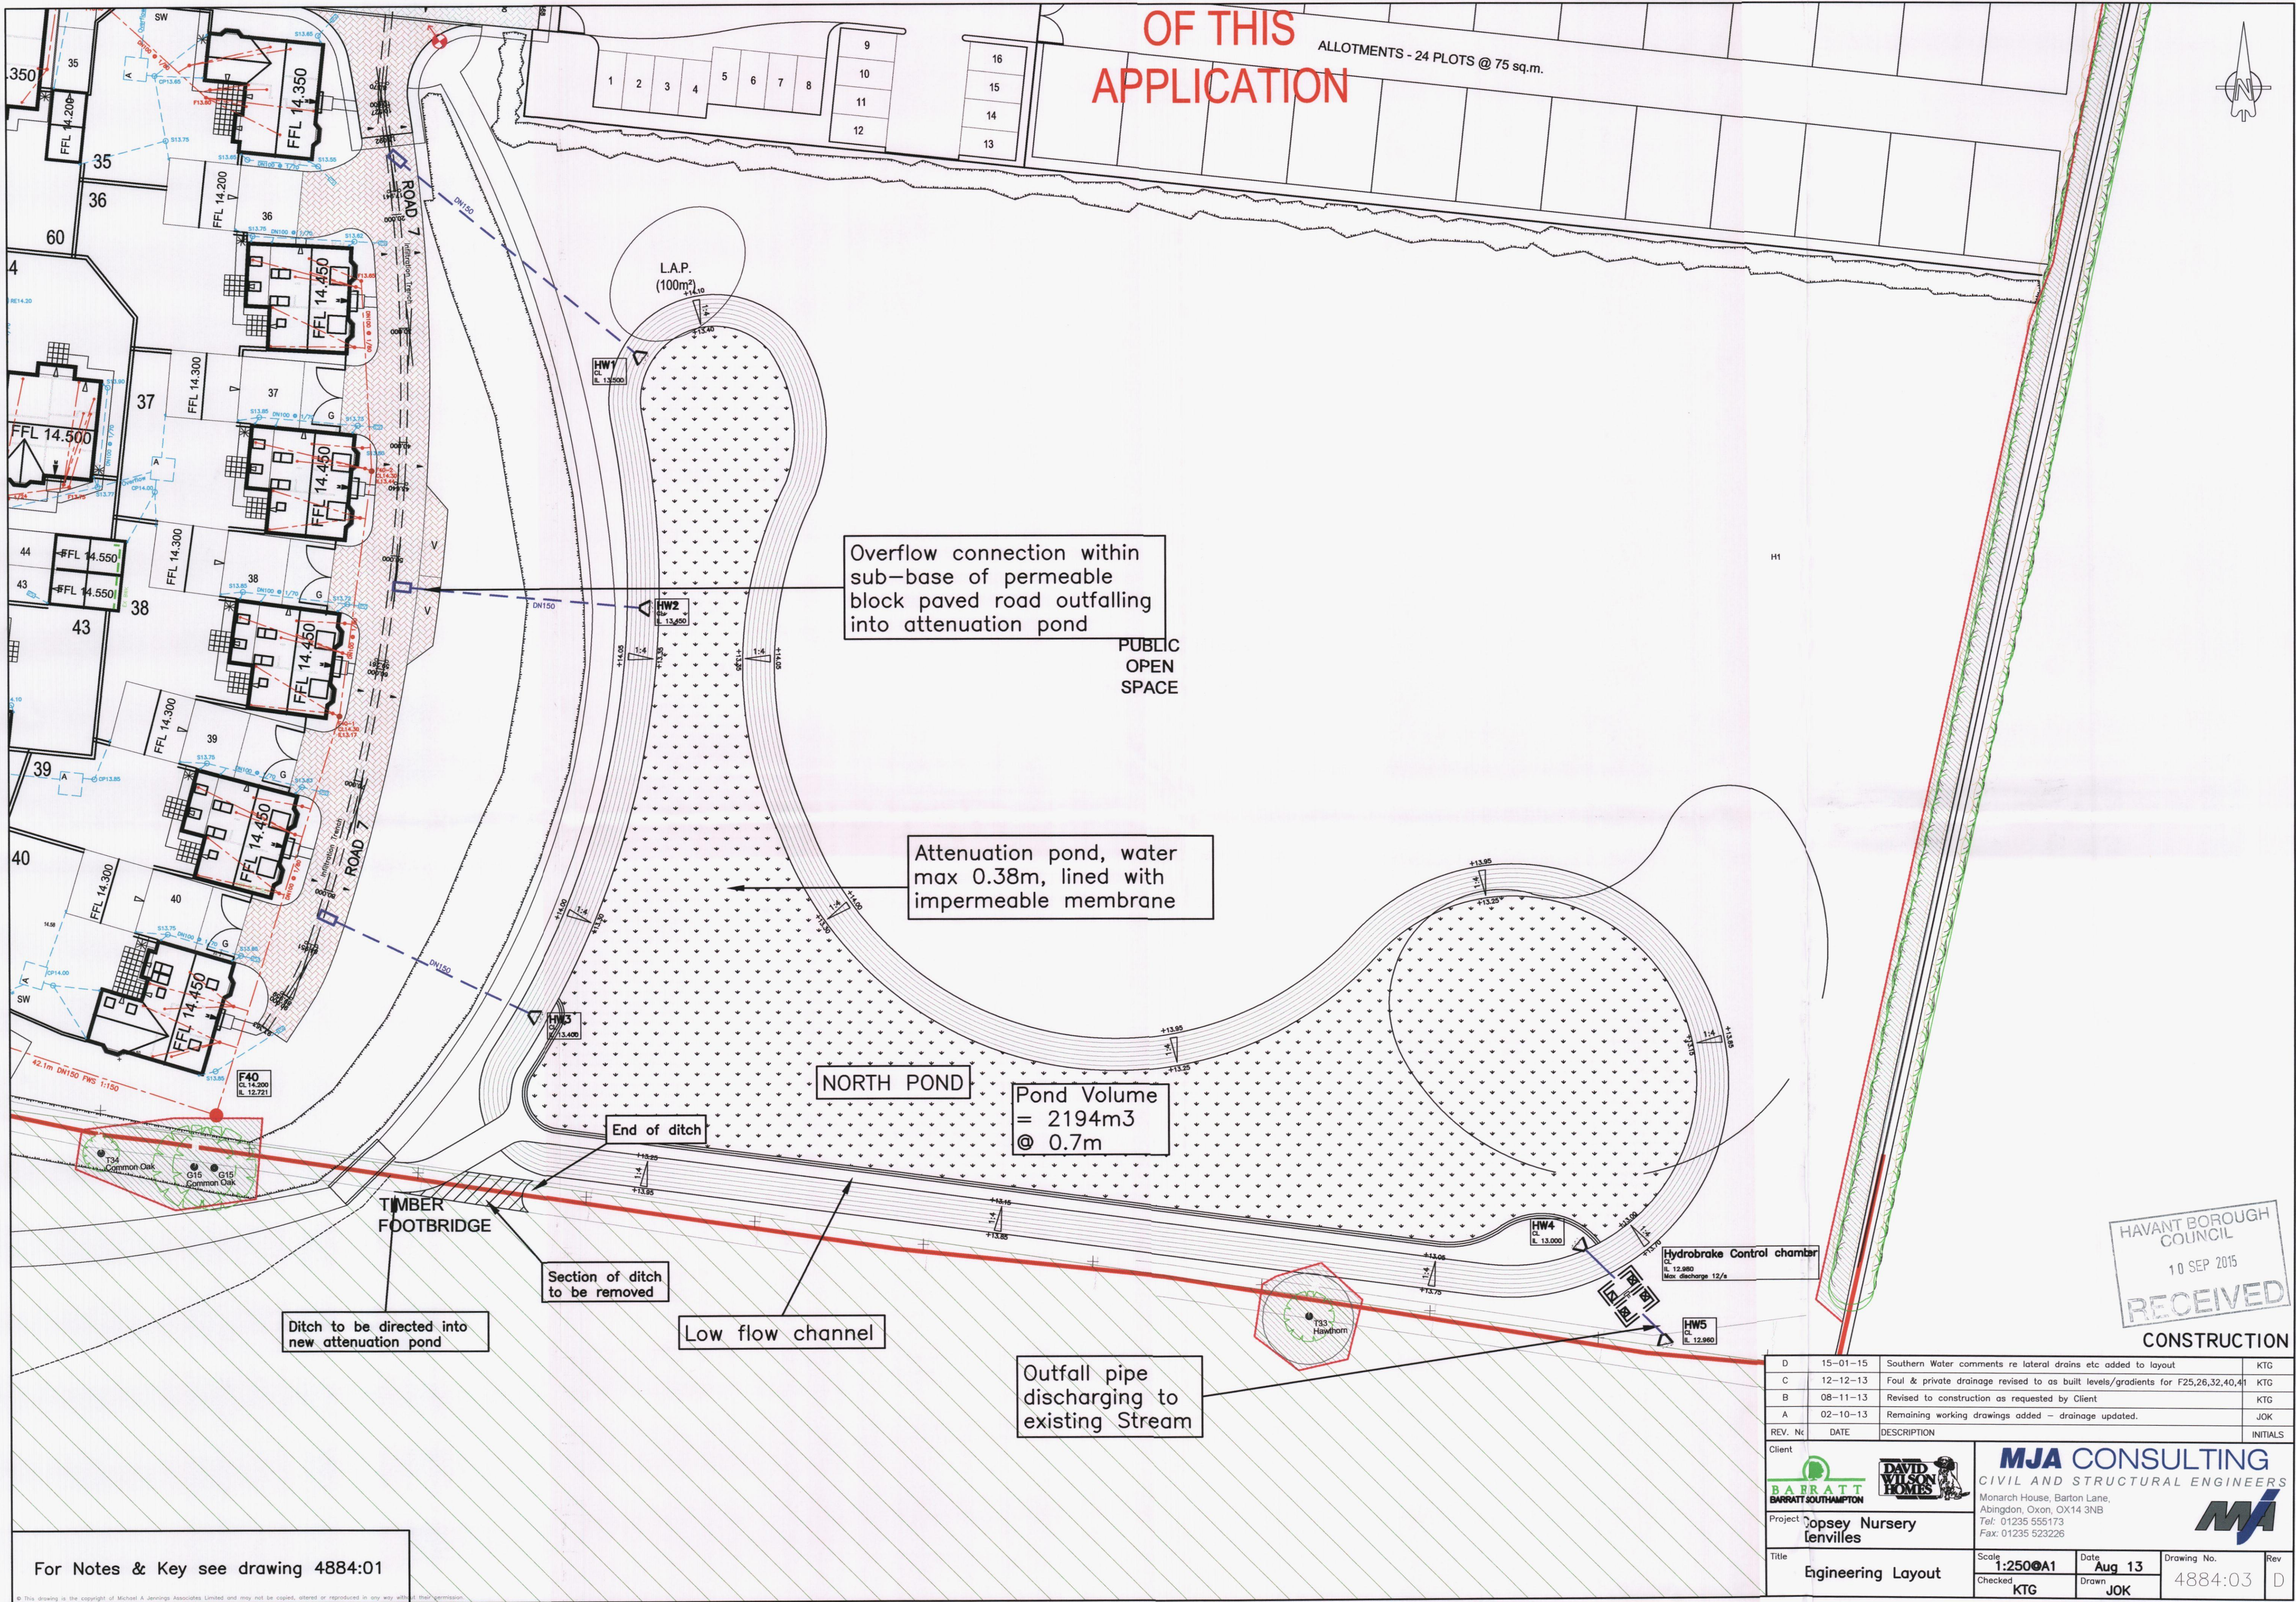


OF THIS APPLICATION

ALLOTMENTS - 24 PLOTS @ 75 sq.m.

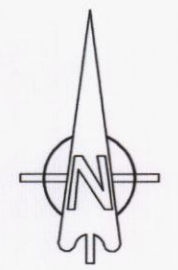

HAVANT BOROUGH COUNCIL
10 SEP 2015
RECEIVED
CONSTRUCTION

D	15-01-15	Southern Water comments re lateral drains etc added to layout	KTG
C	12-12-13	Foul & private drainage revised to as built levels/gradients for F25,26,32,40,41	KTG
B	08-11-13	Revised to construction as requested by Client	KTG
A	02-10-13	Remaining working drawings added - drainage updated.	JOK
REV. No	DATE	DESCRIPTION	INITIALS
Client			
Title	Engineering Layout	Scale 1:2500A1	Date Aug 13
Checked	KTG	Drawn	JOK
Drawing No.	4884:03	Rev	D

For Notes & Key see drawing 4884:01