

REFUSE

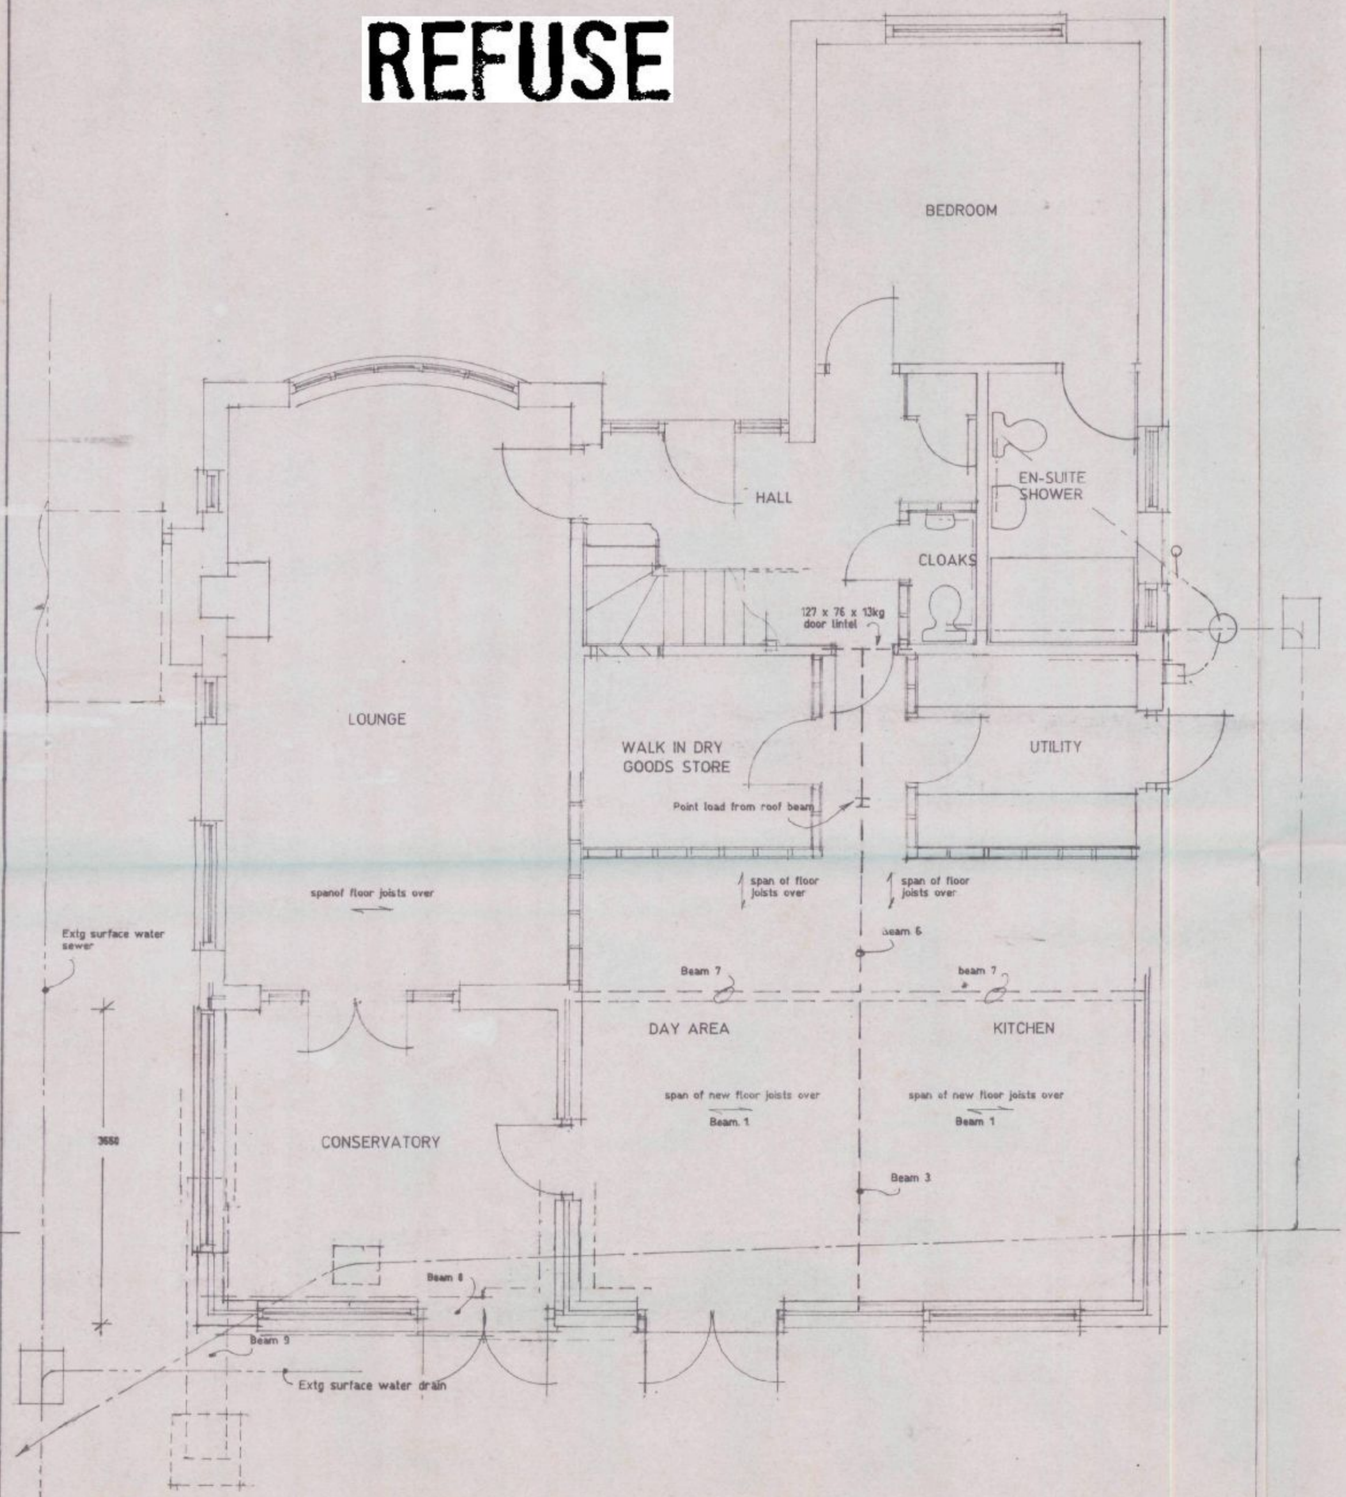

Proposed Ground Floor Layout Plan.

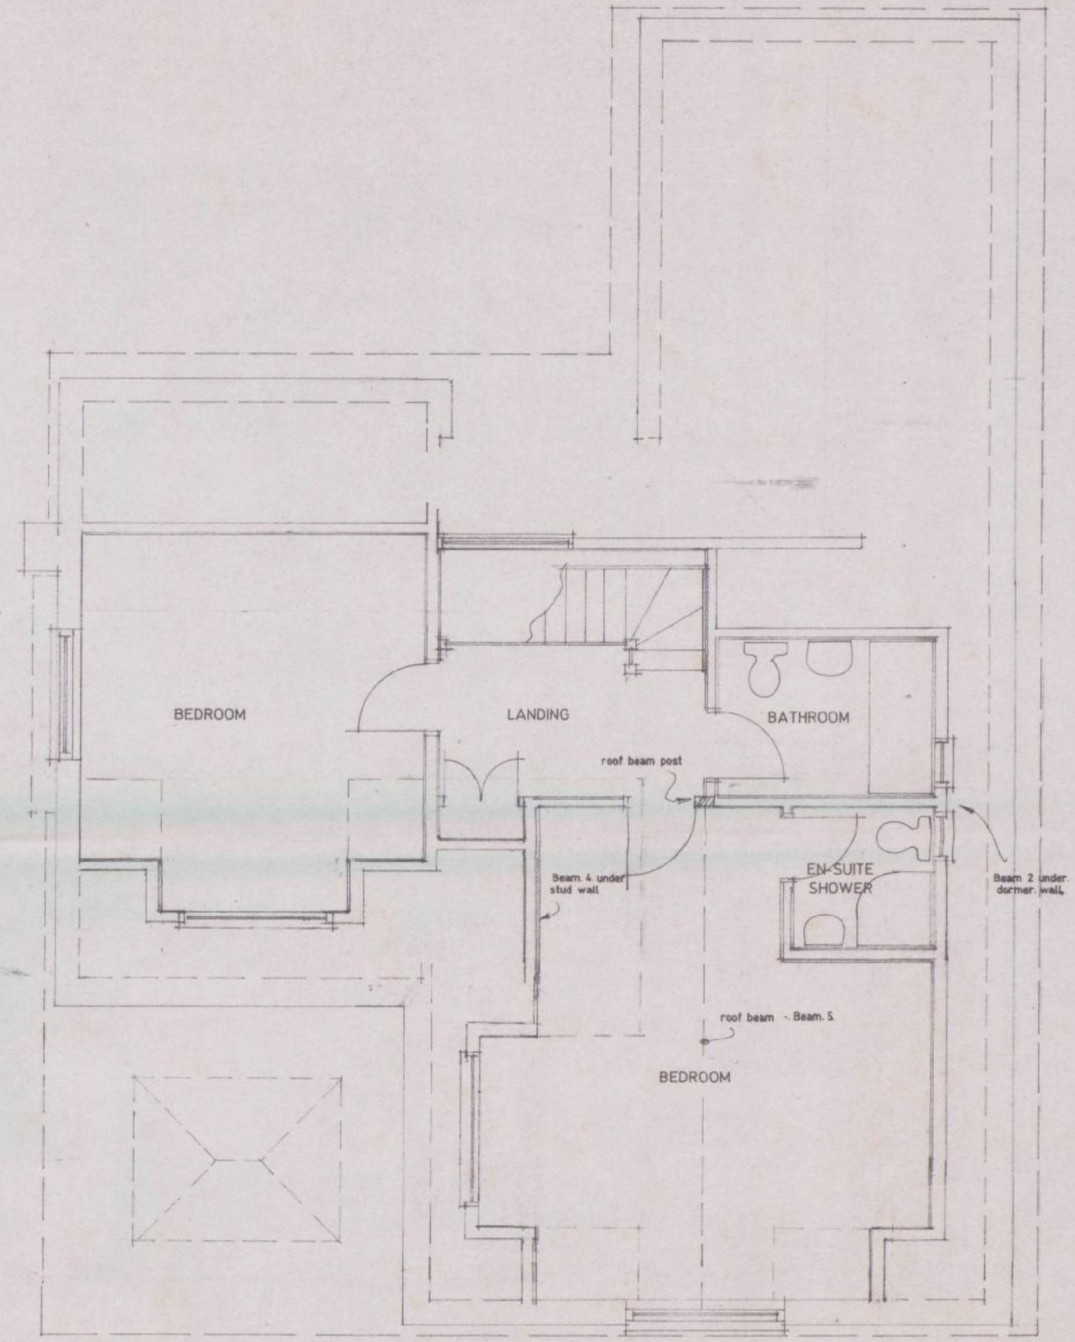

Proposed First Floor Layout Plan.

HAVANT BOROUGH COUNCIL
20 AUG 2010
RECEIVED

Revision E as built Aug 2010

Proposed alterations & extension at 3 Wallis Gardens, Waterlooville, Hants. PO7 7SA

T. Town Esq..

Scale 1:50	Date March 2010
Drawing Number	1
Revision	A B C D E