

Note:


Do not Scale from this Drawing (except for planning approval).
All dimensions are in millimetres and to be checked on site.
All Dimensions relating to subcontractors or suppliers work must be checked and agreed between the main contractor and the sub-contractors and suppliers

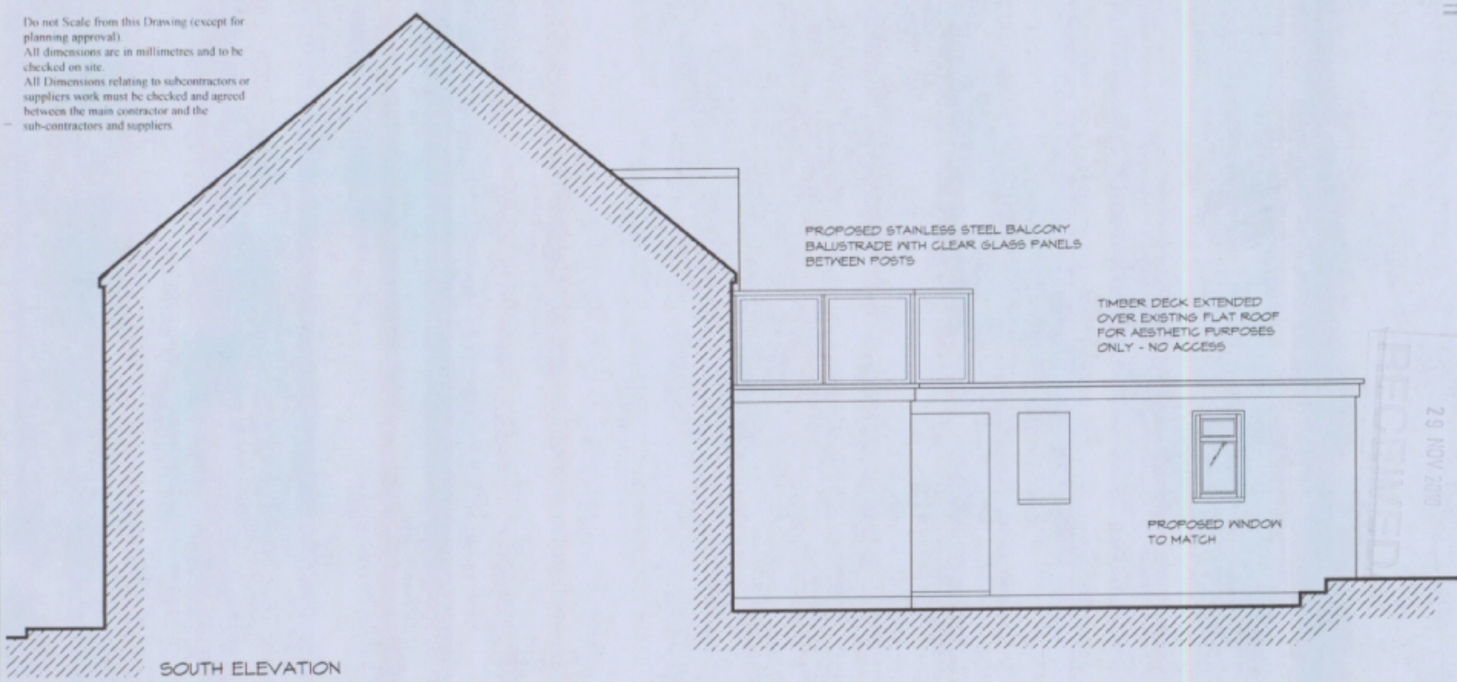


SOUTH ELEVATION

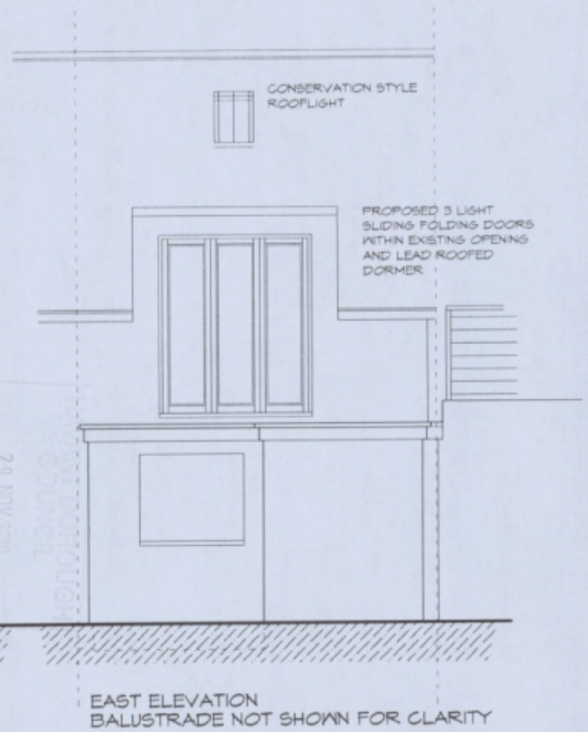


EAST ELEVATION
BALUSTRADE NOT SHOWN FOR CLARITY

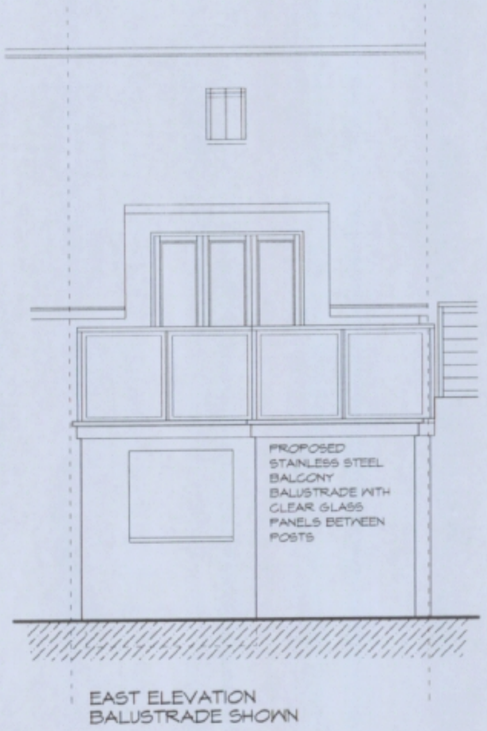


EAST ELEVATION
BALUSTRADE SHOWN

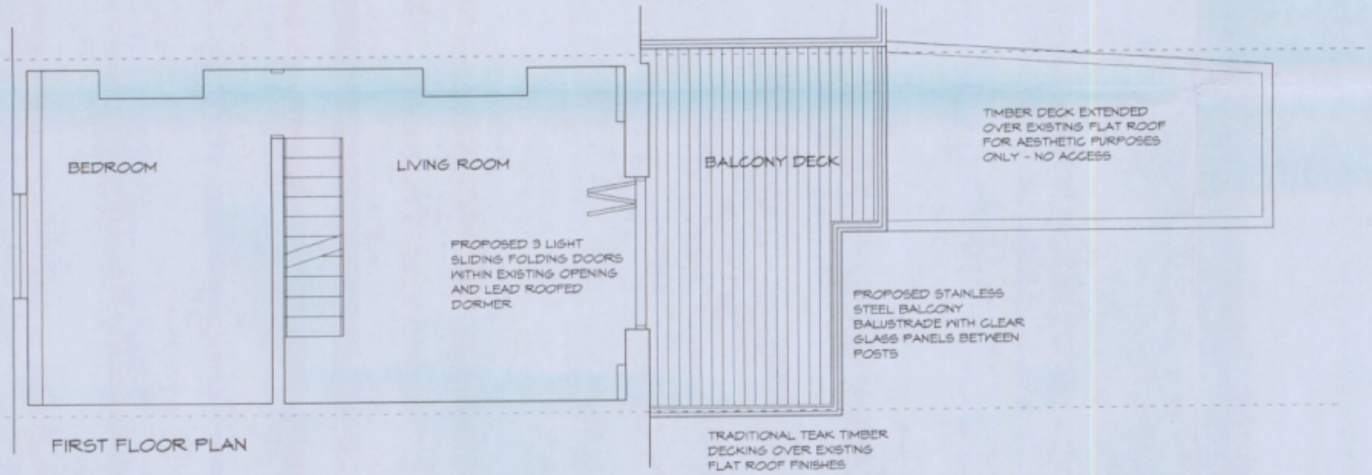

FIRST FLOOR PLAN

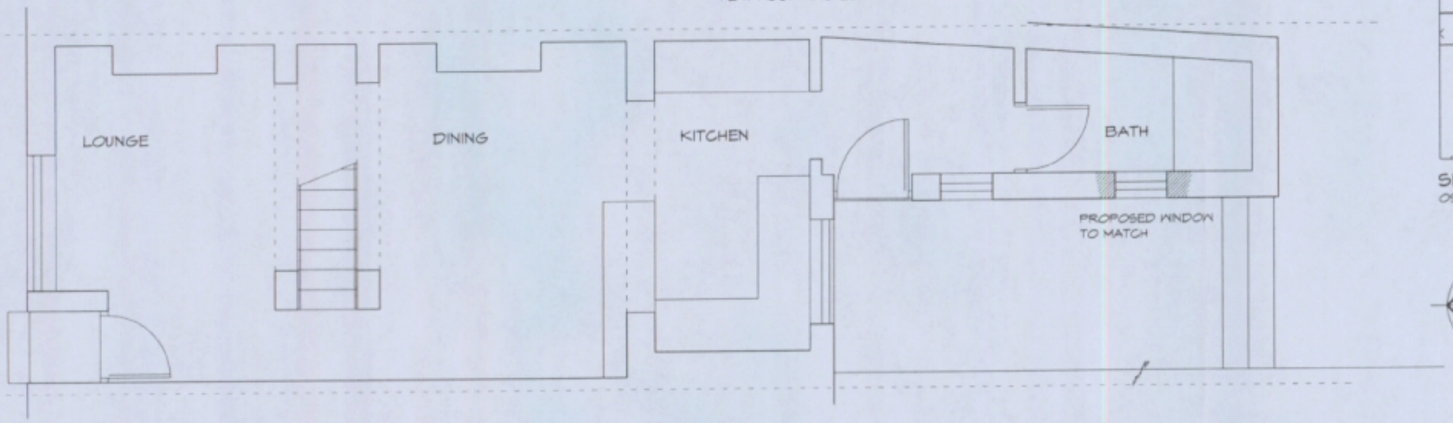

GROUND FLOOR PLAN

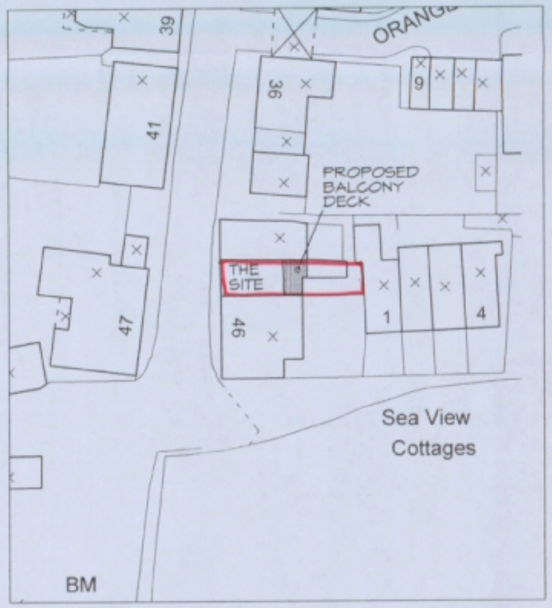

SITE PLAN - 1:500
OS LICENCE 100028290

NORTH



LOCATION PLAN 1:1250
OS LICENCE 100028290

WATKINS WOOD SURVEYORS
37 North Street
Emsworth
Hampshire PO10 7DA
Tel : (01243) 371956
Fax : (01243) 379009
admin@watkinswoodsurveyors.co.uk

PROPOSAL AS BUILT

BALCONY DECK & WINDOWS
44 SOUTH STREET, EMSWORTH
Mrs F Jurycramp

Drawn by:	MJW	**Checked by:**	AA
Scale:	1:50	**Date:**	Oct 10
Job No:	4167	**Drawing:**	PL001