

REFUSE

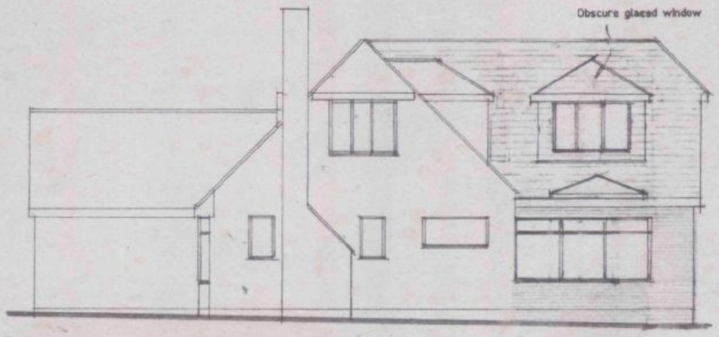


South West Elevation.

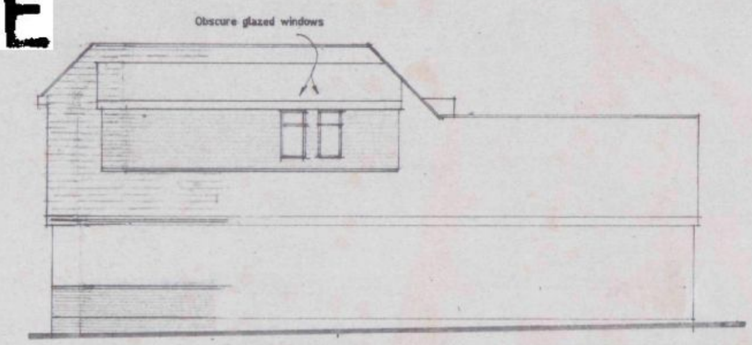


South East Elevation.




North East Elevation

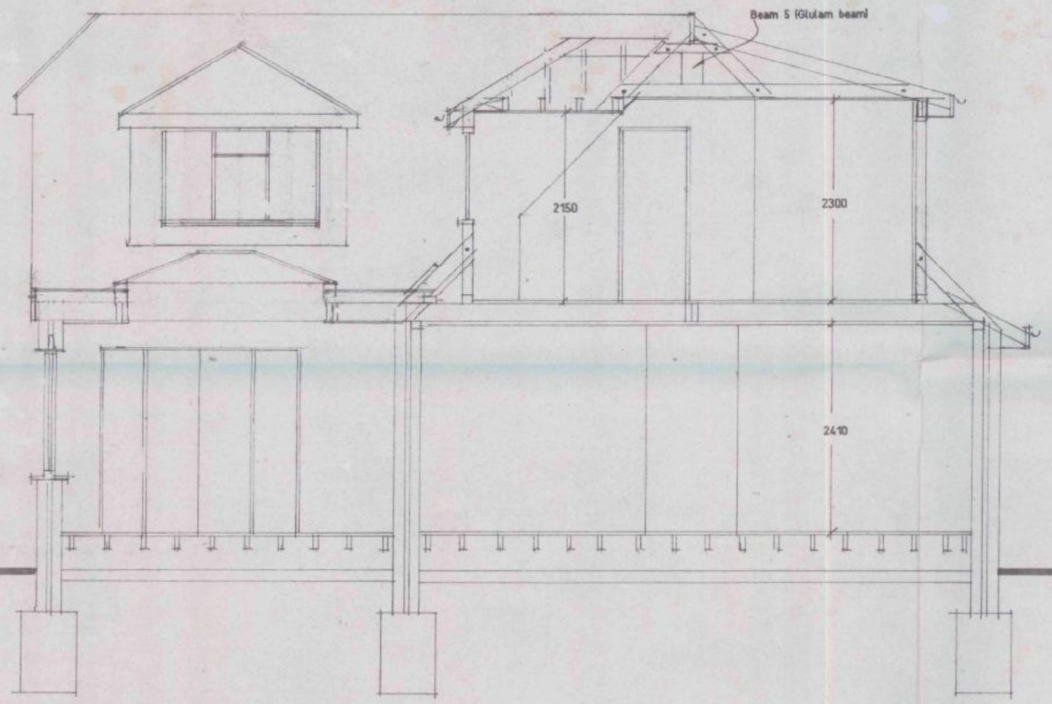


Section x-x.

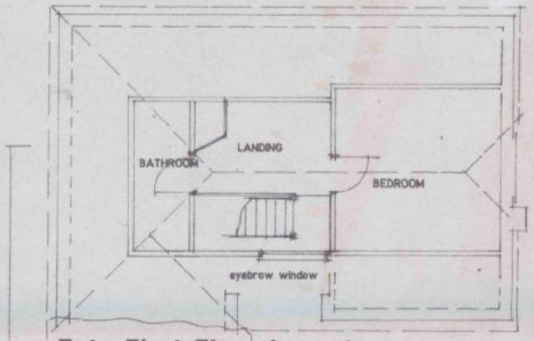

Extg First Floor Layout.

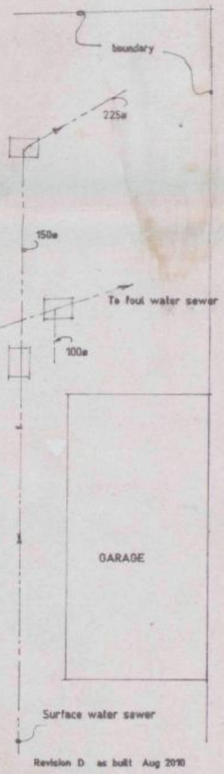

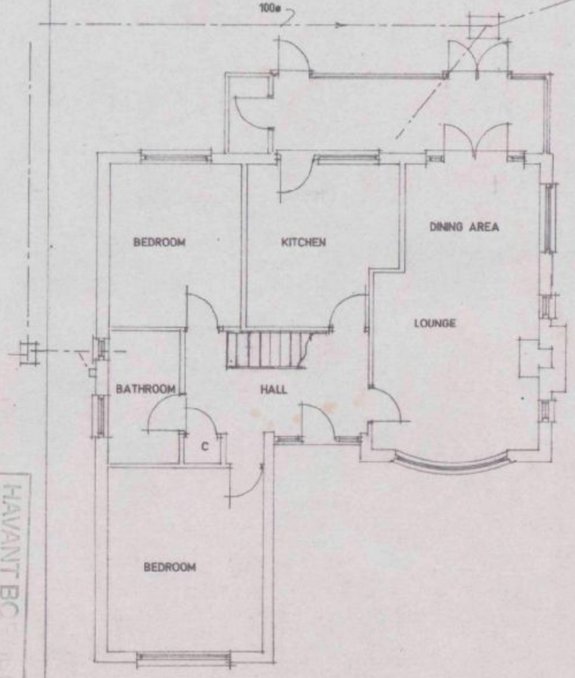

Extg Ground Floor Layout Plan.

HAVANT BC
COUNCIL OFFICES
20 /
RECEIVED

Revision D as built Aug 2010

Proposed alterations & extension at 3 Wallis Gardens, Waterlooville, Hants. PO7 7SA.

T. Town Esq..

Scale 1:50 1:100	Date April 2010
A2 Drawing Number	2
Revision.	AS BUILT