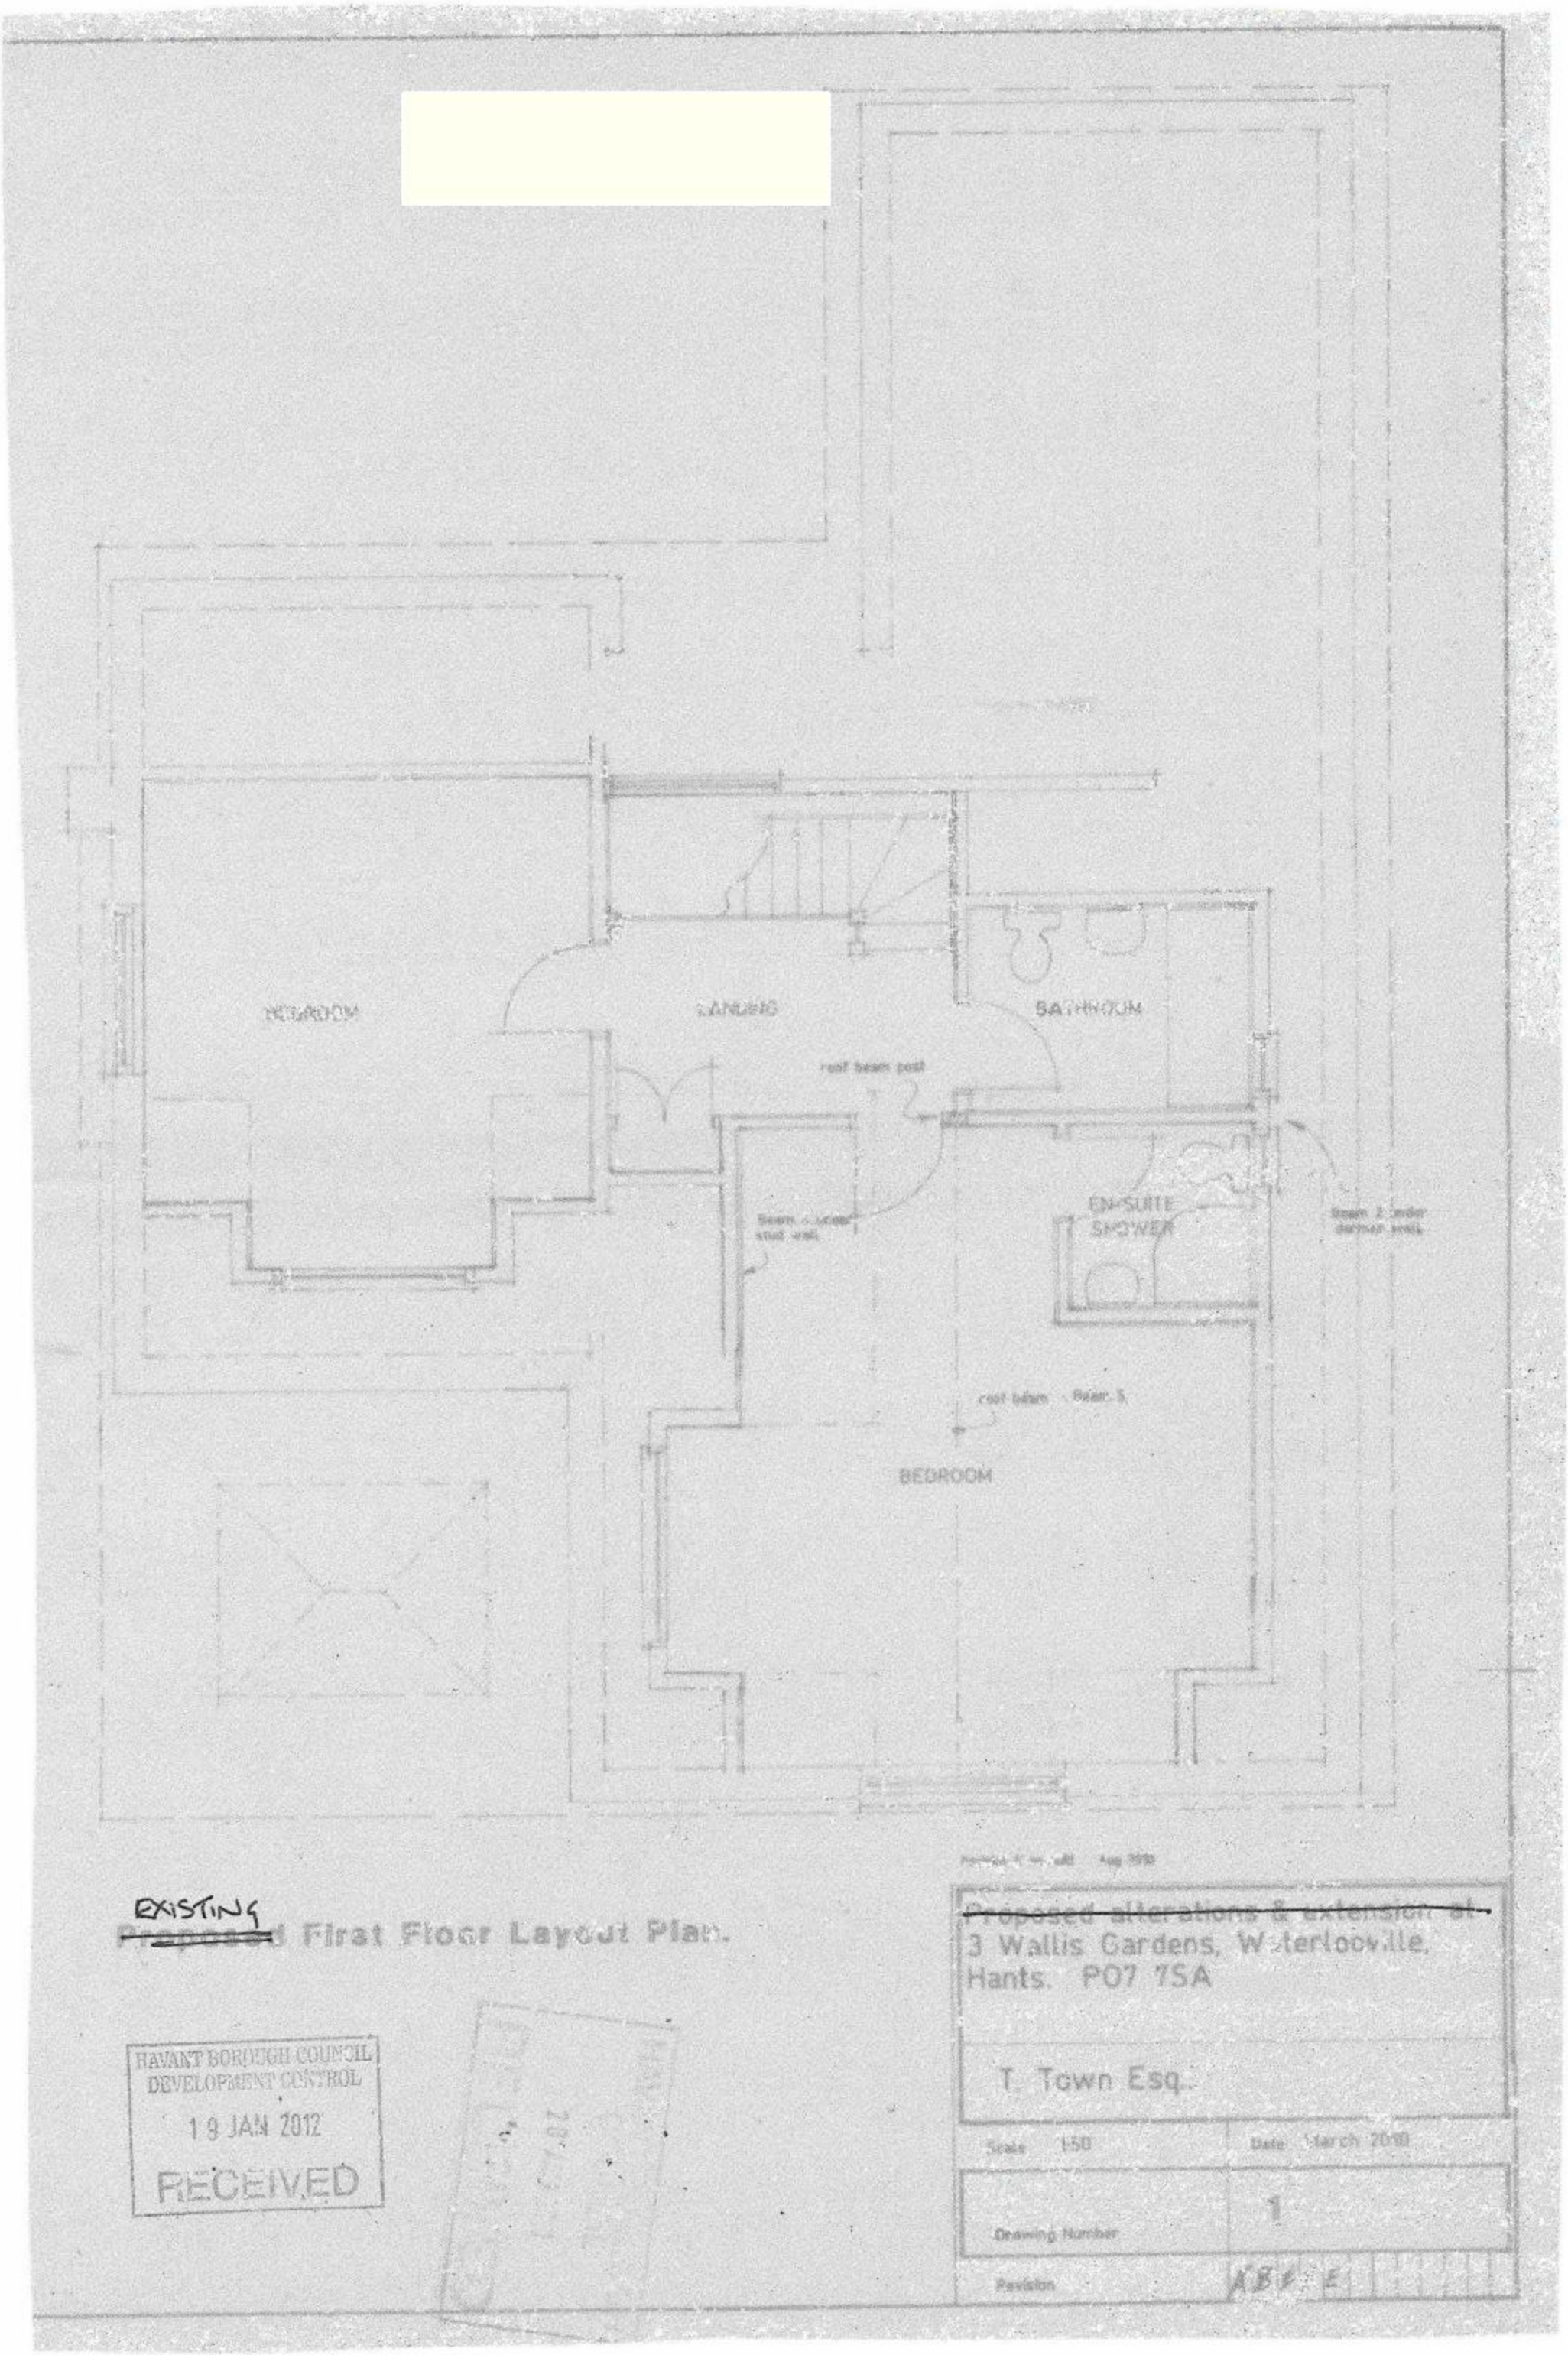


EXISTING
~~Proposed~~ First Floor Layout Plan.

HAVANT BOROUGH COUNCIL
DEVELOPMENT CONTROL
19 JAN 2012
RECEIVED

~~Proposed alterations & extension at~~
3 Wallis Gardens, Waterlooville,
Hants. PO7 7SA

T. Town Esq.

Scale 1:50	Date March 2010
Drawing Number	1
Revision	A B ✓ E