
PERMIT

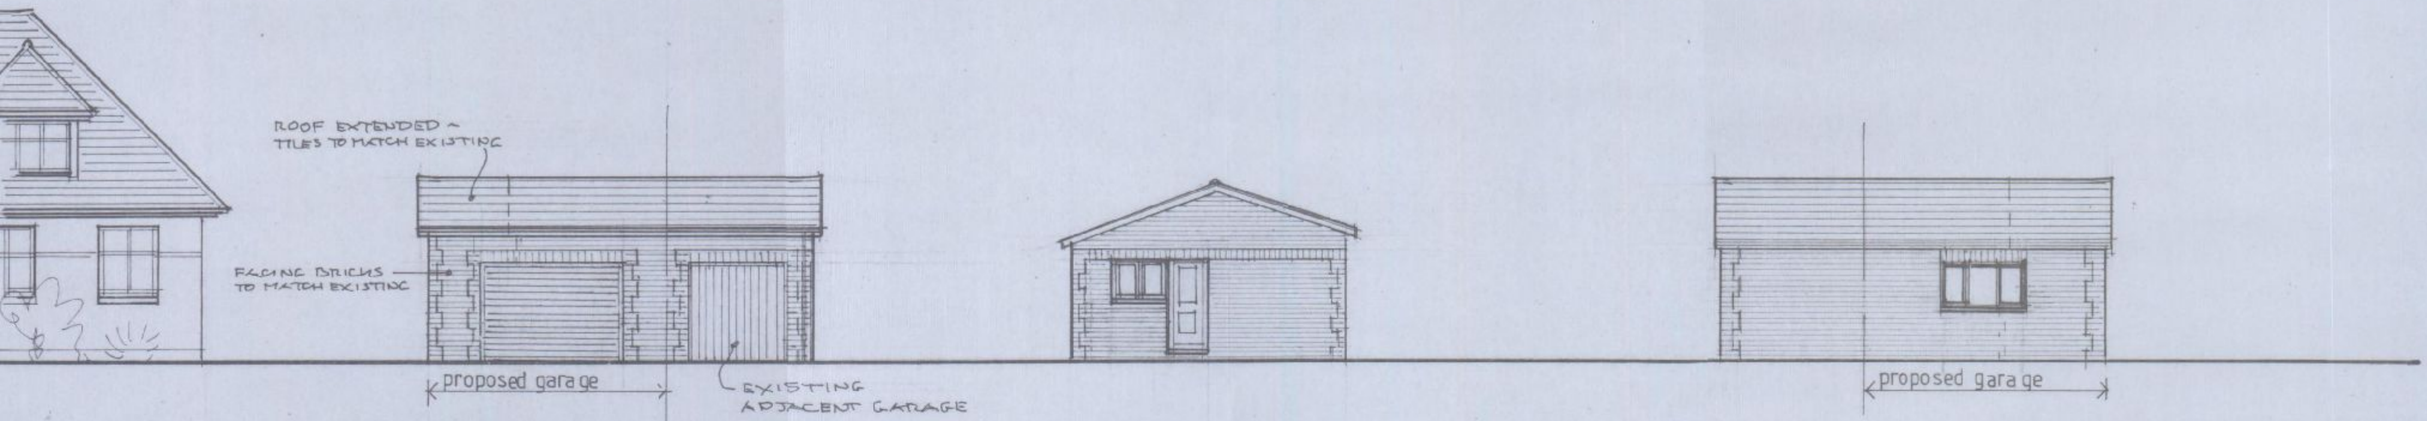


ELEVATIONS 1:100


FRONT

SIDE

REAR

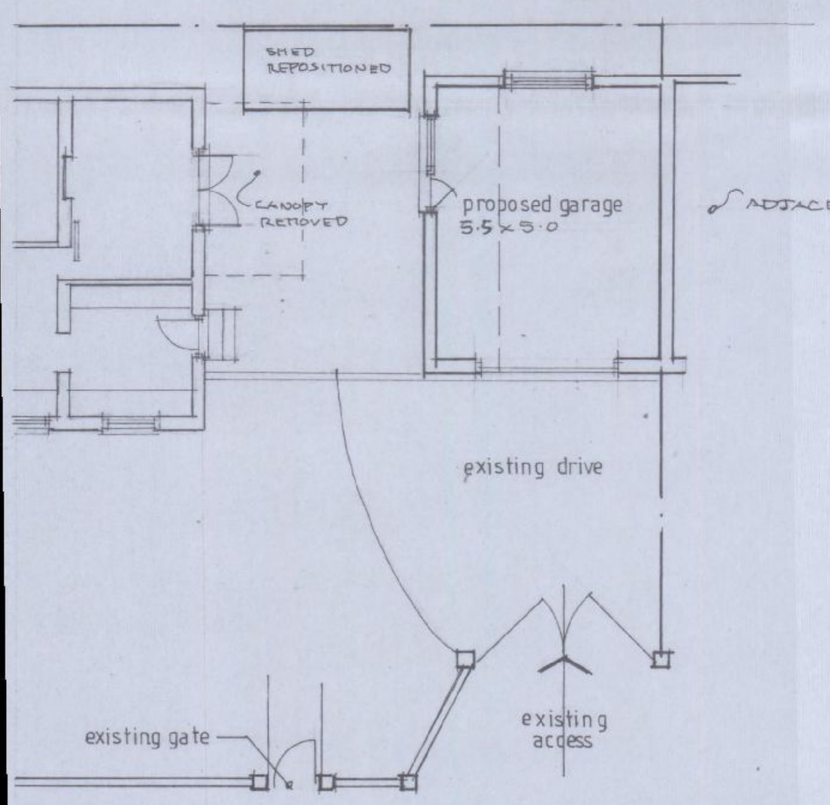

GARAGE PLAN 1:100

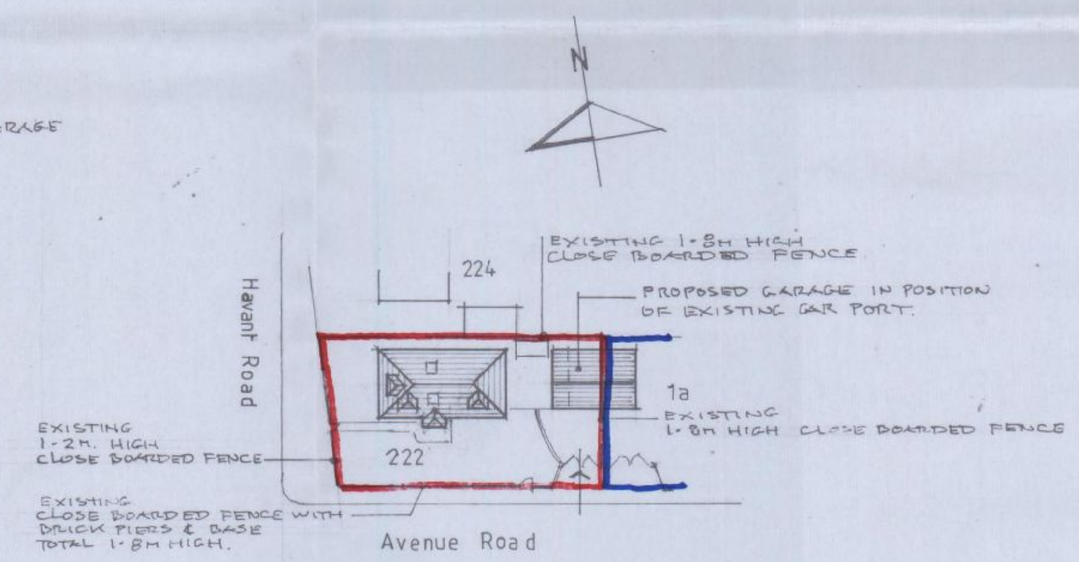

SITE PLAN 1:500

HAVANT BOROUGH COUNCIL
05 MAY 2011
RECEIVED

D ~ REVISED TO 'AS BUILT' 4/11
C ~ CLIENTS REVISIONS 1/11
B ~ FENCE DETAILS ADDED 11/09
A ~ CLIENTS AMENDMENTS 10/09

No.	Revisions:	Date:

O'NEILL
ARCHITECTURAL SERVICES
16 Grosvenor Road, Donnington,
Chichester, West Sussex. PO19 8RX.
Telephone: [01243] 531333

Client:
Mrs. C. PAYNE

Project:
LOFT CONVERSION & ALTERATIONS,
222 HAVANT ROAD,
HAYLING ISLAND

Drawing:
DESIGN PROPOSALS
garage / site plan

Drawn by:	Date:
P. O'NEILL	OCTOBER, 2009
Scale/s: 1:100, 1:500	
Drg. no. 0944/04	Rev: D