
PERMIT




SIDE ELEVATION [to Avenue Road]

FRONT ELEVATION [to Havant Road]


SIDE ELEVATION

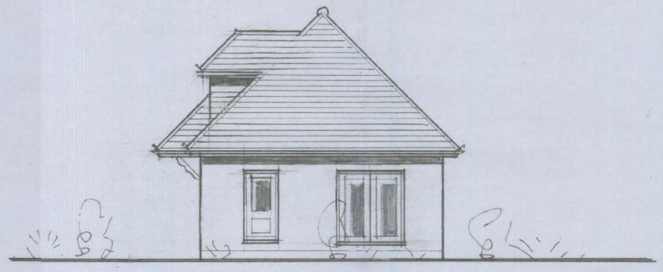


REAR ELEVATION

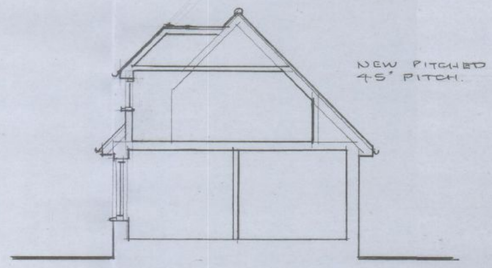

SECTION

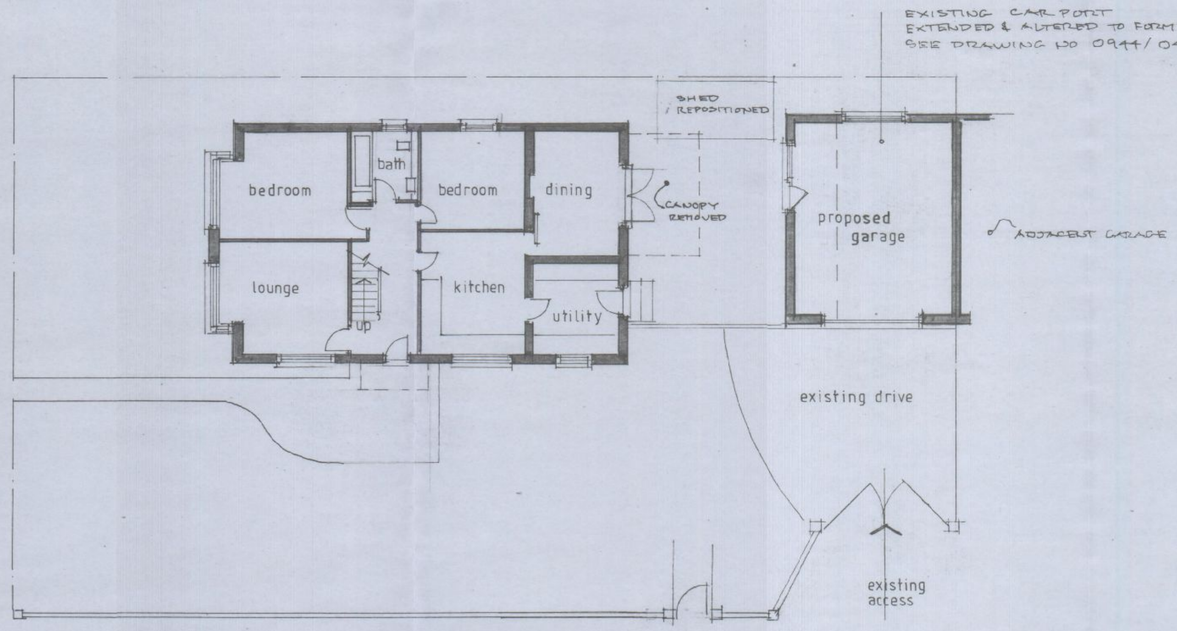

GROUND FLOOR PLAN 1:100

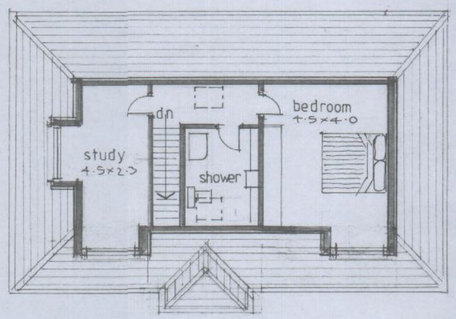

FIRST FLOOR PLAN

D AREVISED TO 'AS BUILT' 4/11
A=CLIENTS REVISIONS 1/11

No.	Revisions:	Date:

O'NEILL
ARCHITECTURAL SERVICES
16 Grosvenor Road, Donnington,
Chichester, West Sussex. PO19 8RX.
Telephone: [01243] 531333

Client:
Mrs. C. PAYNE

Project:
LOFT CONVERSION & ALTERATIONS
222 HAVANT ROAD,
HAYLING ISLAND

Drawing:
DESIGN PROPOSALS
floor plans & elevations

Drawn by: P.O'NEILL
Date: SEPTEMBER 2009

Scale/s: 1:100

Drg.no. 0944/03
Rev B

HAVANT BOROUGH COUNCIL
05 MAY 2011
RECEIVED