

PERMIT

HAVANT BOROUGH COUNCIL
15 FEB 2011
RECEIVED

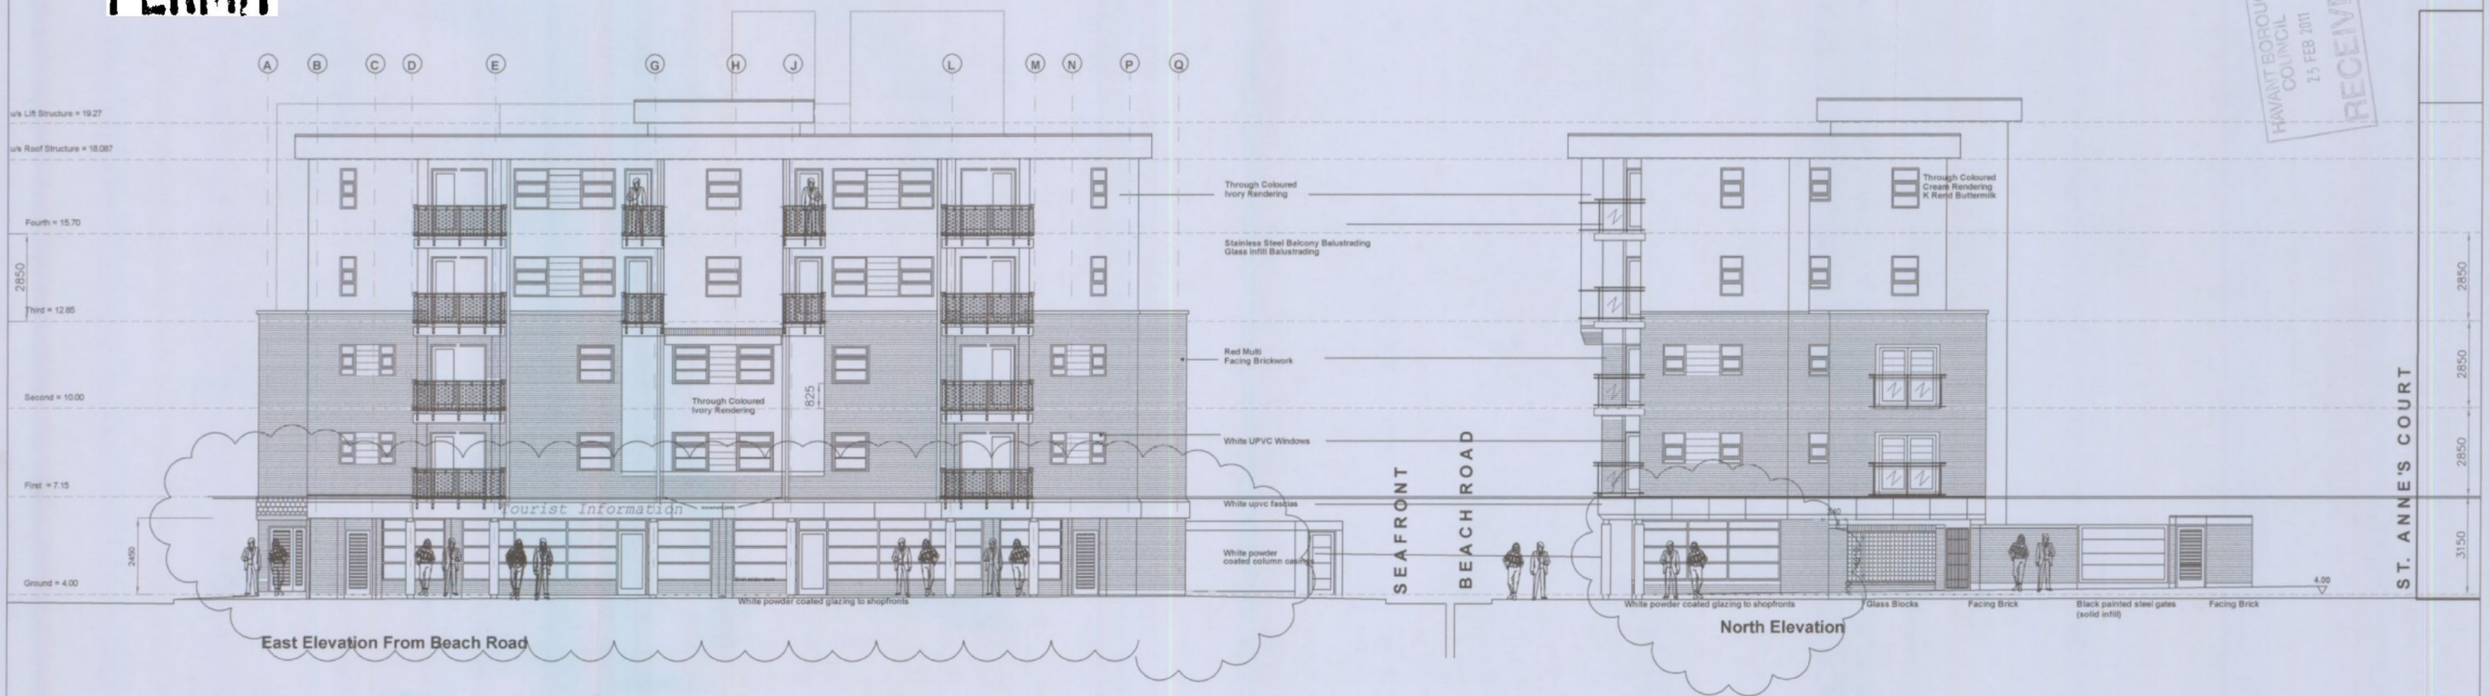


East Elevation From Beach Road

North Elevation

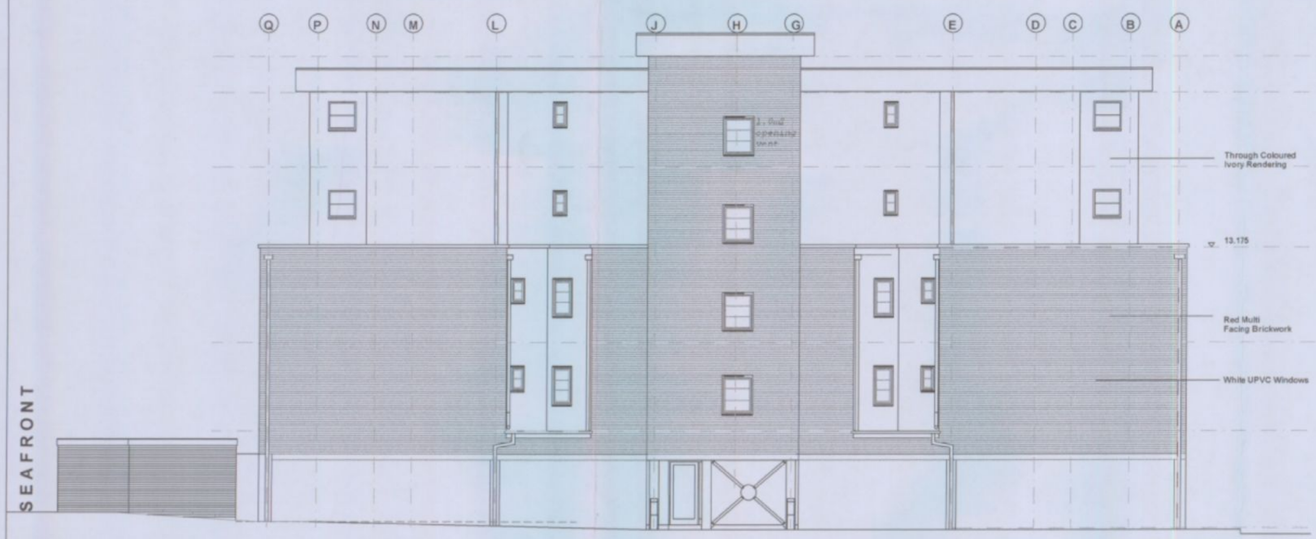

West Elevation

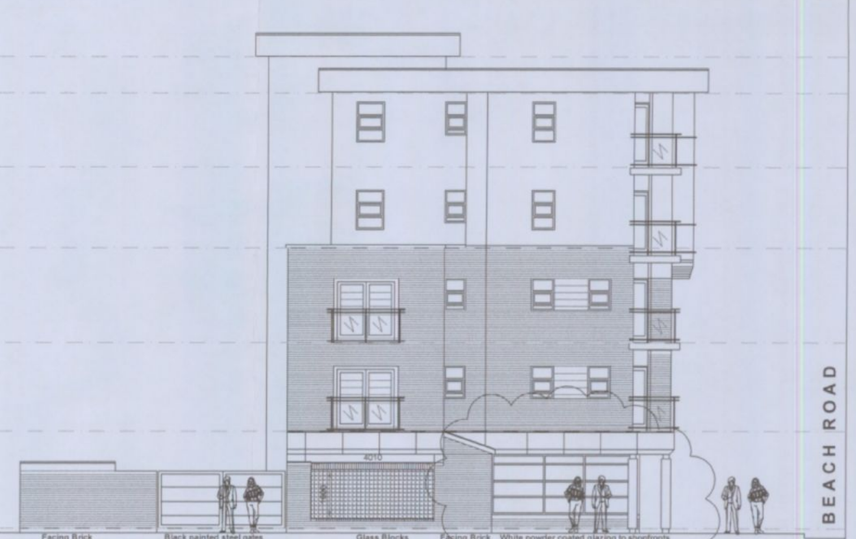

South Elevation

AS BUILT

REVISION H: SHOPFRONT DETAILS ADDED – 15/02/11 – PG
REVISION G: GLASS BLOCK SETTING OUT AMENDED – 26/01/11 – PG
REVISION F: GLASS BLOCK SETTING OUT AMENDED – 16/08/10 – PG
REVISION E: GLASS BLOCK SETTING OUT ADDED – 13/08/10 – PG
REVISION D: REAR RECESSES AMENDED – 30/03/09 – PG
REVISION C: REVISED BALCONIES ADDED – 04/12/09 – PG
REVISION B: EAVES DETAIL AMENDED – 19/11/09 – PG
REVISION A: MINOR AMENDMENTS – 03/11/09 – PG

SCALE: 1/100
DATE: July 09
AUTHOR: PG

TITLE: Lock-up Shop Units & 14 Flats
9, Seafront - Hayling Island
DETAIL: Elevations
DRAWING No: 05/17/W08

PETER GALLOWAY PARTNERSHIP
pgp
ARCHITECTS
BURGAN HOUSE, 8/10 EAST STREET,
HAVANT, HAMPSHIRE PO9 1AQ
TEL 02392 472650 FAX 02392 472702