



Finished floor and site levels. Scale 1 : 100

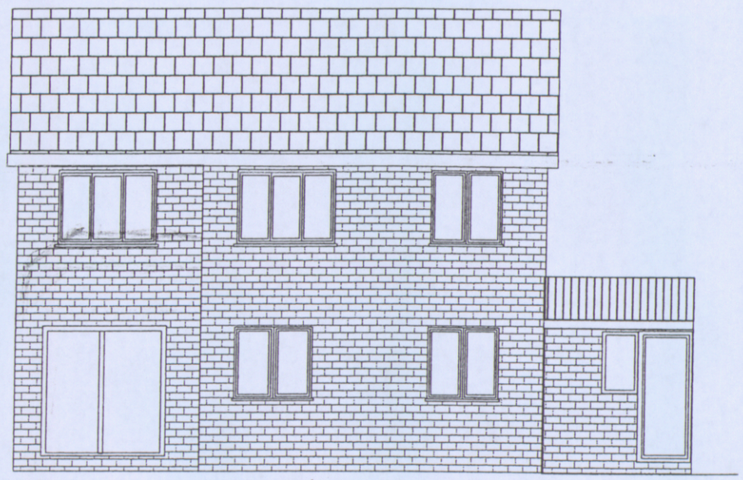

East

Proposed ~~West~~ elevation

Scale 1 : 100

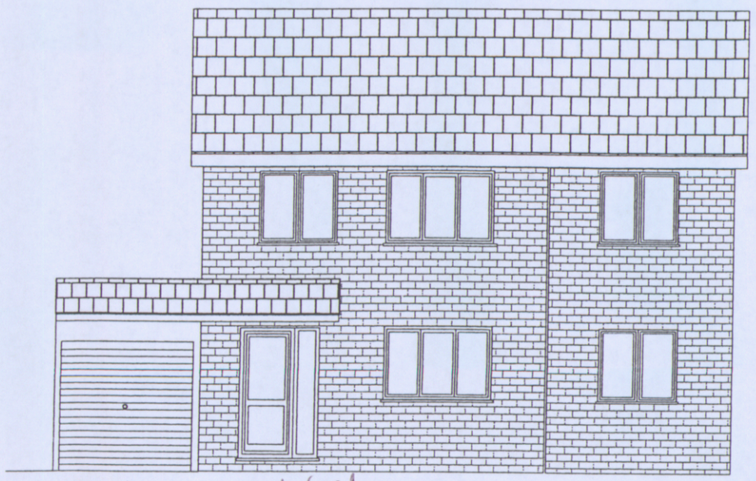


West

Proposed ~~East~~ elevation

Scale 1 : 100


APP/10/00033

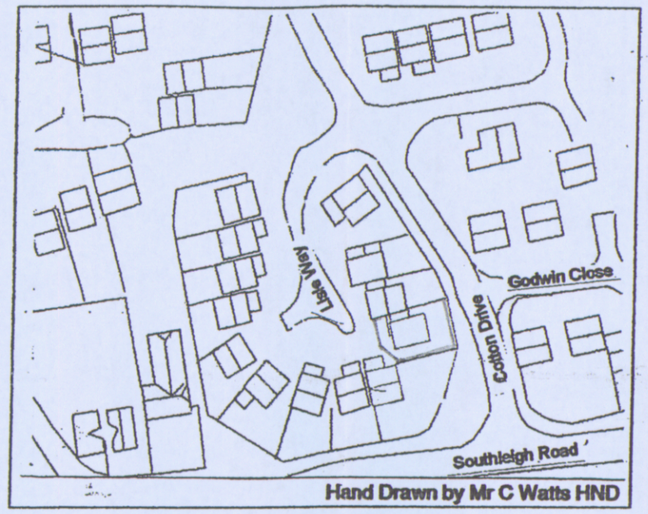

Location Plan Scale 1 : 1250

B.O.H.
REFUSE

N

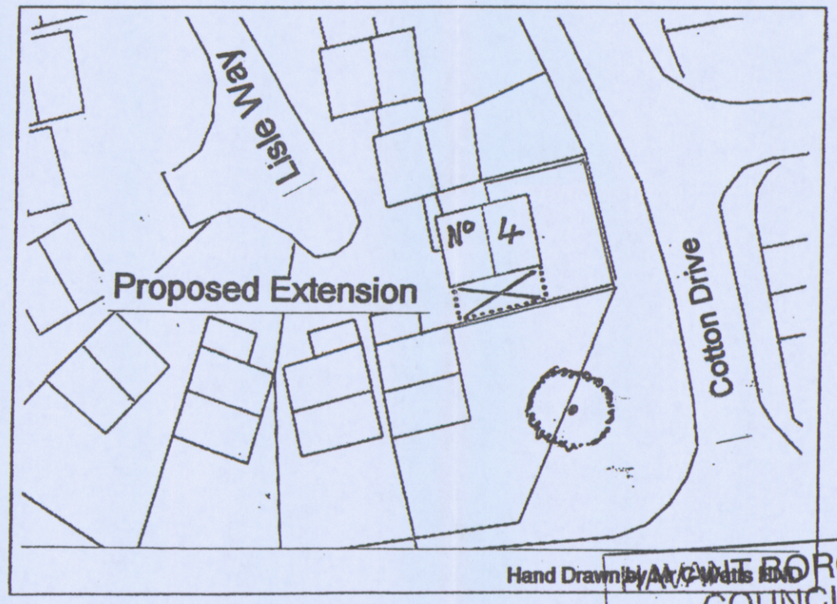

Block Plan Scale 1: 500

Blue line indicates 6ft X 6ft wooden fence panels.

EASTLEIGH BOROUGH COUNCIL
20 APR 2010
RECEIVED

AMENDED

Proposed two Storey side Extension for
Mr & Mrs M Boxall
4 Lisle Way, Emsworth.
Hants, PO 10 7XN

Scale 1 : 100 (or as shown) Drawn of A3 paper

Amendments 19th April 2010 Plan 1 of 1