


APP/10/00033

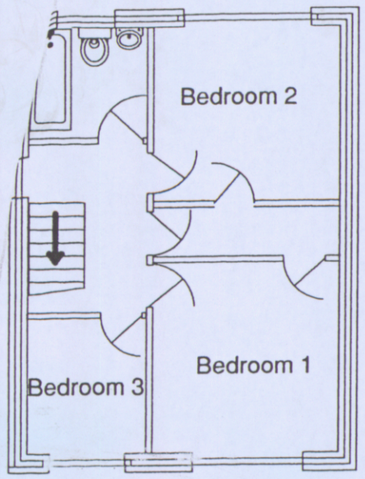



Existing first floor
Scale 1 : 100

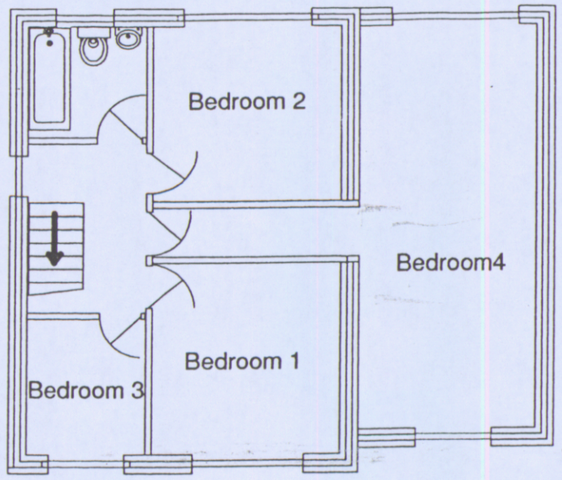


Proposed first floor
Scale 1 : 100

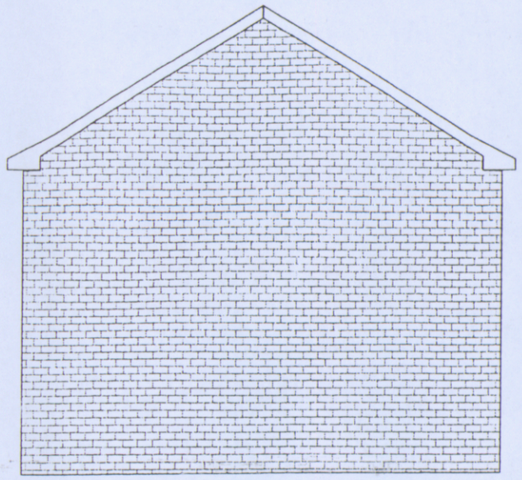


Existing South elevation
Scale 1 : 100

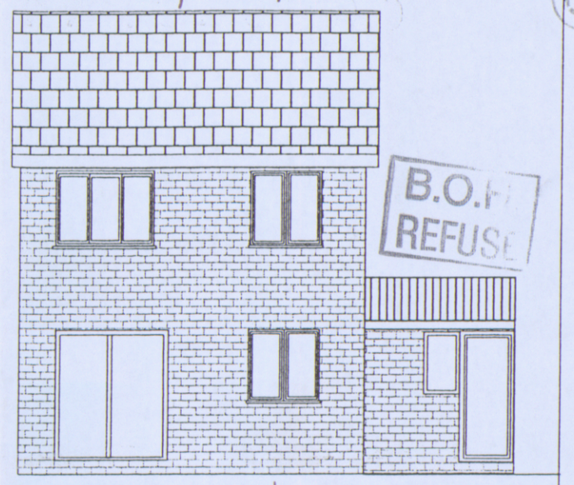



Existing ~~West~~ East elevation
Scale 1 : 100


HAVANT BOROUGH COUNCIL
20 APR 2010
RECEIVED

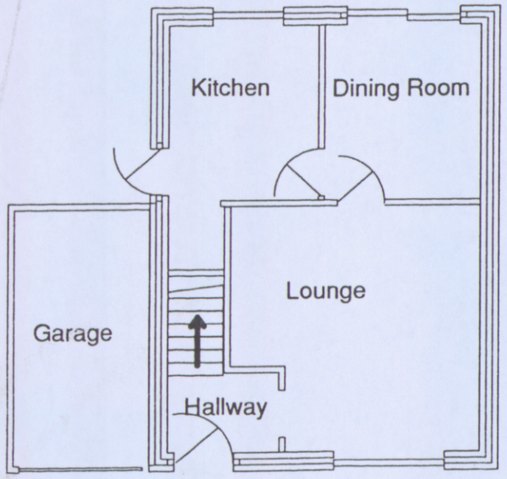



Existing ground floor
Scale 1 : 100

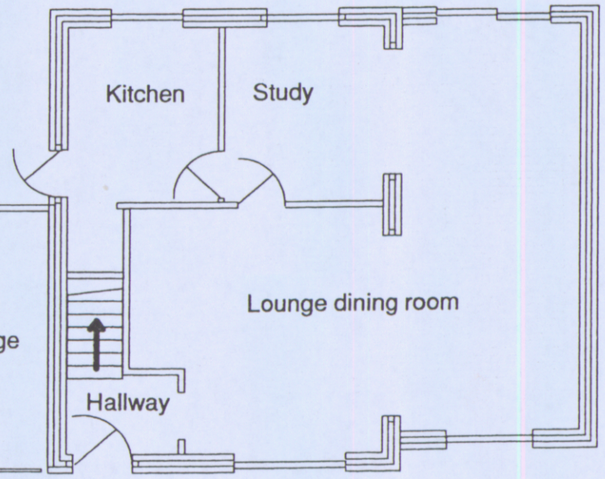



Proposed ground floor
Scale 1 : 100

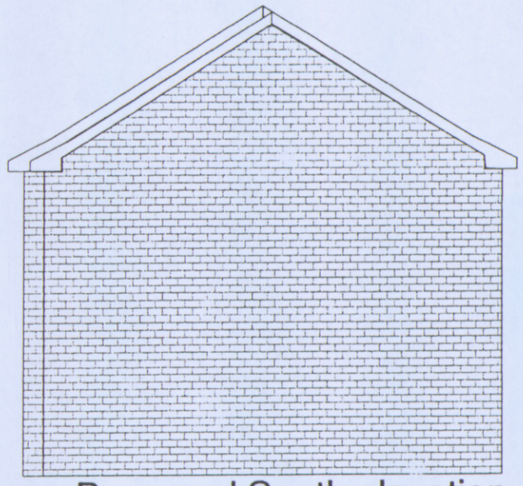

Proposed South elevation
Scale 1 : 100

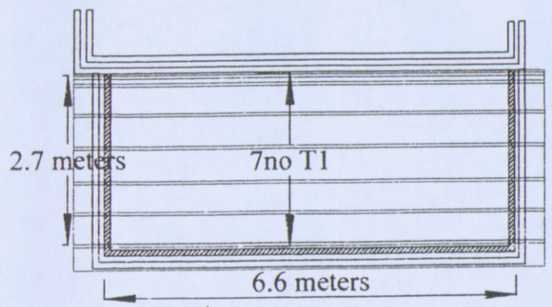


Trusses designed by bespoke truss makers.
Scale 1 : 100

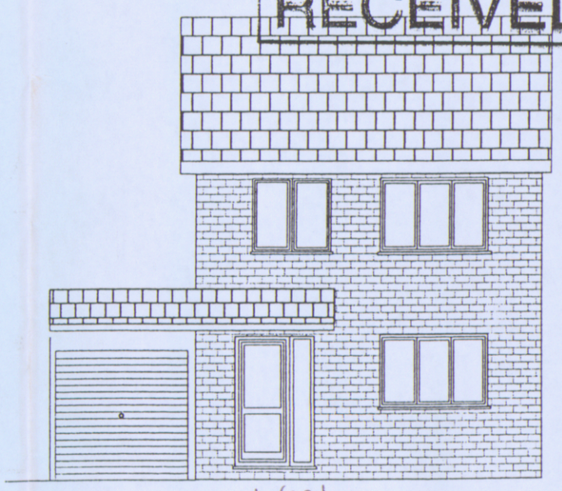

Existing ~~East~~ West elevation
Scale 1 : 100

Proposed two Storey side Extension for
Mr & Mrs M Boxall
4 Lisle Way, Emsworth.
Hants, PO 10 7XN

AMENDED

Scale 1 : 100 ( or as shown) Drawn of A3 paper
Amended 19th April 2010 Plan 2 of 2