Existing Elevation-Left side WEST

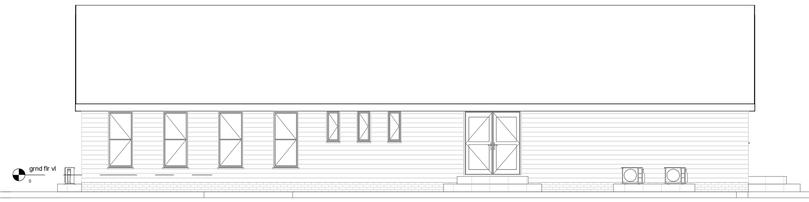

Existing Elevation-Front SOUTH

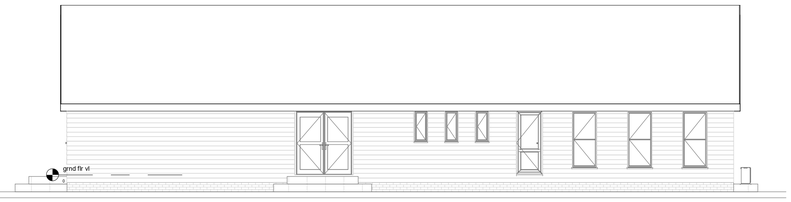

Existing Elevation-Rear NORTH

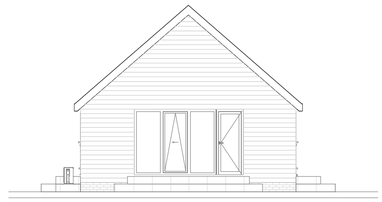

Existing Elevation-Right side EAST

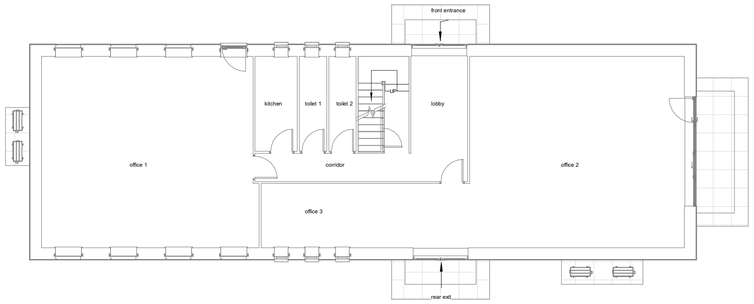

Existing Ground Floor

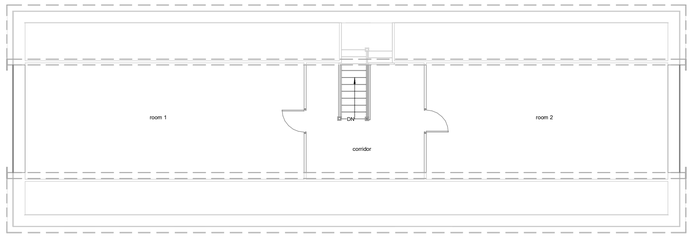

Existing First Floor

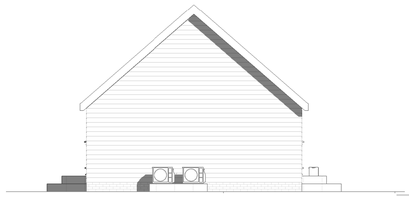

Proposed/As Built Elevation-Left side WEST

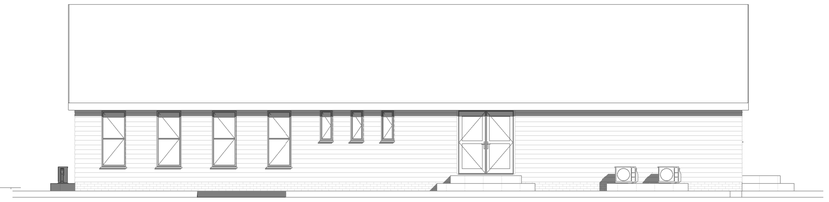

Proposed/As Built Elevation-Front SOUTH

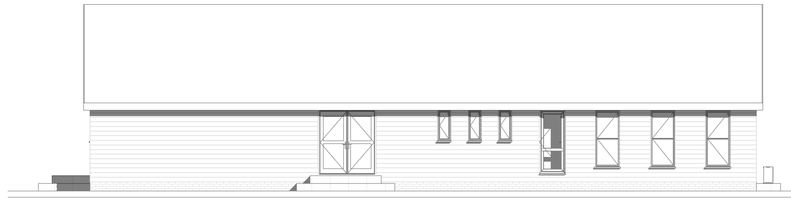

Proposed/As Built Elevation-Rear NORTH

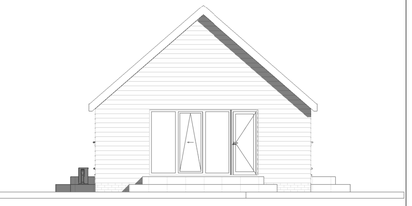

Proposed/As Built Elevation-Right side EAST

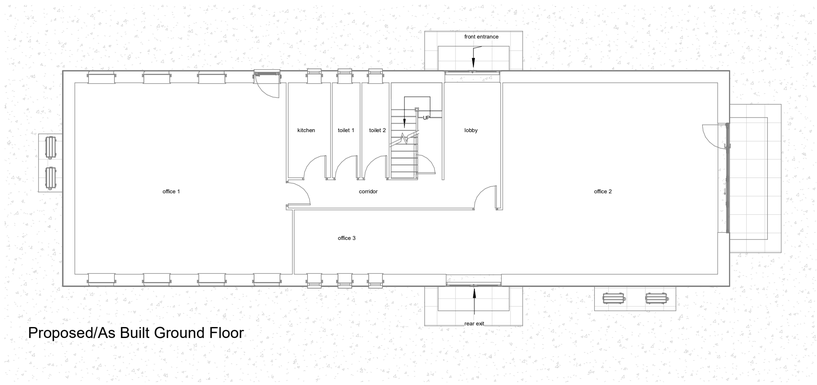

Proposed/As Built Ground Floor

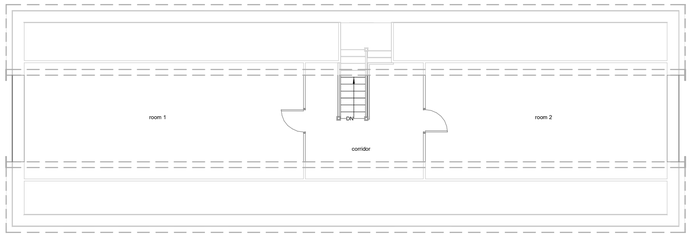

Proposed/As s Built First Floor

Boat Shed	144.5m2
Office Ground Floor	131.8m2
Office First floor @ 1500mm	59m2

parkers design

www.parkersdesign.co.uk

info@parkersdesign.co.uk

Tel: 07776 008822

1:500 50
1:200 20
1:100 10
1:50 5

All measurement to be checked on site prior to any commenment

Parkers Design Limited - No.3 - PO9 6AH

PROJECT	Yachthaven, Copse Lane PO11 0BF	CLIENT	Alpine Homes
		Date Issue Date	SCALE (@ A1) 1 : 100
SHEET	Office	Drawn by SW	DRAWING NUMBER P 1
		Checked by SR	REV

Project Number

(C) Copyright of Parkers Design (Southern) Limited. Any reprodution of these drawings will require written authority from the copyright owner.