


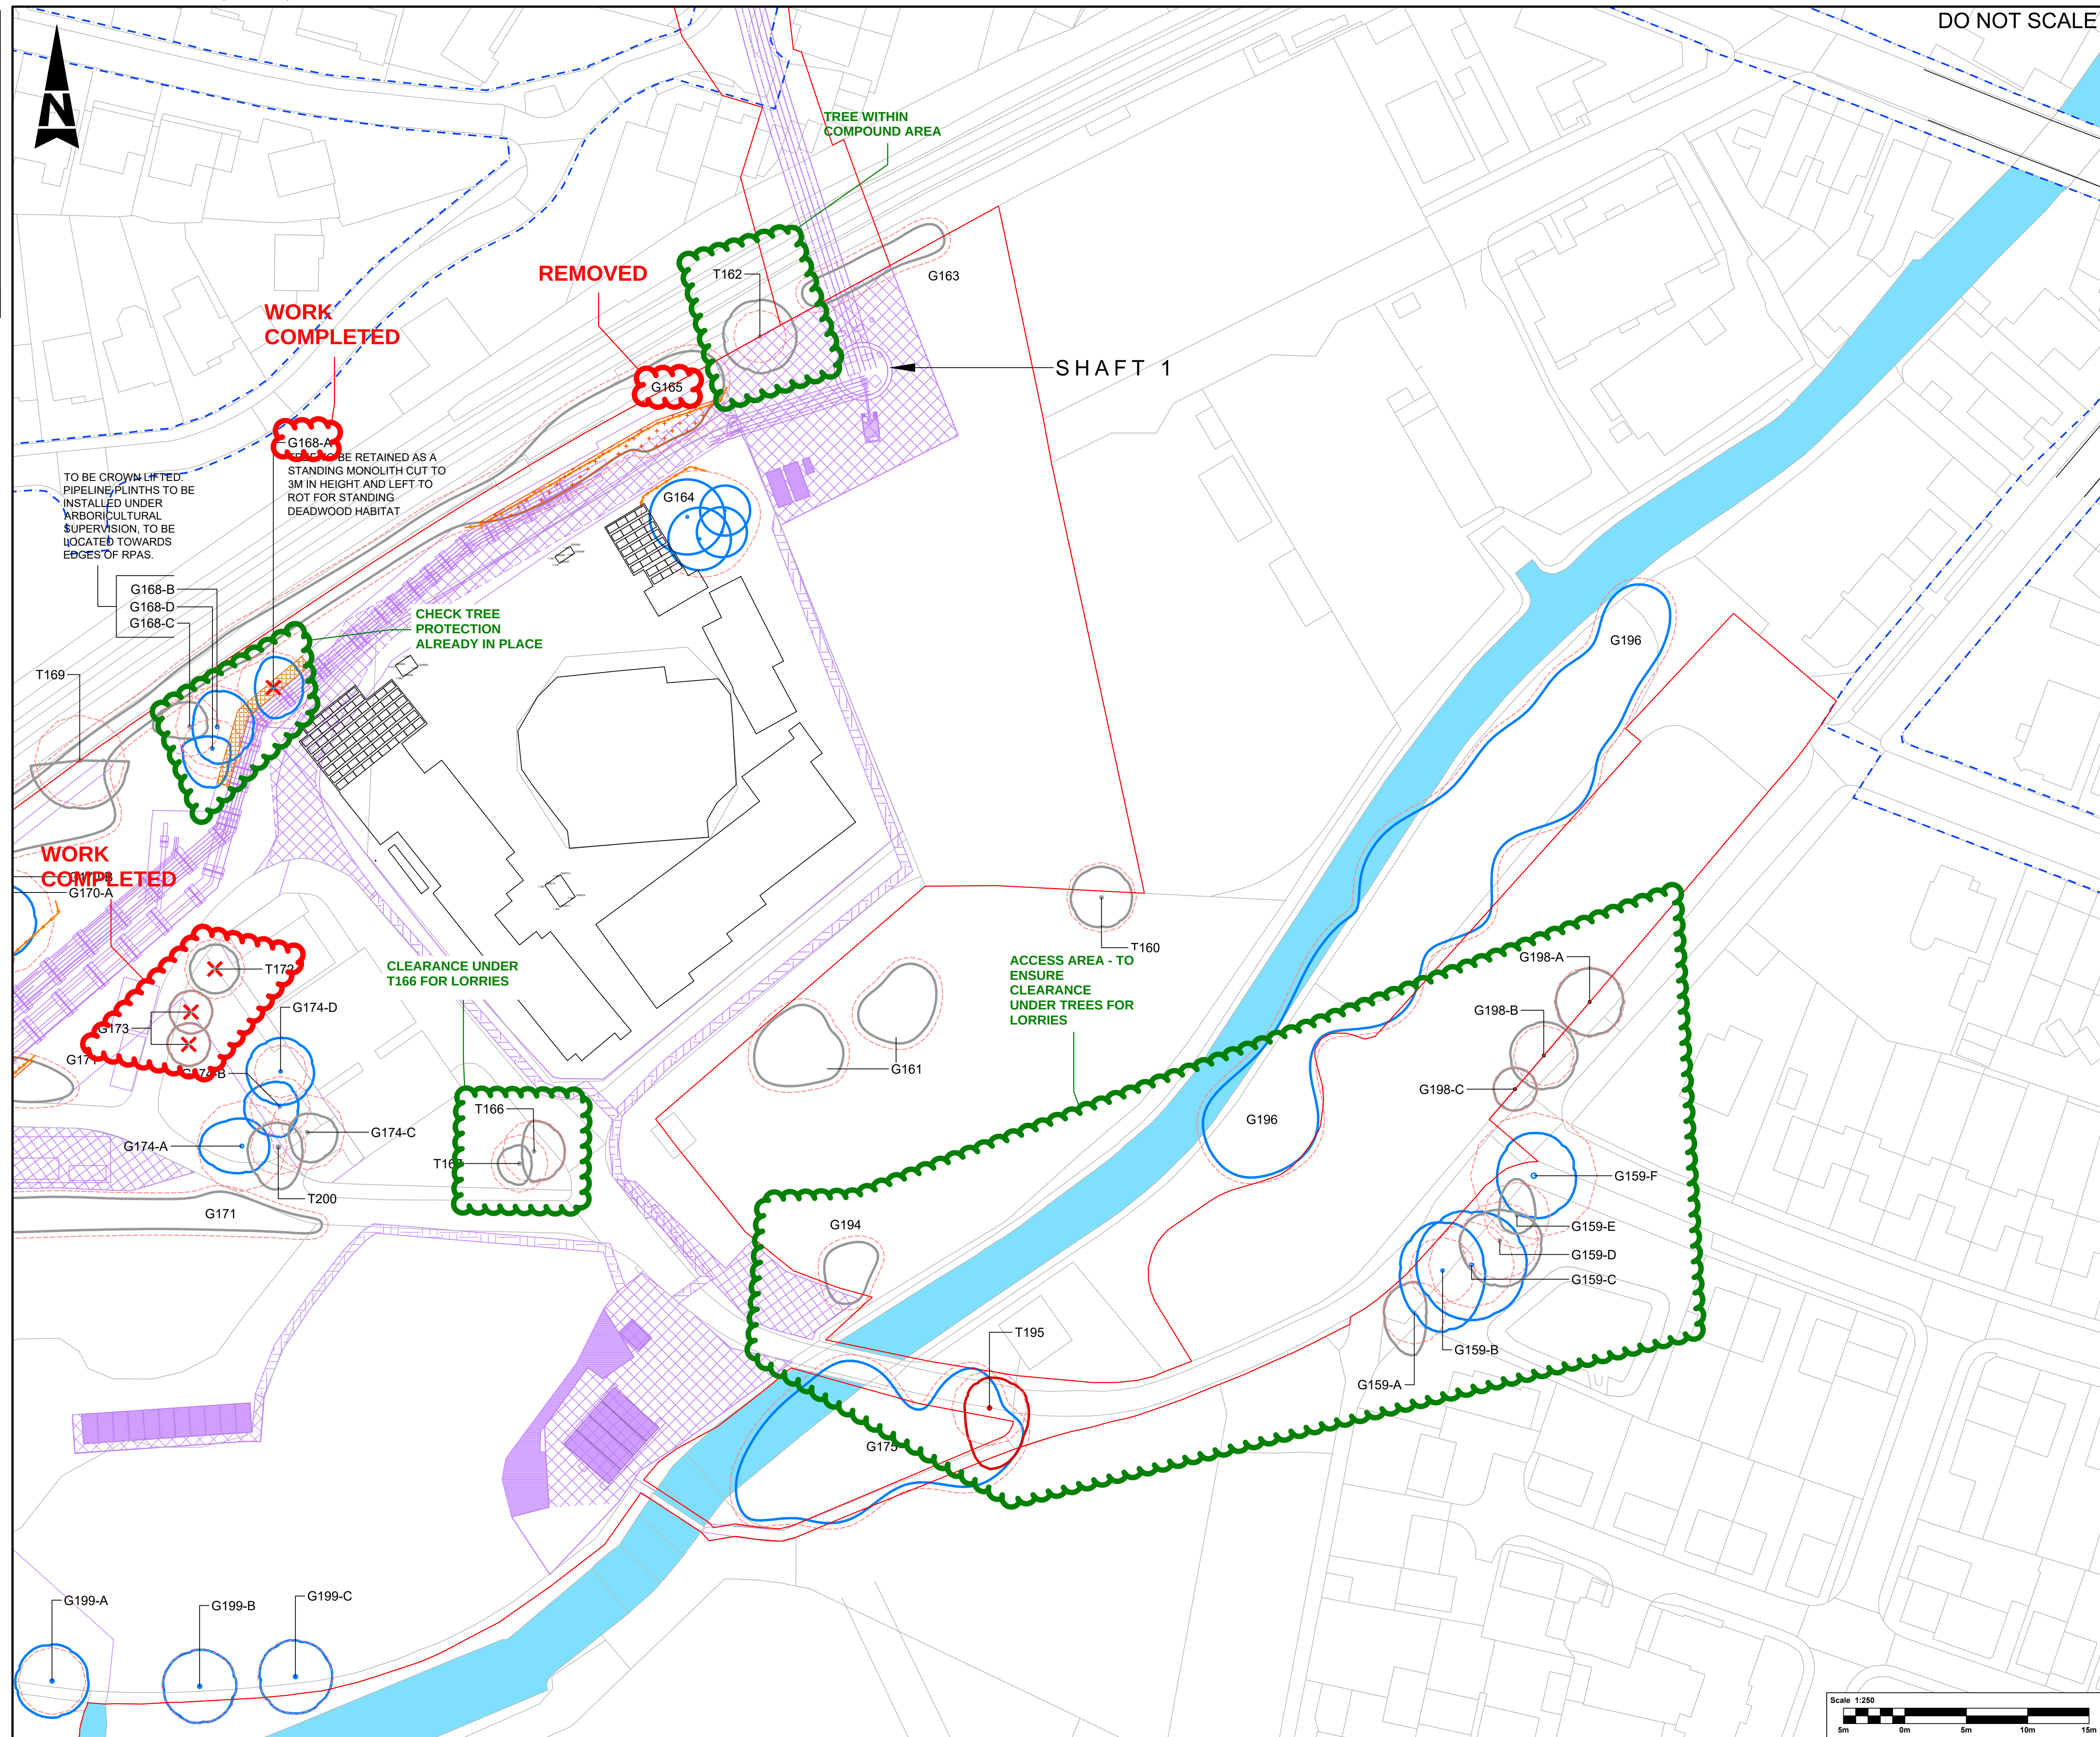

In addition to the hazards/risks normally associated with the types of work detailed on this drawing, note the following:

CONSTRUCTION

100



Refer to designer's risk assessment

1	2	
---	---	---	---	---	---	---	---	---	----	----	-----	-----	

Refer to designer's risk assessment


It is assumed that all works will be carried out by a competent contractor working, where appropriate, to an approved method statement

☐ HIGHWAY ☐ SCHEME RED LINE

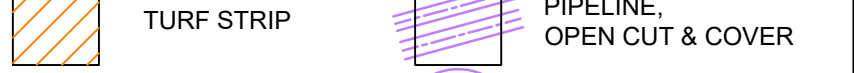 **MAIN PIPELINE** **SHUNTWELL UPGRADE**

TREE FEATURES
& SURVEY

 ANCIENT WOODLAND

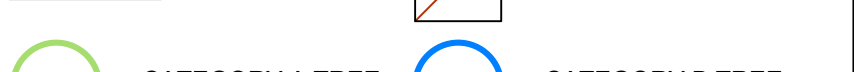

TREE PROTECTION / WORKS / REMOVALS



OTHER SPECIFIC TREE WORKS AS NOTED ON DRAWINGS

C03	20/11/2024	General updates	NA	TD	JH
C02	11/05/2024	General updates	NA	TD	JH
Rev.	Date	Description	By	Chk'd	App'd

Suitability	Status
SUITABLE FOR INFORMATION	S2



Nova North
11 Bressenden Place
Westminster
London
SW1E 5BY

Tel: +44 (0)20 7121 20000
Fax: +44 (0)1206 732020

www.atkinsrealis.com
© SNC-Lavalin (2024)

Client

Telephone: Havant (023) 9249 9888
Fax: Havant (023) 9245 3632
Website: www.portsmouthwater.co.uk
Registered Office: PO Box 8 West Street
Havant Hampshire PO9 1LG
REGISTERED IN ENGLAND No. 2536455

Portsmouth Water



Project Title

HAVANT THICKET RESERVOIR

Drawing Title

PIPELINE
TREE PROTECTION PLAN
SHEET 11 of 12

Scale 1:500	Designed X	Drawn NA	Checked TD	Authorised JH
Original Size A1	Date --/--/--	Date 30/06/2023	Date 30/06/2023	Date 30/06/2023

Drawing Number	Revision
HTR-ATK-PZ-BR-DR-L-0012	C03